
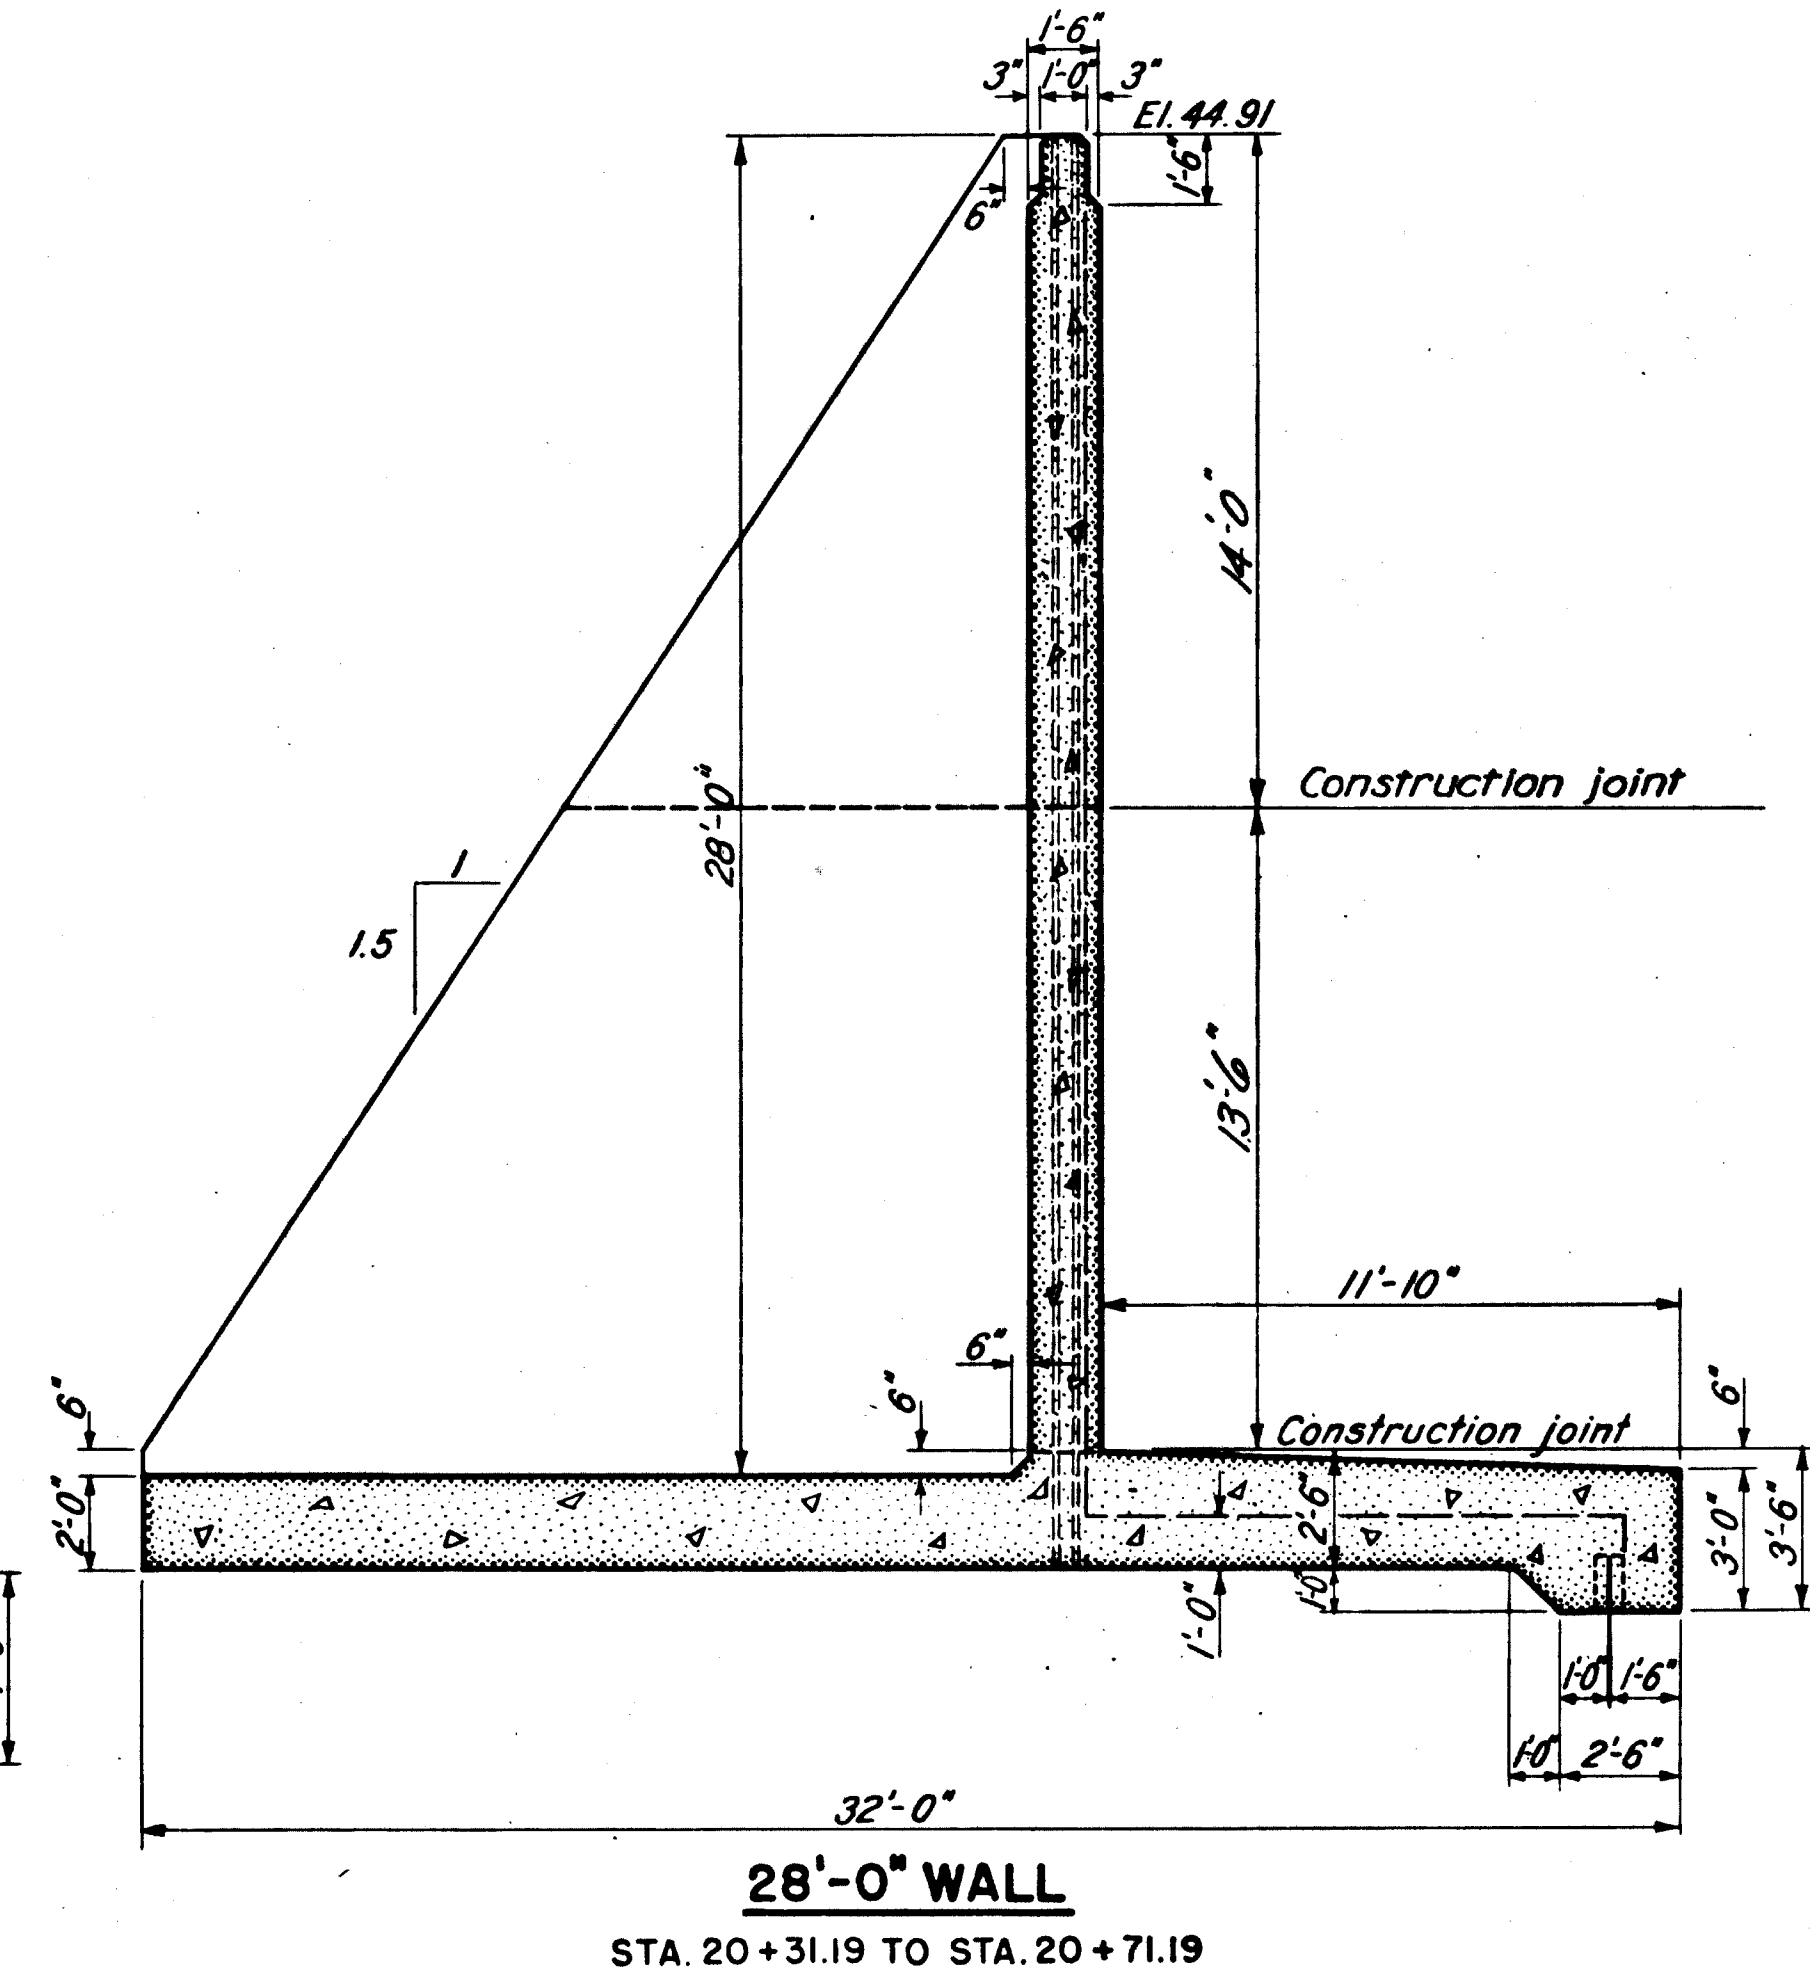
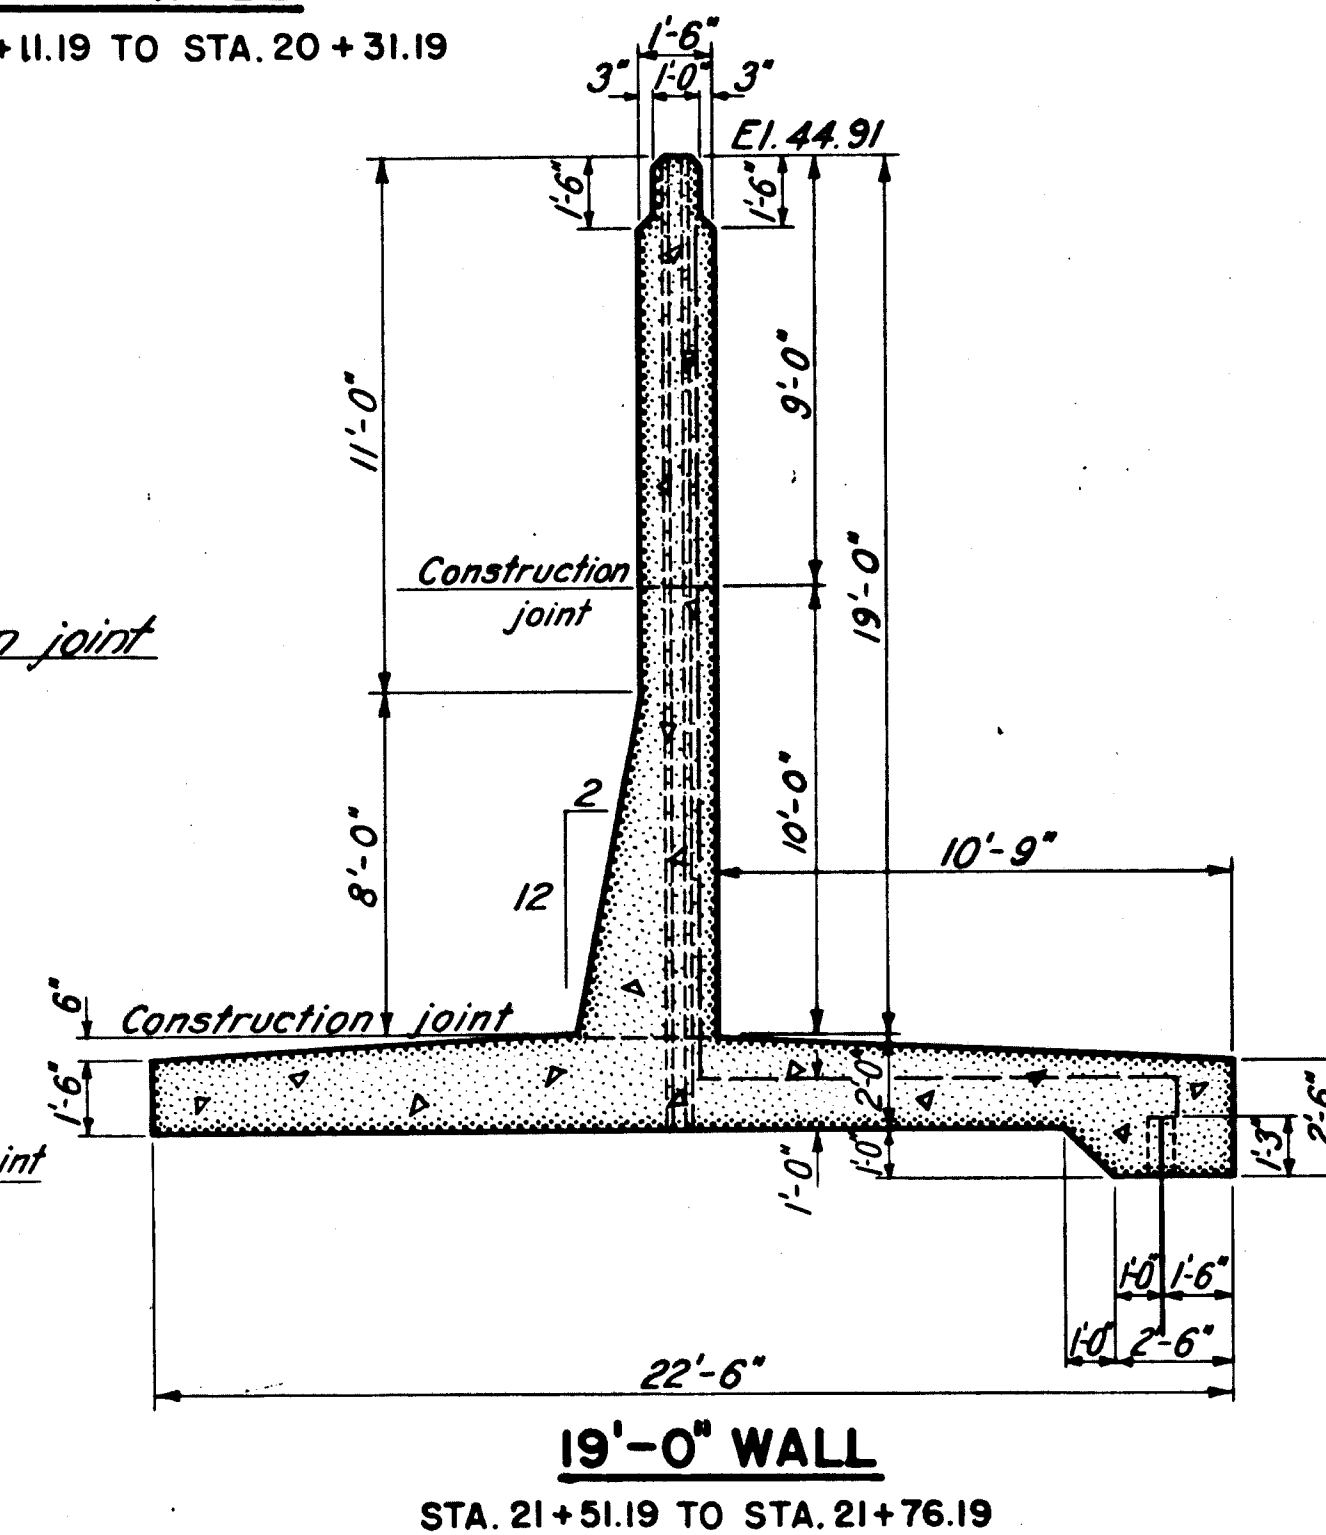
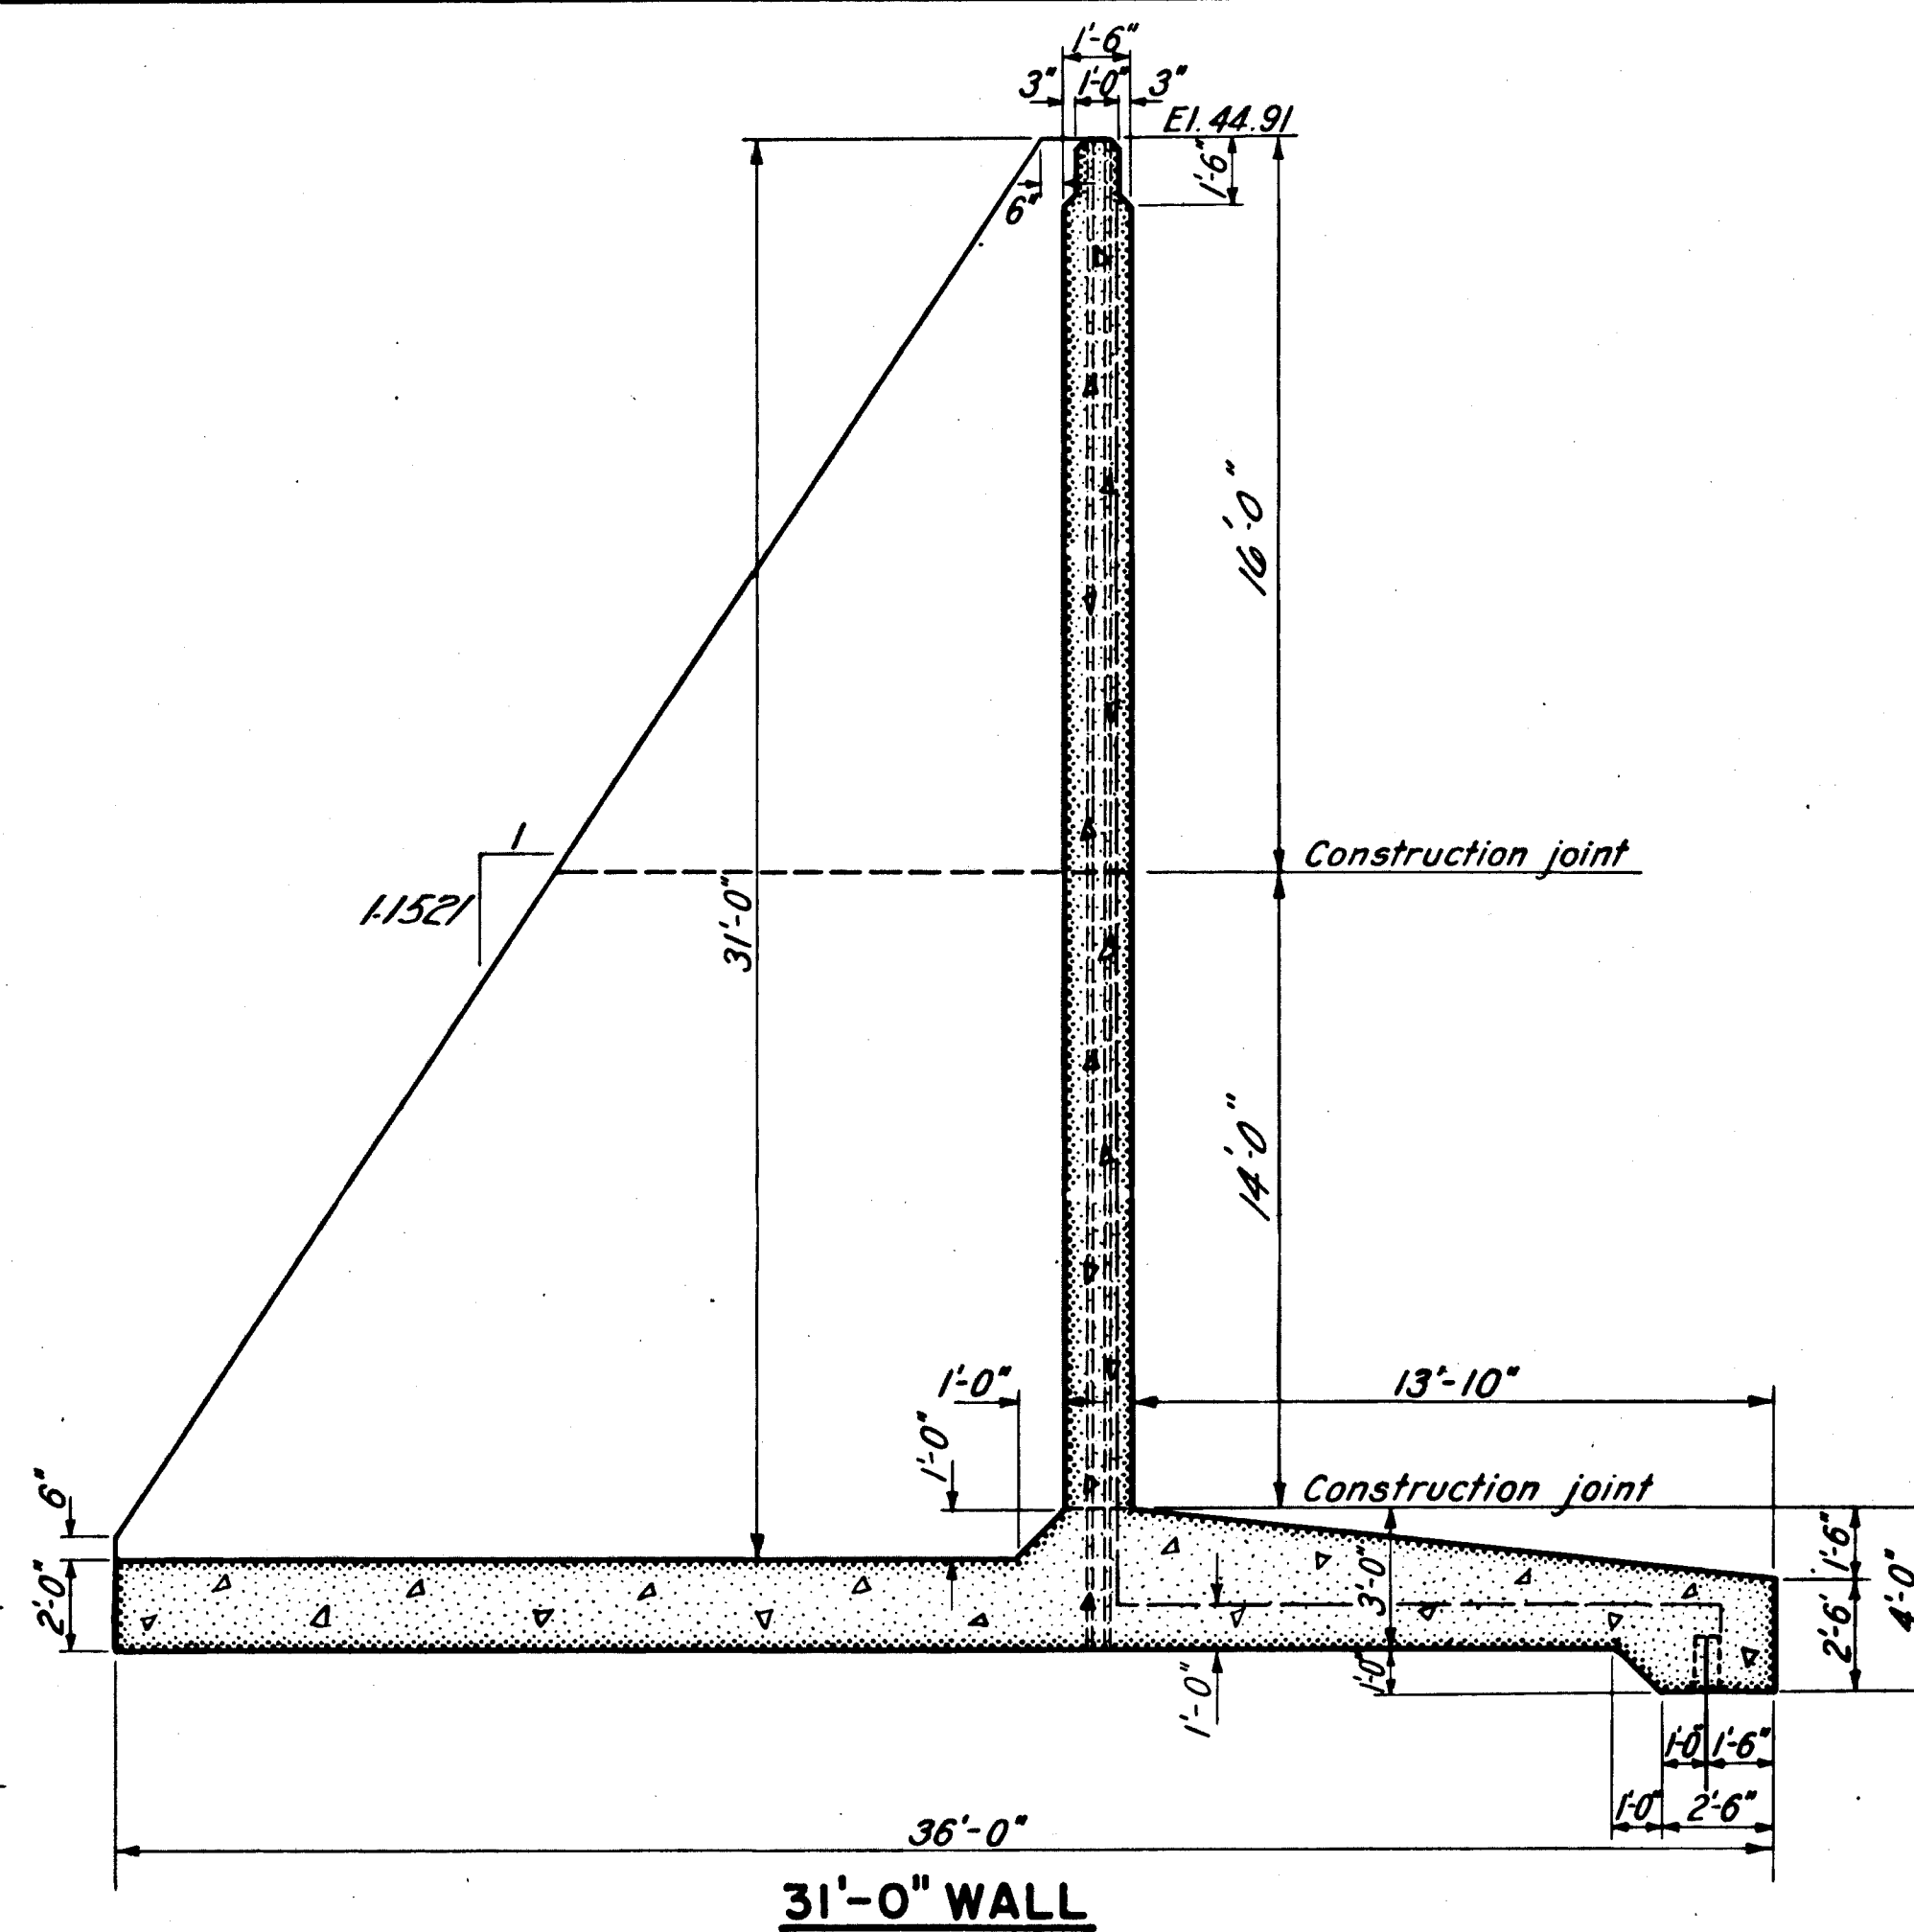
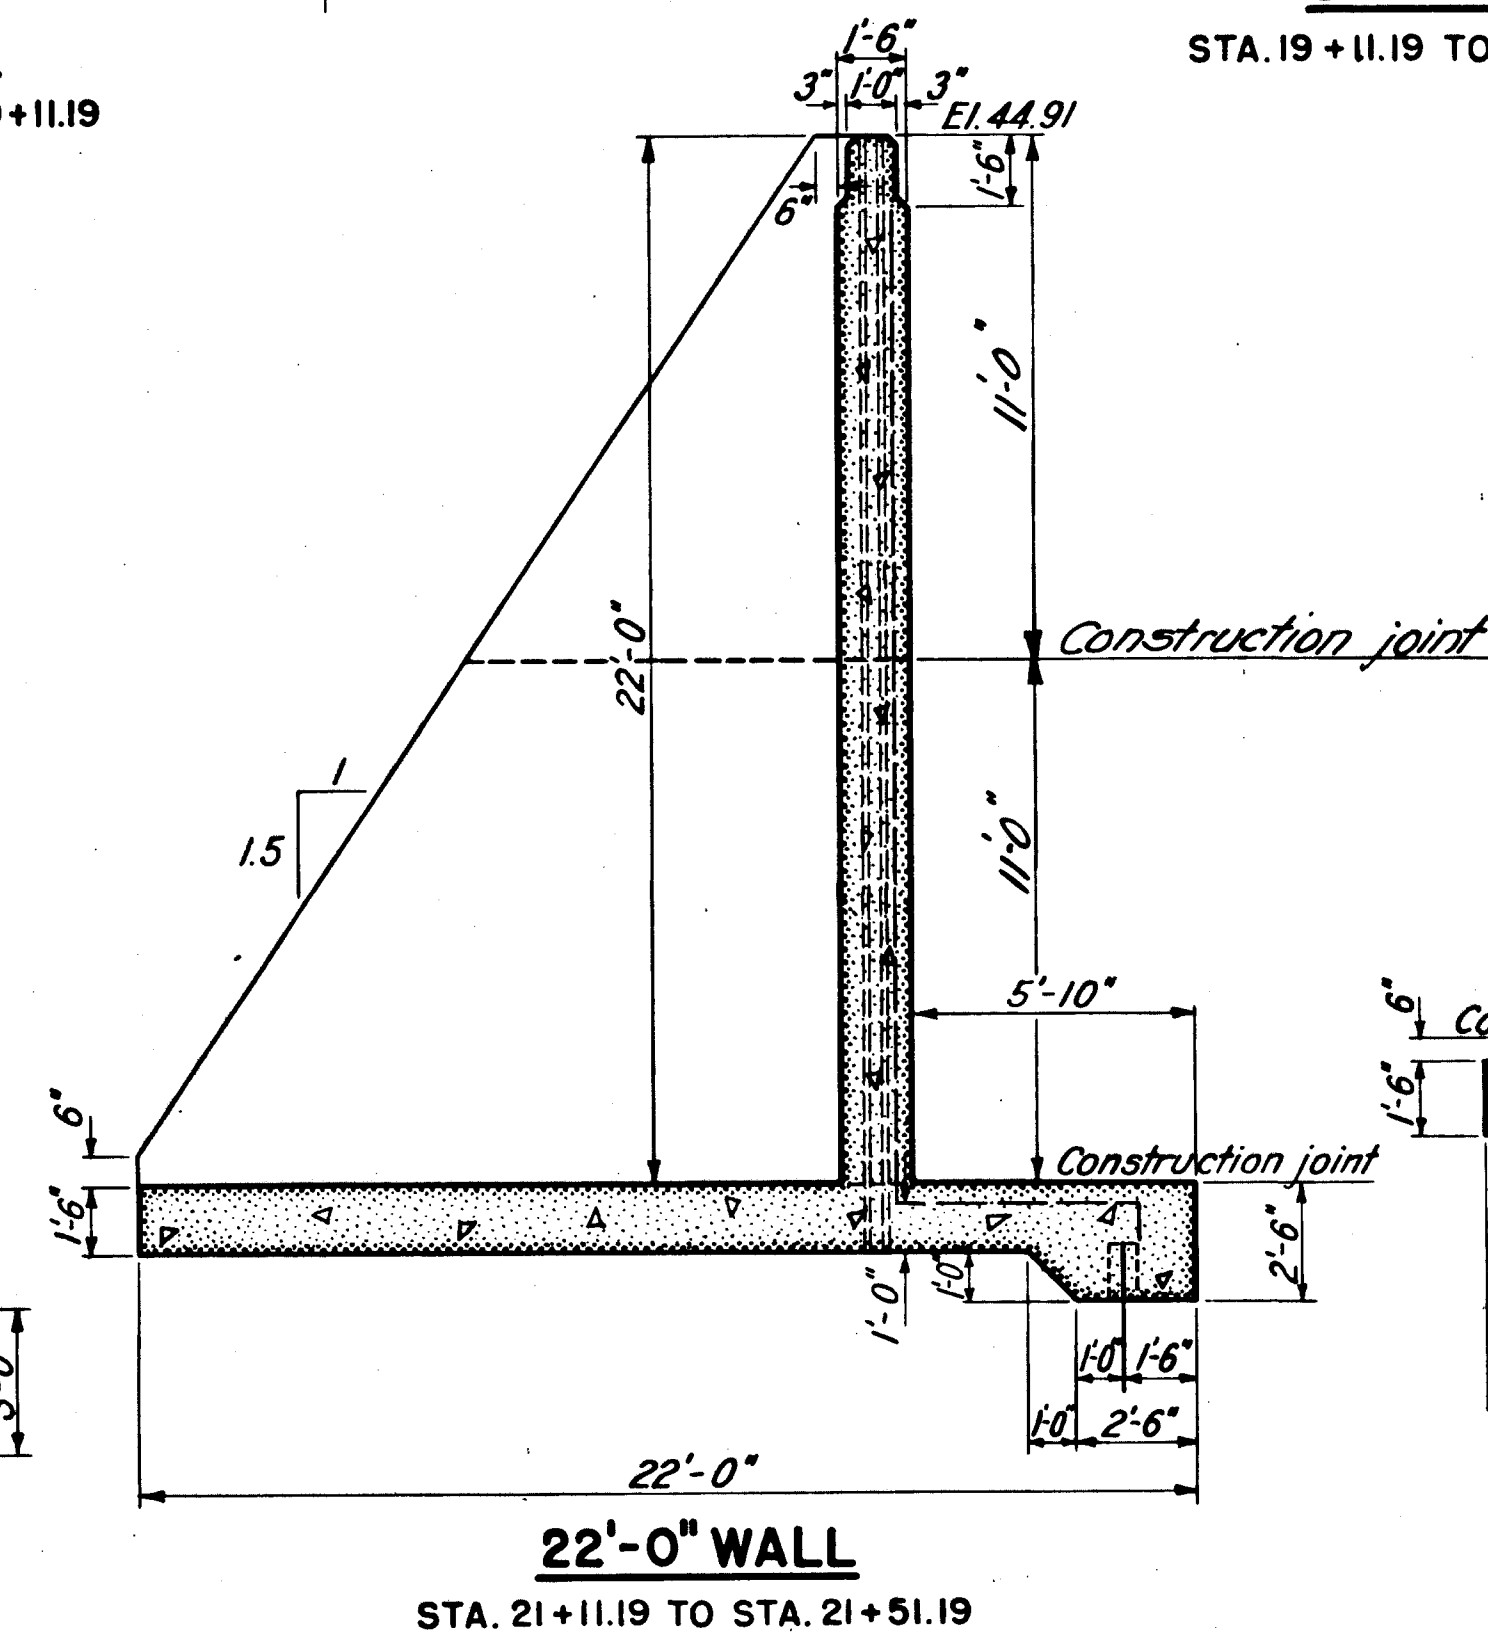
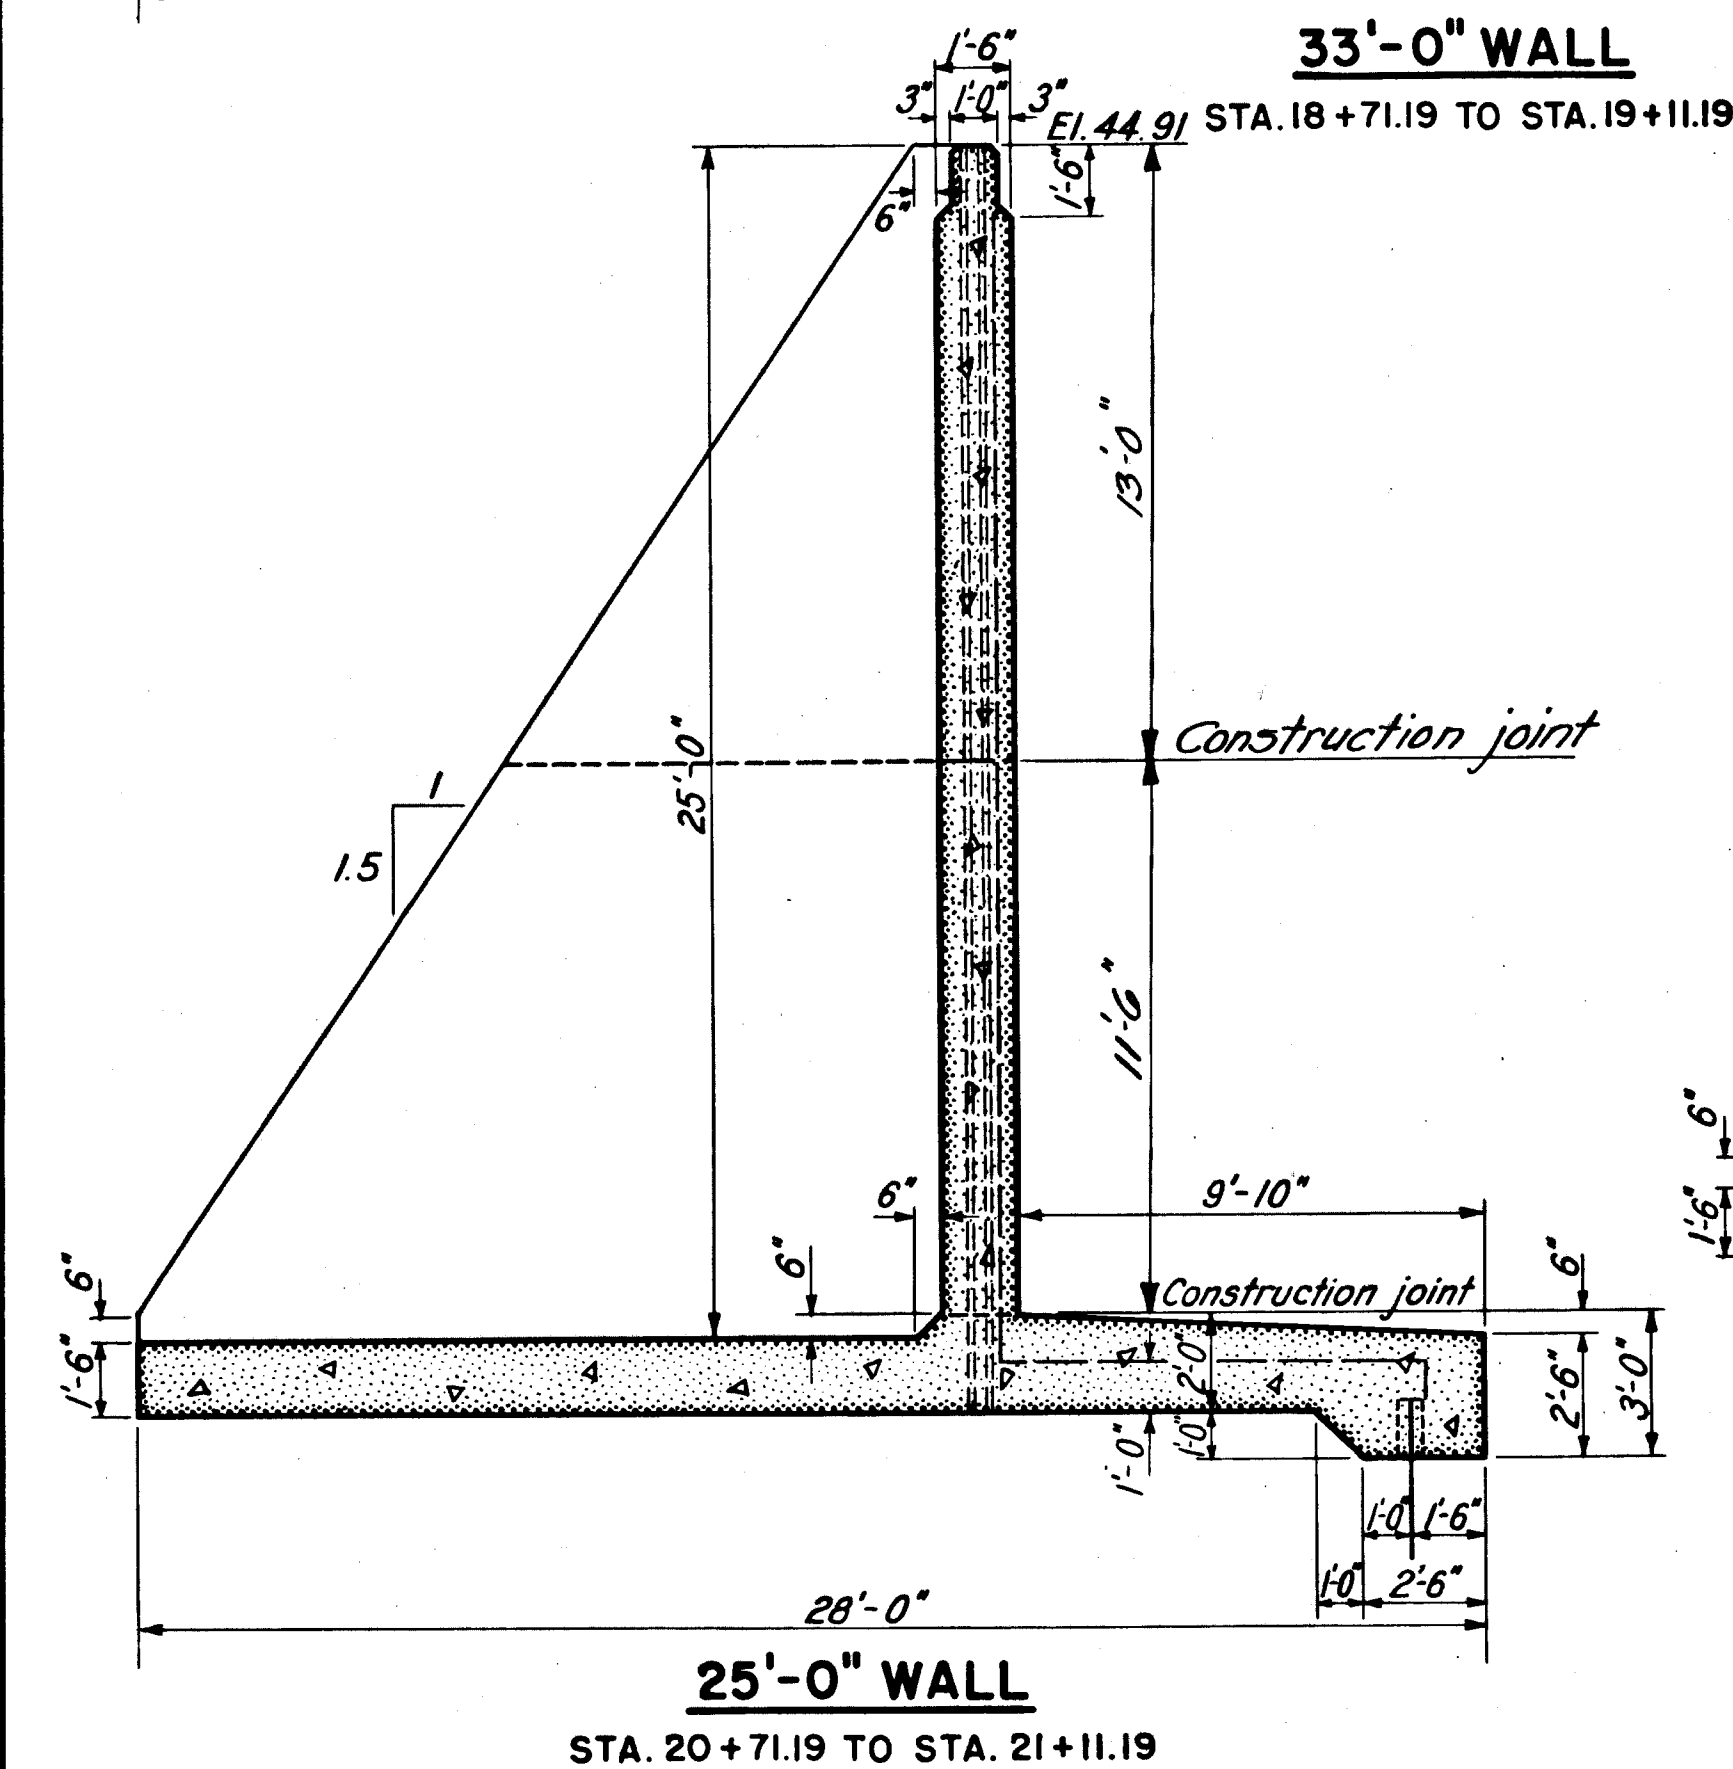


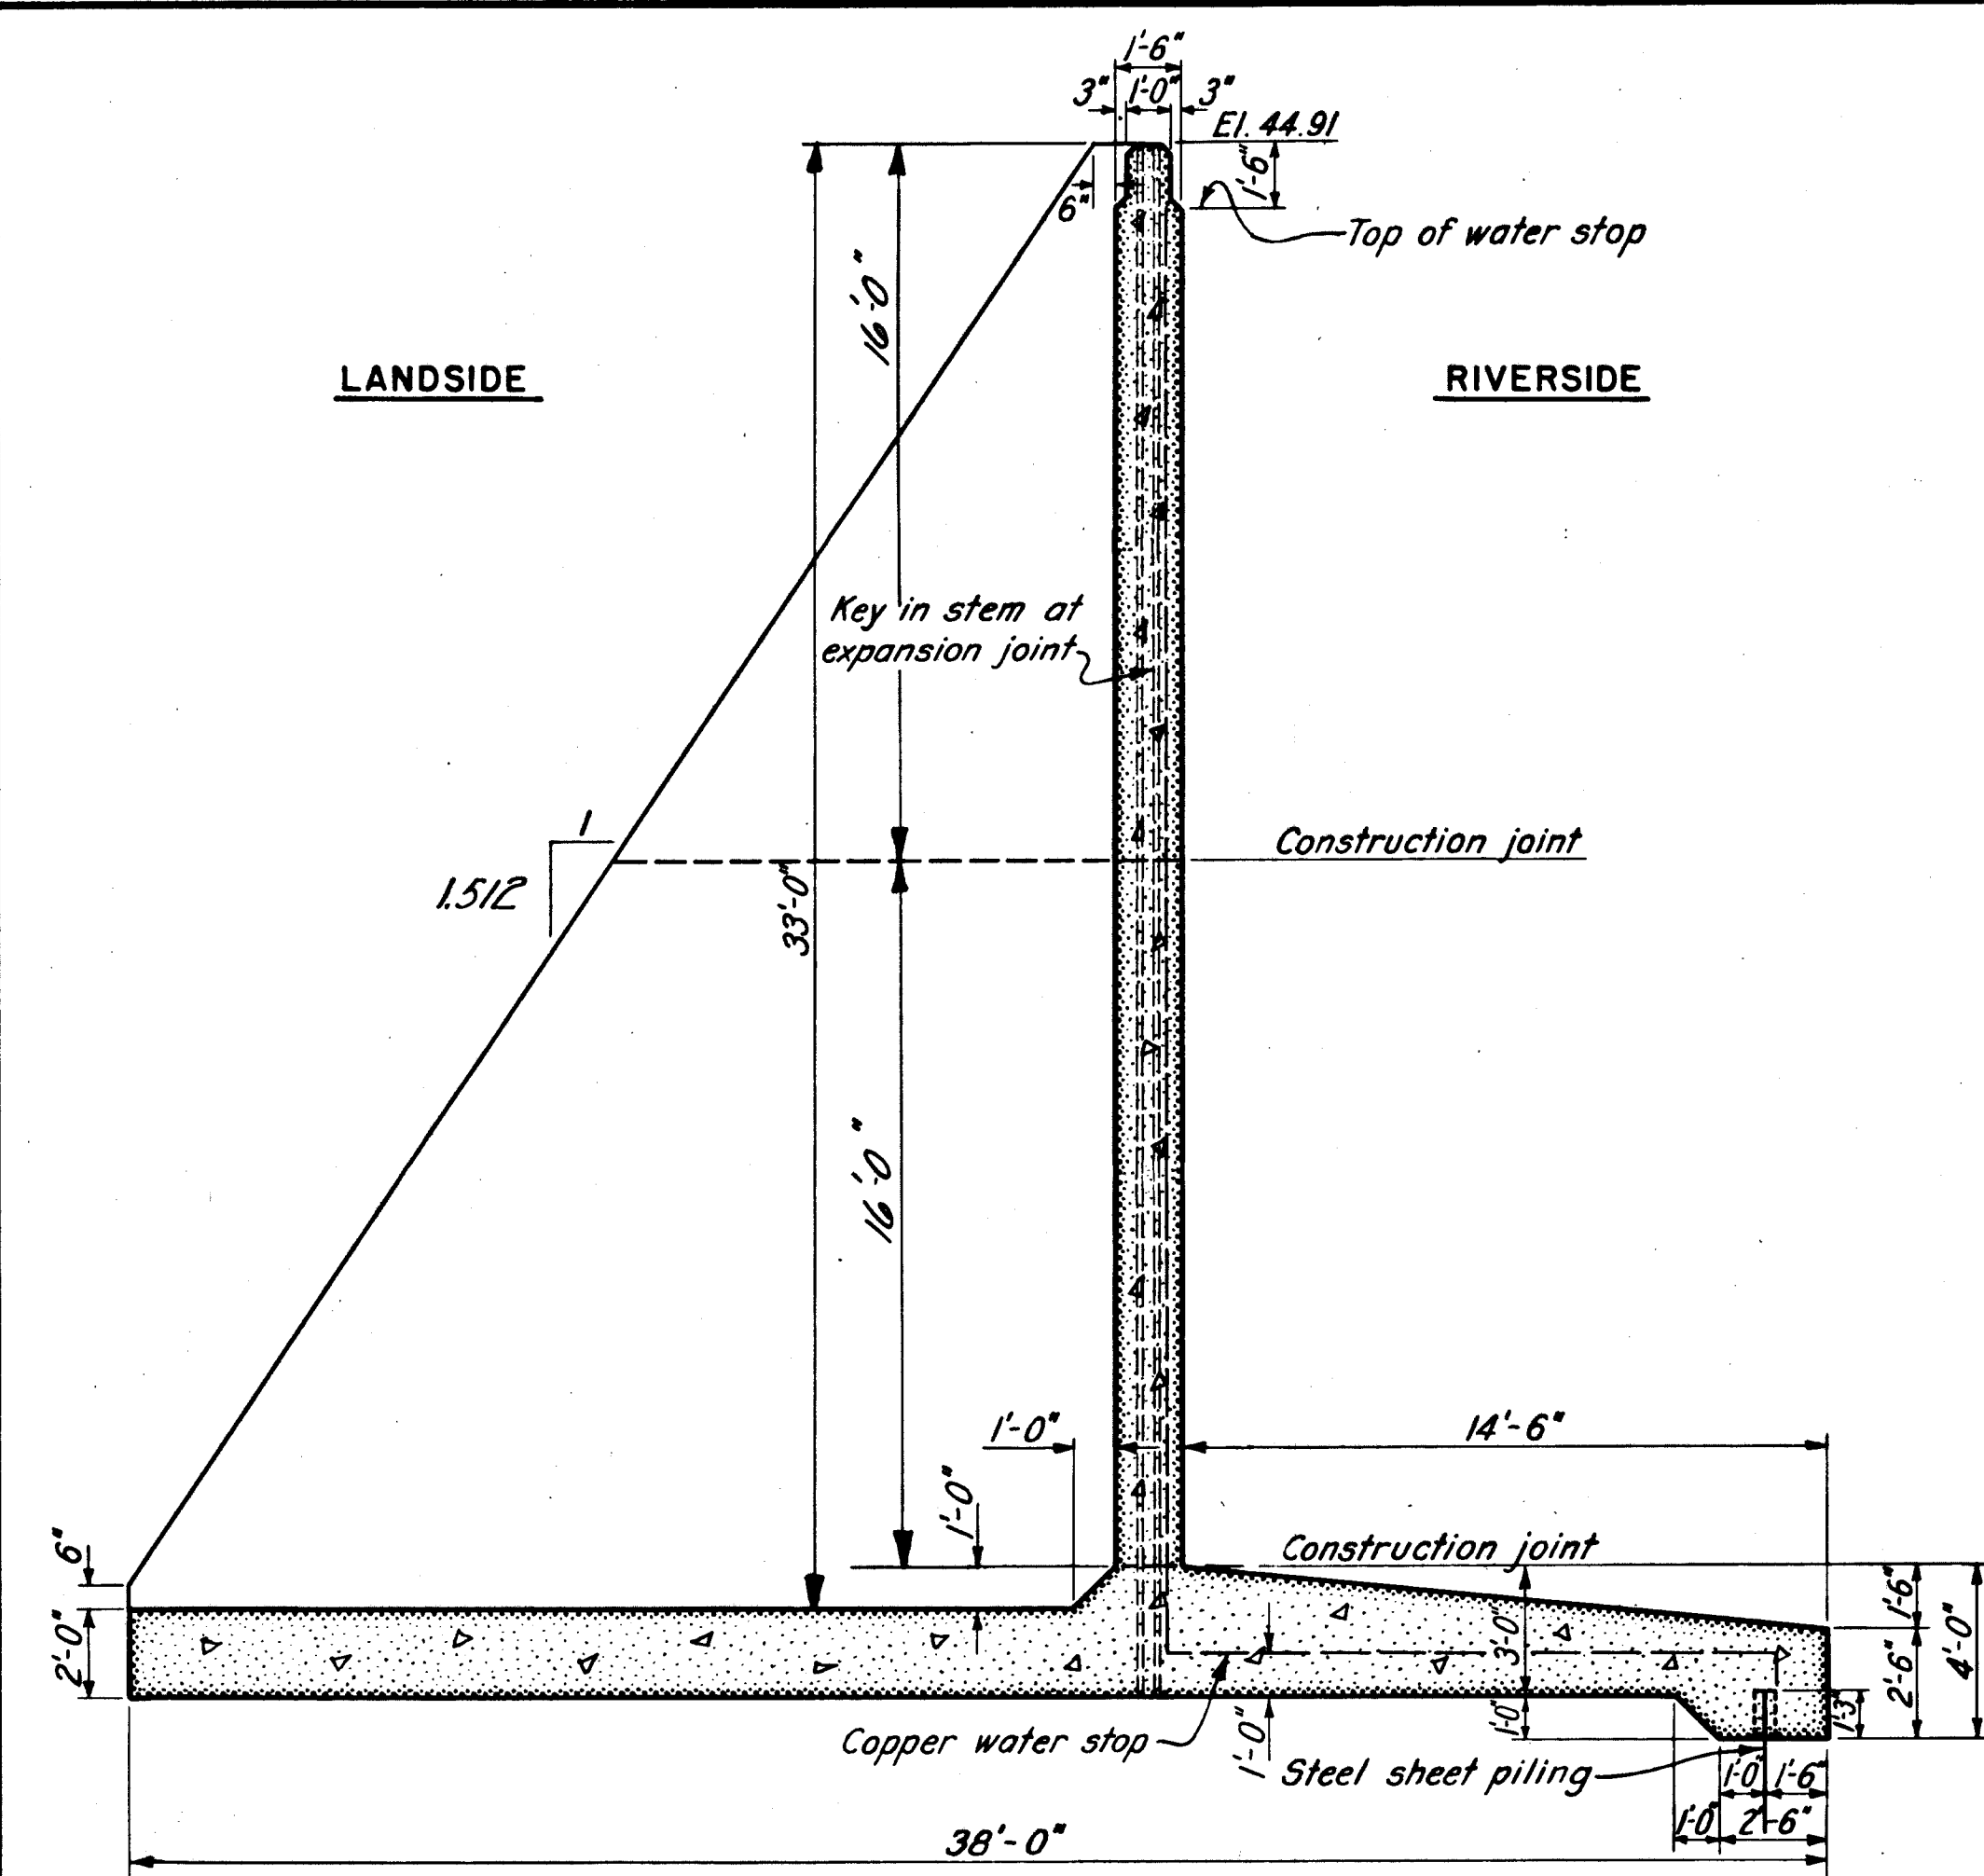

NOTES

- For general notes see Sheet No. 71.
All buttresses shall be 2'-0" thick.
For spacing of buttresses see detail on Sheet No. 72.
All corners of buttresses to have 1" chamfer.

CONNECTICUT RIVER FLOOD CONTROL
HARTFORD DIKE
RIVERFRONT, MORGAN ST. TO STA. 96+73
CONCRETE WALL SECTIONS NO. 4

CONNECTICUT RIVER
IN 135 SHEETS
SCALE: 1/2" = 1' ET
CONNECTICUT
SHEET NO. 73

U. S. ENGINEER OFFICE, PROVIDENCE, R.I., MAY 1940

SUBMITTED: *Wm. B. Wilson* APPROVED: *Wm. B. Wilson*
SENIOR ENGINEER HEAD DESIGN SECTION PRINCIPAL ENGINEER CHIEF, P.C. ENGINEERING DIV. DISTRICT ENGINEER
DESIGNED: *J. Rastler* DRAWN: K.H.W. TRACED: L.H. CHECKED: *W.C.C.* FISCAL YEAR 1940
FILE NO. CT-4-2533

KEY	DATE	REVISION (Indicated by Δ)	REV. BY	CK. BY	AP. BY
	12-31-45	As built revisions			