



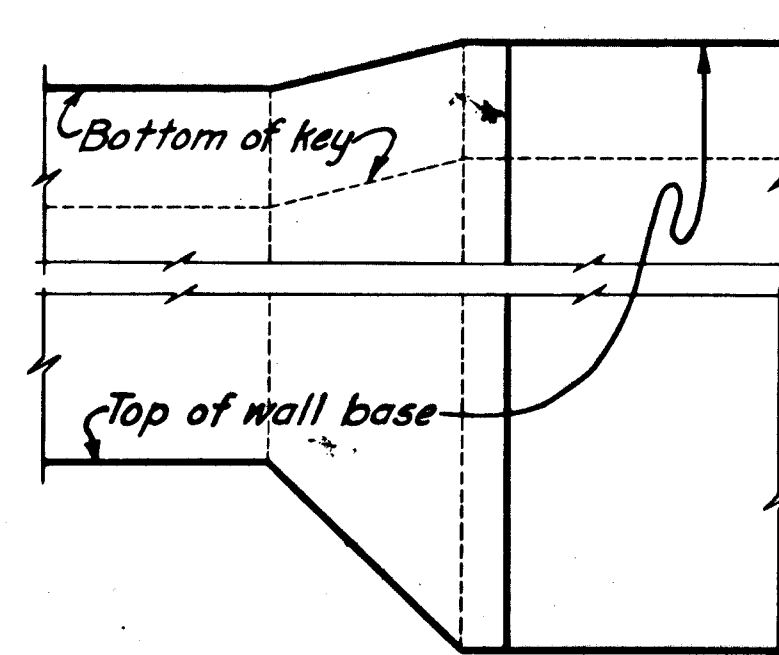


PLAN

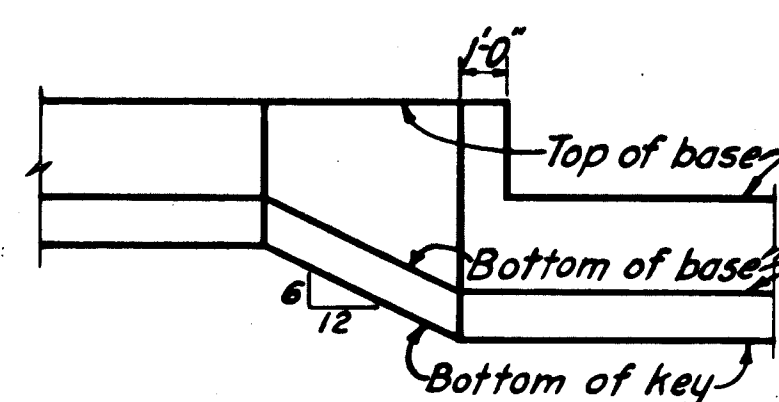


ELEVATION

TYPICAL BASE TREATMENT AT CHANGE IN WALL HEIGHT

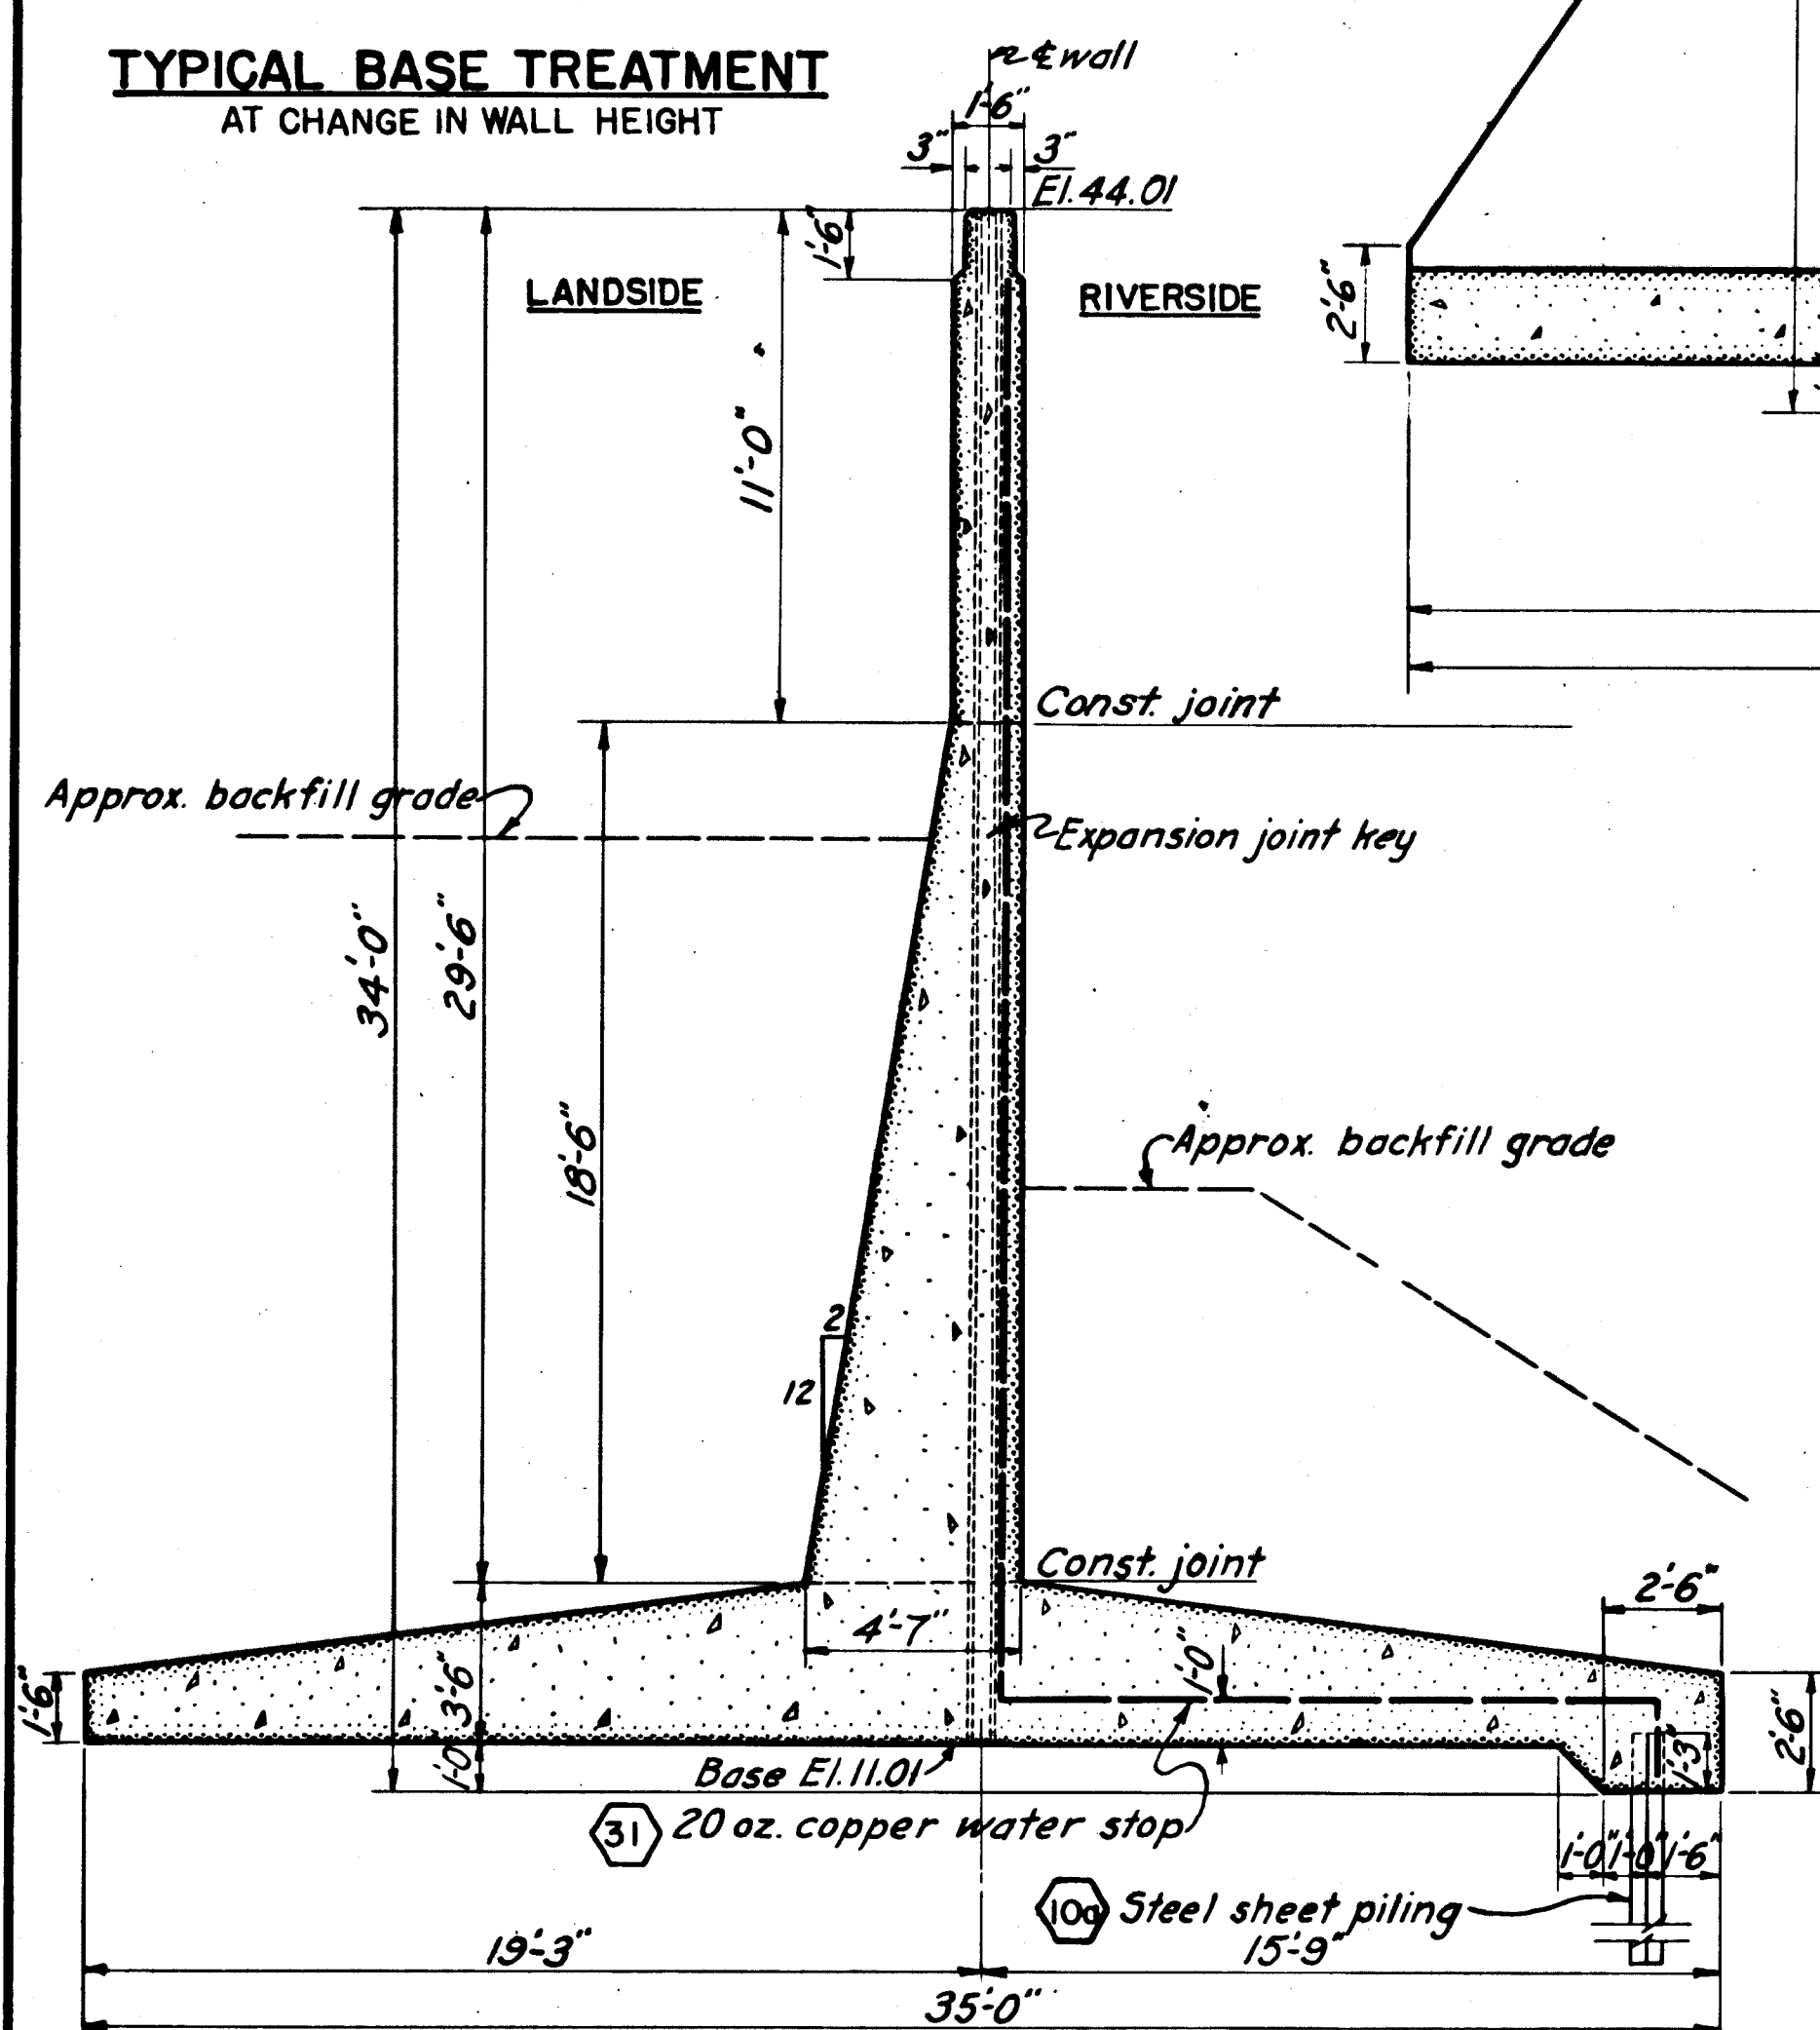


29'-6" WALL SECTION

STA. 88+85.34 TO STA. 89+17.67

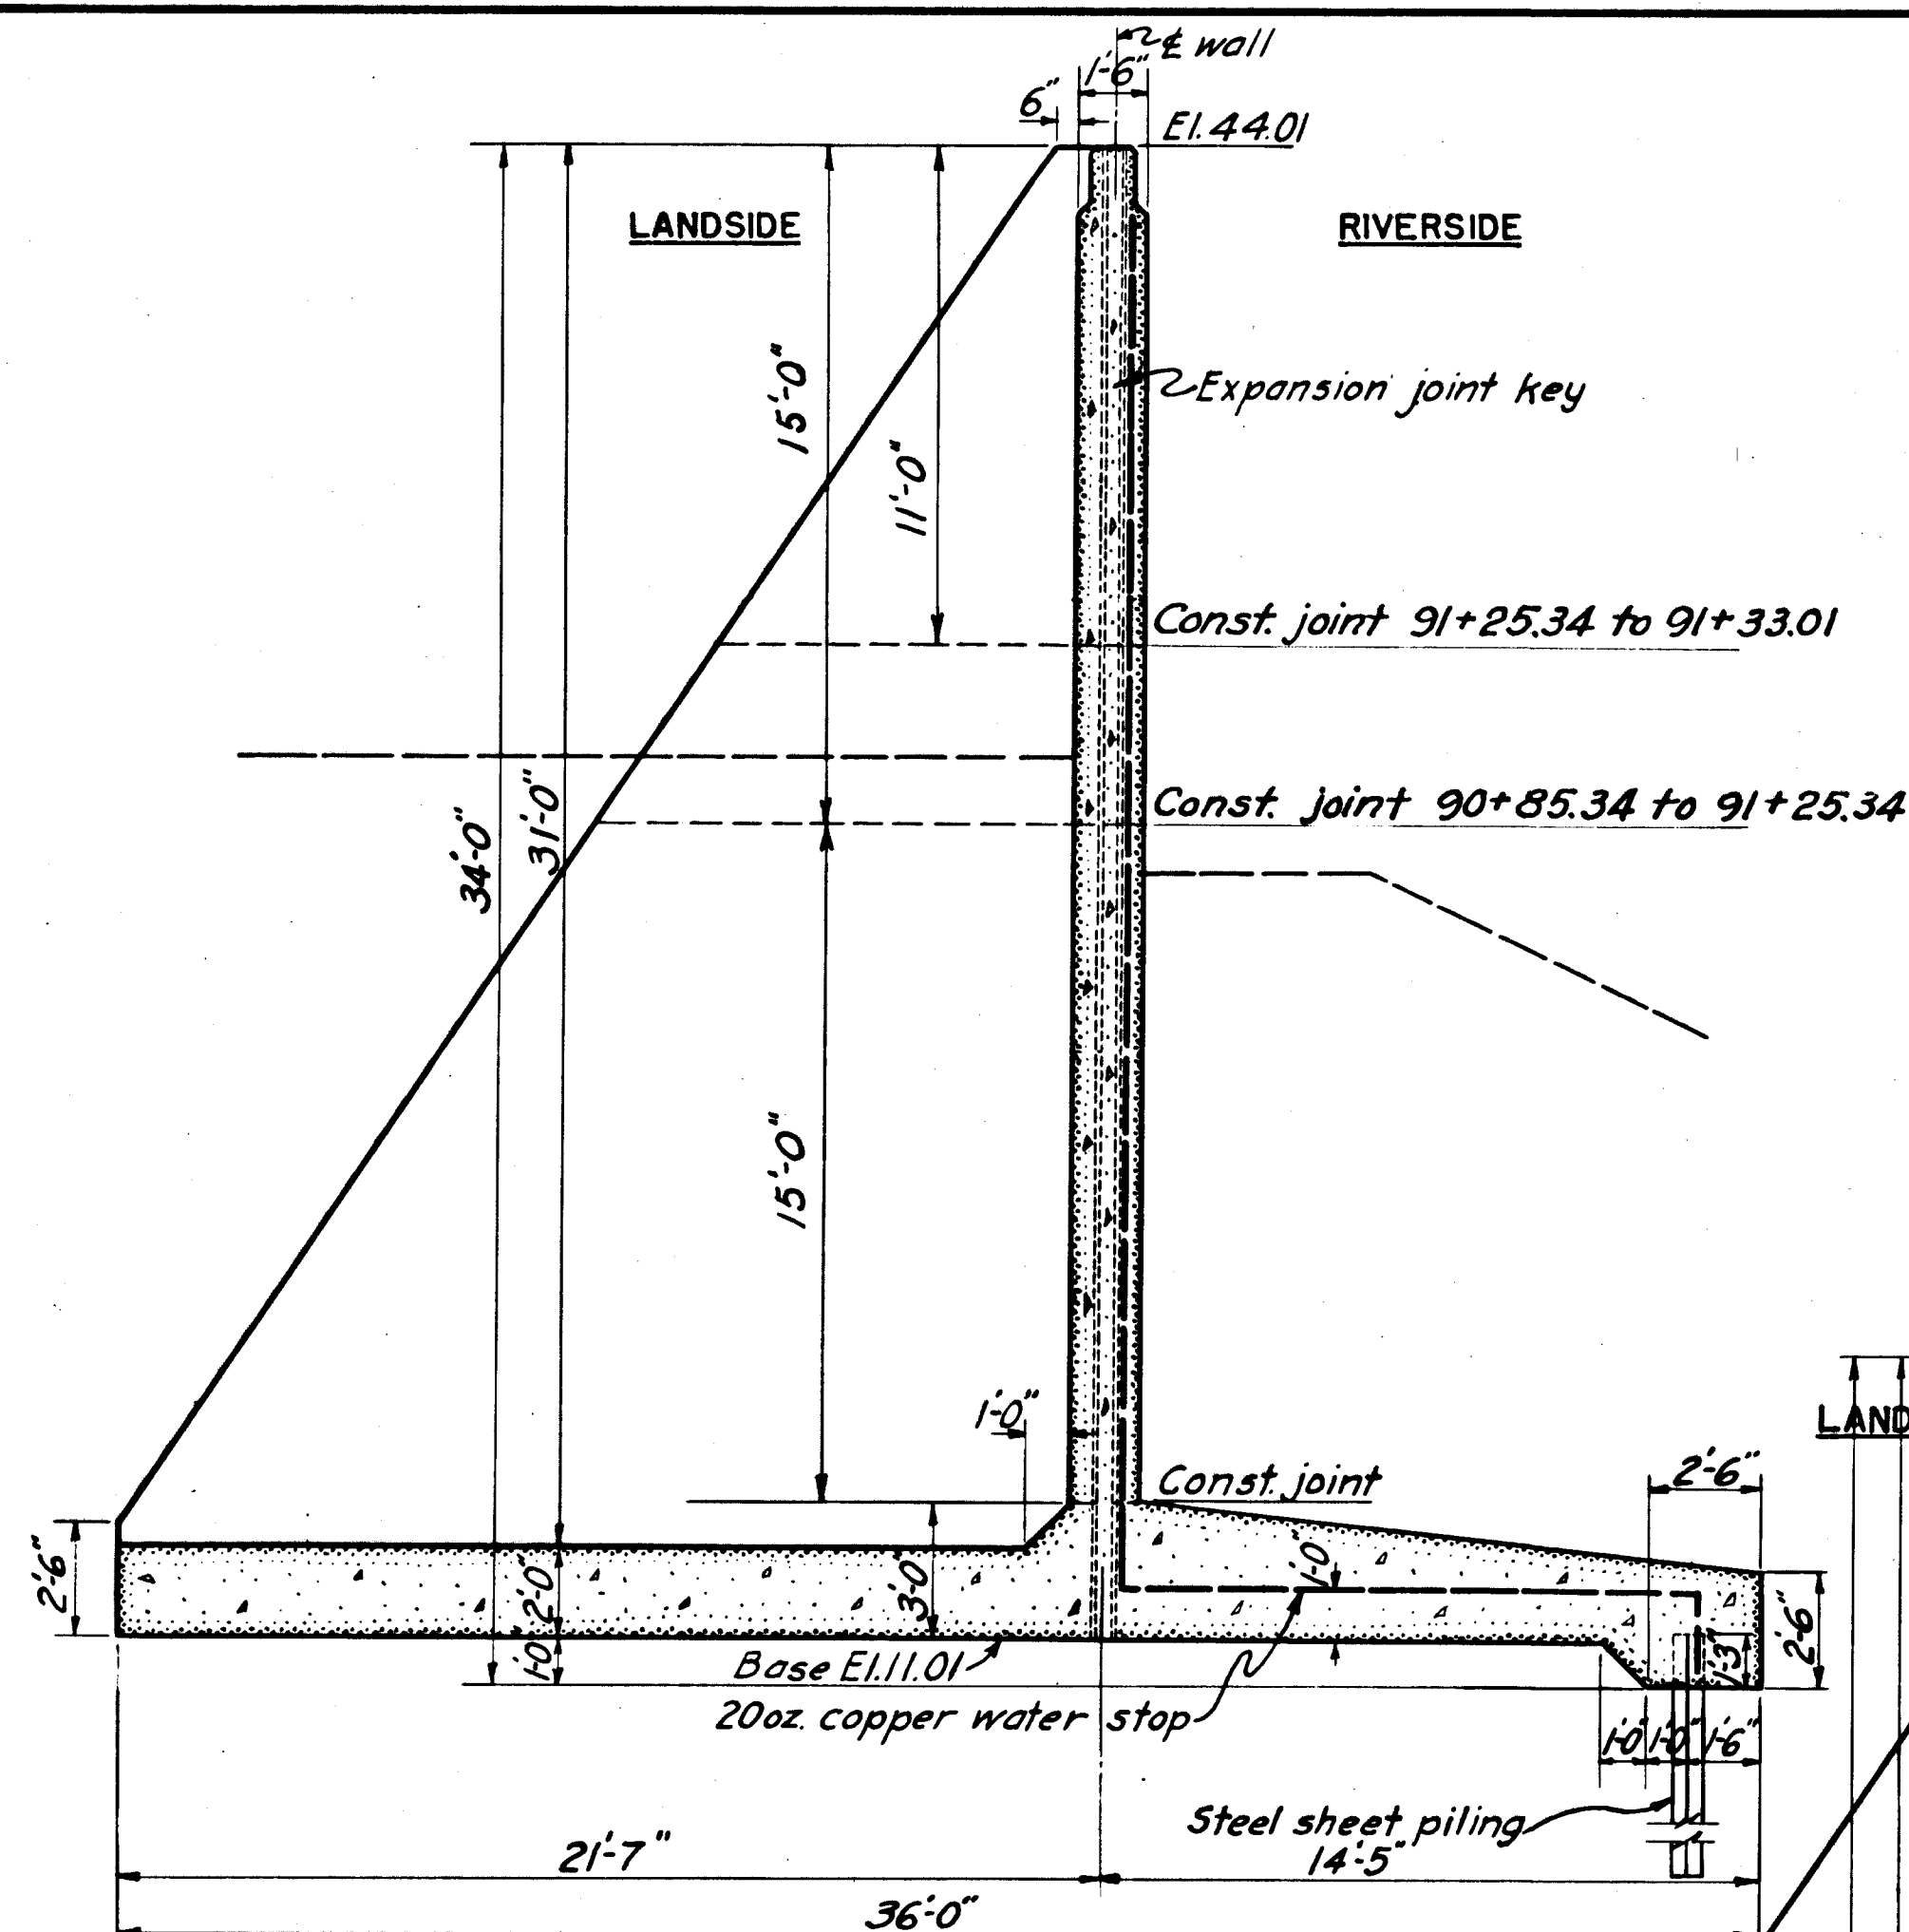


31'-0" WALL SECTION

STA. 90+91.01 TO STA. 91+33.01

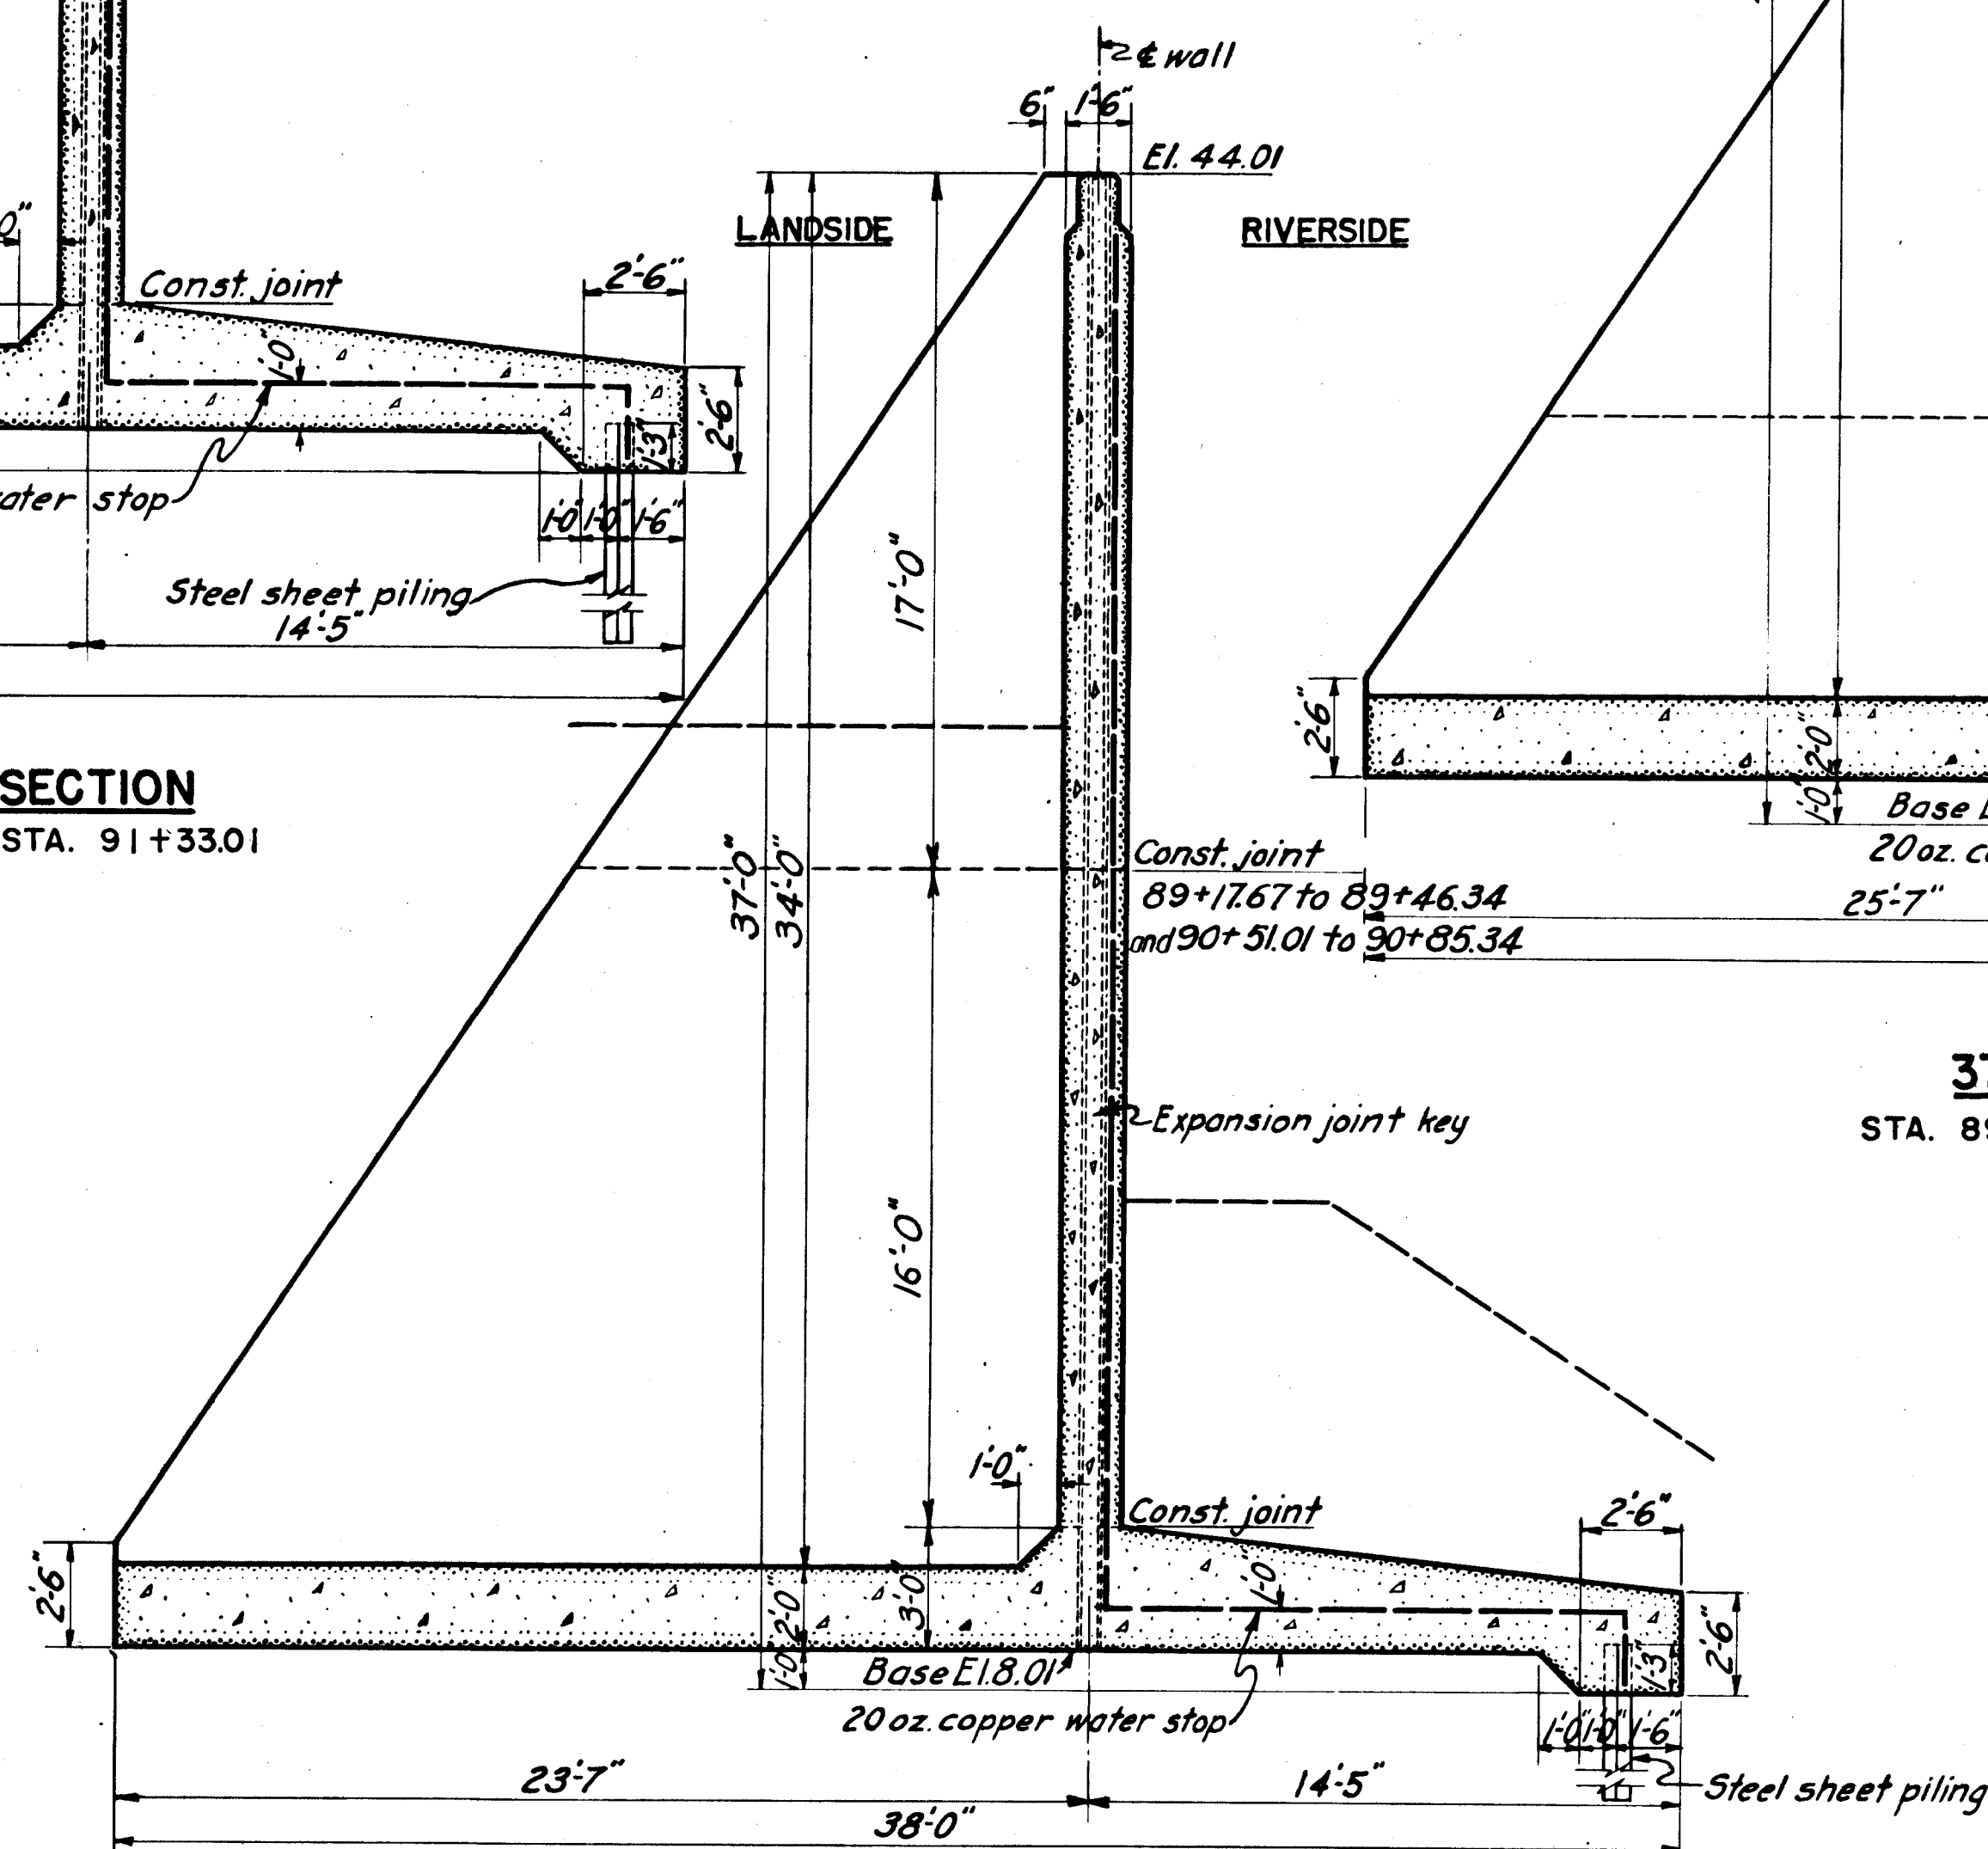

34'-0" WALL SECTION

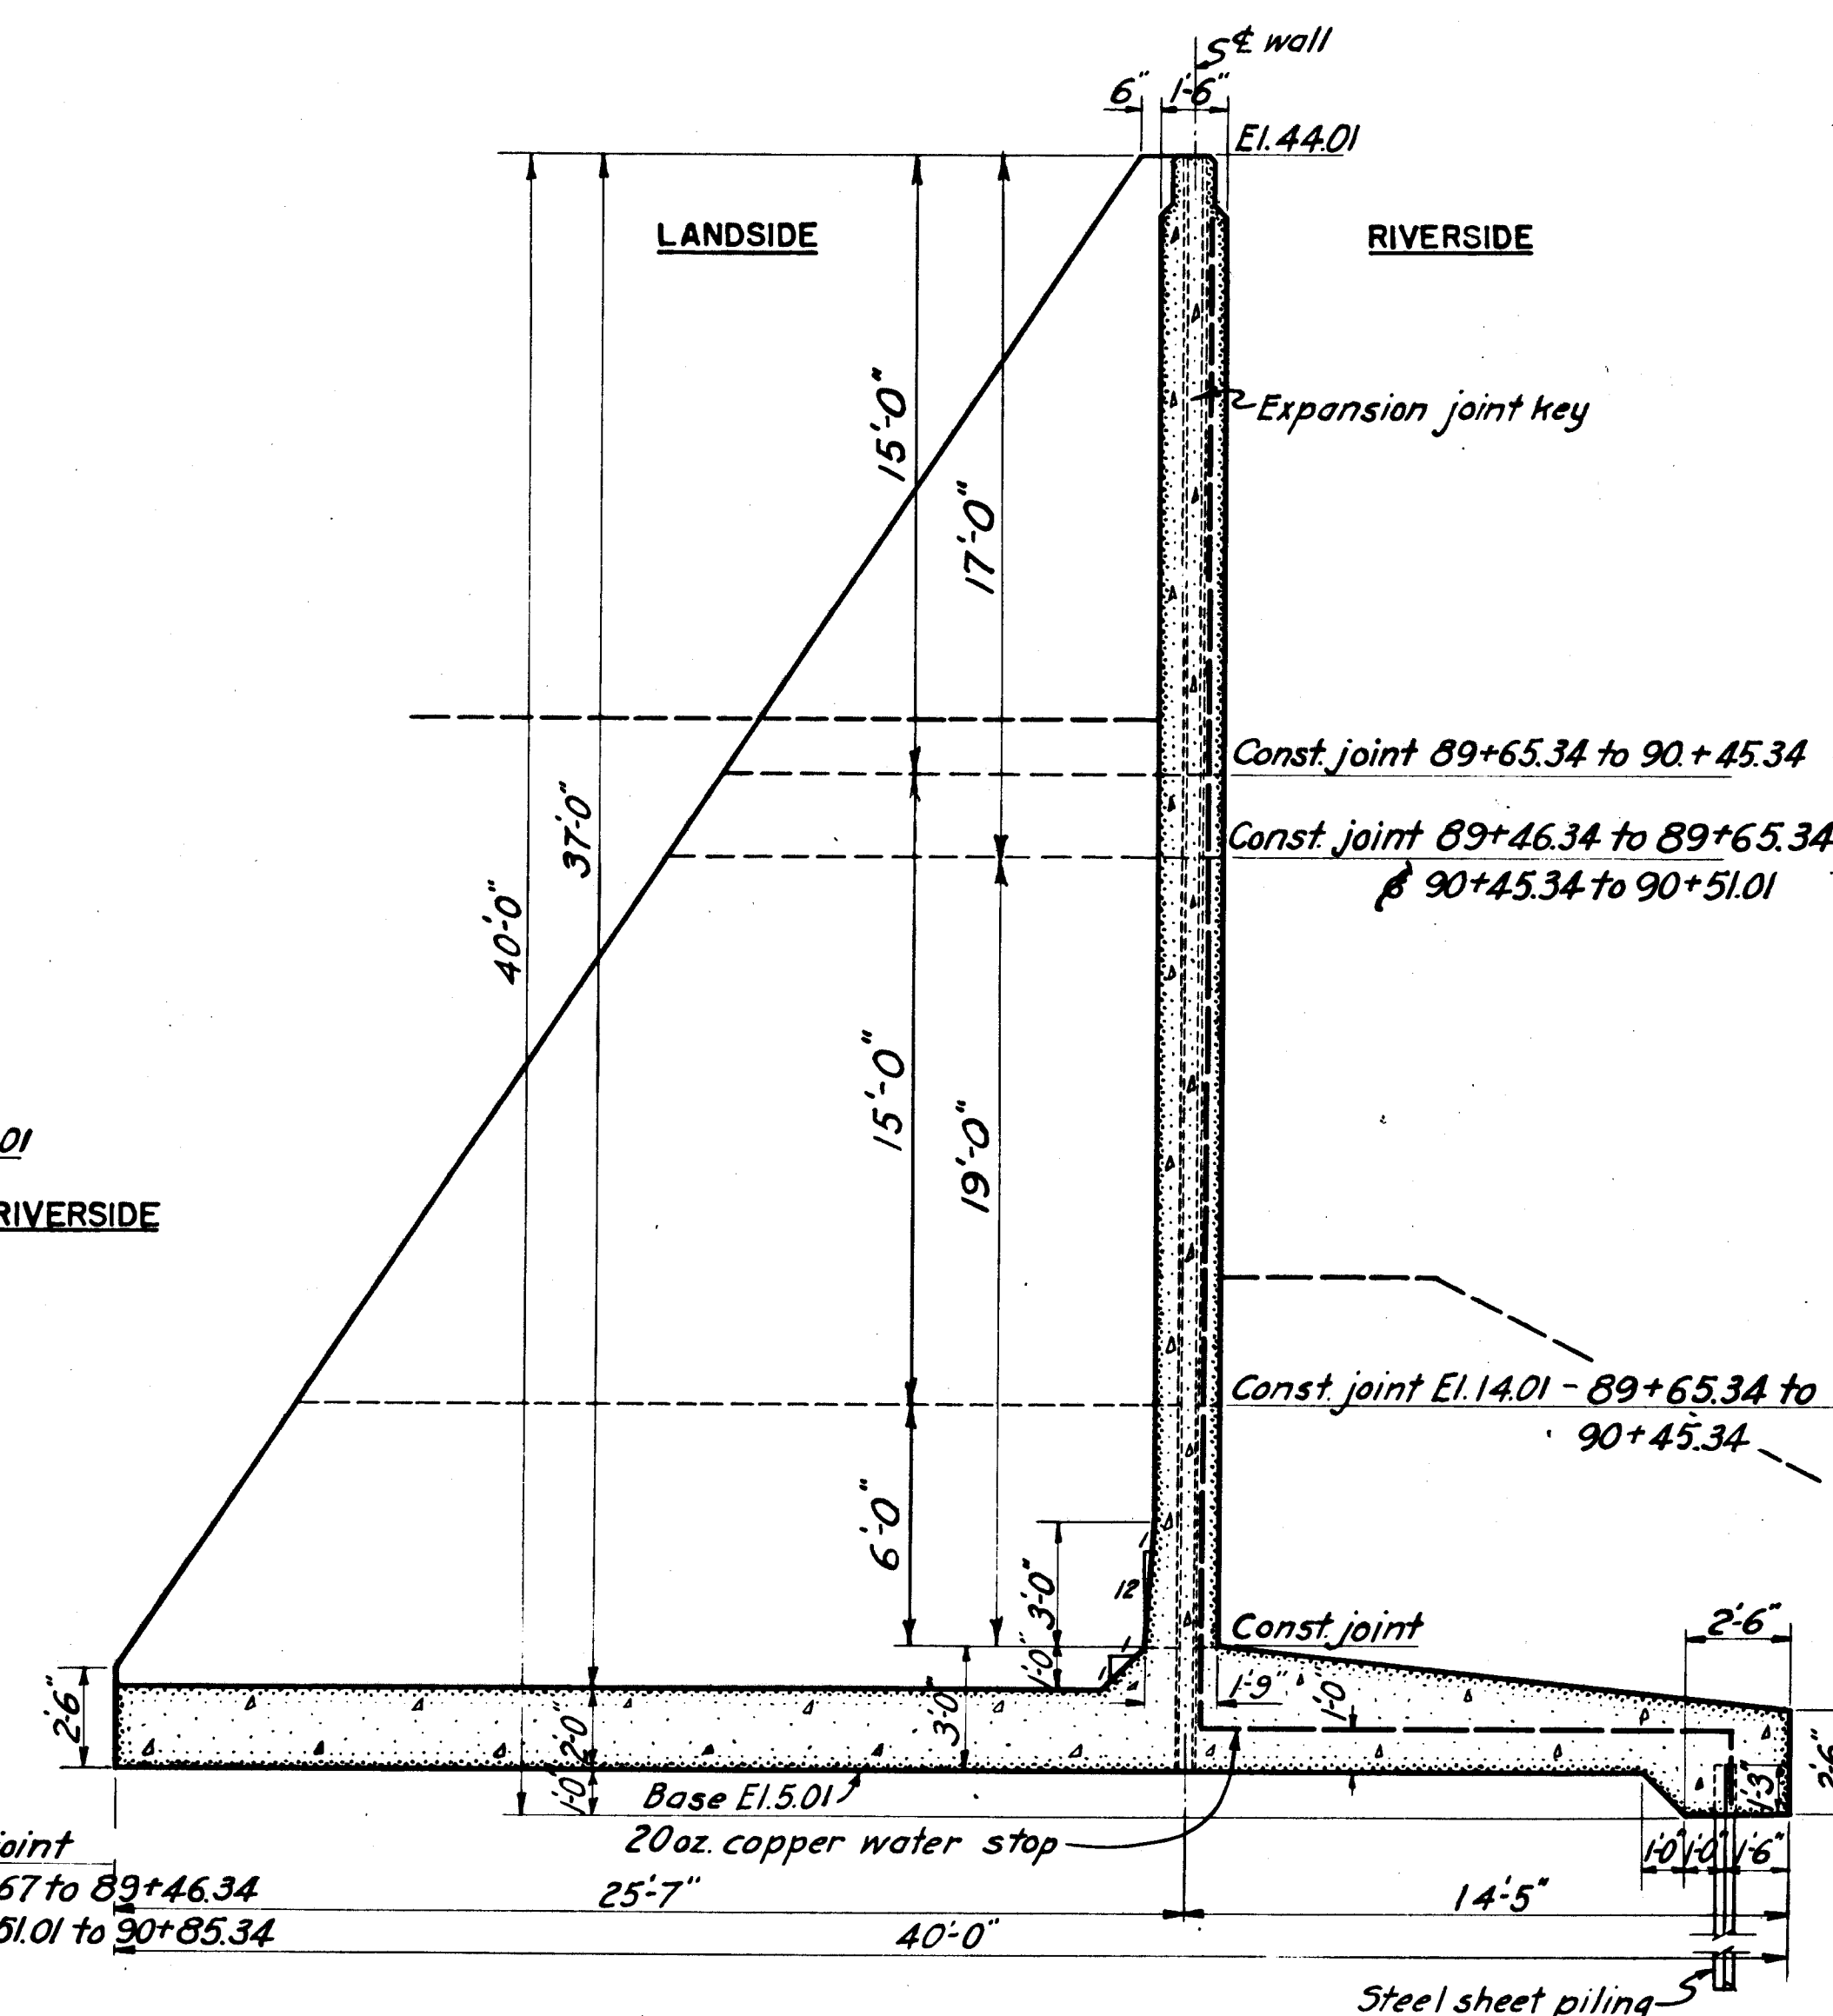STA. 89+17.67 TO STA. 89+46.34
STA. 90+51.01 TO STA. 90+91.01

37'-0" WALL SECTION

STA. 89+46.34 TO STA. 90+51.01

NOTES

For general notes applying to this sheet see Sheet No. 20.
For steel reinforcing details see Sheets No. 115, 120, 121, 123 & 125.
For additional architectural details see Sheet No. 76.

CONNECTICUT RIVER FLOOD CONTROL
HARTFORD DIKE
RIVERFRONT, MORGAN ST. TO STA. 96+73.
CONCRETE WALL SECTIONS NO. 6

CONNECTICUT RIVER CONNECTICUT
IN 135 SHEETS SCALE: 1/4 IN. = 1 FT. SHEET NO. 75

U.S. ENGINEER OFFICE, PROVIDENCE, R.I., MAY 1940

SUBMITTED: APPROVAL RECOMMENDED: APPROVED:
SENIOR ENGINEER PRINCIPAL ENGINEER DISTRICT ENGINEER
HEAD, DESIGN SECTION CHIEF, F.O. ENGINEERING DIV. DISTRICT ENGINEER

DESIGNED: DRAWN: R.S.S. FISCAL YEAR 1940
TRACED: R.S.S. FILE NO. CT-4-2535
ASSOC. ENGINEER CHECKED: W.O.C.

12-31-45	As built revisions				
KEY	DATE	REVISION (Indicated by Δ)	REV. BY	CK. BY	AP. BY