


For concrete details, see Sheet No. 31.
The minimum cover for main steel reinforcement is 3" except where concrete is poured against earth in which case it is 4".
Bar splices are equal in length to forty diameters of the smaller bar.
Radius of bend of bars is equal to four diameters of the bar.
Payment for furnishing, bending, and placing of steel reinforcement was made under Item No. 25
Stationing from Sta. 0+11.57 to Sta. 4+71.19 is along west face of wall and is denoted by letters "W.S."

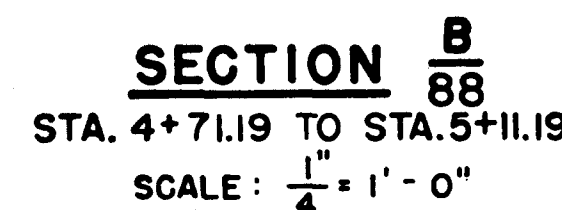

	12-31-45	As built revisions				
KEY	DATE	REVISION (Indicated by Δ)	REV. BY	CK. BY	AP. B.	

CONNECTICUT RIVER FLOOD CONTROL
HARTFORD DIKE
 RIVERFRONT, MORGAN ST. TO STA. 96+73
 WALL-STA. 3+97.14 TO STA. 5+11.9
 STEEL REINFORCEMENT