
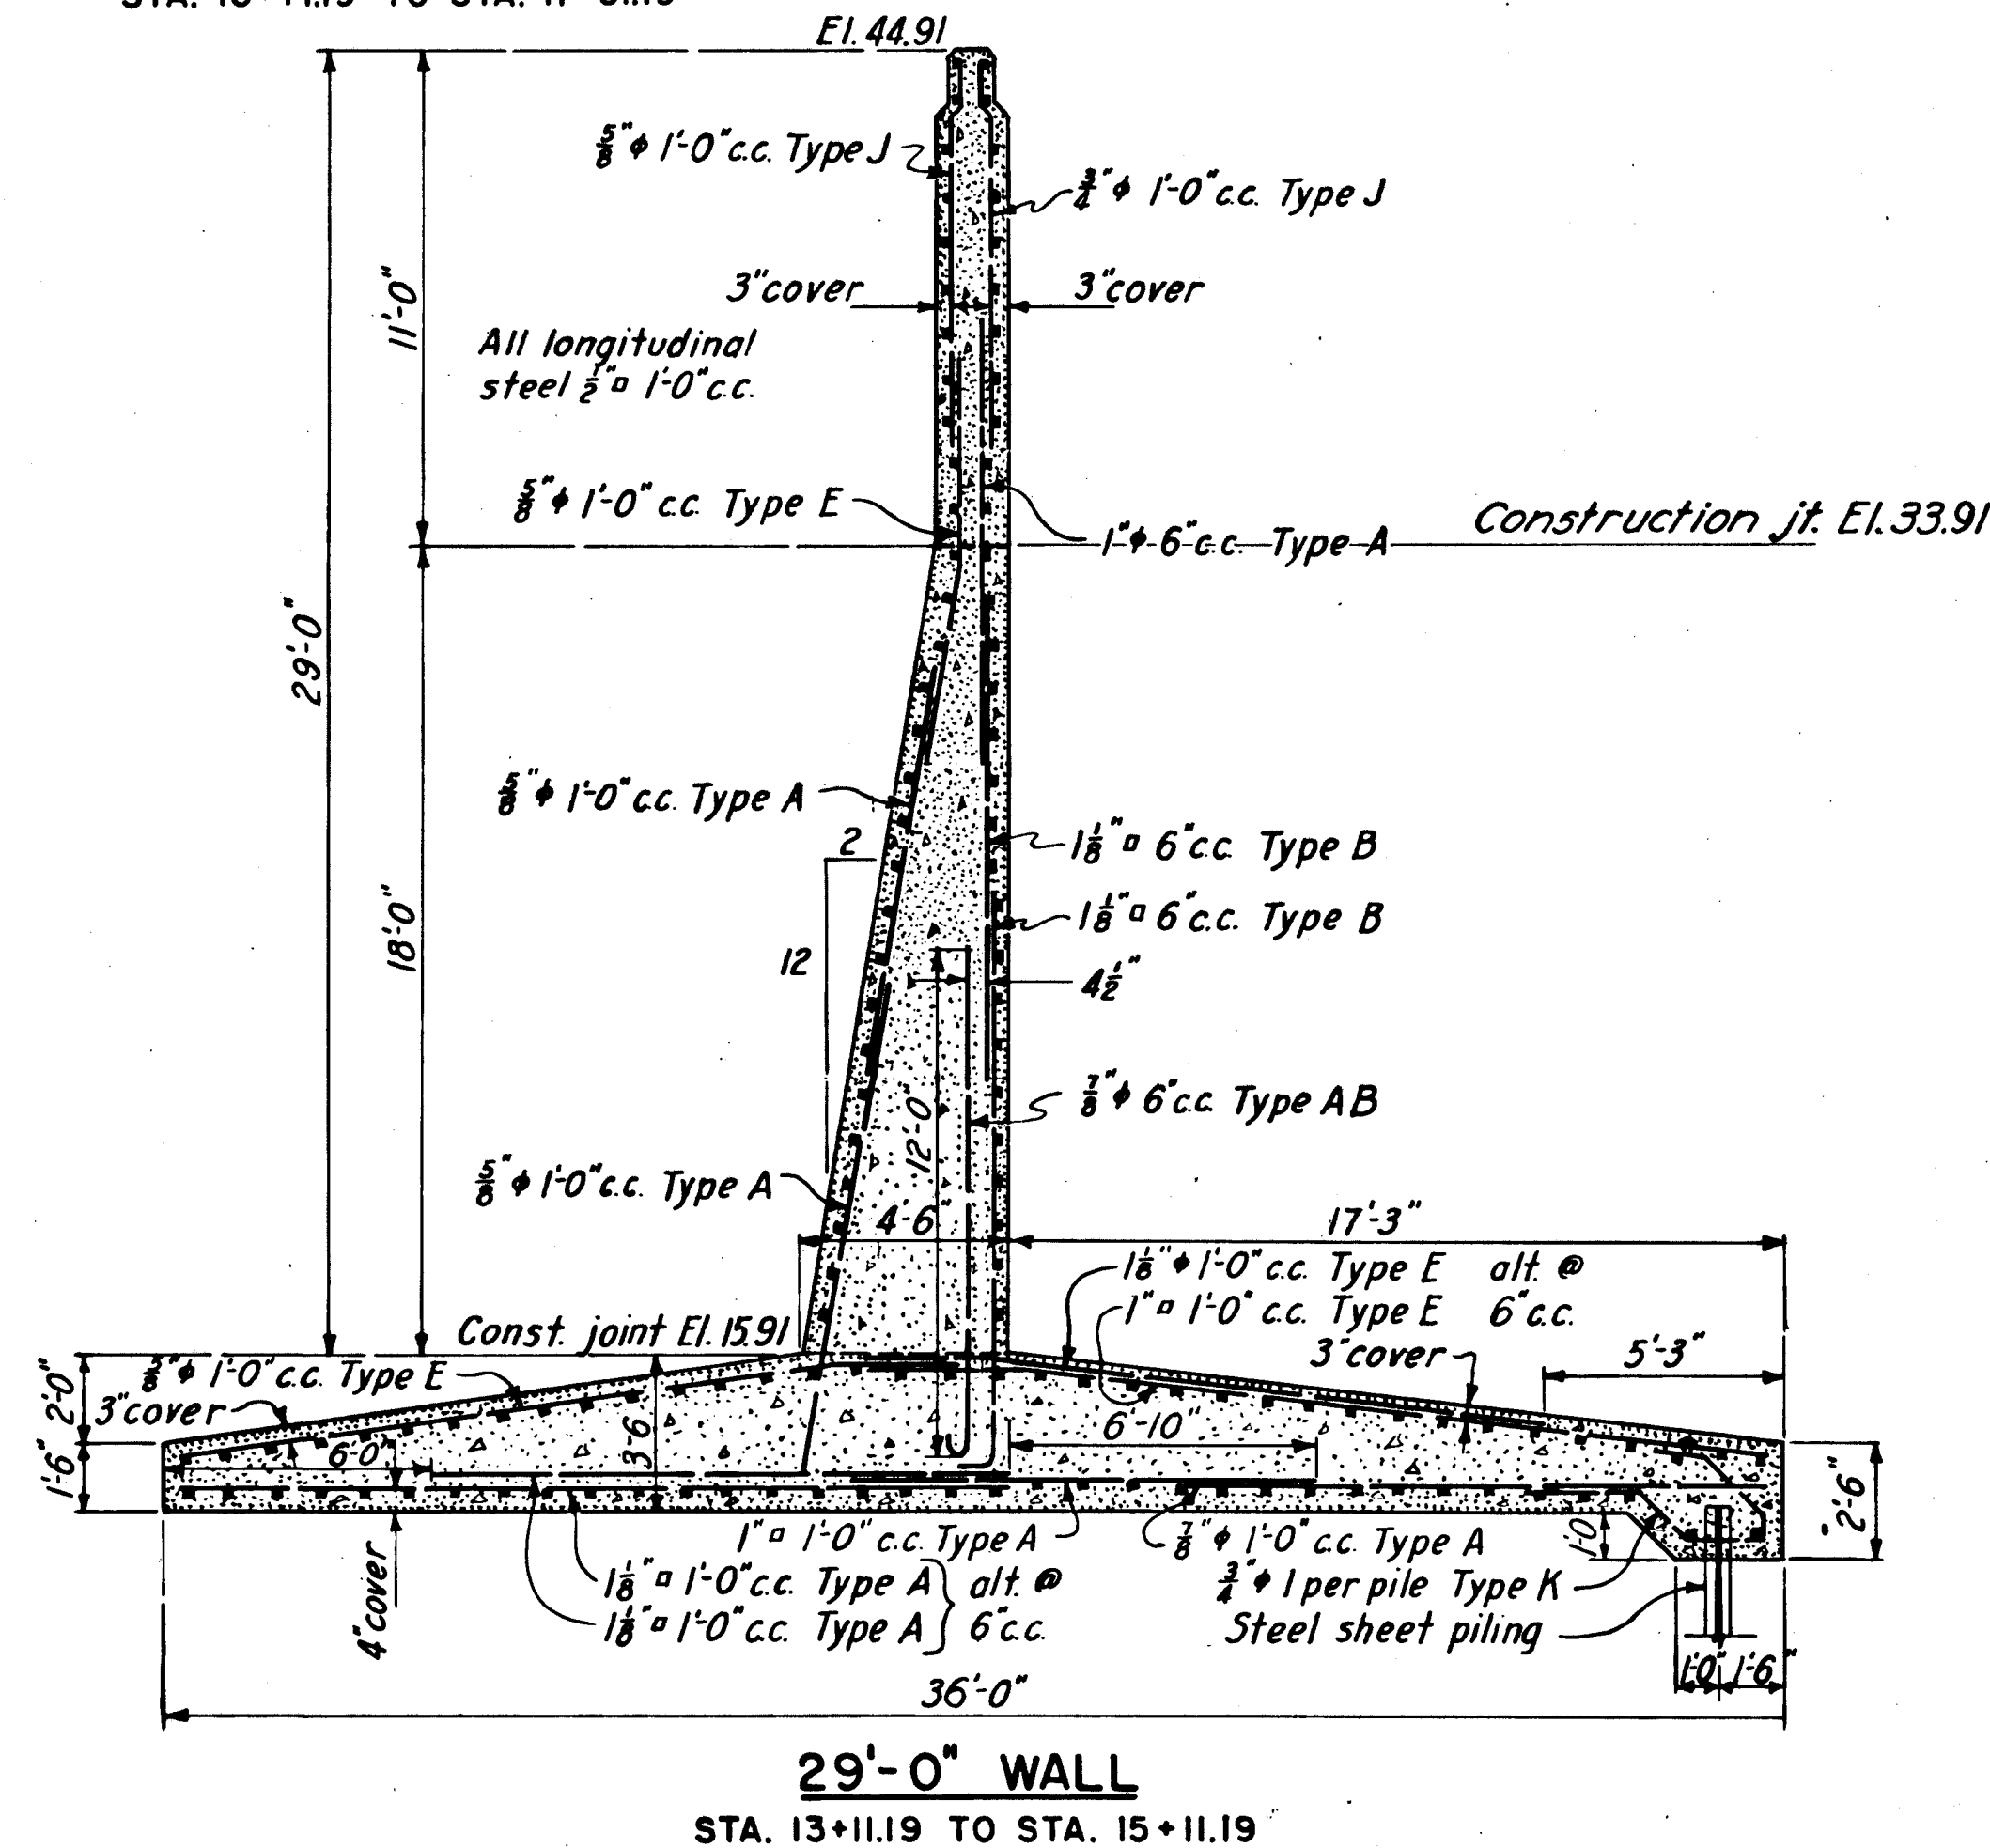
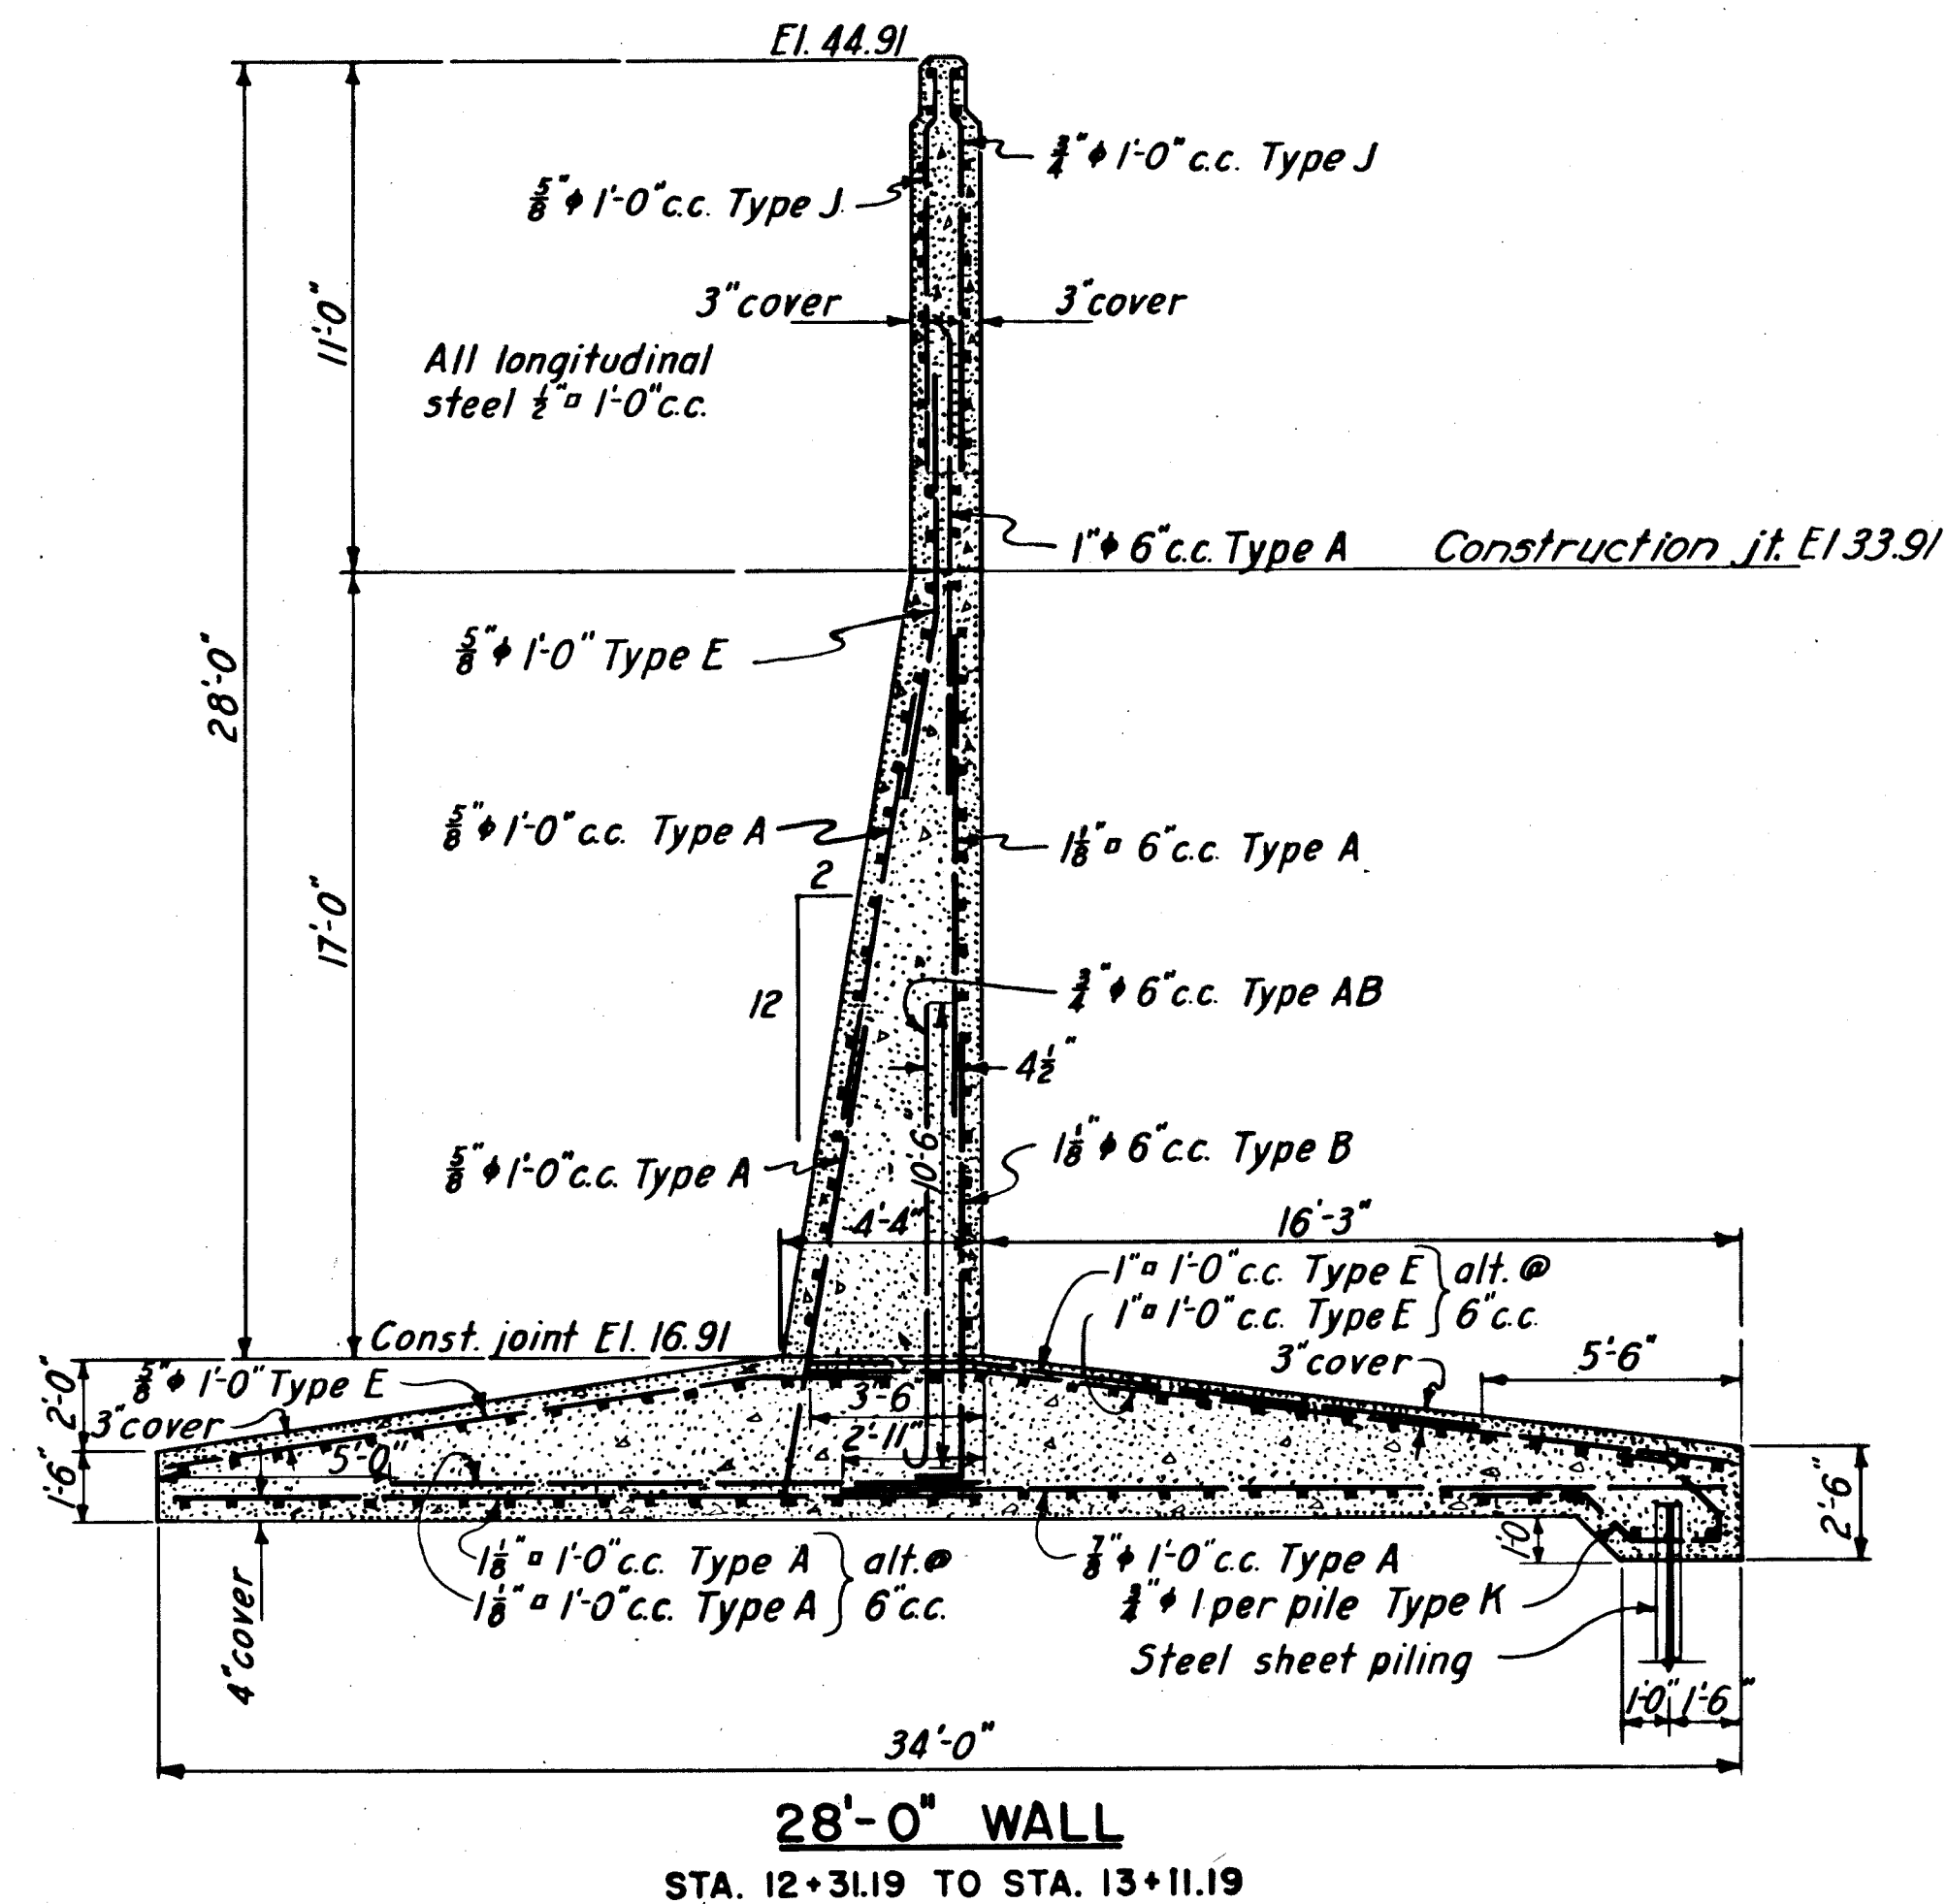
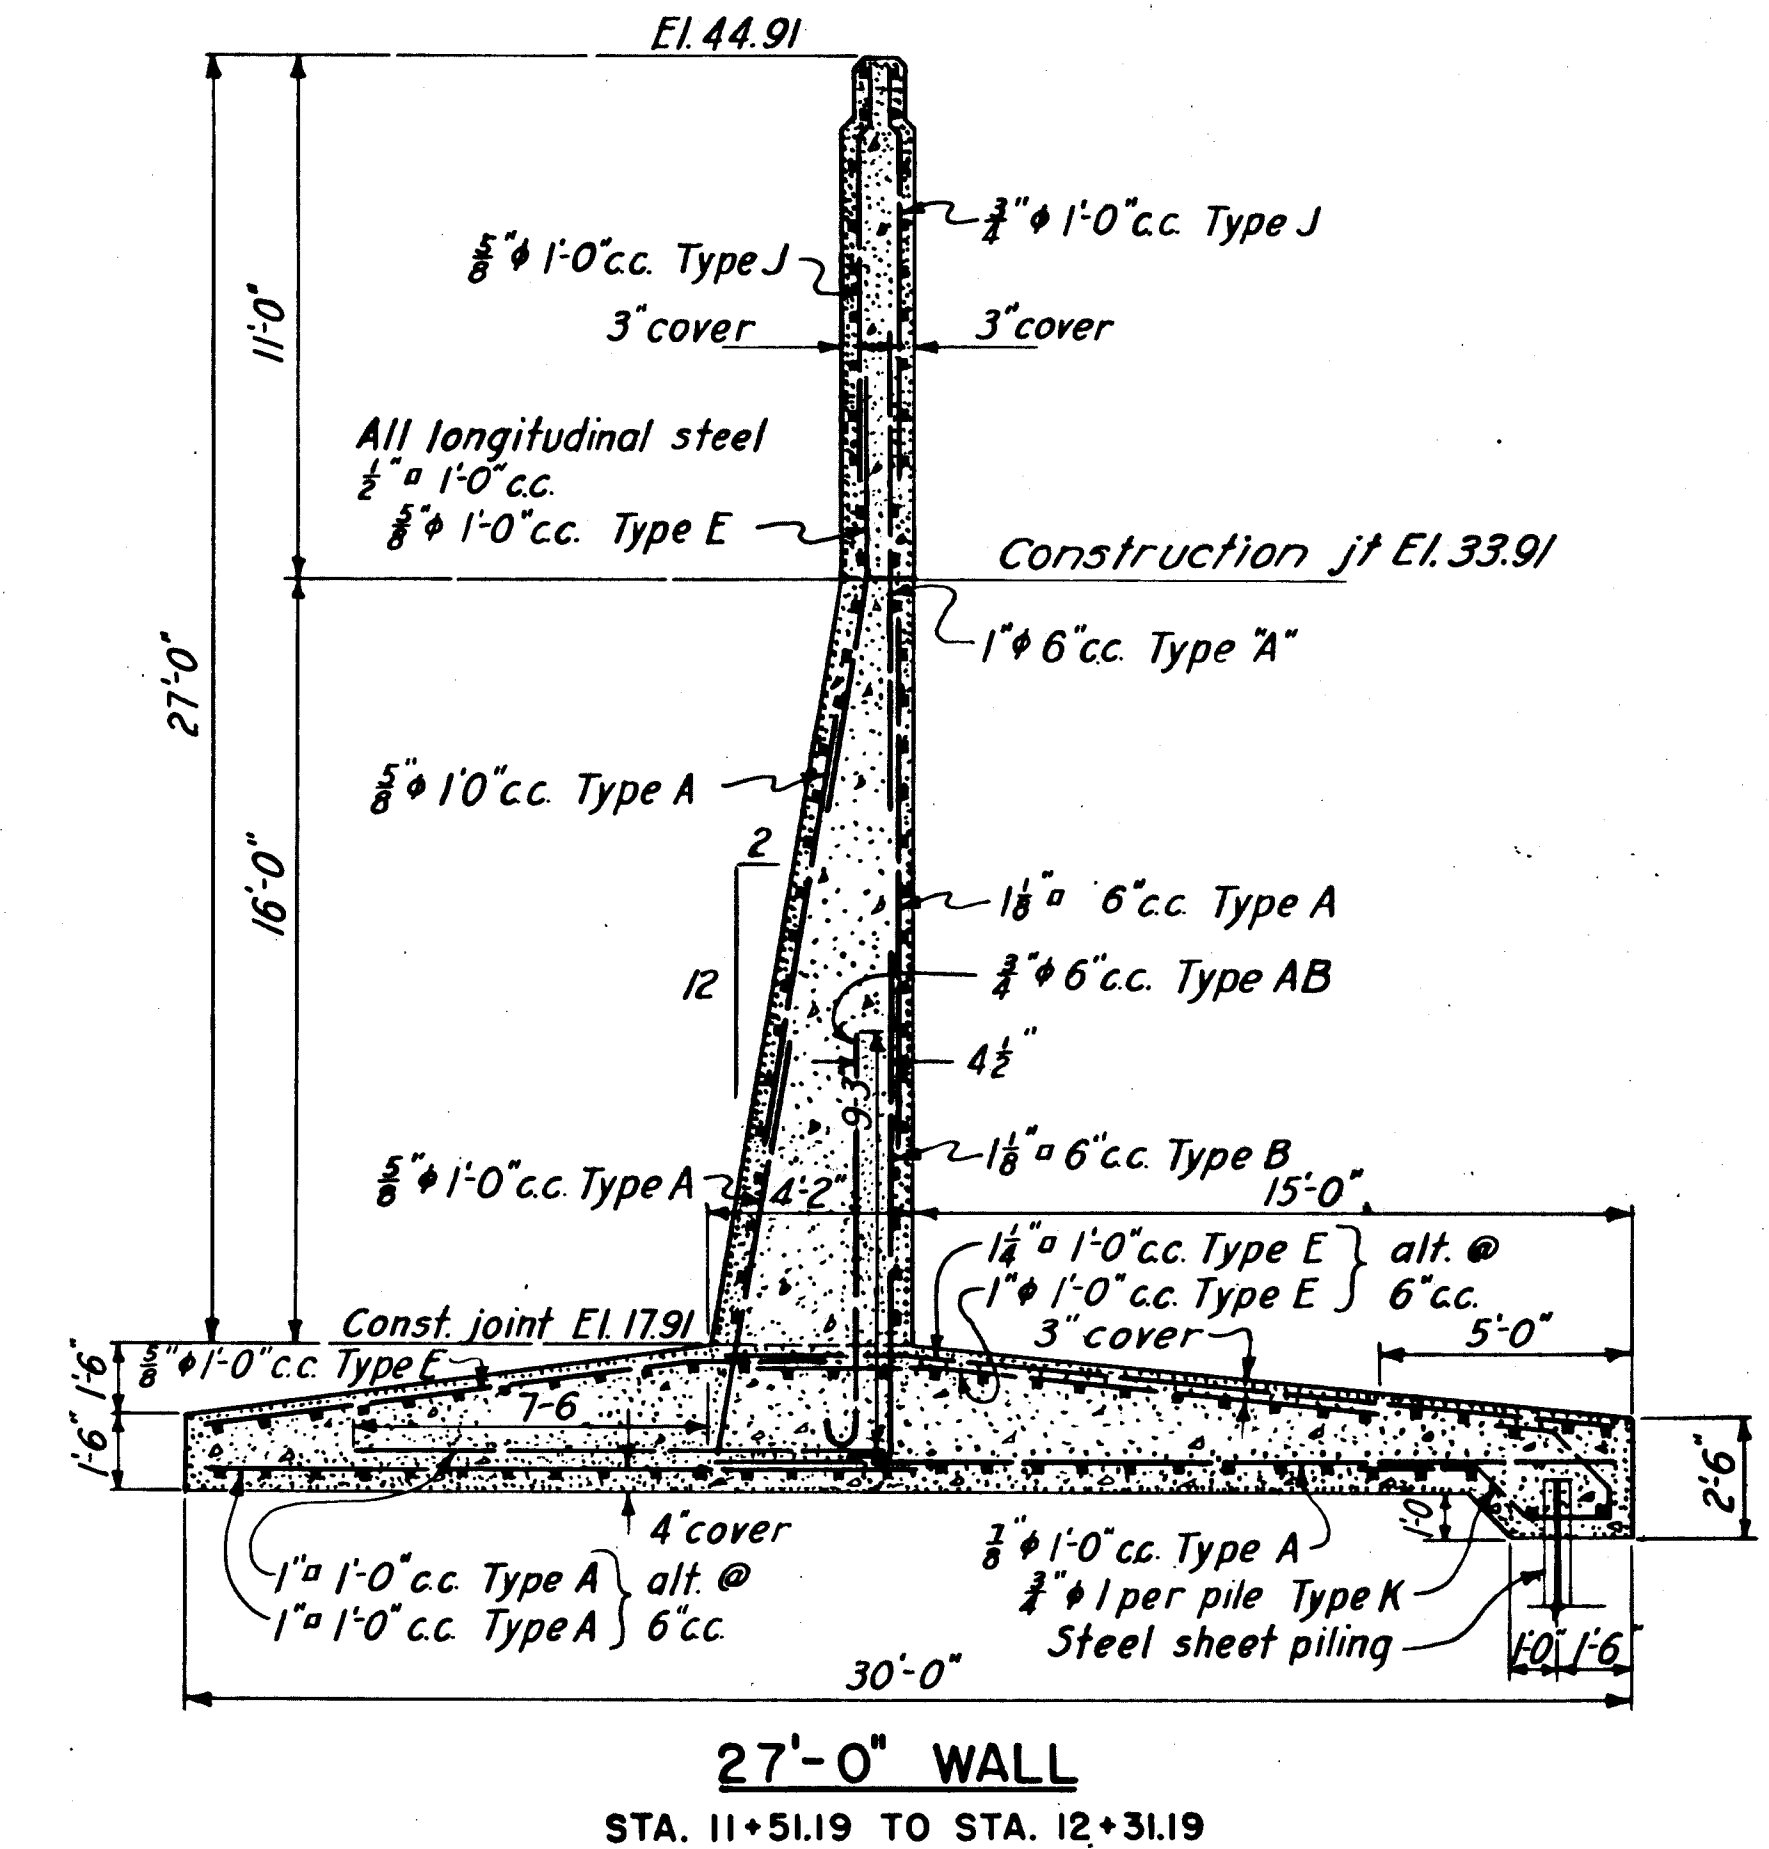
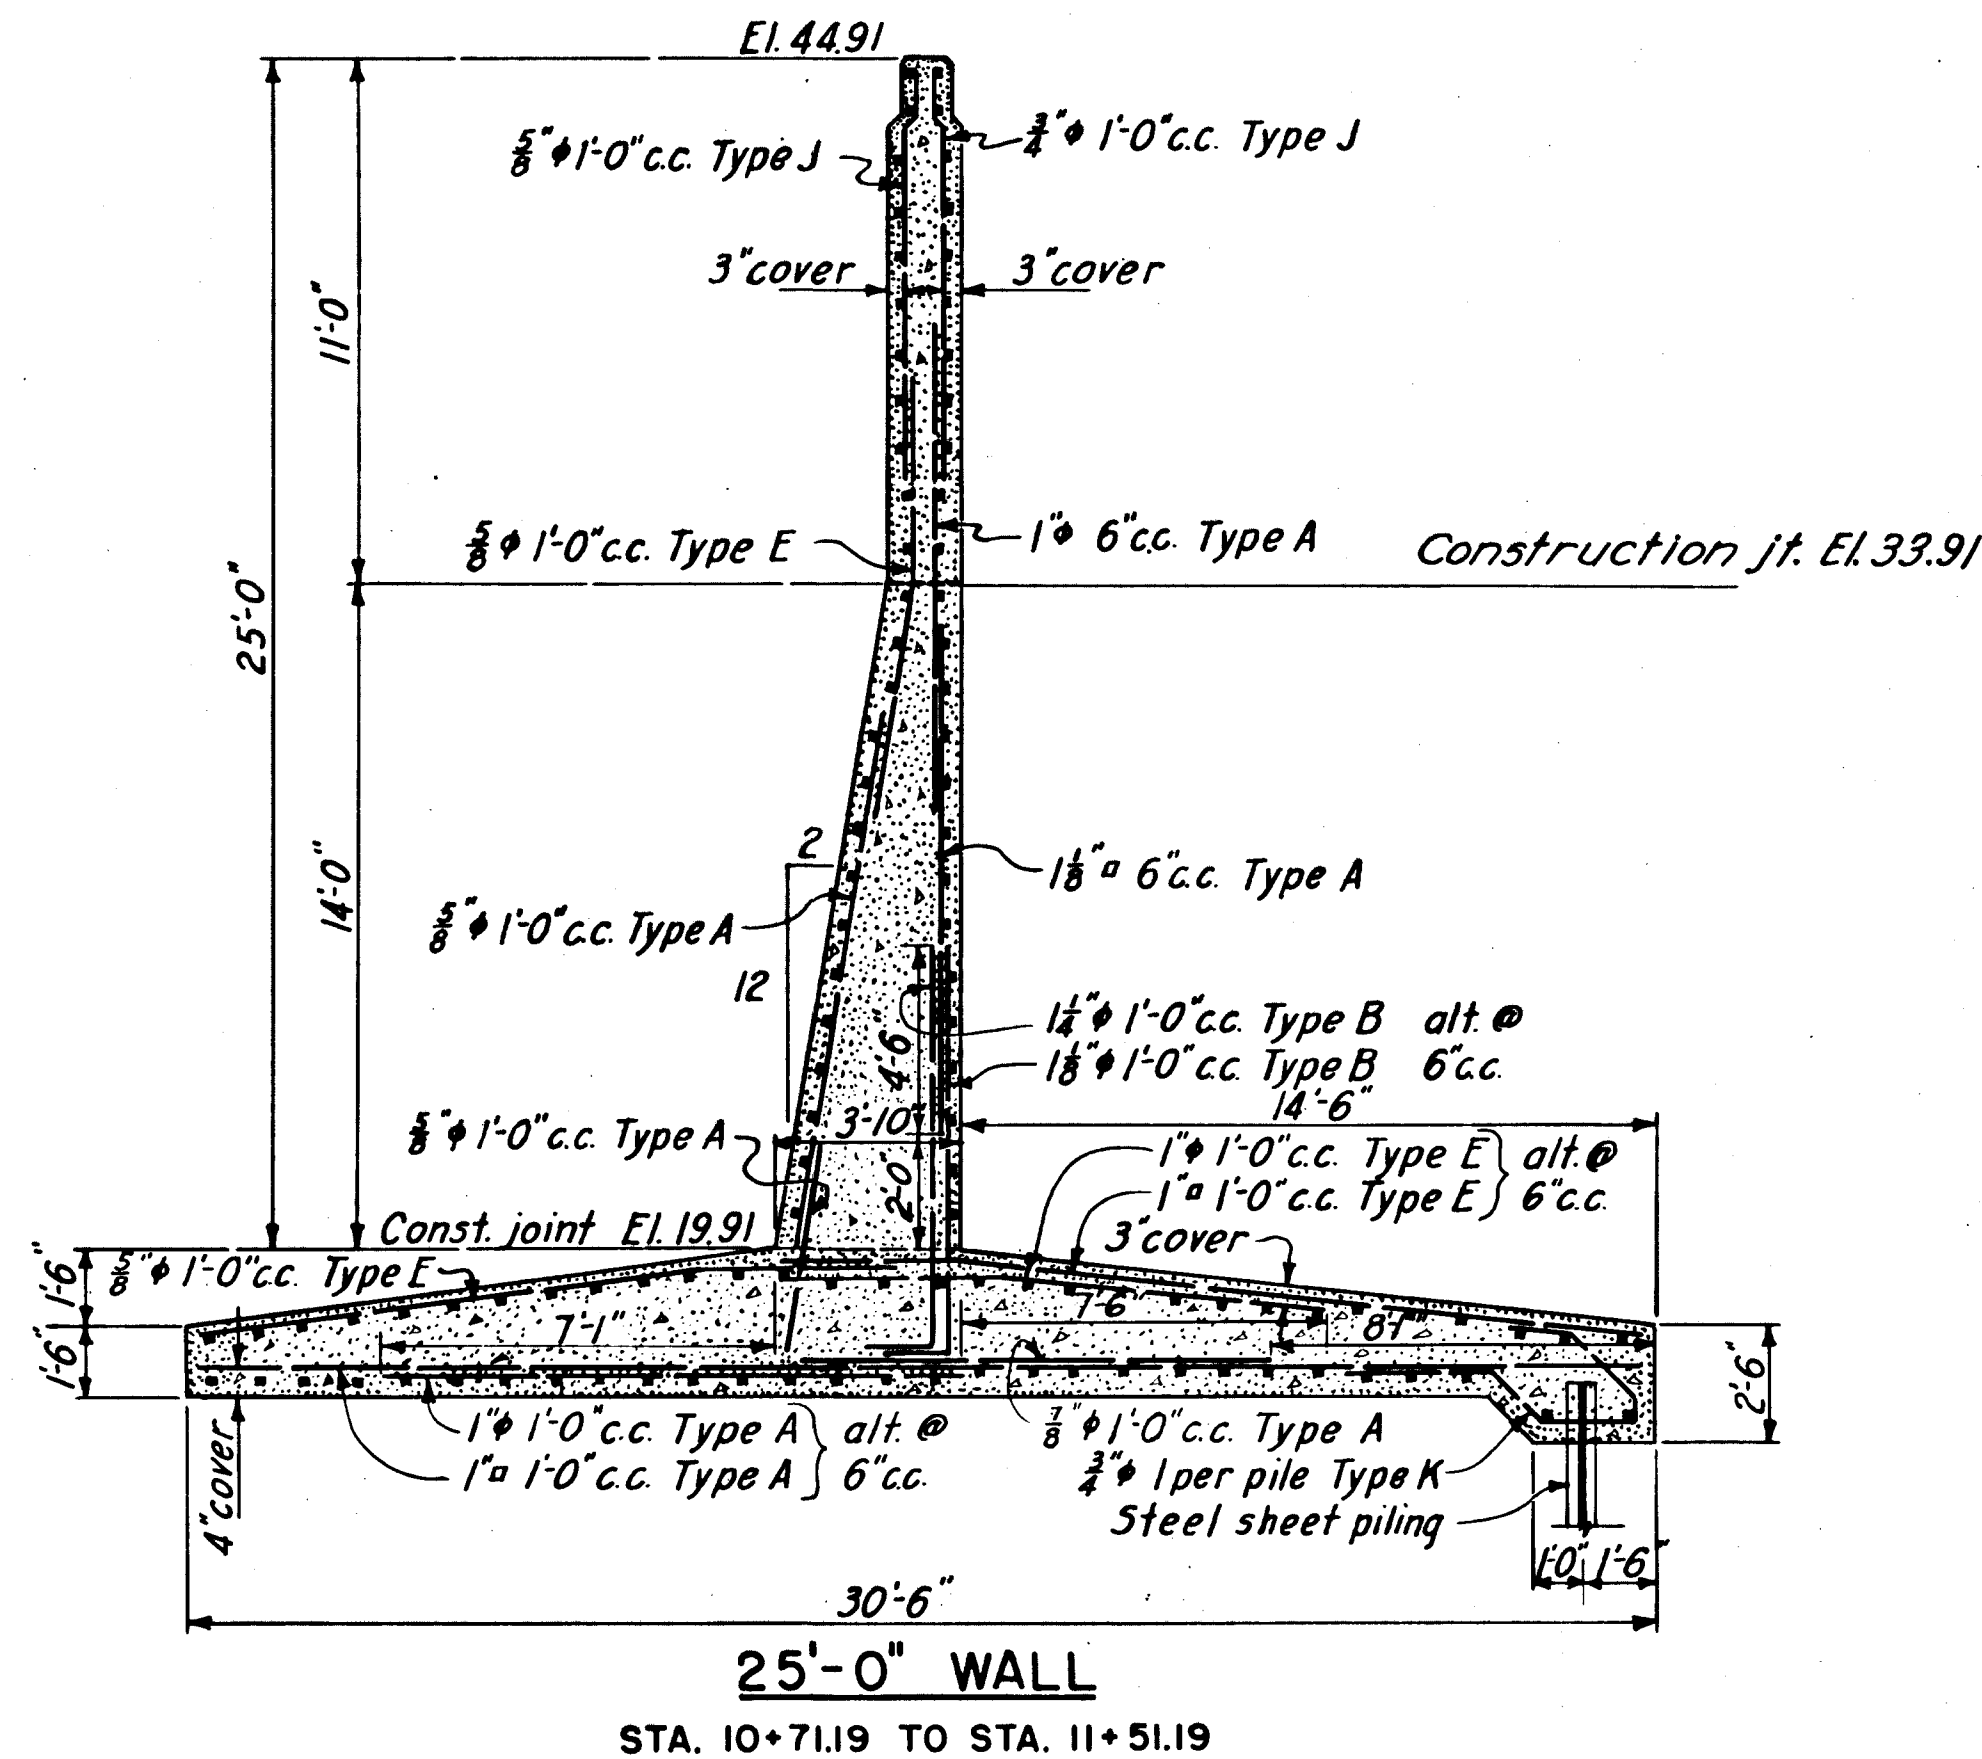
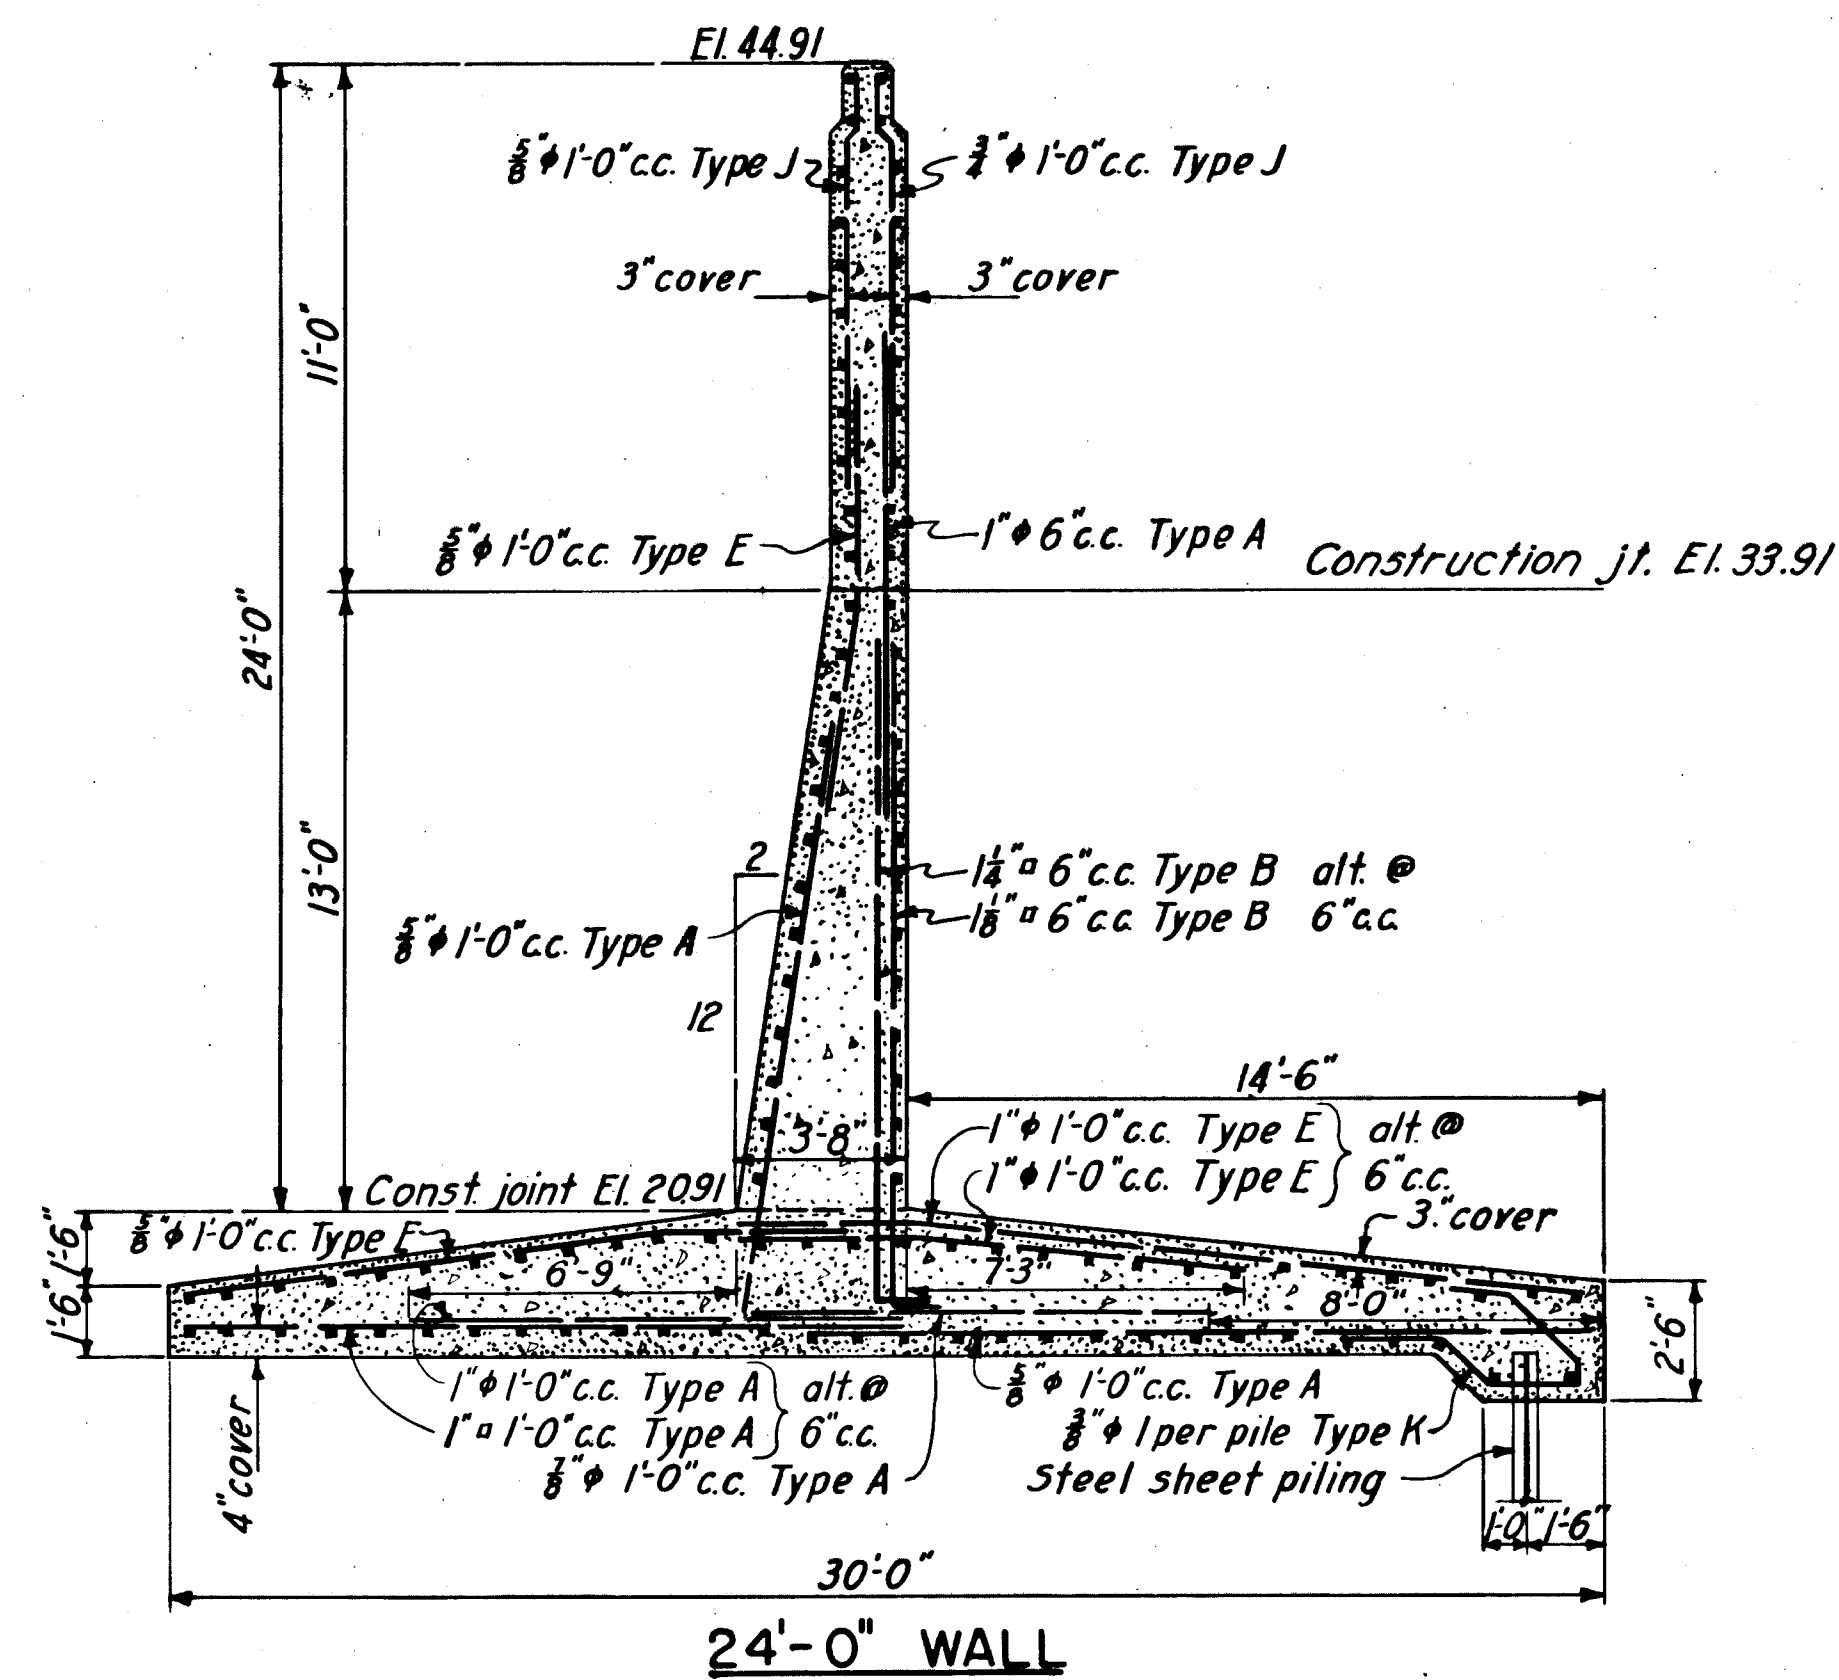


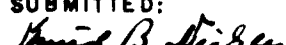

NOTES

For concrete details see Sheet No. 71
For general notes see Sheet No. 89

	12-31-45	As built revisions			
KEY	DATE	REVISION	(Indicated by Δ)	REV.BY	CK.BY AR.BY
CONNECTICUT RIVER FLOOD CONTROL					
HARTFORD DIKE					
RIVERFRONT, MORGAN ST. TO STA. 96+73					
WALL- STA. 10 + 31.19 TO STA. 15+11.19					
STEEL REINFORCEMENT					
CONNECTICUT RIVER			CONNECTICUT		
IN 135 SHEETS			SCALE: 1/4 IN = 1 FT.		SHEET NO. 90
					
U.S. ENGINEER OFFICE, PROVIDENCE, R.I., MAY 1940					
SUBMITTED:		APPROVAL RECOMMENDED:		APPROVED:	
					
SENIOR ENGINEER		PRINCIPAL ENGINEER		LTCOL, CORPS OF ENGINEERS	
HEAD, DESIGN SECTION		CHIEF, F.C. ENGINEERING DIV.		DISTRICT ENGINEER	
DESIGNED:		DRAWN: U. M. S.		FISCAL YEAR 1940	
		TRACED: R. M. W. & N. B.		FILE NO. CT-4-2550	
ASSOC. ENGINEER		CHECKED: A. W.			