
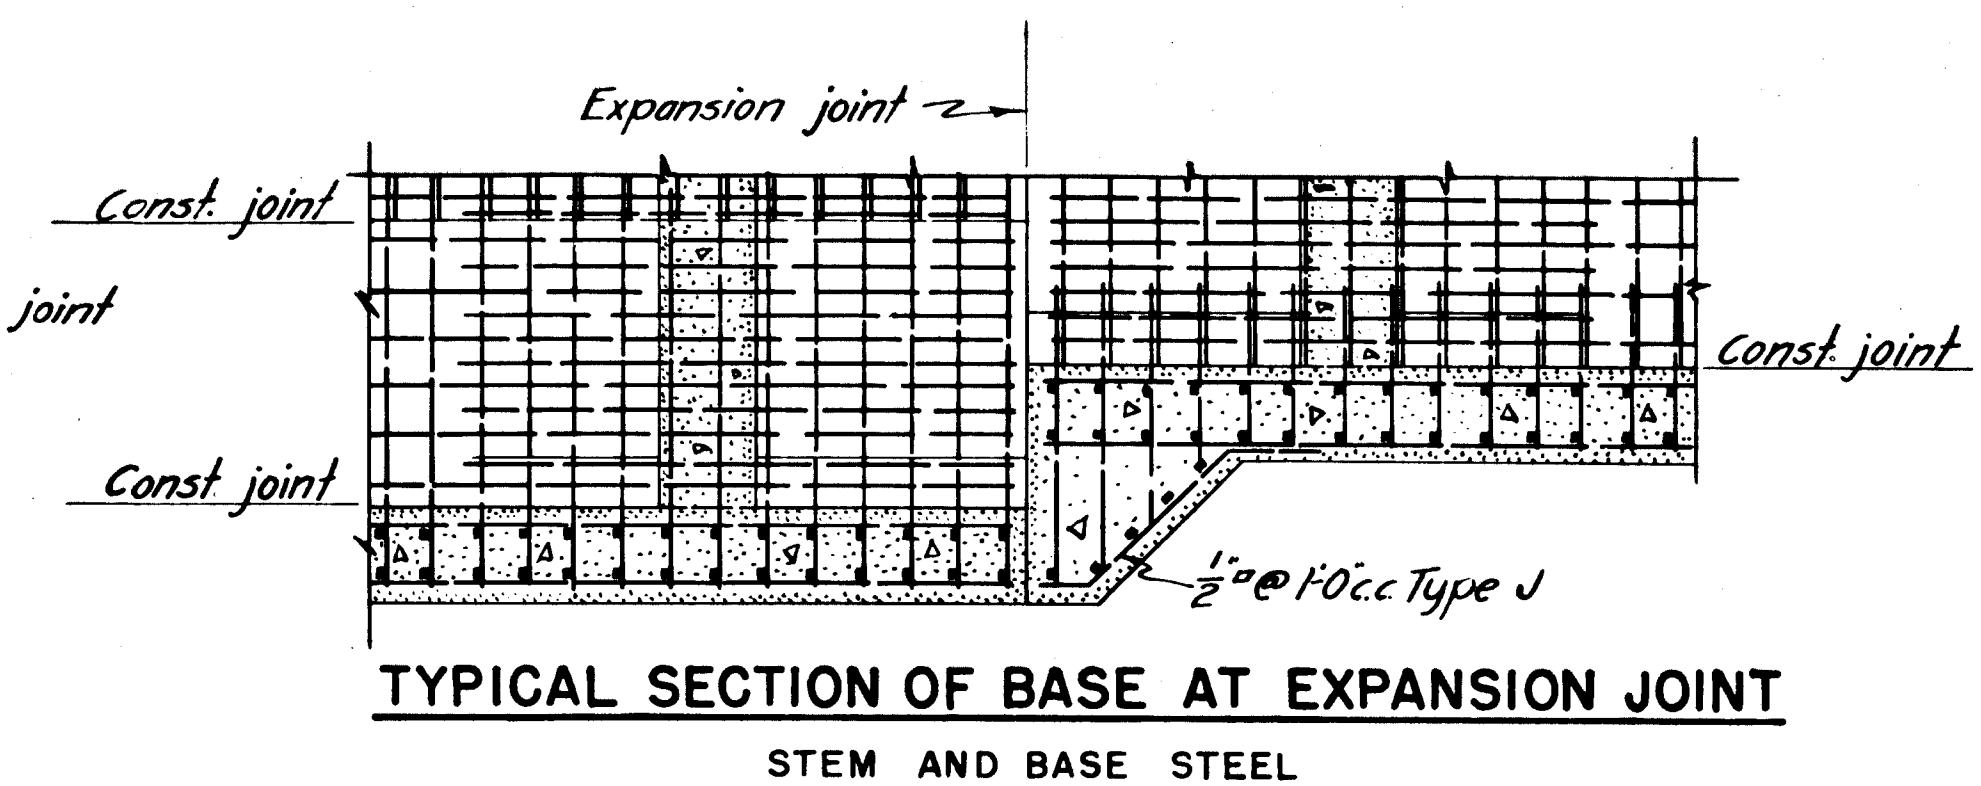
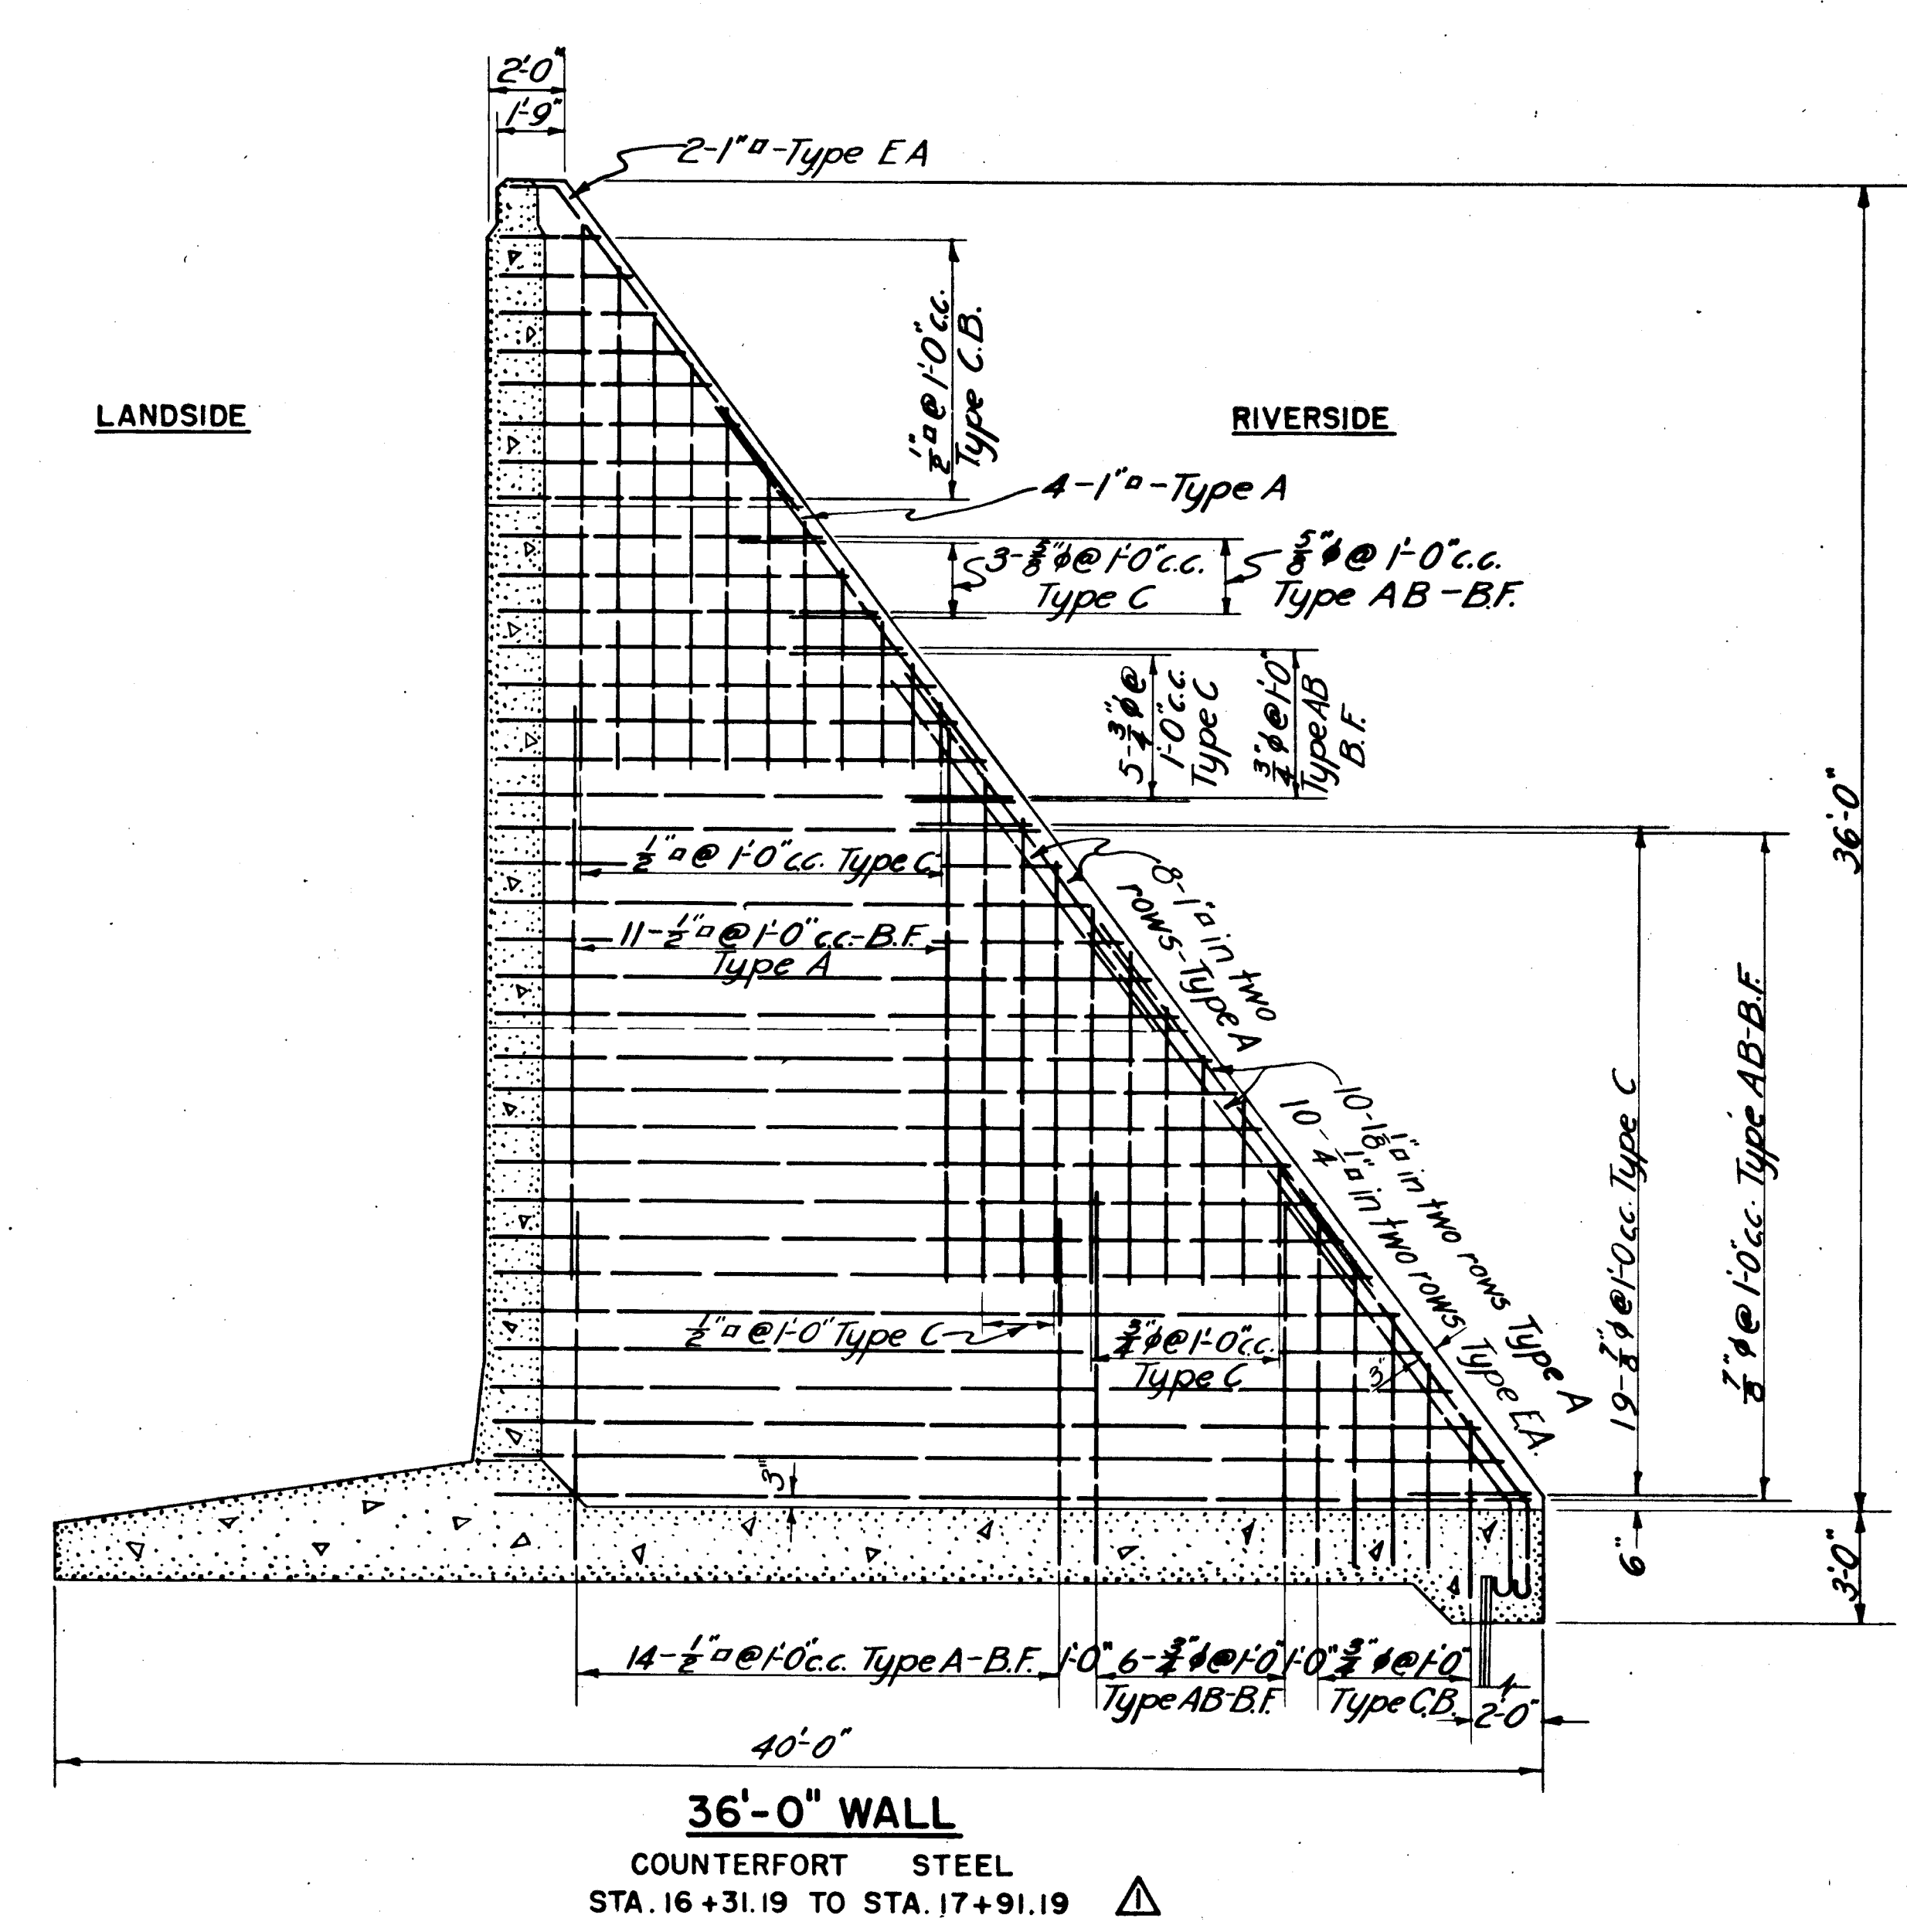
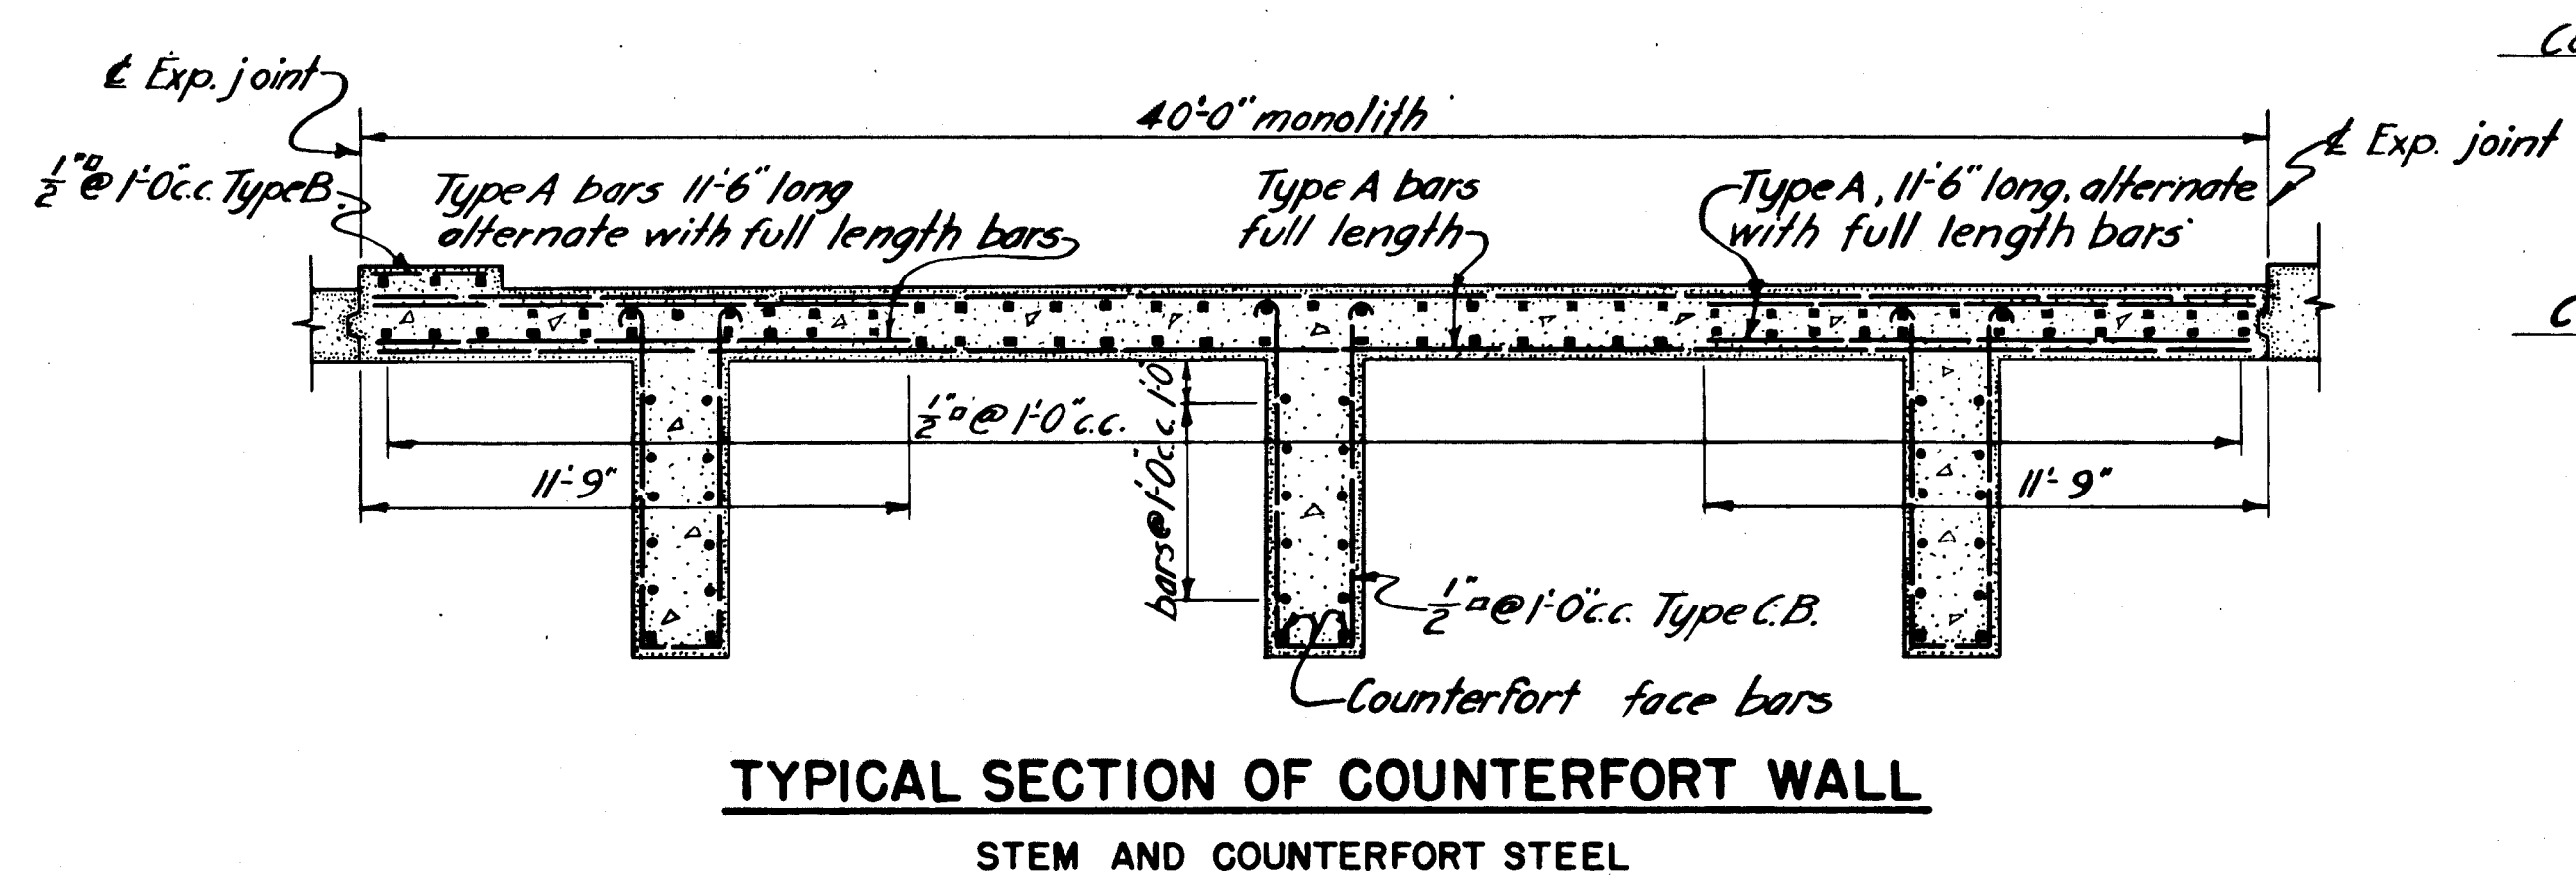


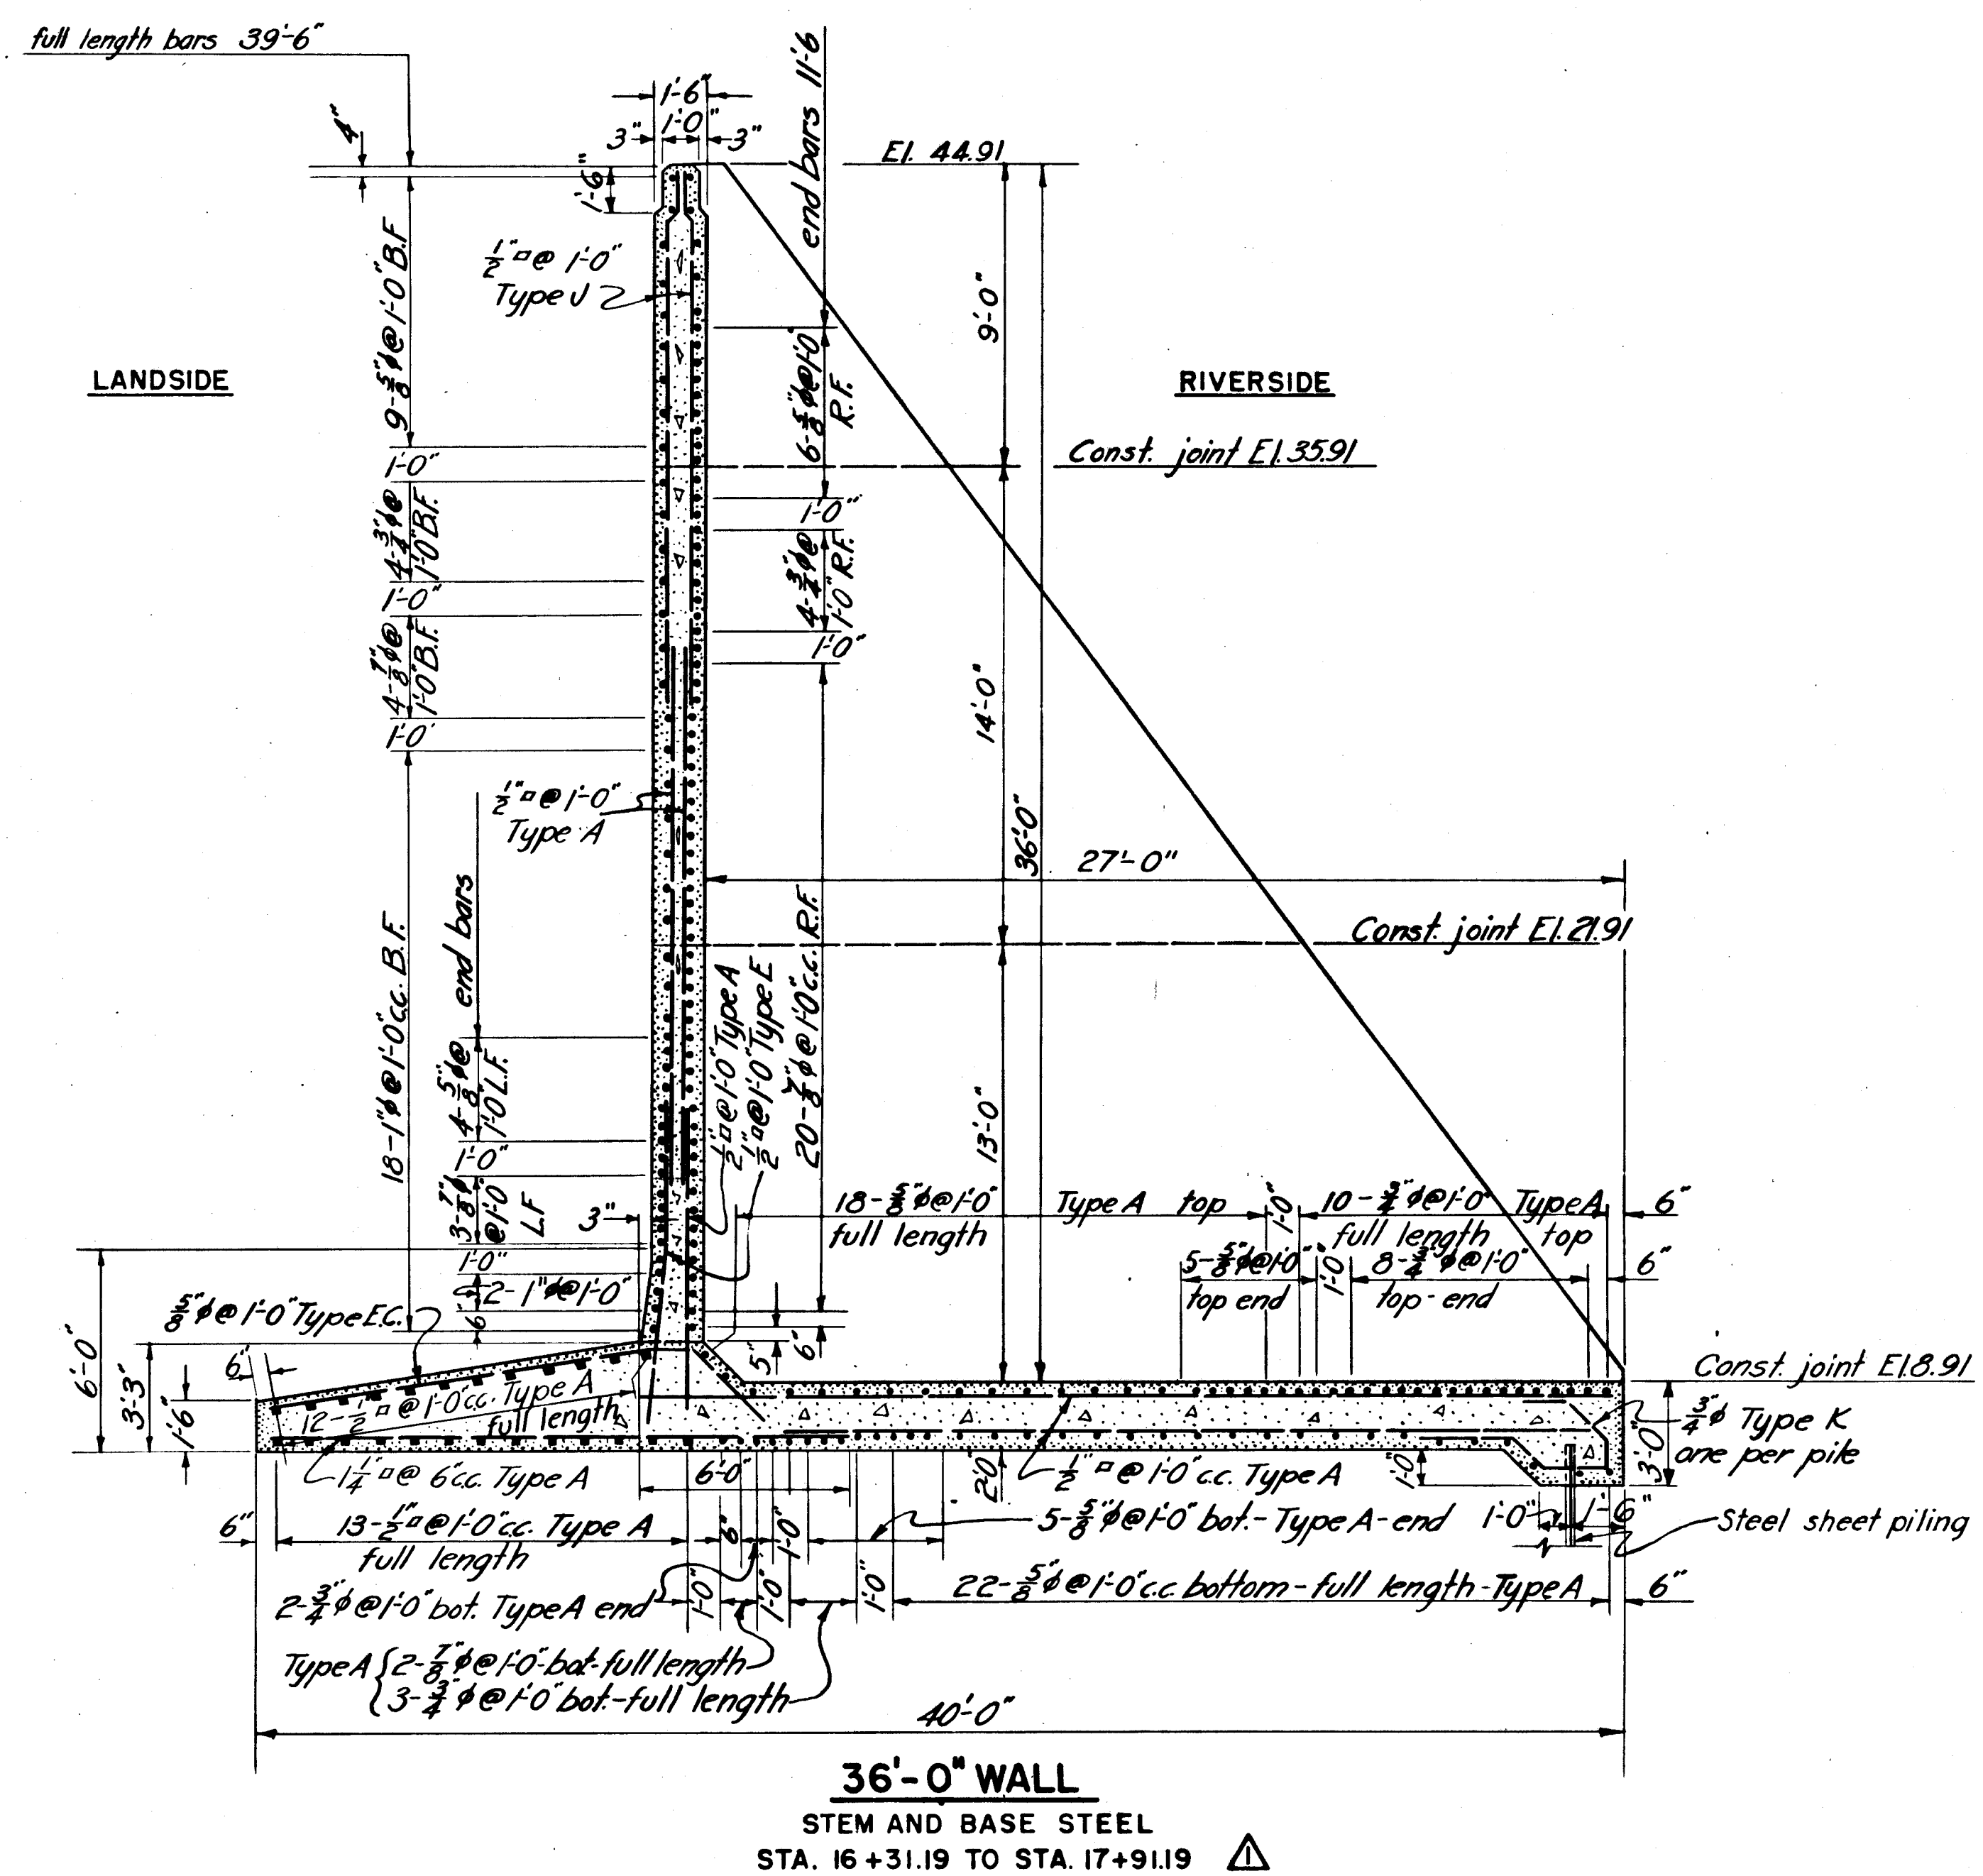

NOTES

For concrete details see Sheet No. 72
For general notes see Sheet No. 89

CONNECTICUT RIVER FLOOD CONTROL
HARTFORD DIKE
RIVERFRONT, MORGAN ST. TO STA. 96+73
WALL-STA. 16+31.19 TO STA. 17+91.19
STEEL REINFORCEMENT

CONNECTICUT RIVER
IN 135 SHEETS
SCALE: 1/4" = 1 FT.
SHEET NO. 92

U. S. ENGINEER OFFICE, PROVIDENCE, R.I., MAY 1940

SUBMITTED: 12-31-45
DESIGNED: 8/26/40
CHECKED: J.M.V. 1/24/42

APPROVAL RECOMMENDED: J.M.V. 1/24/42
PRINCIPAL ENGINEER: J.M.V. 1/24/42
HEAD, DESIGN SECTION: J.M.V. 1/24/42
CHIEF, F.C. ENGINEERING DIV.: J.M.V. 1/24/42
LT. COL. CORPS OF ENGINEERS: J.M.V. 1/24/42
DISTRICT ENGINEER: J.M.V. 1/24/42

DRAWN: J.M.V. 1/24/42
TRACED: F.J.S. 1/24/42
CHECKED: J.M.V. 1/24/42

FISCAL YEAR 1940
FILE NO. CT-4-2552

KEY	DATE	REVISION (Indicated by Δ)	REV. BY	CK. BY	AP. BY
Δ	12-31-45	As built revisions			
Δ	8/26/40	Wall stations changed	J.M.V.	1/24/42	J.M.V.