



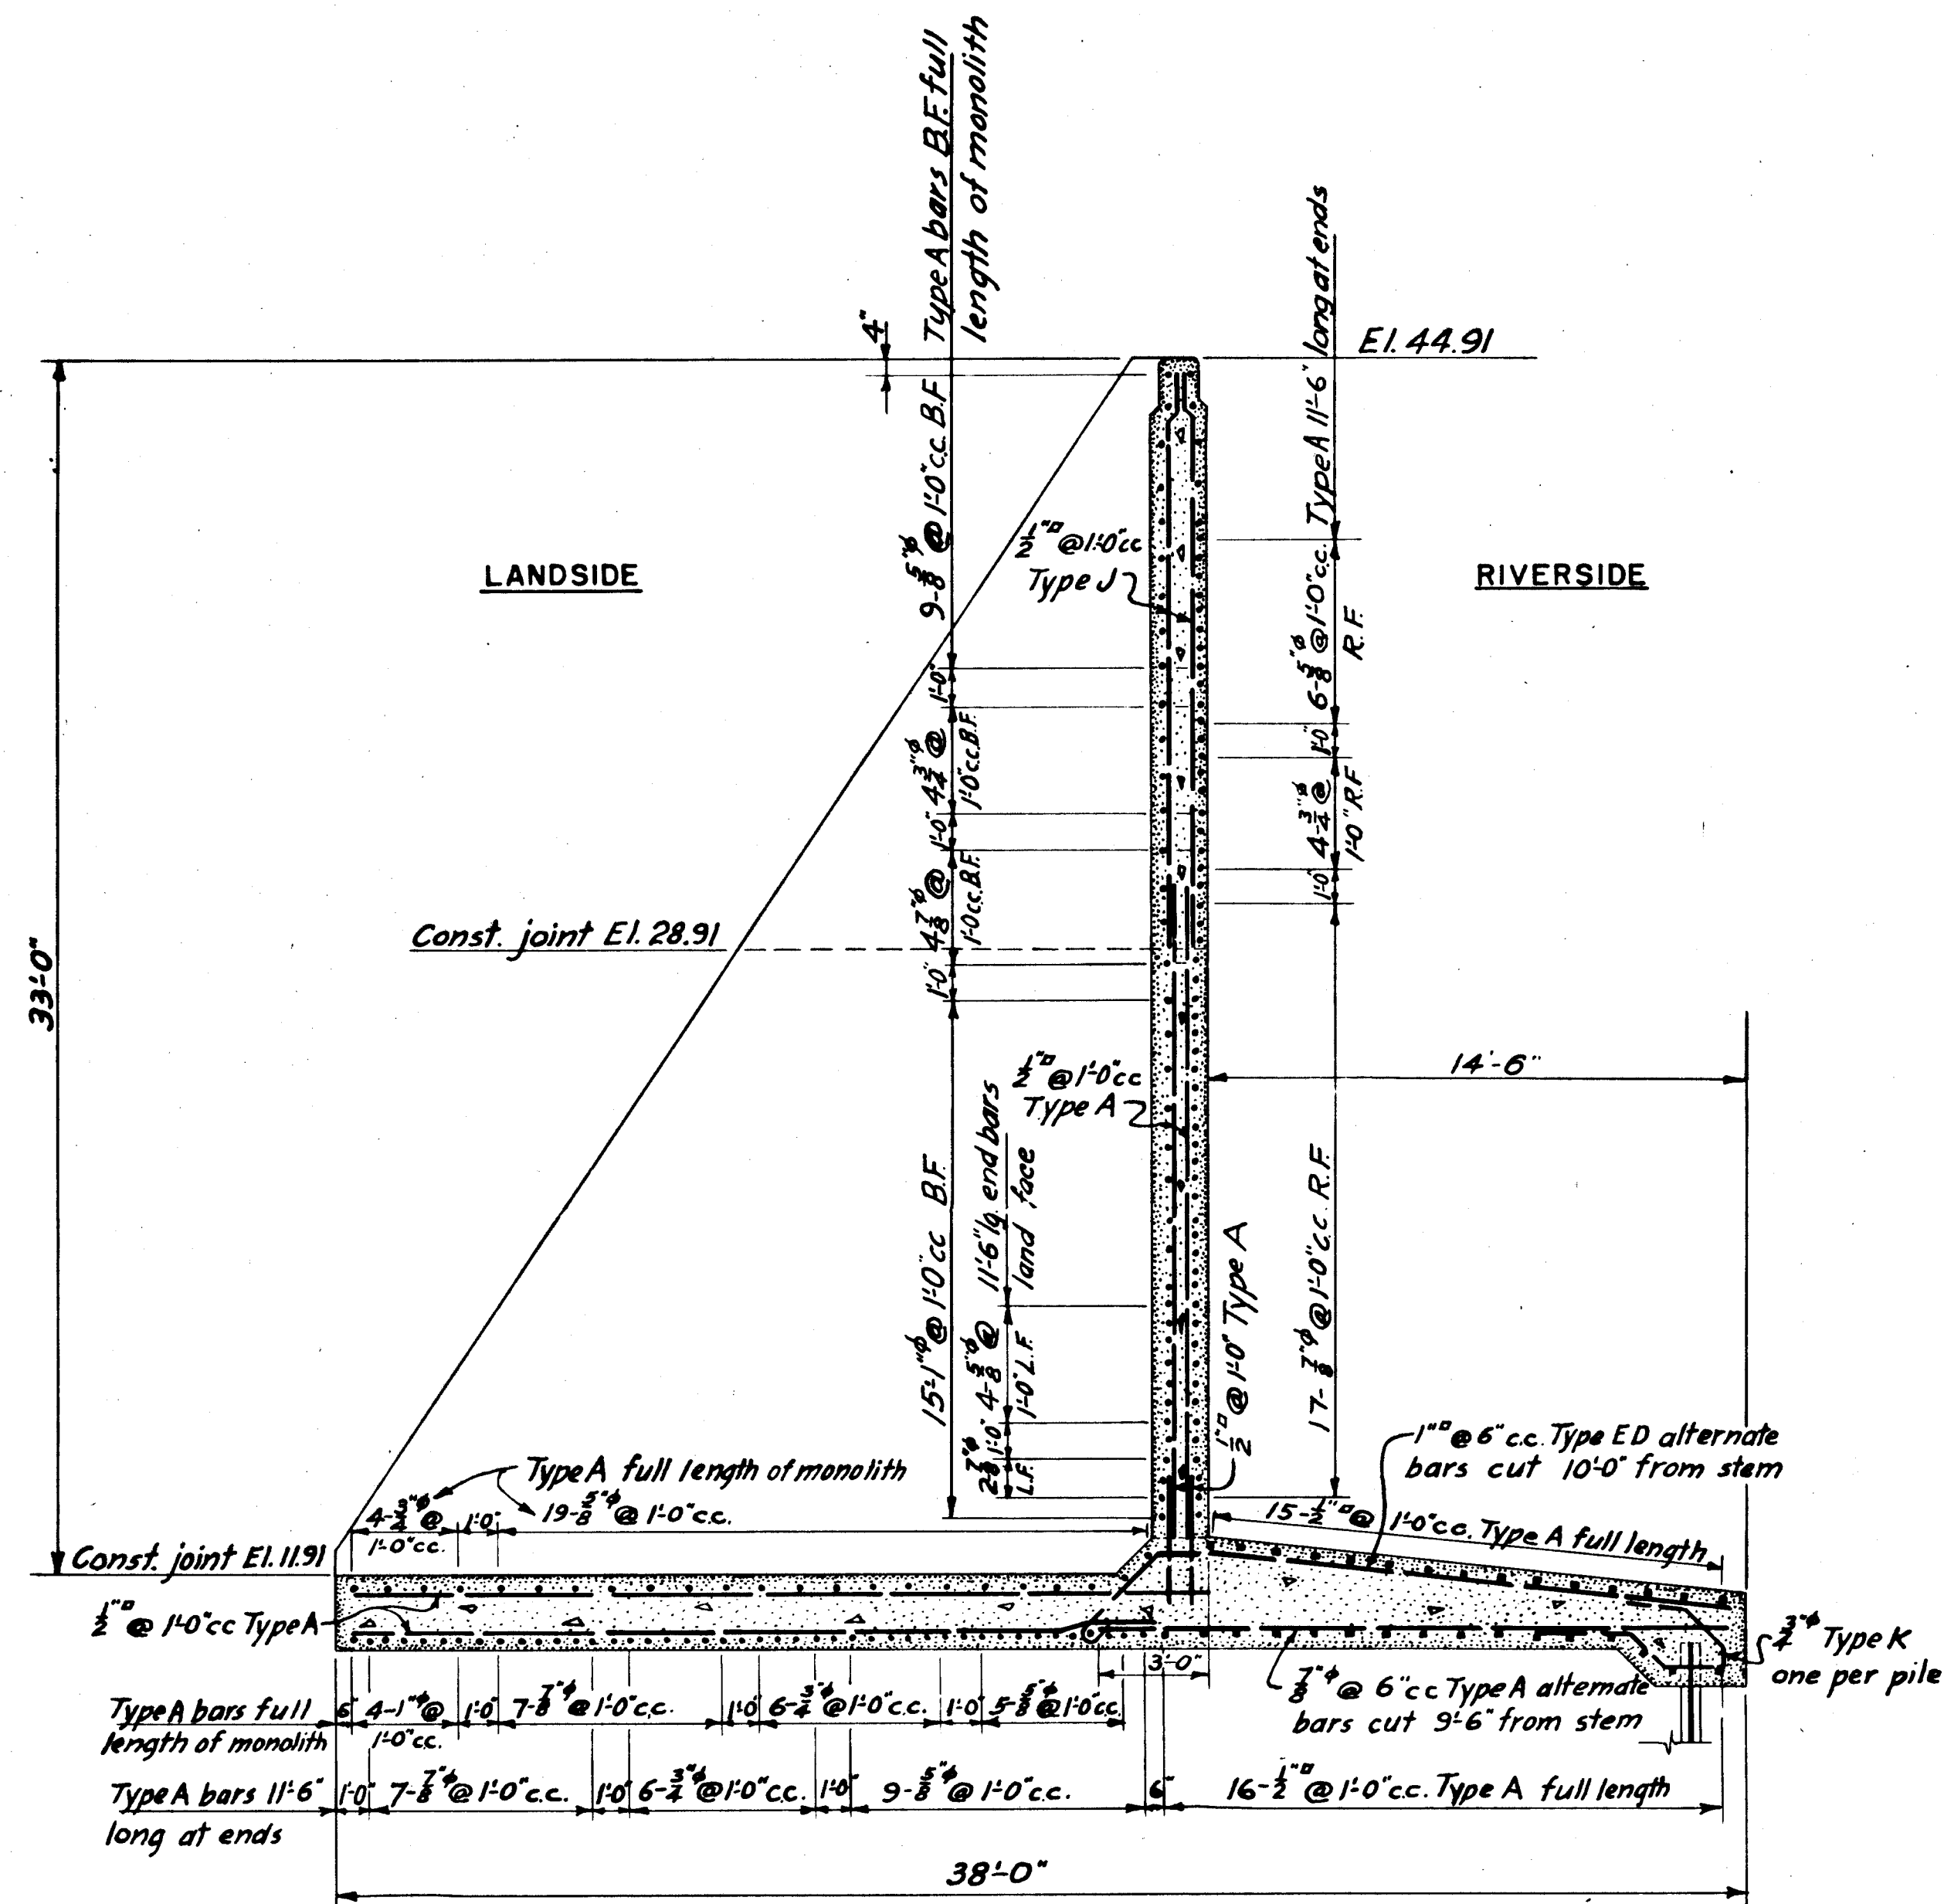

33'-0" WALL
STEM AND BASE STEEL
STA. 18+71.19 TO STA. 19+11.19

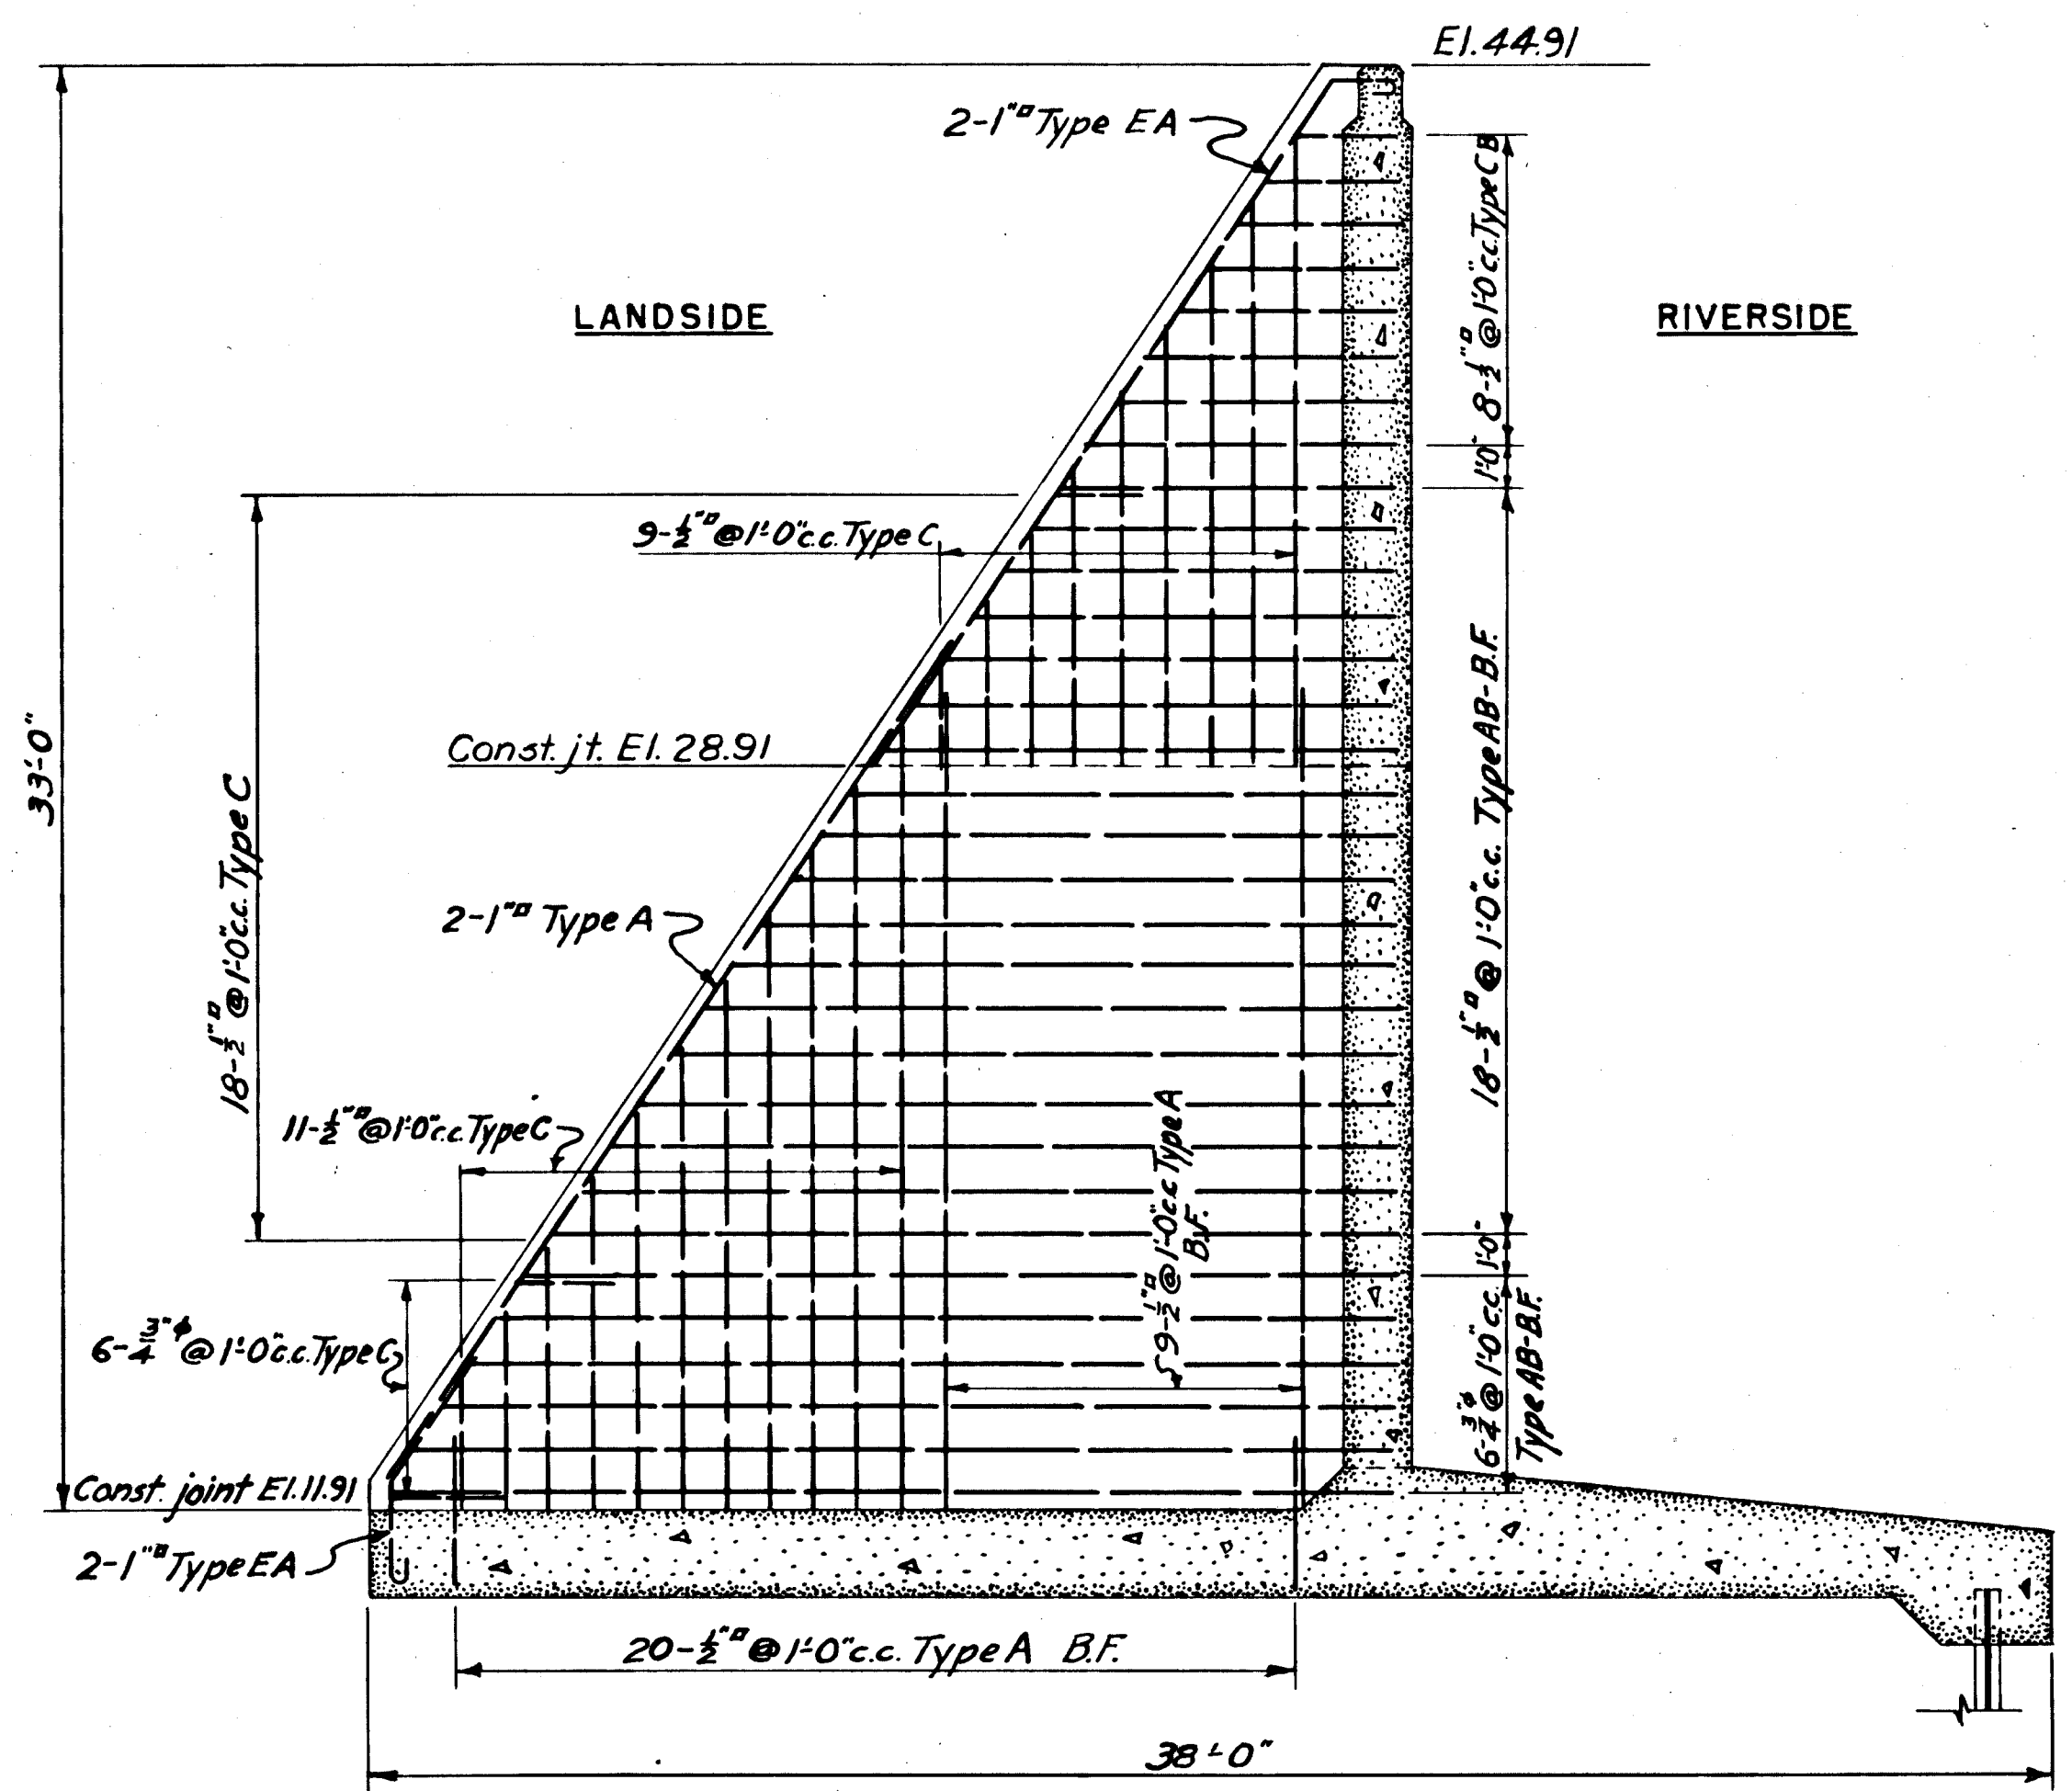

33'-0" WALL
BUTTRESS STEEL
STA. 18+71.19 TO STA. 19+11.19

NOTES
For concrete details, see Sheet No. 73.
For bar type schedule see Sheet No. 85.
The minimum cover for main steel reinforcement is 3" except where concrete is poured against earth in which case it is 4".
Bar splices are equal in length to 40 diameters of the smaller bar.
Radius of bend of bars is equal to 4 diameters of the bar.
Payment for furnishing, bending and placing of steel reinforcement was made under Item No. 25.

KEY	DATE	REVISION (Indicated by Δ)	REV. BY	CK. BY	AP. BY
	12-31-45	As built revisions			

CONNECTICUT RIVER FLOOD CONTROL			
HARTFORD DIKE			
RIVERFRONT, MORGAN ST. TO STA. 96+73.			
WALL - STA. 18+71.19 TO STA. 19+11.19			
STEEL REINFORCEMENT			
CONNECTICUT RIVER	CONNECTICUT	IN 135 SHEETS	
SCALE: 1/4 IN. = 1 FT.		SHEET NO. 94	
U.S. ENGINEER OFFICE, PROVIDENCE, R.I., MAY 1940			
SUBMITTED:	APPROVAL RECOMMENDED:	APPROVED:	
SENIOR ENGINEER	PRINCIPAL ENGINEER	LT. COL., CORPS OF ENGINEERS	
HEAD, DESIGN SECTION	CHIEF, P.C. ENGINEERING DIV.	DISTRICT ENGINEER	
DESIGNED BY:	DRAWN BY:	FISCAL YEAR 1940	
ASSOC. ENGINEER	CHECKED:	FILE NO. CT-4-2554	