
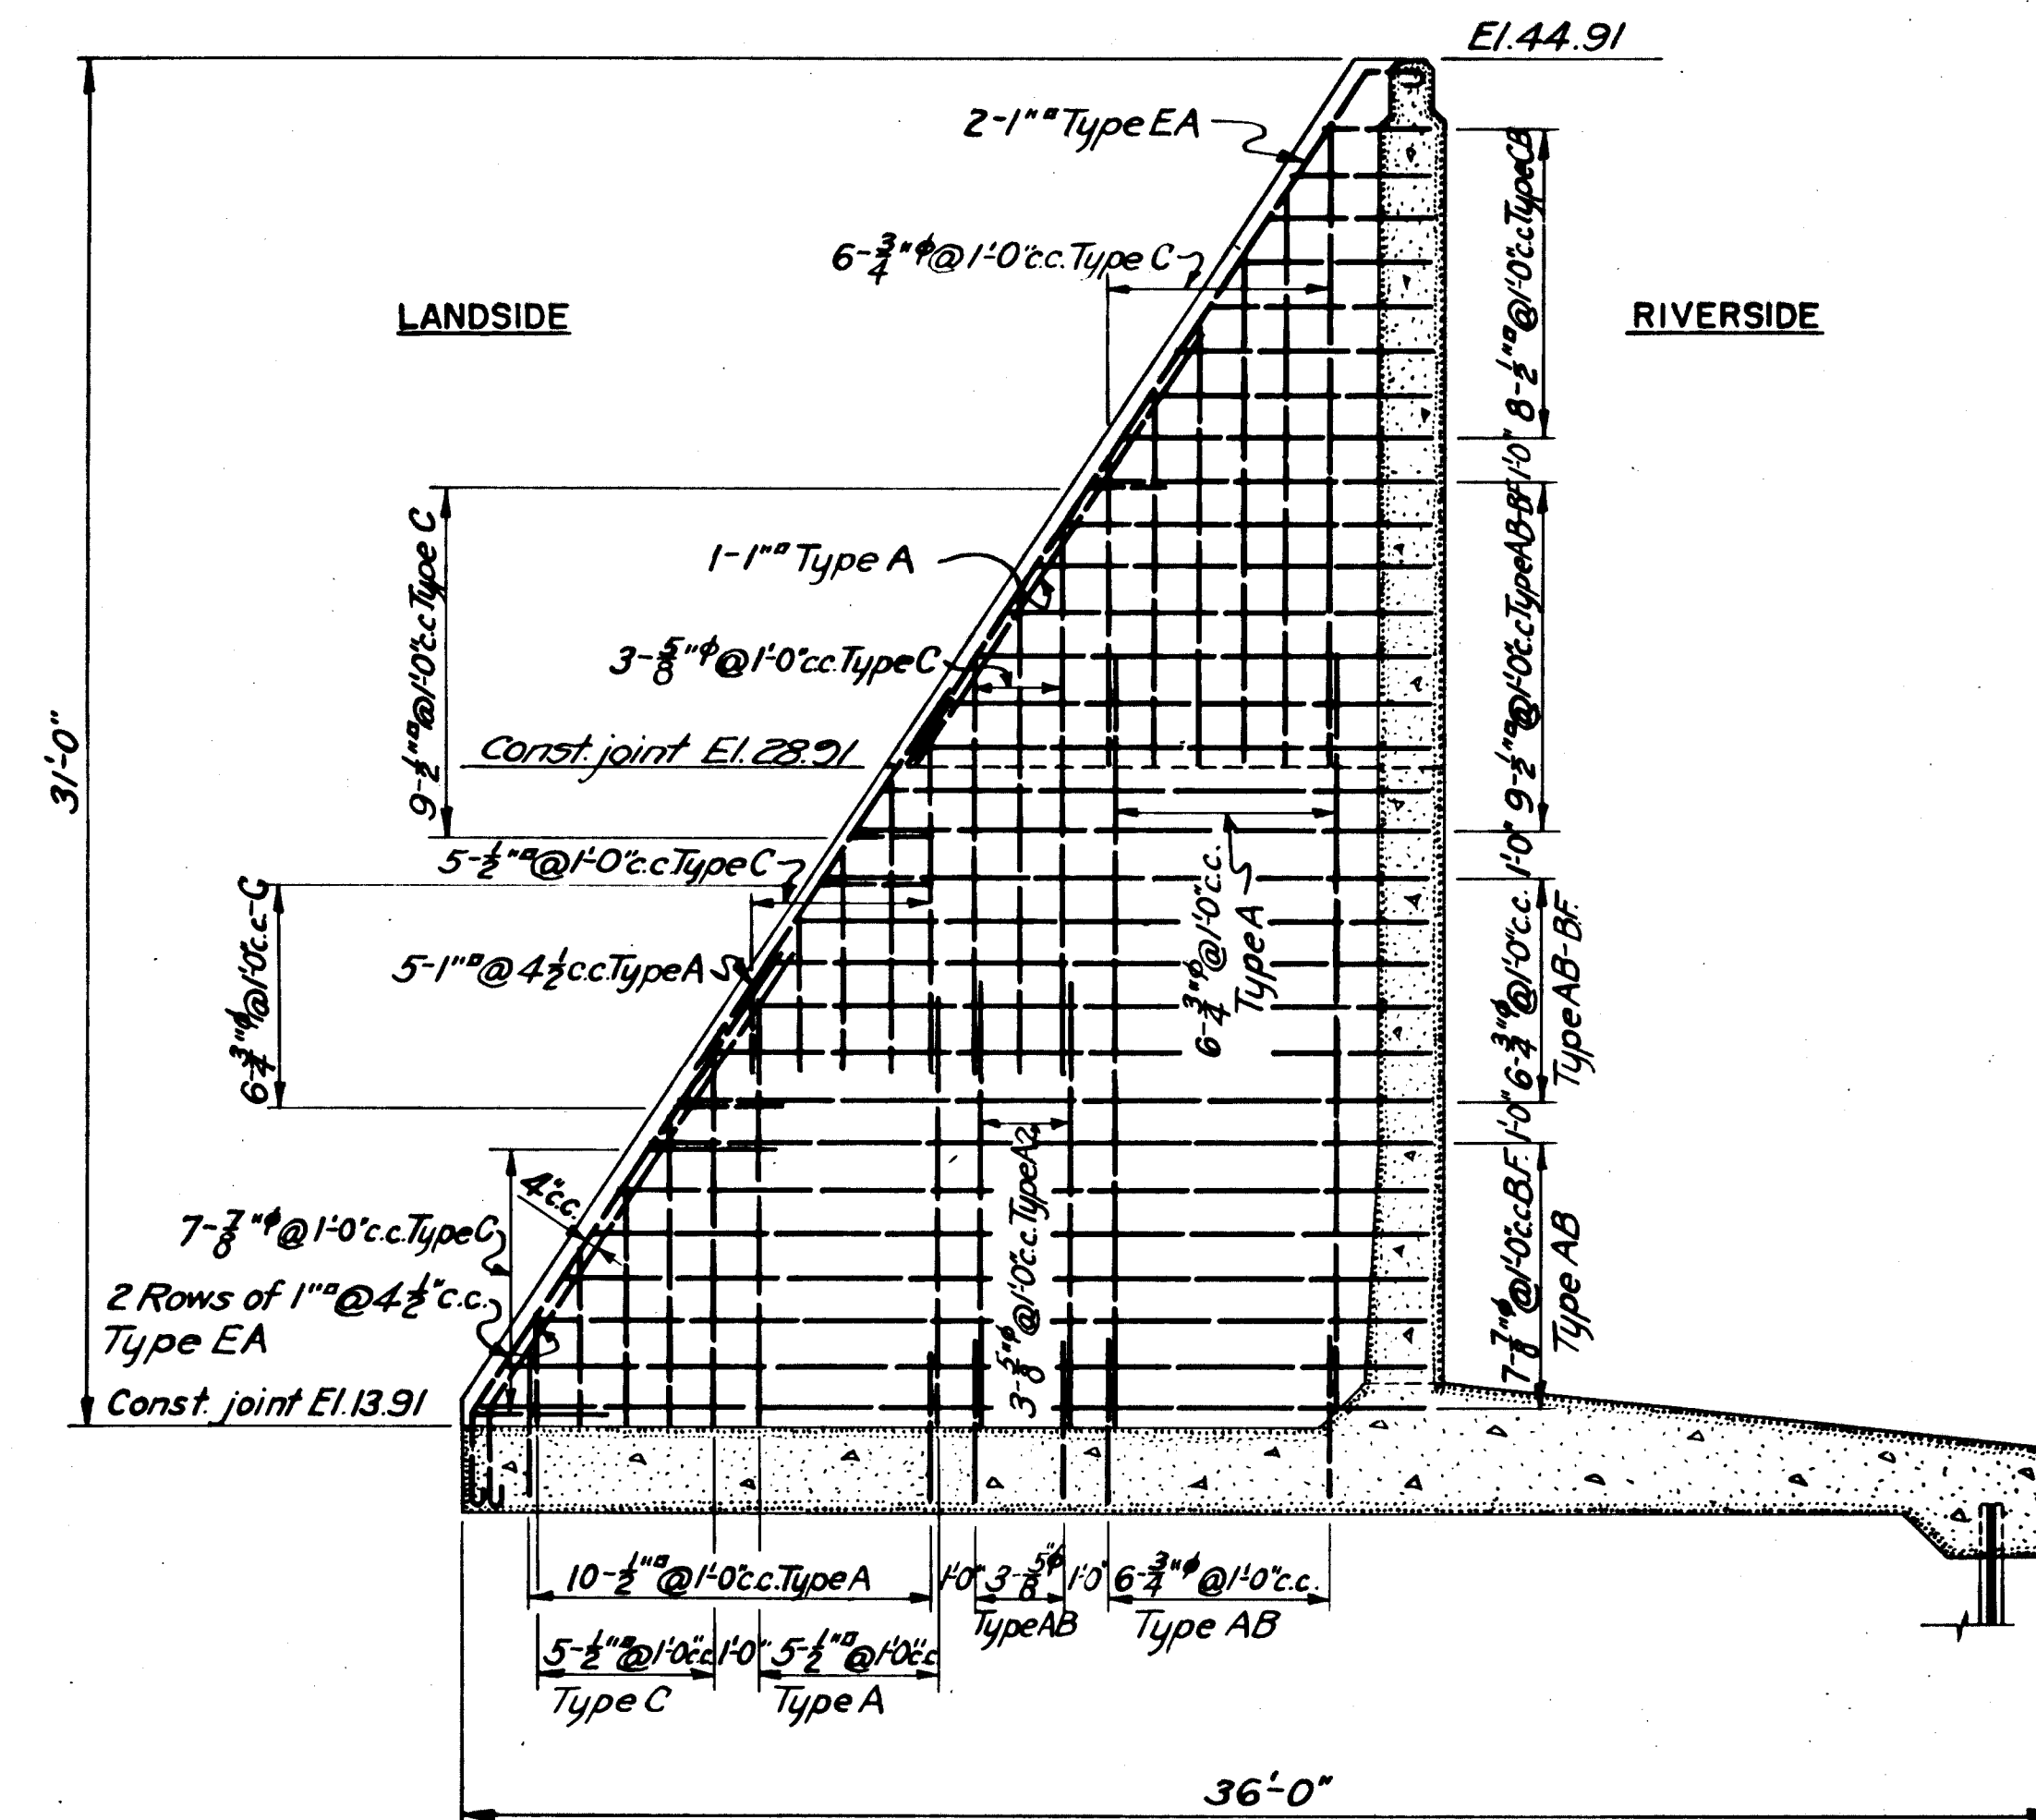


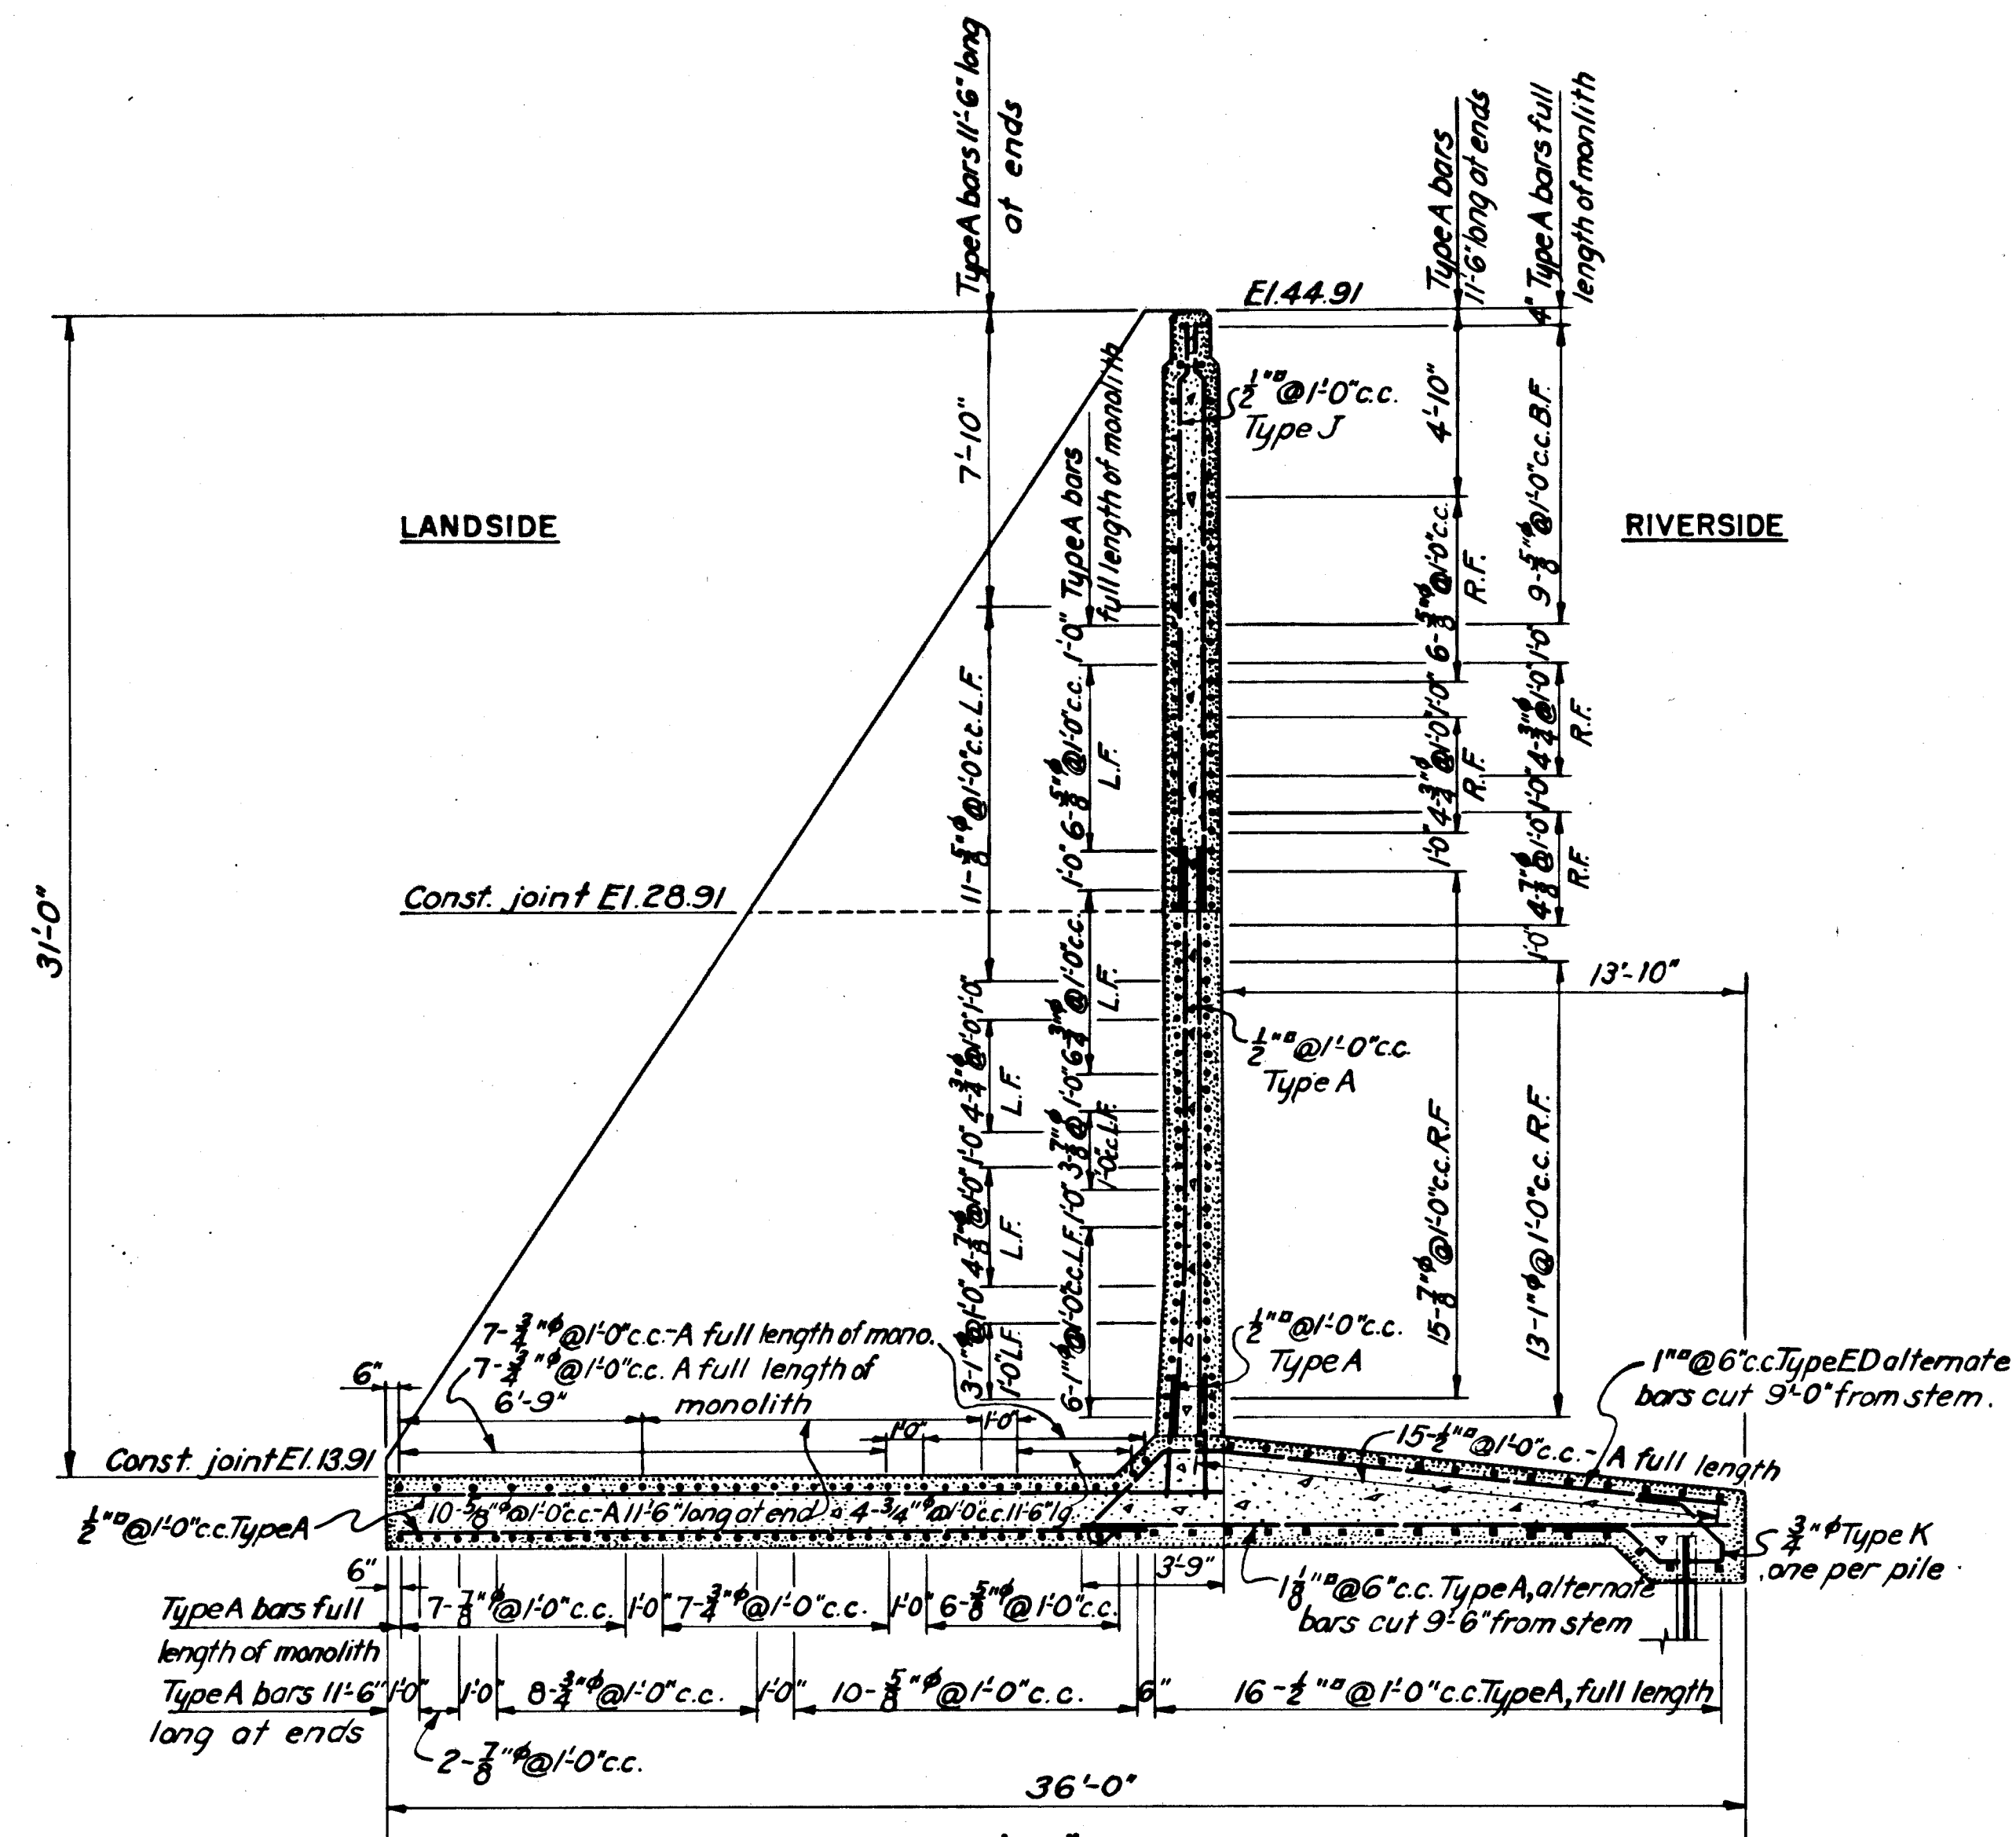

NOTES

For concrete details see Sheet No. 73
For general notes see Sheet No. 94

KEY	DATE	REVISION (Indicated by Δ)	REV. BY	CK. BY	AP. BY
	12-31-45	As built revisions			

CONNECTICUT RIVER FLOOD CONTROL			
HARTFORD DIKE			
RIVERFRONT, MORGAN ST. TO STA. 96+73.			
WALL—STA. 19+11.19 TO STA. 20+31.19			
STEEL REINFORCEMENT			
CONNECTICUT RIVER		CONNECTICUT	
IN 135 SHEETS		SCALE: 1/4 IN. = 1 FT.	
		SHEET NO. 95	
U.S. ENGINEER OFFICE, PROVIDENCE, R.I., MAY 1940			
SUBMITTED:	APPROVAL:	RECOMMENDED:	APPROVED:
SENIOR ENGINEER	PRINCIPAL ENGINEER	CHIEF, E.C. ENGINEERING DIV.	U.S. COL. CORPS OF ENGINEERS
DESIGNED:	DRAWN:	TRACED:	FISCAL YEAR 1940
ASSOC. ENGINEER	ASSOC. ENGINEER	CHECKED:	FILE NO. CT-4-2555