



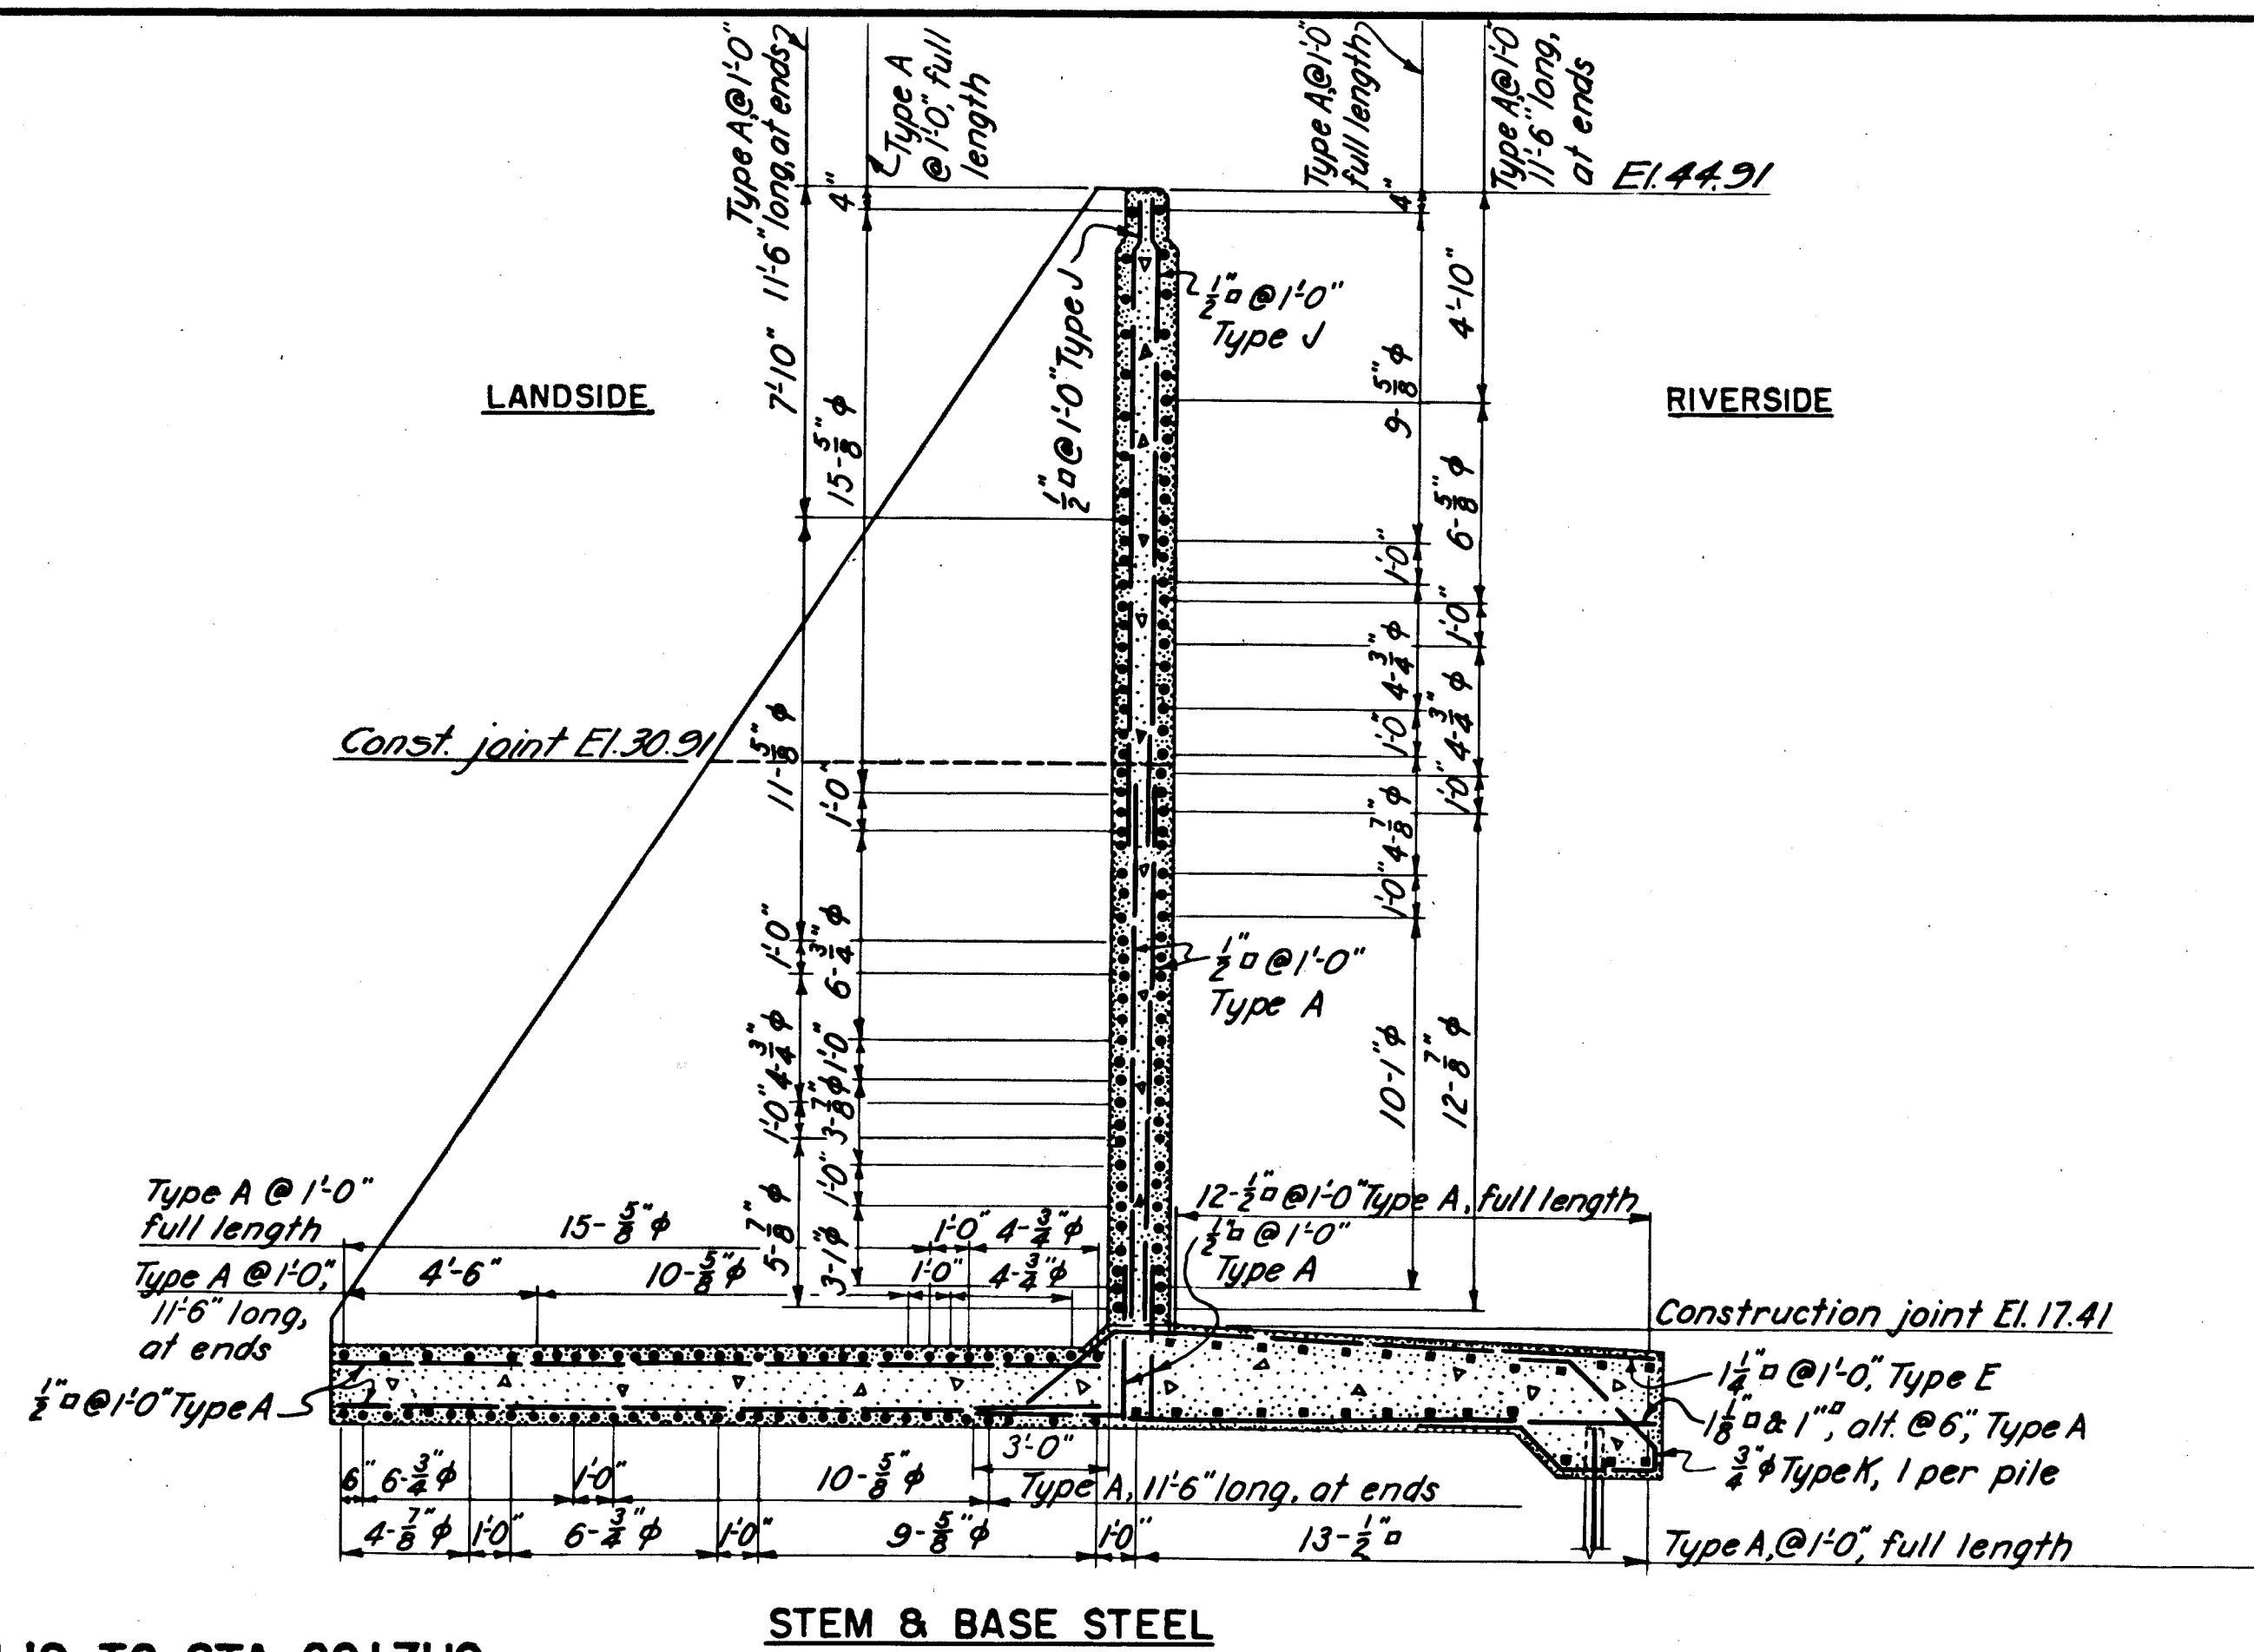

28'-0" WALL - STA. 20+31.19 TO STA. 20+71.19

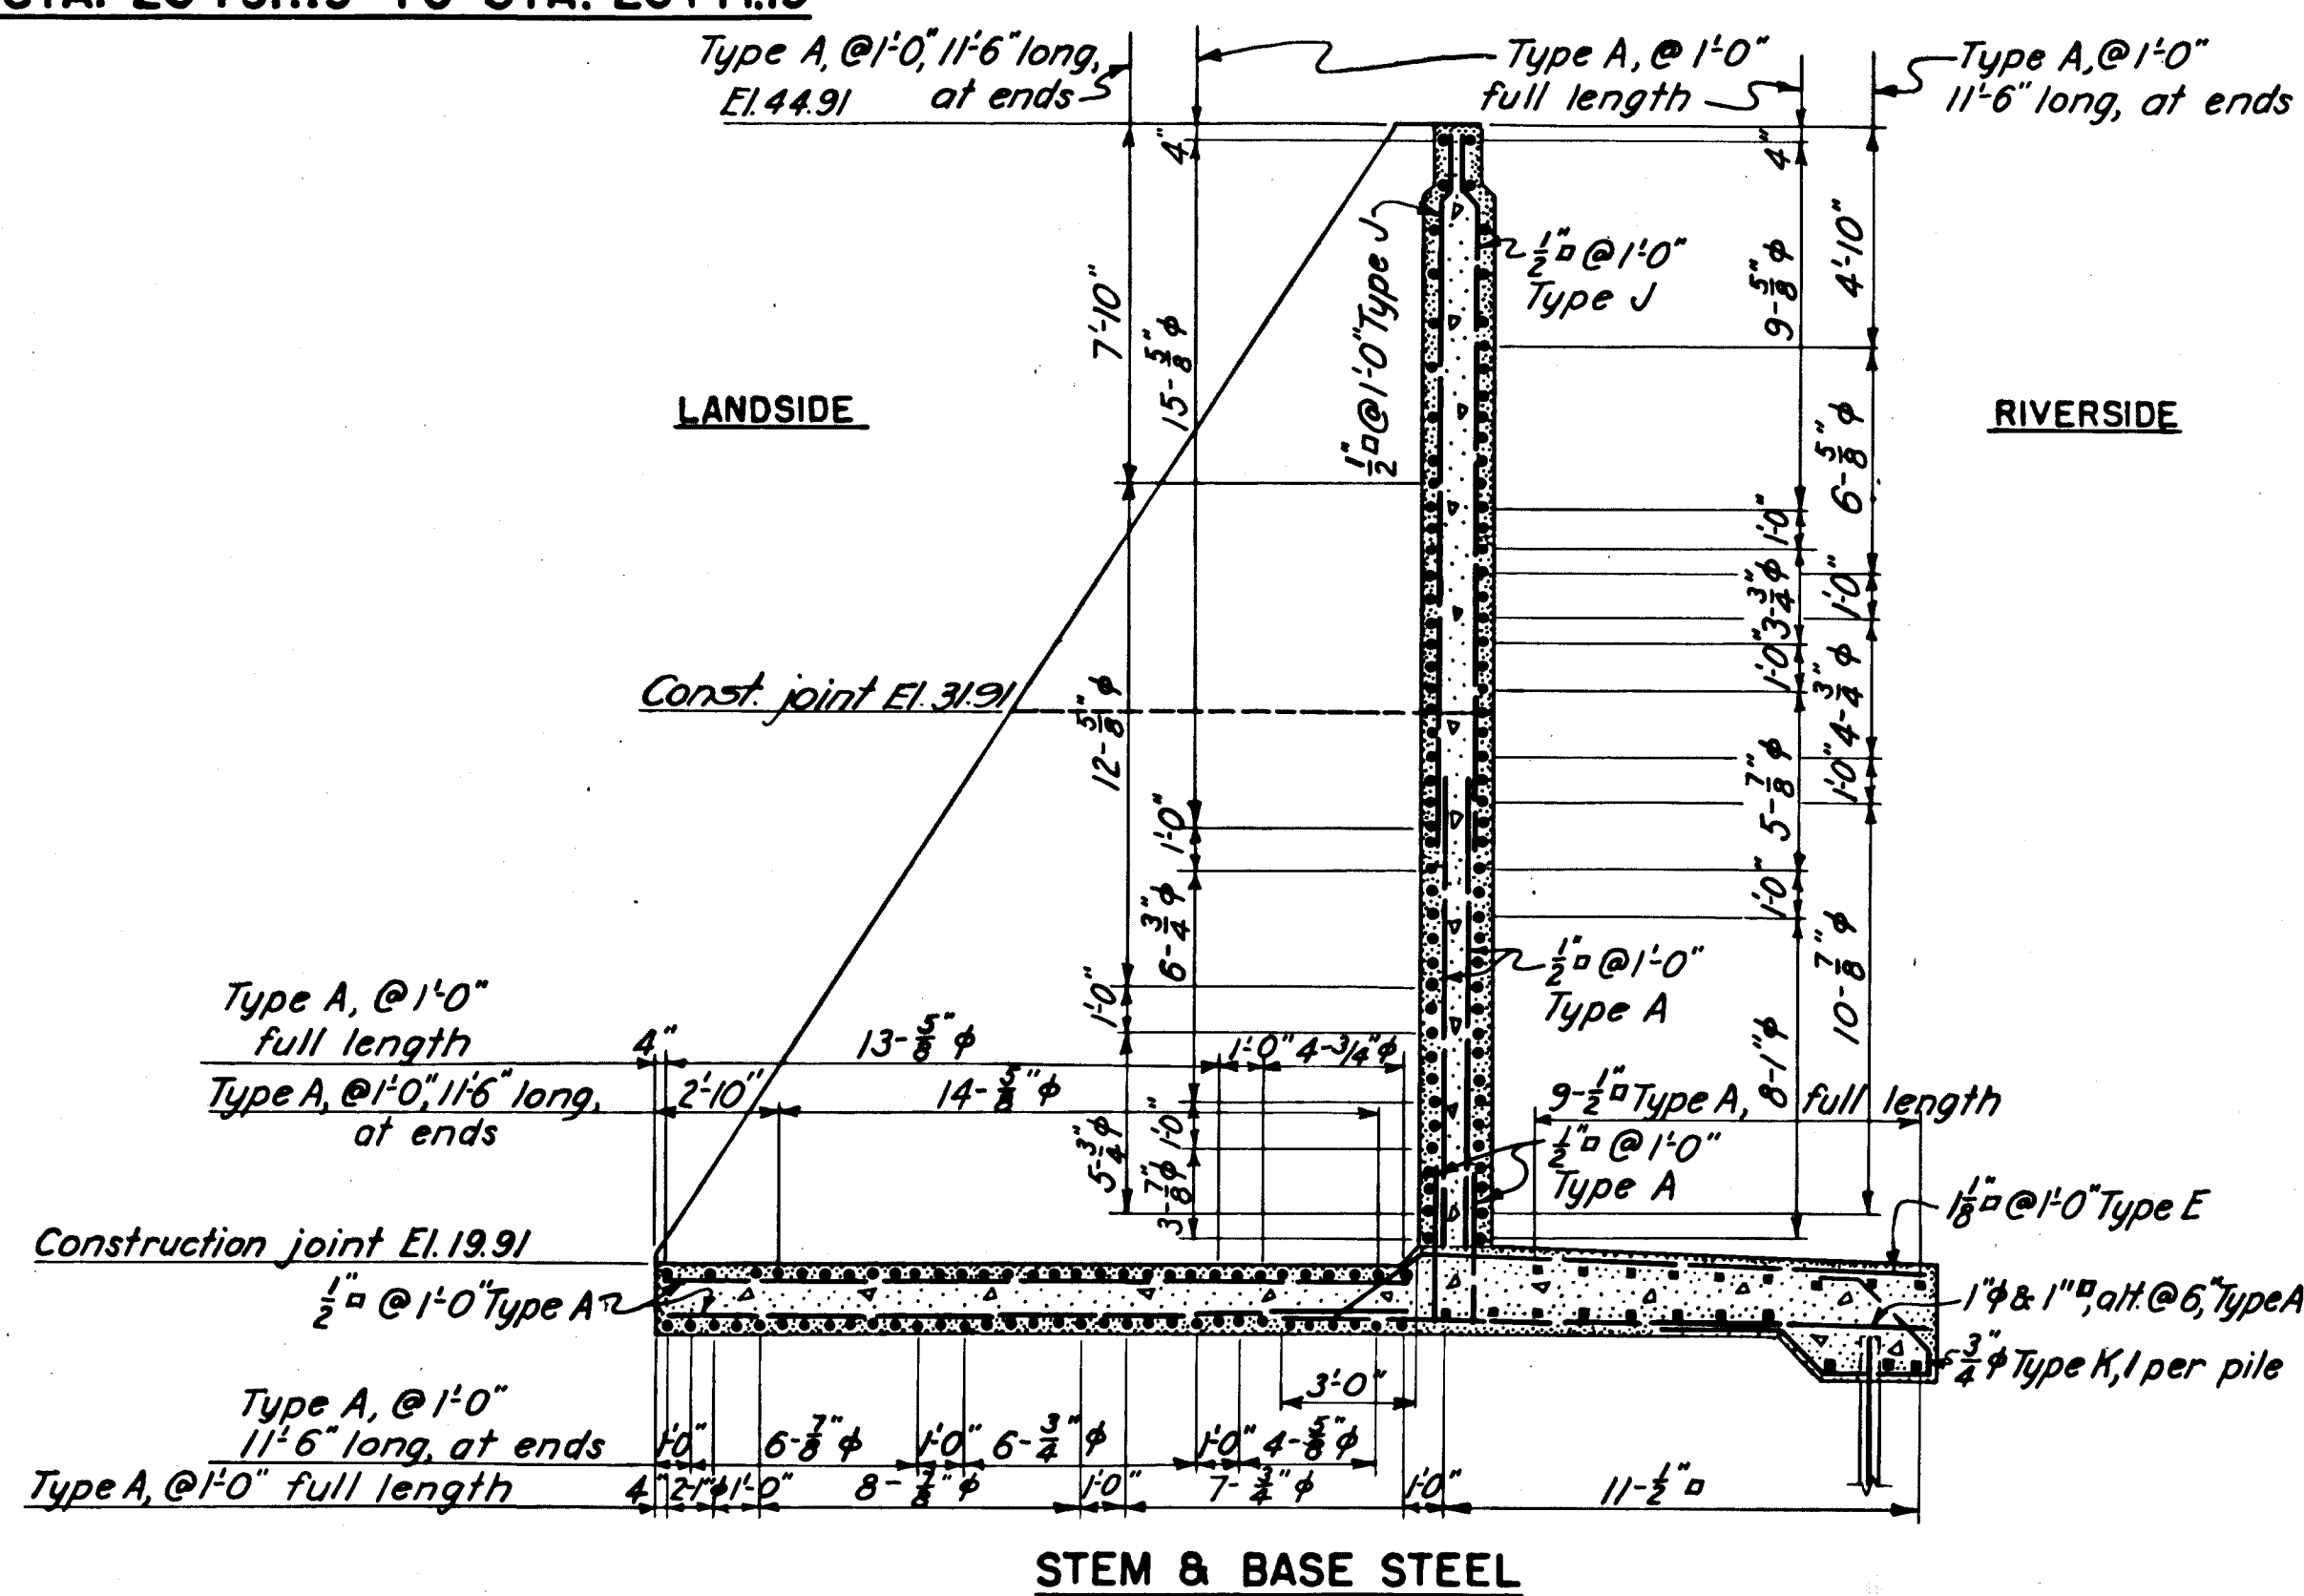

25'-0" WALL- STA. 20+71.19 TO STA. 21+11.19

NOTES
For general notes applying to details on
this sheet see Sheet No. 94.

	12-31-45	As built revisions			
KEY	DATE	REVISION (Indicated by Δ)	REV. BY	CK. BY	AP. BY

CONNECTICUT RIVER		CONTROL	
HARTFORD DIKE			
RIVERFRONT, MORGAN ST. TO STA. 96+73 WALL- STA. 20+31.19 TO STA. 21+11.9 STEEL REINFORCEMENT			
CONNECTICUT RIVER		CONNECTICUT	
IN 135 SHEETS	SCALE: 1/4 IN. = 1 FT.	SHEET NO. 96	
U. S. ENGINEER OFFICE, PROVIDENCE, R. I.,			MAY 1940
SUBMITTED:	APPROVAL RECOMMENDED:	APPROVED:	
<i>Charles B. [Signature]</i>	<i>W. B. [Signature]</i>	<i>W. B. [Signature]</i>	
SENIOR ENGINEER	PRINCIPAL ENGINEER	LT. COL. CORPS OF ENGINEERS	
HEAD. DESIGN SECTION	CHIEF, P.C. ENGINEERING DIV.	DISTRICT ENGINEER	
DESIGNED:	DRAWN: R. S. M.	FILE NO. 1940	
<i>W. B. [Signature]</i>	CHECKED: <i>W. B. [Signature]</i>	FISCAL NO. CT-4-2556	