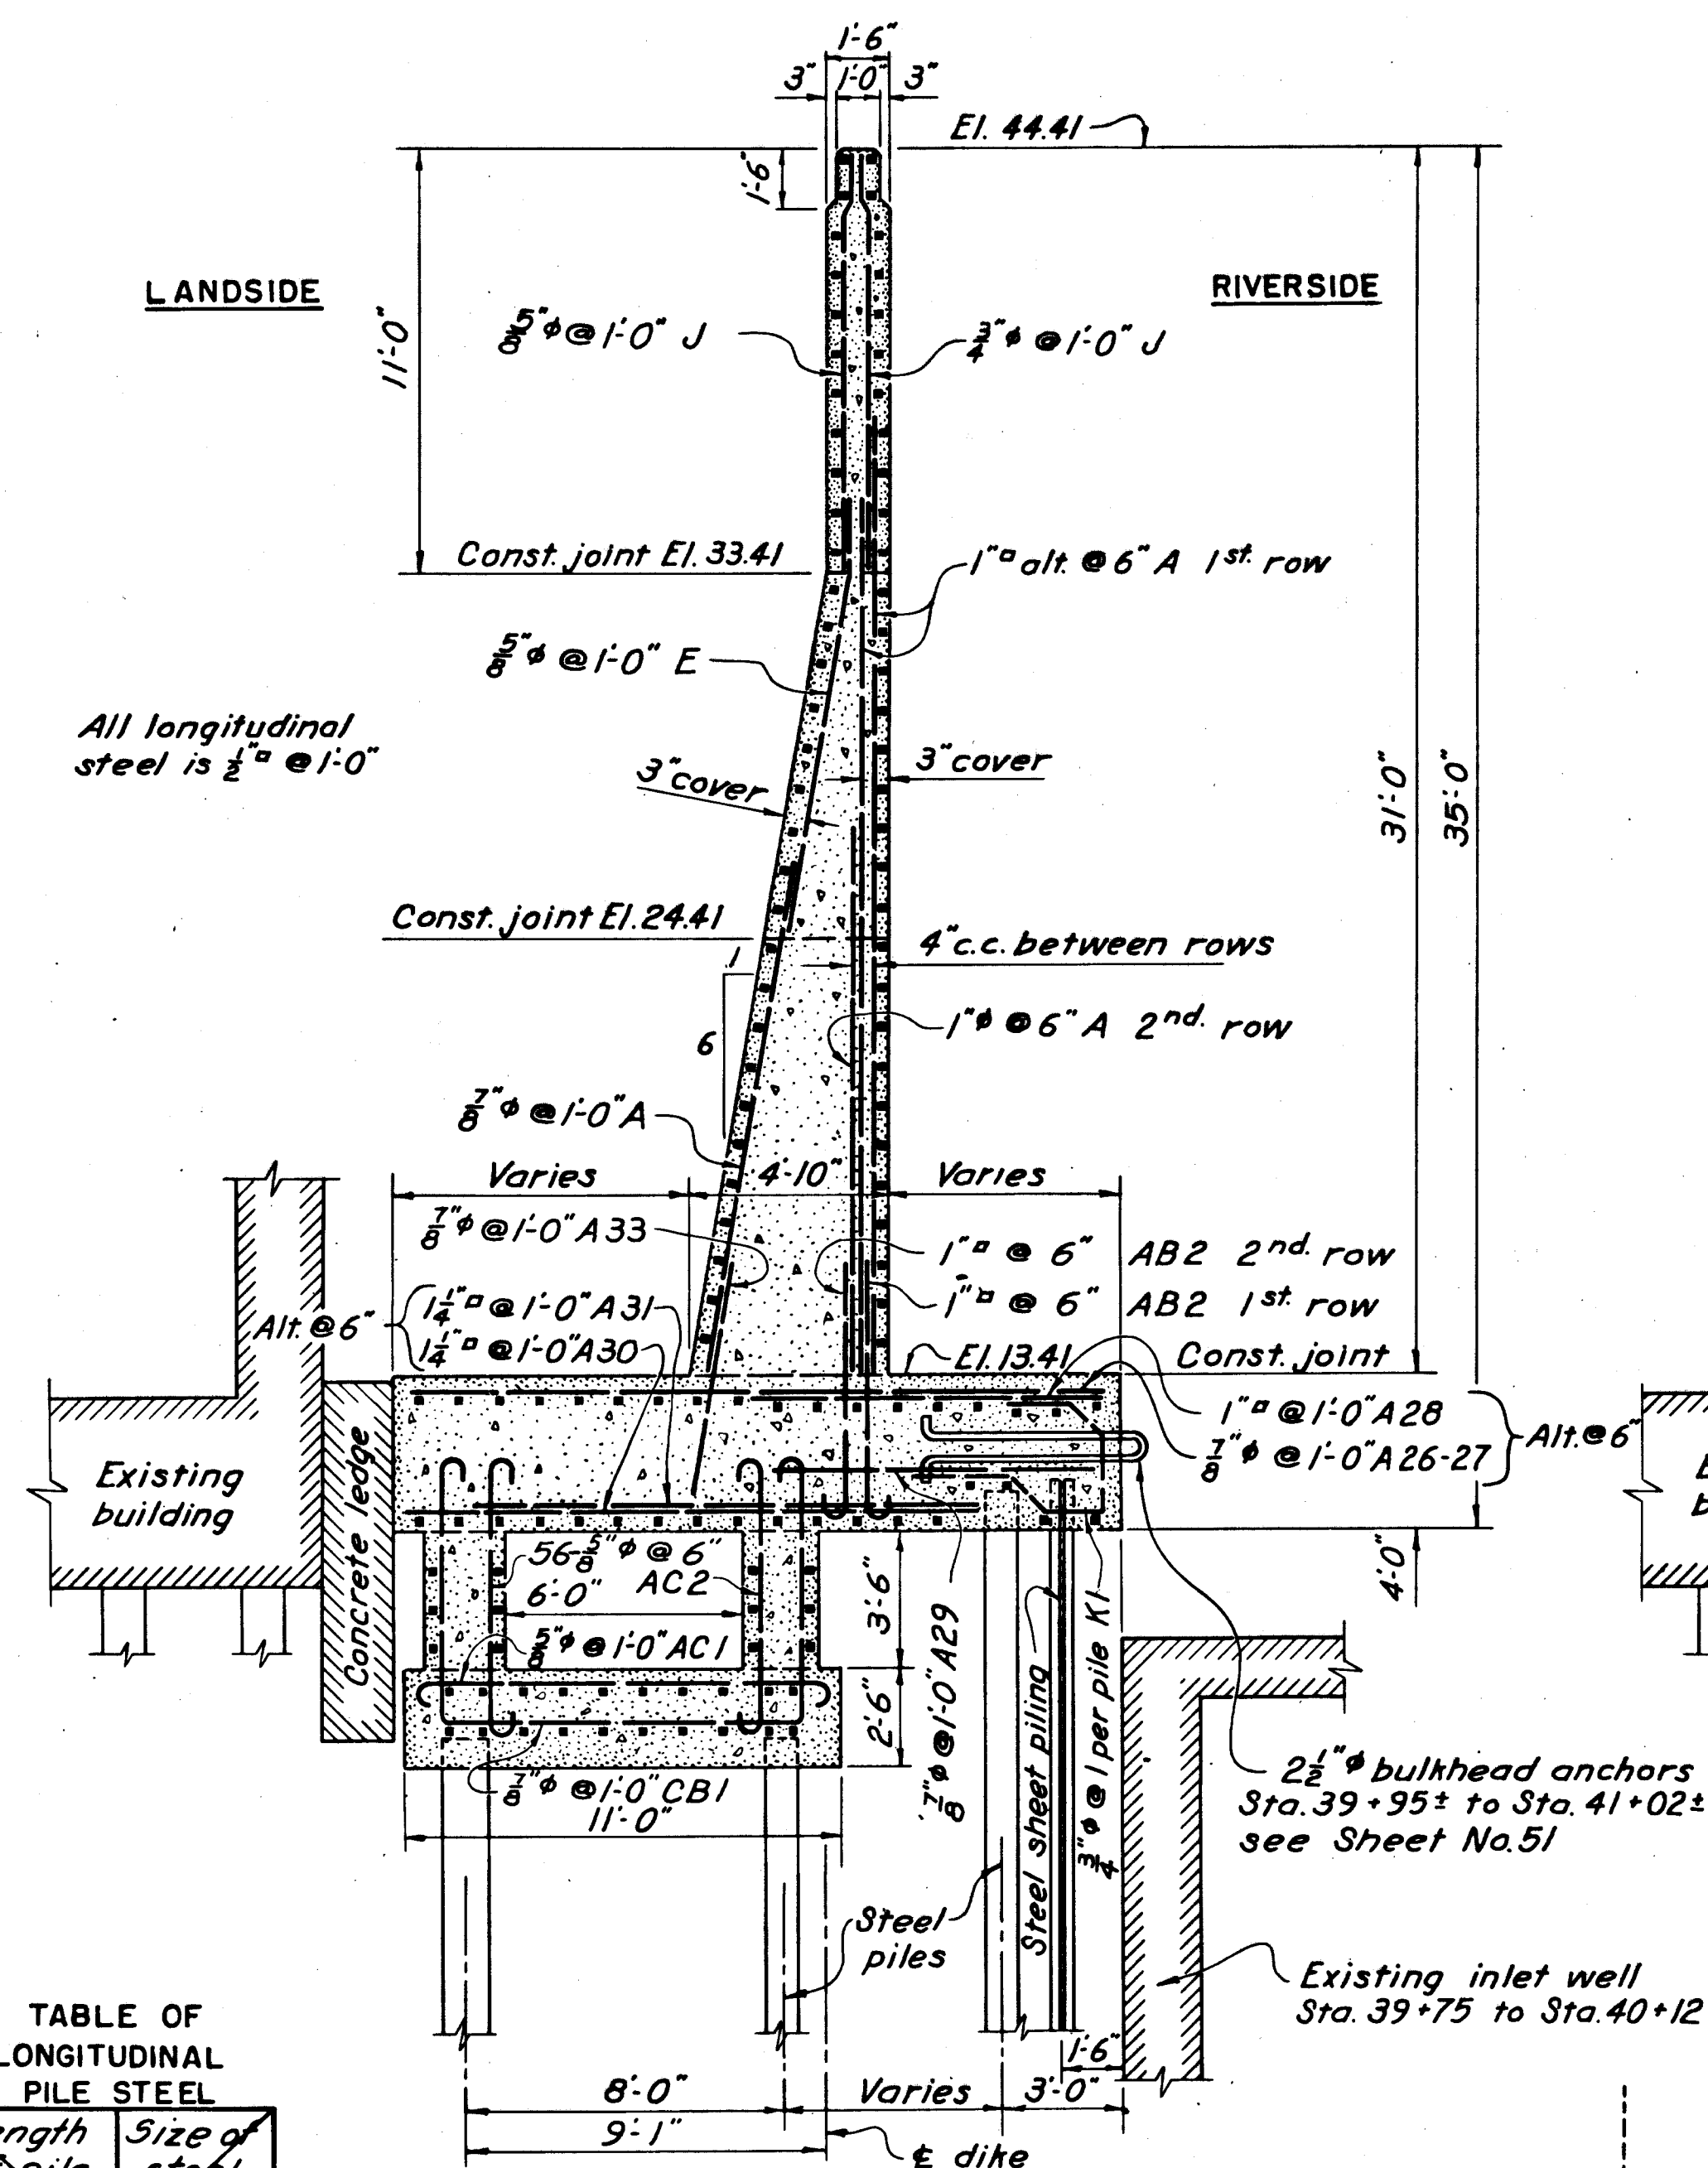
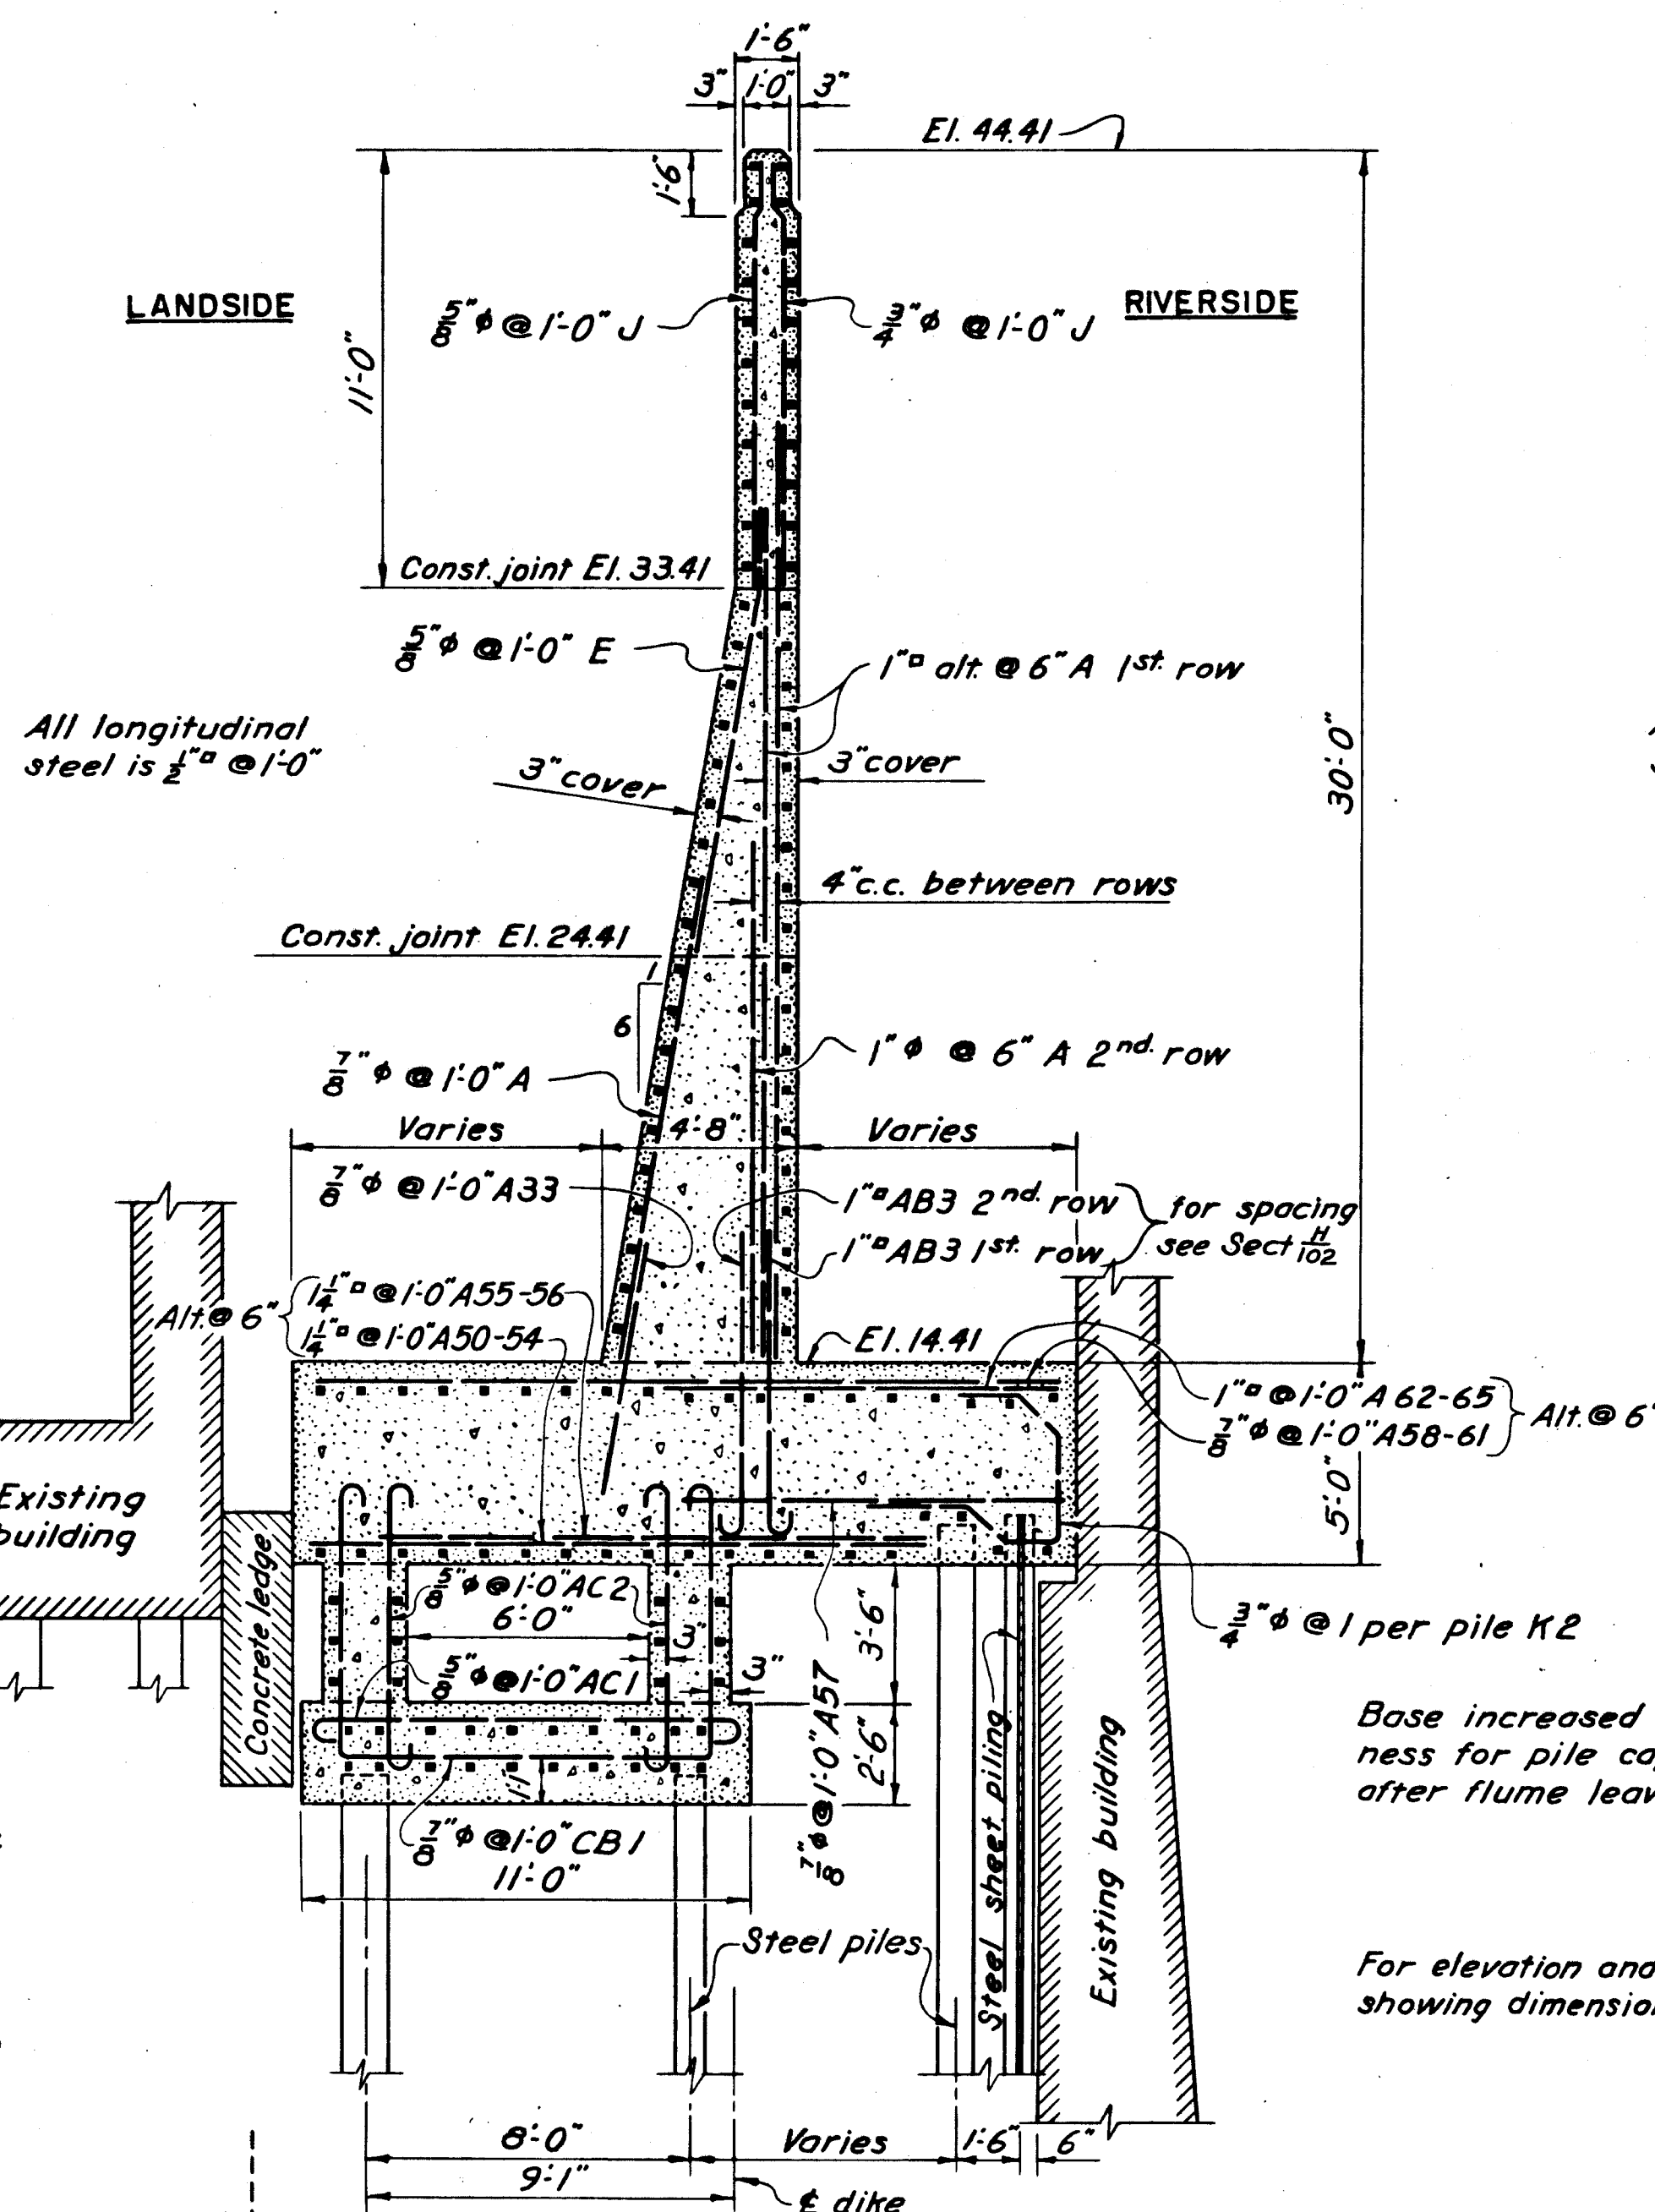
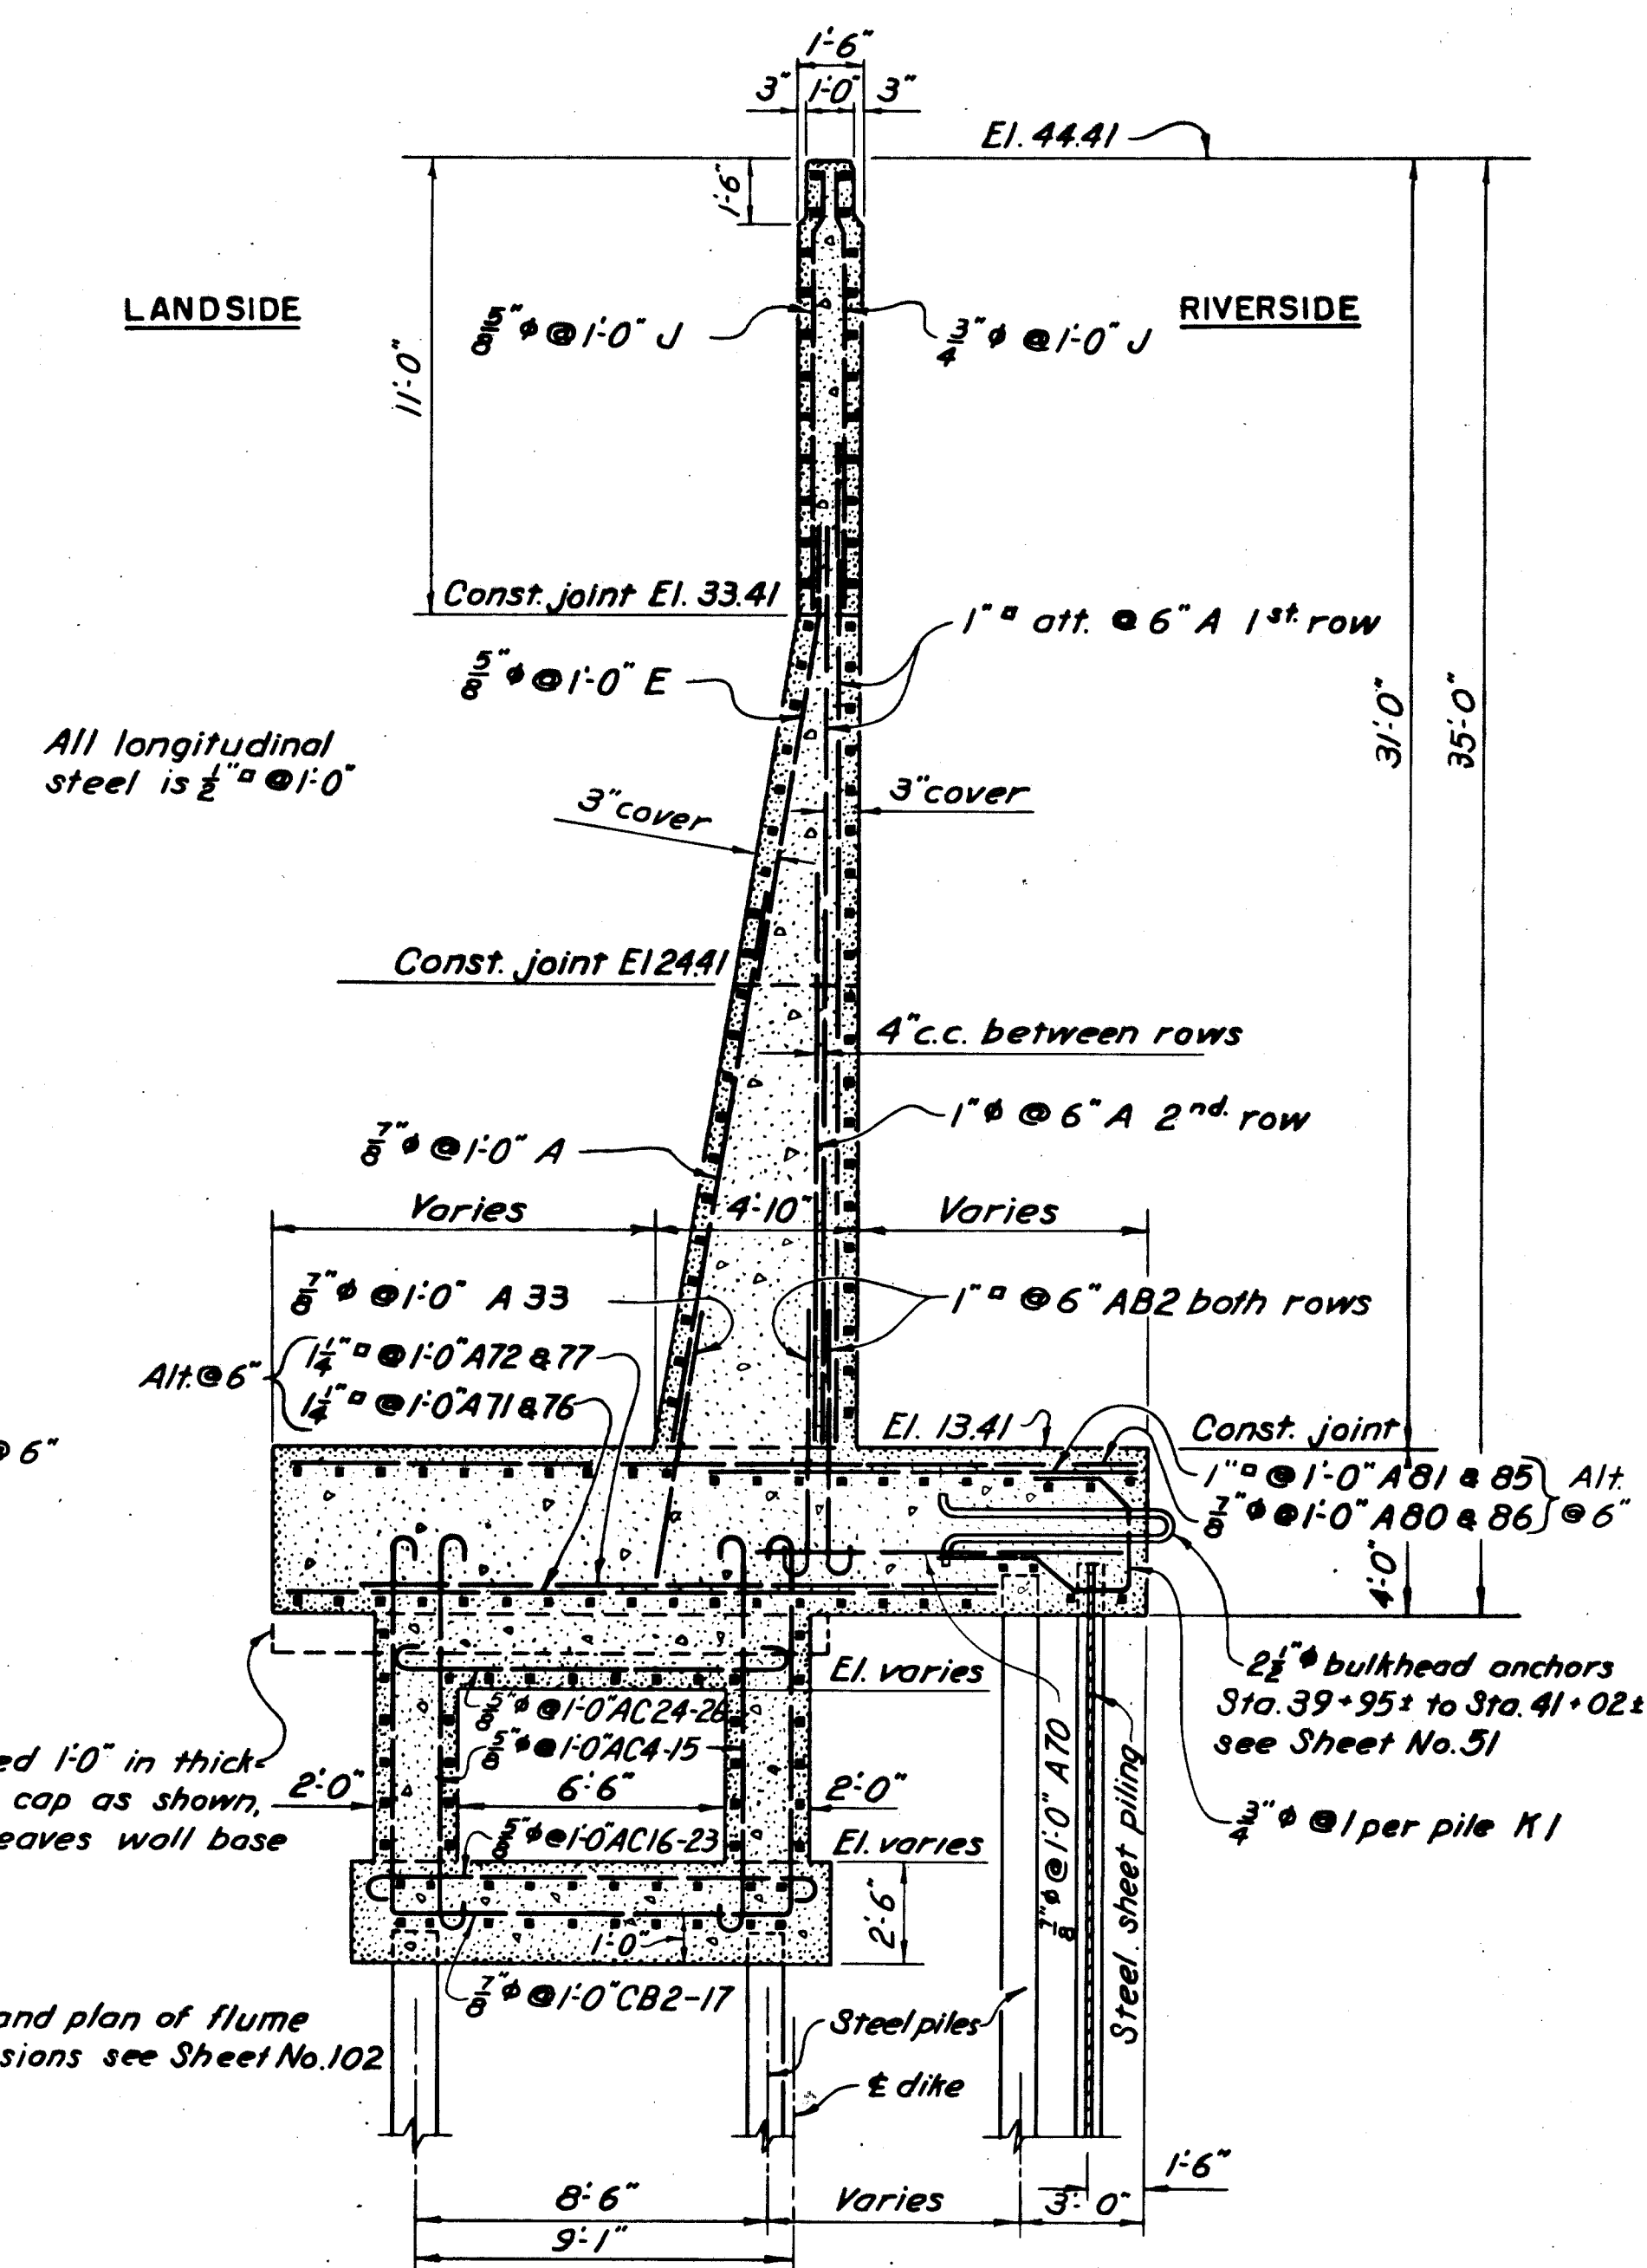


31'-0" WALL SECTION $\frac{D}{101}$

TYPICAL SECTION STA. 39+75.0 TO STA. 40+03.0

30'-0" WALL SECTION $\frac{E}{102}$


TYPICAL SECTION STA. 40+03.0 TO STA. 40+54.5

31'-0" WALL SECTION $\frac{F}{102}$

TYPICAL SECTION STA. 40+54.5 to STA. 41+12.63

Length of pile	Size of steel
26 to 32	4-1"
37 to 63	4-1 1/2"
64 to 70	4-1 3/4"
71 to 77	8-1"

PILE PICKUP

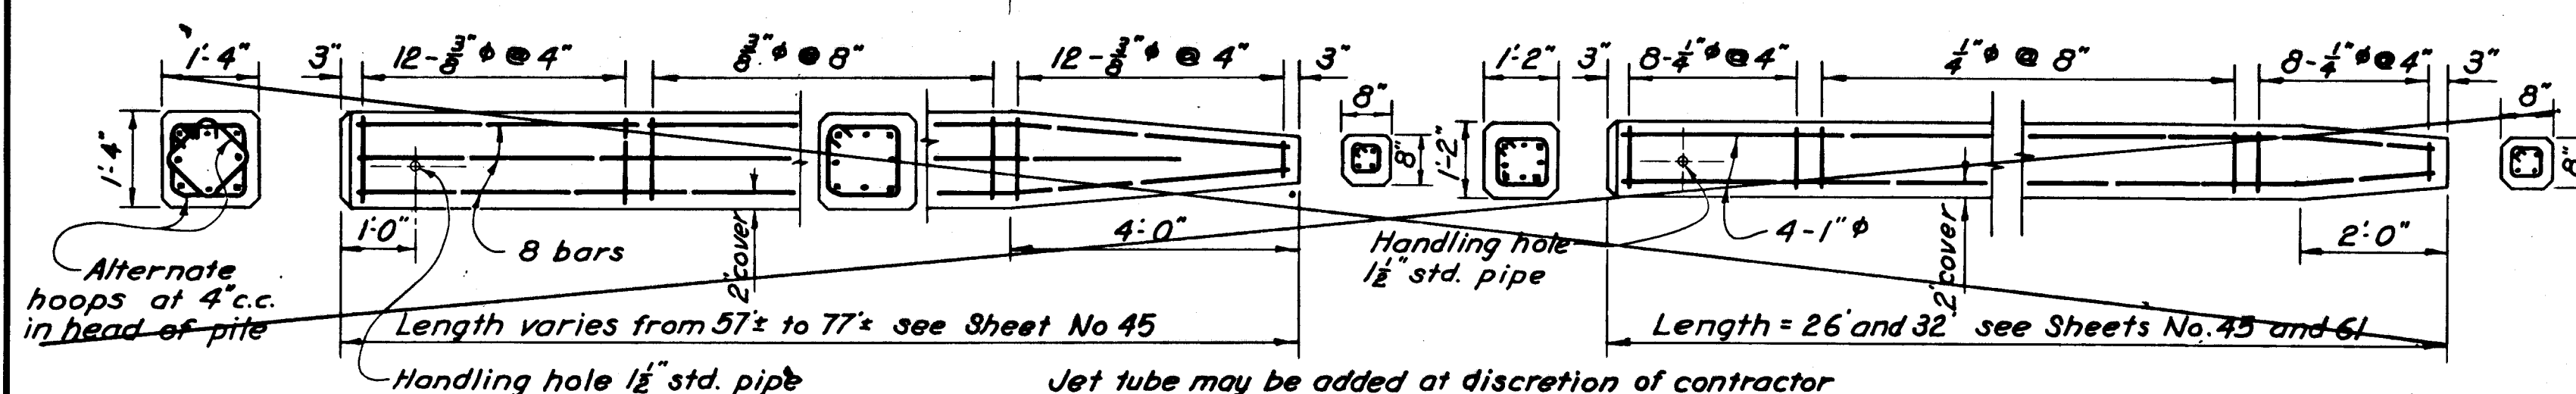PRECAST CONCRETE PILES
(FOR ALTERNATE SEE SPECIFICATIONS)SCALE: $\frac{1}{2}$ " = 1'-0"

Reinforcement is computed on assumption that piles will be picked up as shown

Steel H-section bearing piles substituted for concrete piles.

Chamfer all corners 1"

NOTES

- For concrete details see Sheets No. 40, 41, 43, 44, 45, 46 & 47
- For additional steel reinforcement details see Sheets No. 101, 102 & 103
- For general notes applying to details on this sheet see Sheet No. 103
- For schedule of base steel see Sheet No. 104 A

KEY	DATE	REVISION (Indicated by Δ)	REV. BY	CK. BY	AP. BY
	12-31-45	As built revisions			

THIS SHEET SUPERSEDES SHEET NO. 104 FILE NO. CT-4-2564

CONNECTICUT RIVER FLOOD CONTROL

HARTFORD DIKE

RIVERFRONT, MORGAN ST. TO STA. 96+73

WALL DETAILS - DUTCH POINT STATION

STEEL REINFORCEMENT NO. 4

CONNECTICUT RIVER

CONNECTICUT

IN 135 SHEETS

SCALE: 1/4" = 1 FT.

SHEET NO. 104

U. S. ENGINEER OFFICE, PROVIDENCE, R. I.

JUNE 1941

SUBMITTED: J. C. Duggan, Jr. APPROVED: J. C. Duggan, Jr.

DESIGNED: J. C. Duggan, Jr. DRAWN: E. H. V. TRACED: O. W. B. CHECKED: J. C. Duggan, Jr.

FISCAL YEAR 1940

FILE NO. CT-4-2572