
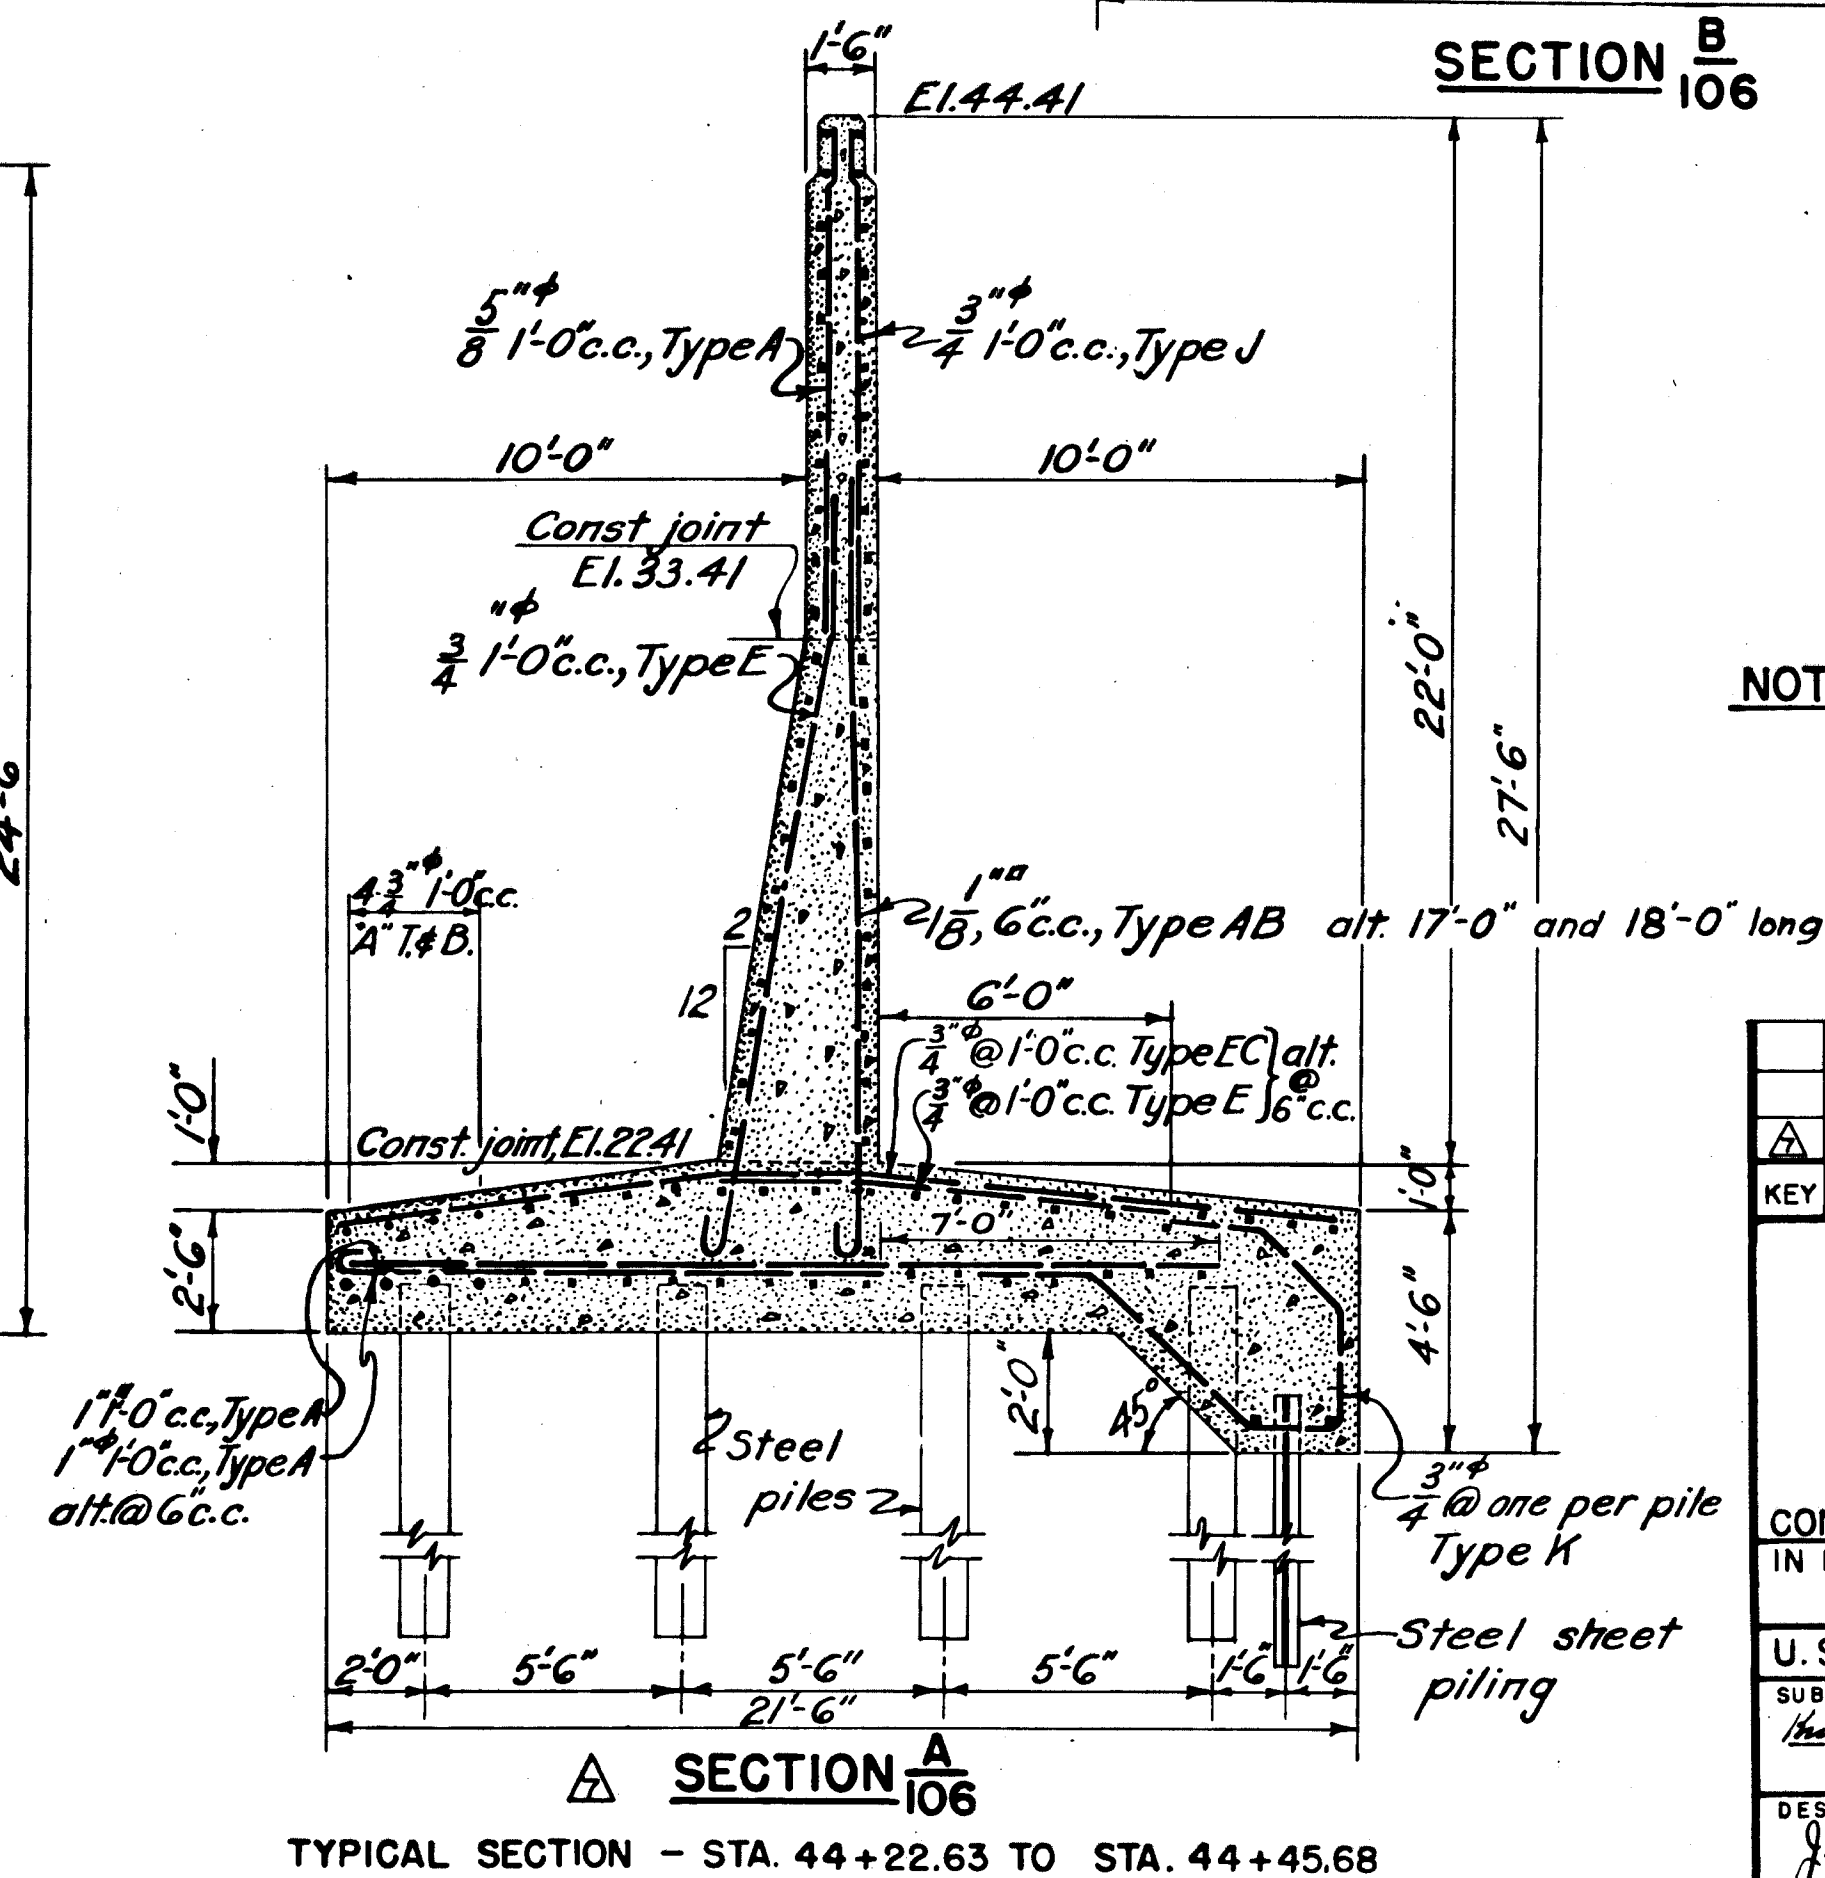


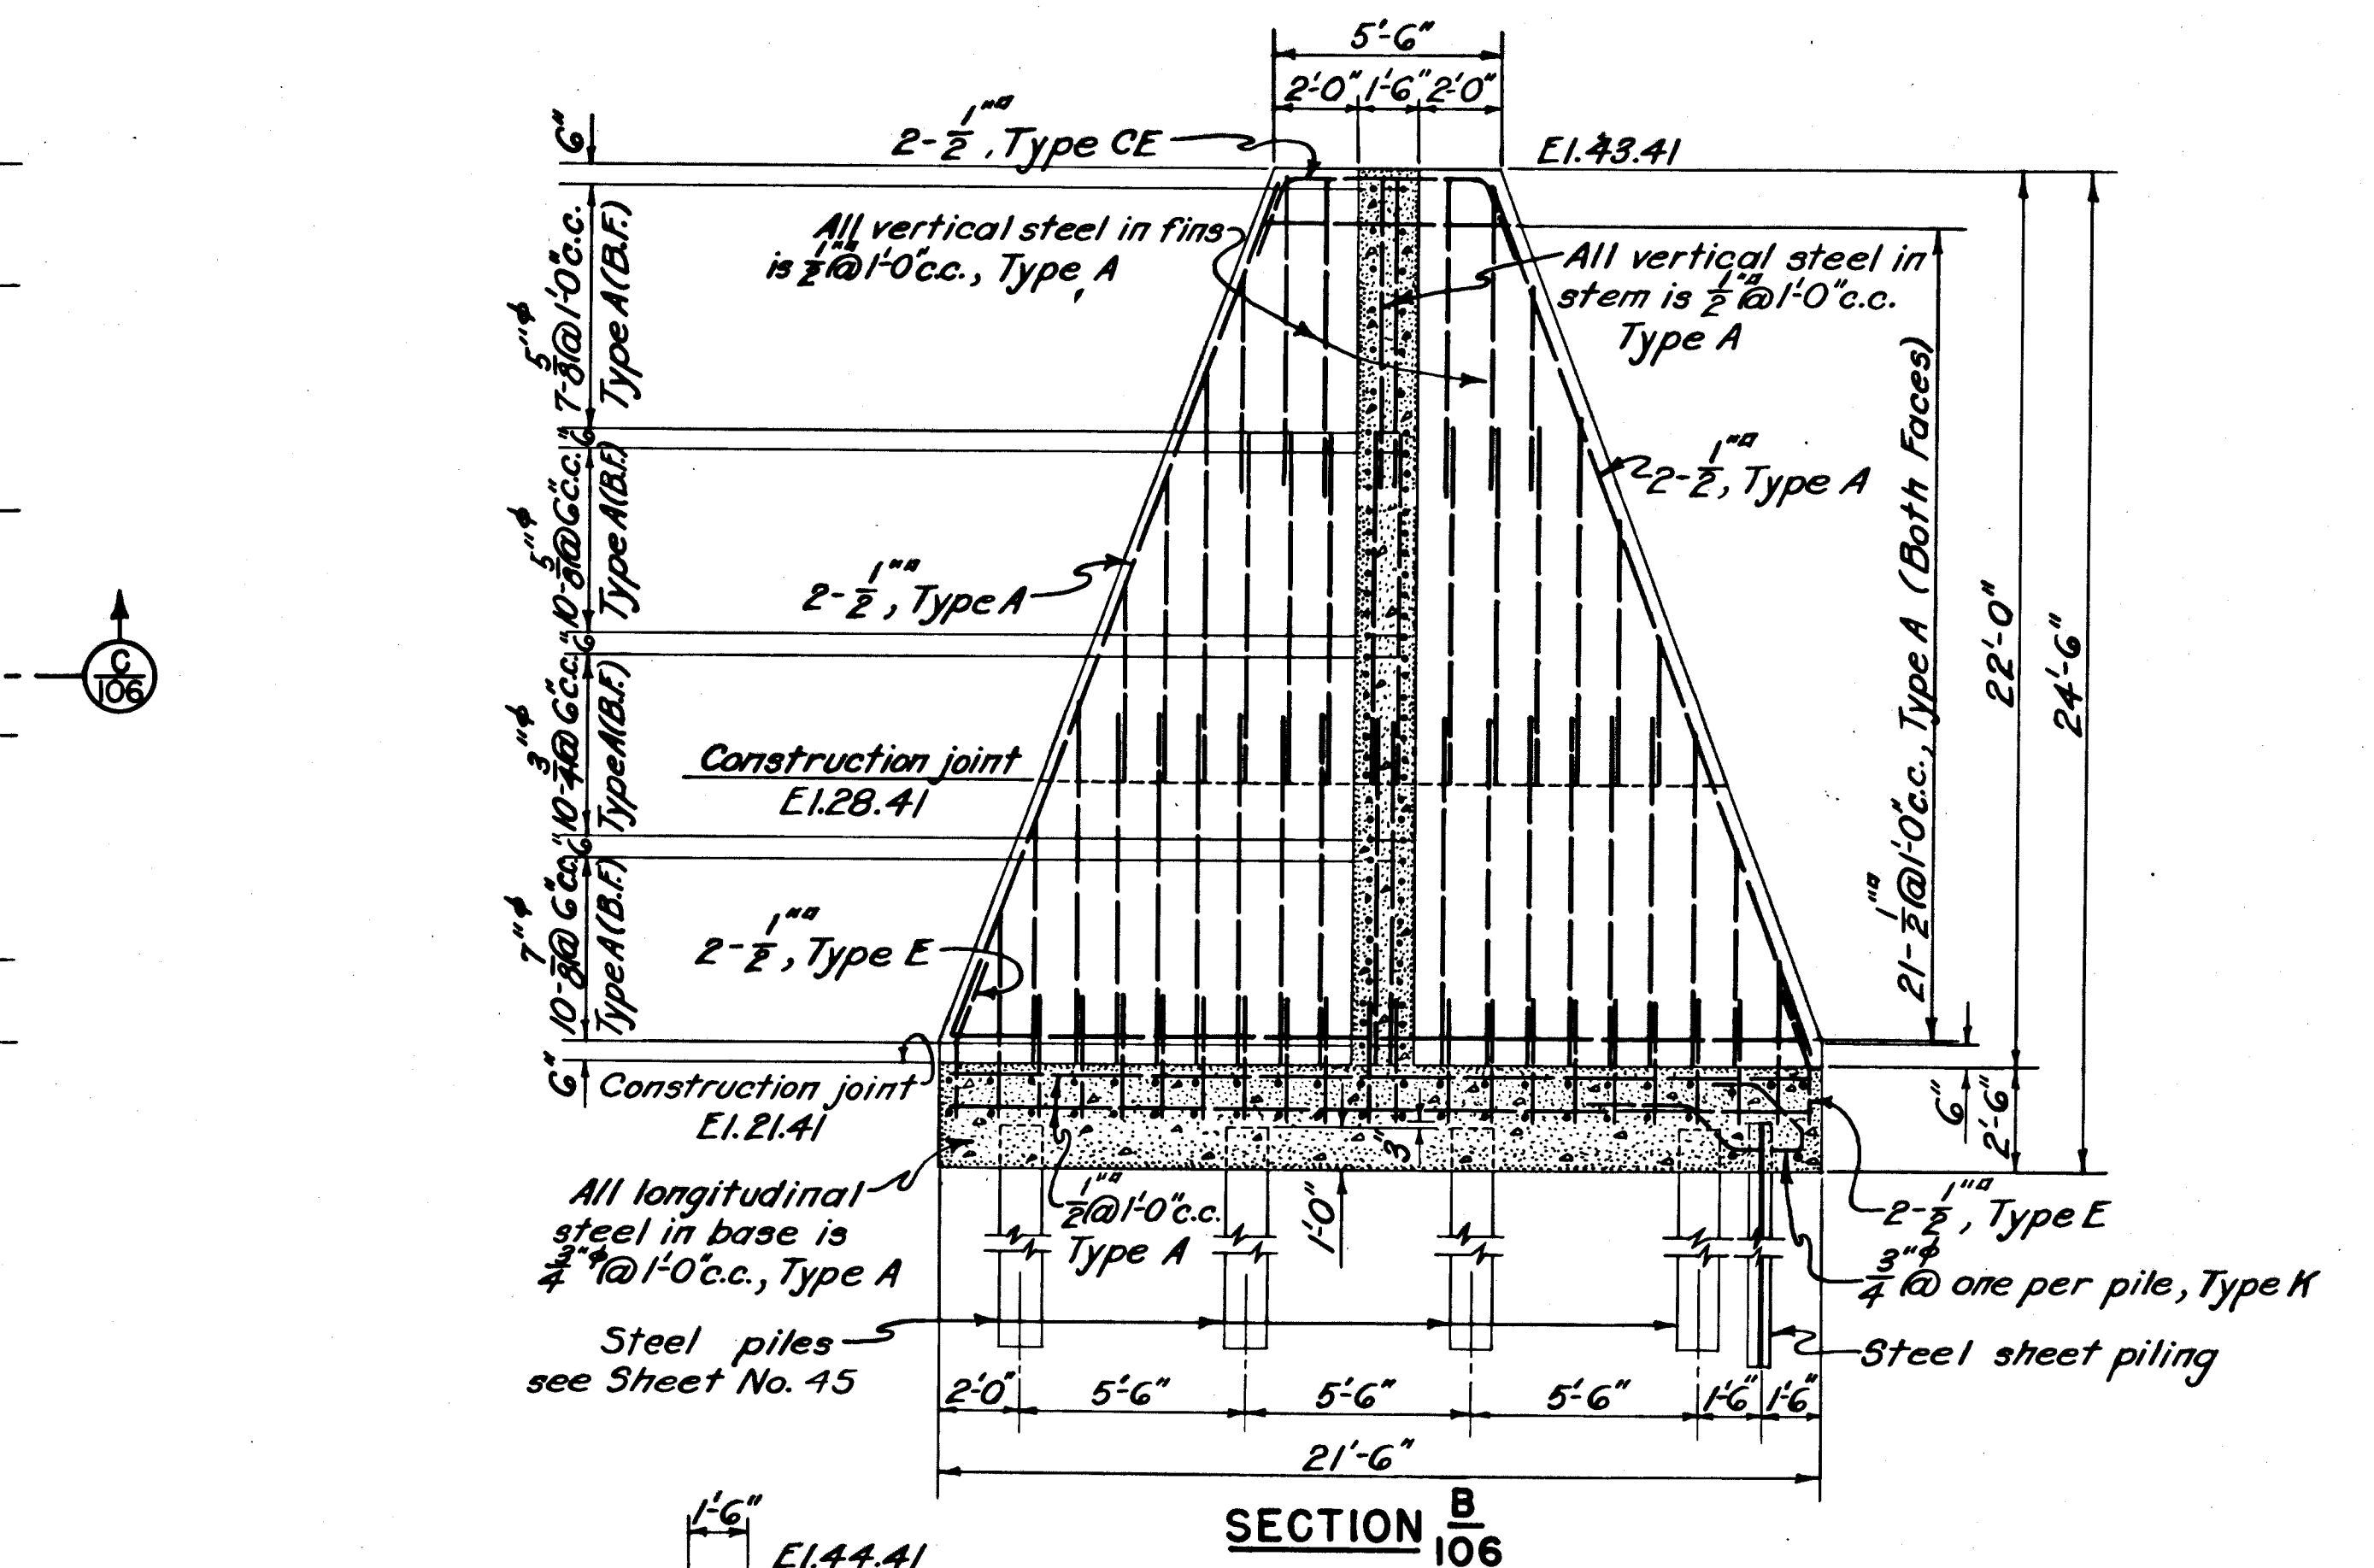

NOTES
For concrete details see Sheet No.54.
For general notes see Sheet No.103.

		12-31-45 As built revisions								
A		3/10/41 Change in wall.						J.C.D.	MW	JWB
KEY	DATE	REVISION (indicated by Δ)				REV. BY	CHK. BY	AP. BY		
CONNECTICUT RIVER FLOOD CONTROL										
HARTFORD DIKE										
RIVERFRONT, MORGAN ST. TO STA. 96+73										
CUT-OFF WALL AND REG. WALL										
STA. 44+22.63 TO STA. 44+85.68										
CONNECTICUT RIVER					CONNECTICUT					
IN 135 SHEETS			SCALE: 1/4 IN. = 1 FT.			SHEET NO. 106				
U.S. ENGINEER OFFICE, PROVIDENCE, R.I.,							MAY 1940			
SUBMITTED:		APPROVED / RECOMMENDED:				APPROVED:				
<i>Hendrick B. Nichols</i>		<i>J.P. Sullivan</i>				<i>G.T. Seagraves</i>				
SENIOR ENGINEER		PRINCIPAL ENGINEER				LT. COL. CORPS OF ENGINEERS				
HEAD DESIGN SECTION		CHIEF, F.C. ENGINEERING DIV.				DISTRICT ENGINEER				
DESIGNED:		DRAWN: J.S.M.				FISCAL YEAR 1940				
<i>J.C.D.</i>		TRACED: J.S.M.								
ASSOC. ENGINEER		CHECKED: <i>J.W. Shee</i>				FILE NO. CT-4-2566				