




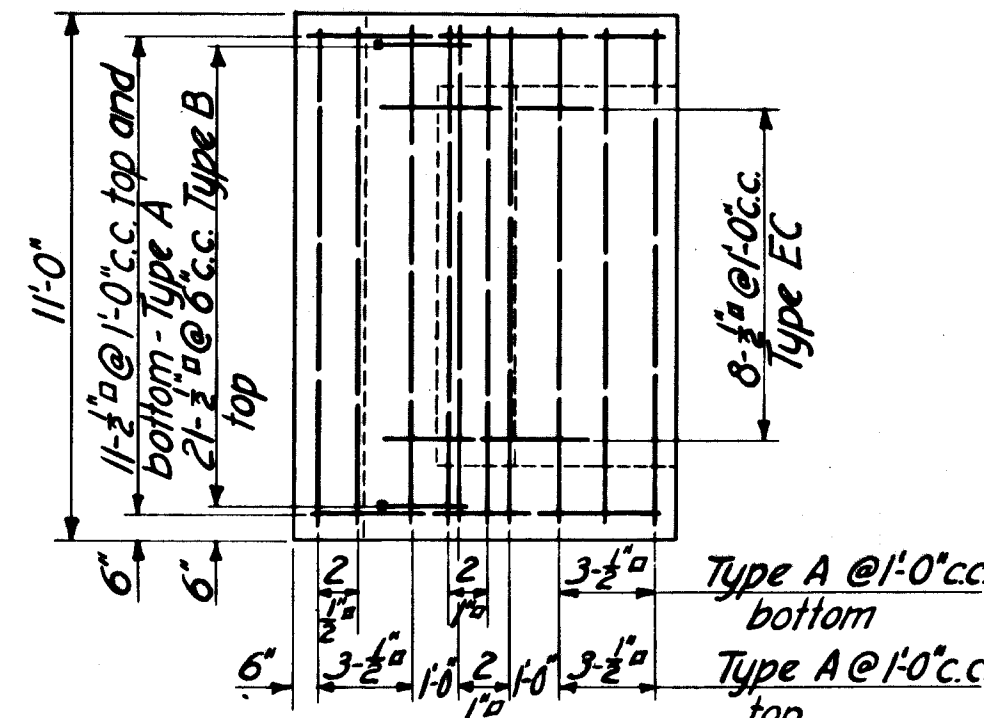


FLOOR PLAN

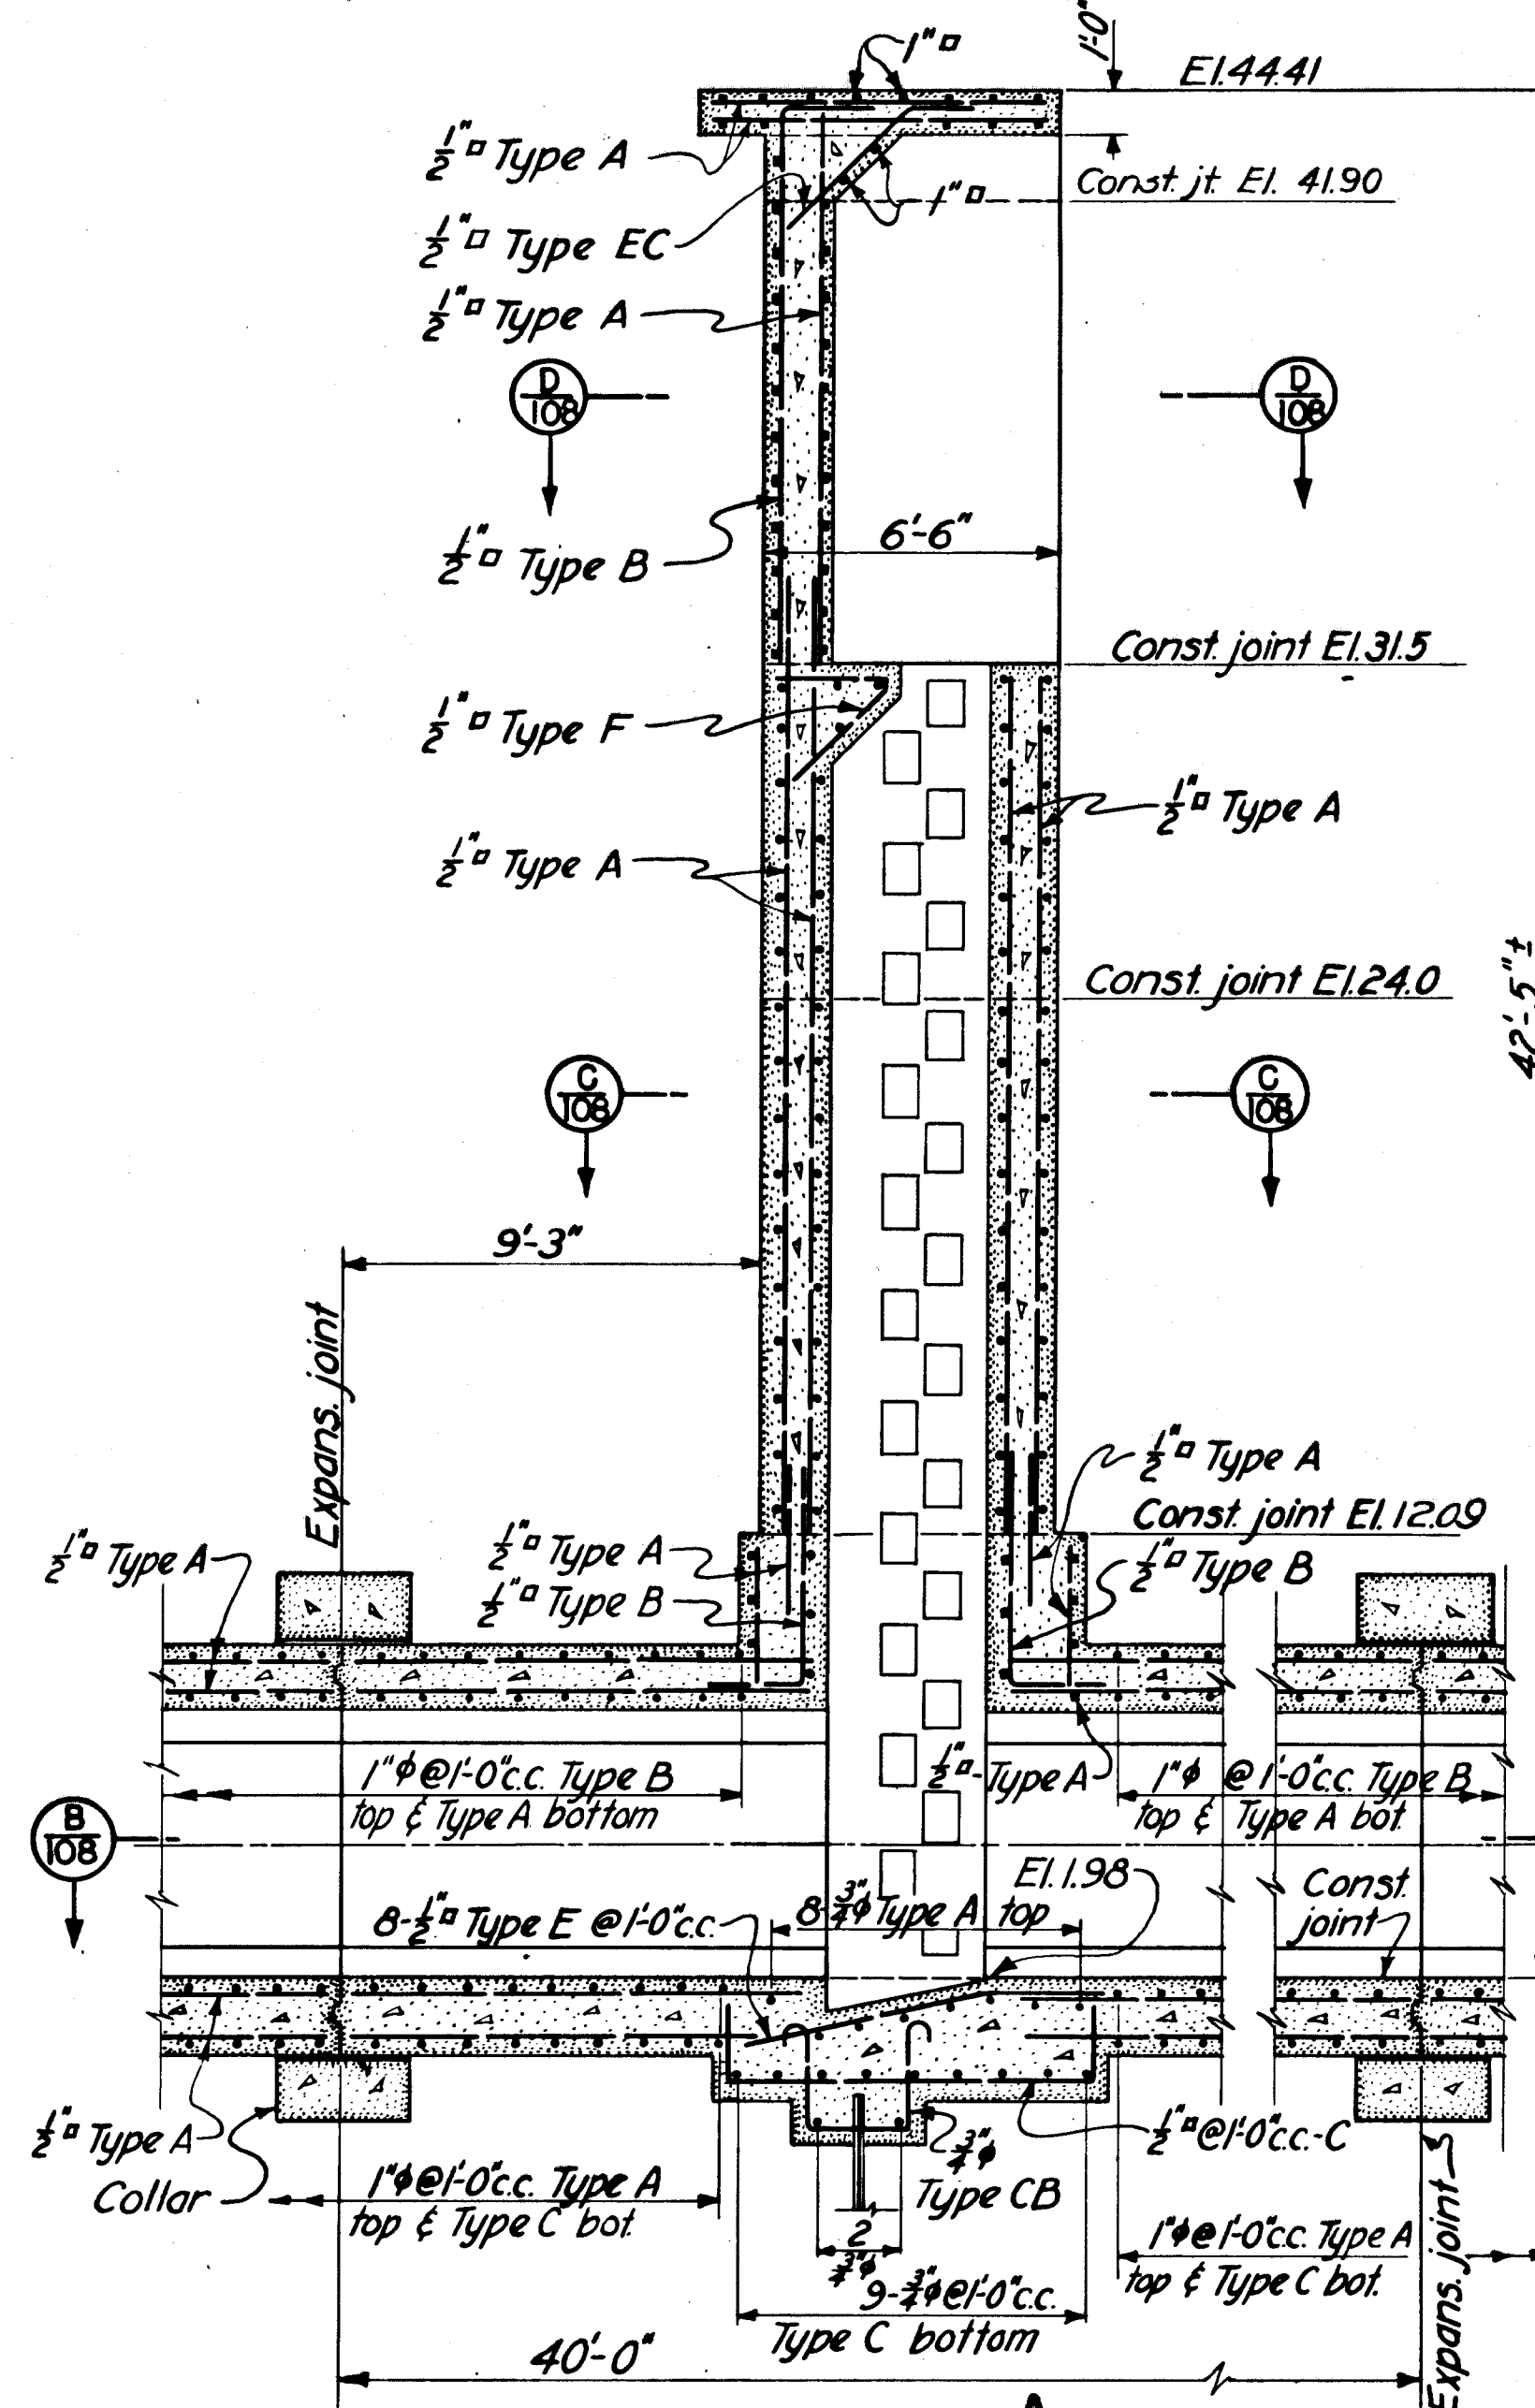


SECTION A 108

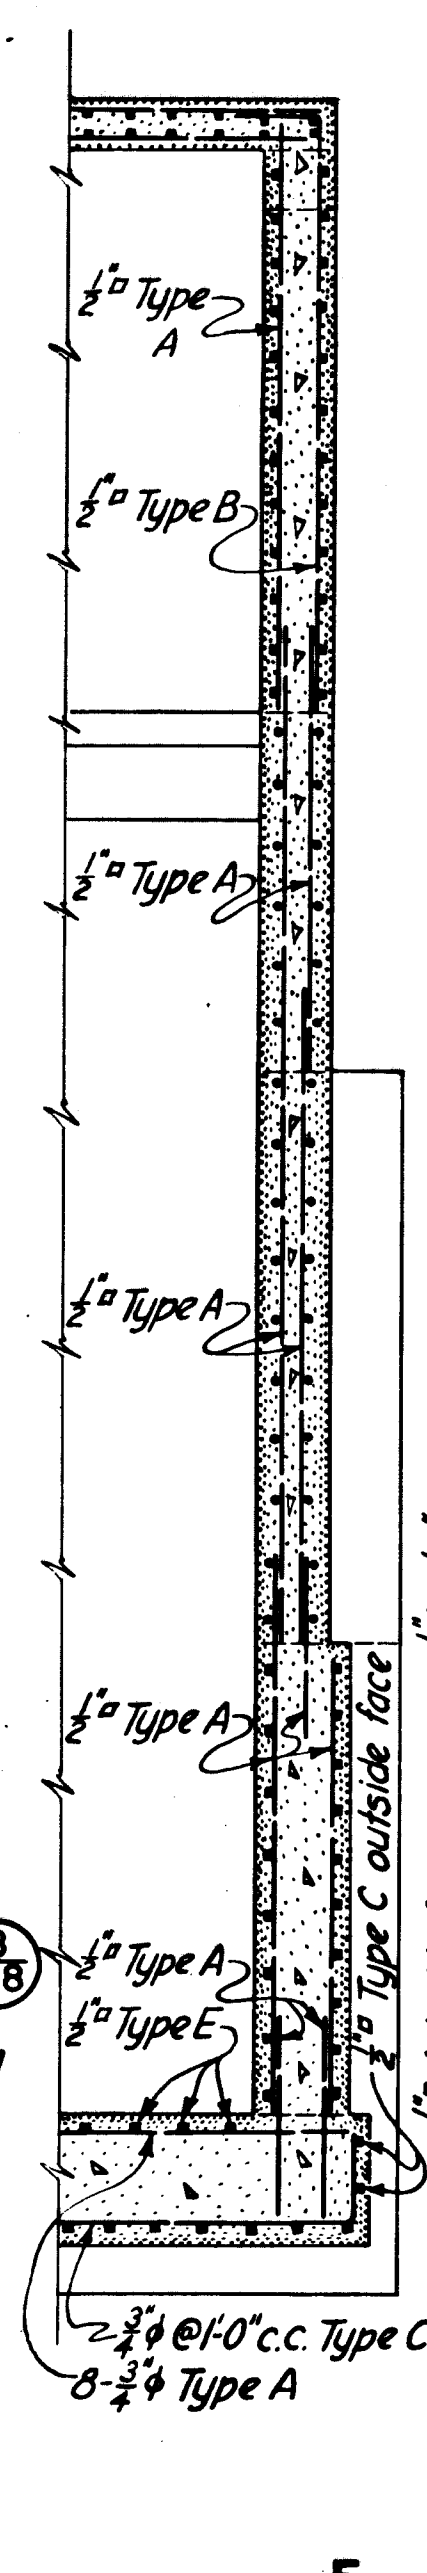


SECTION E 108

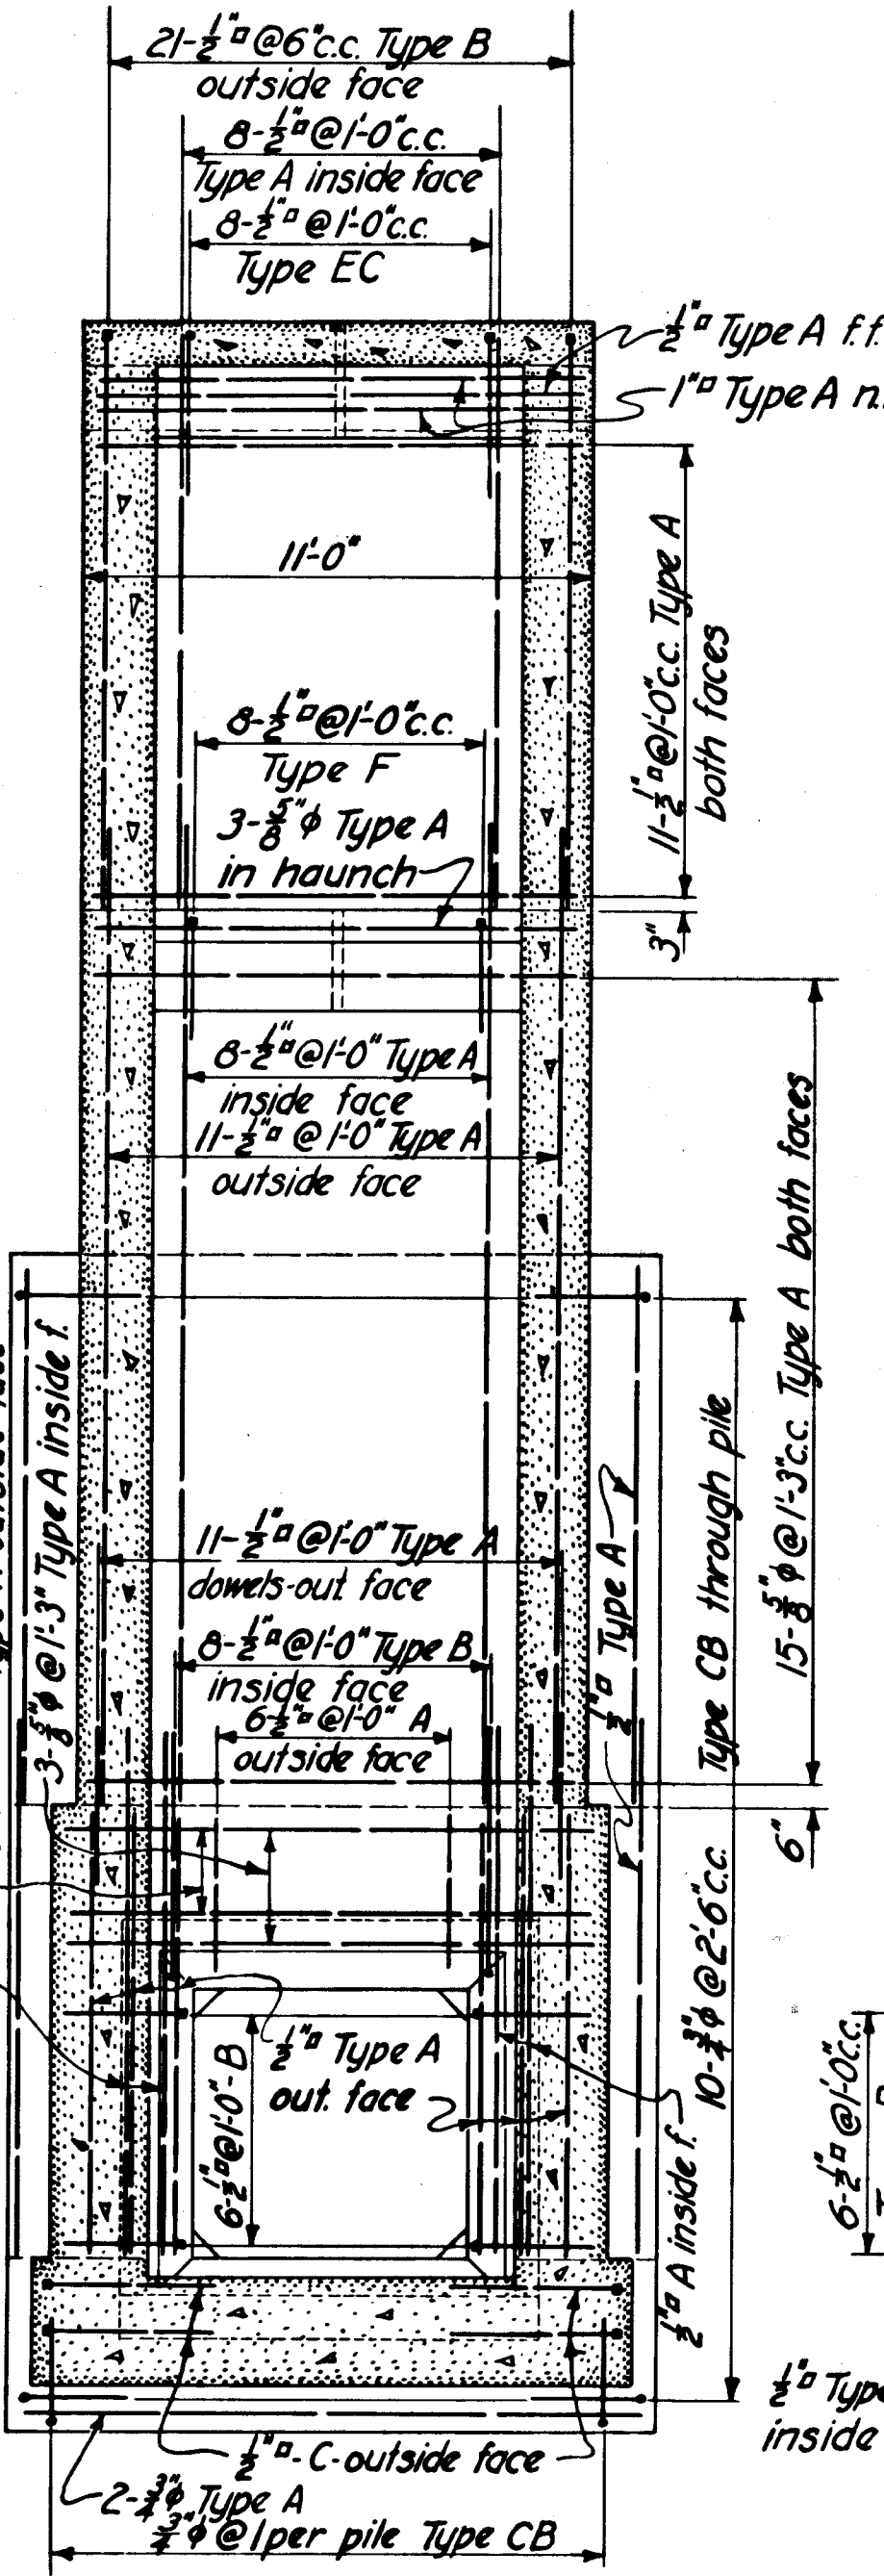


SECTION F 108

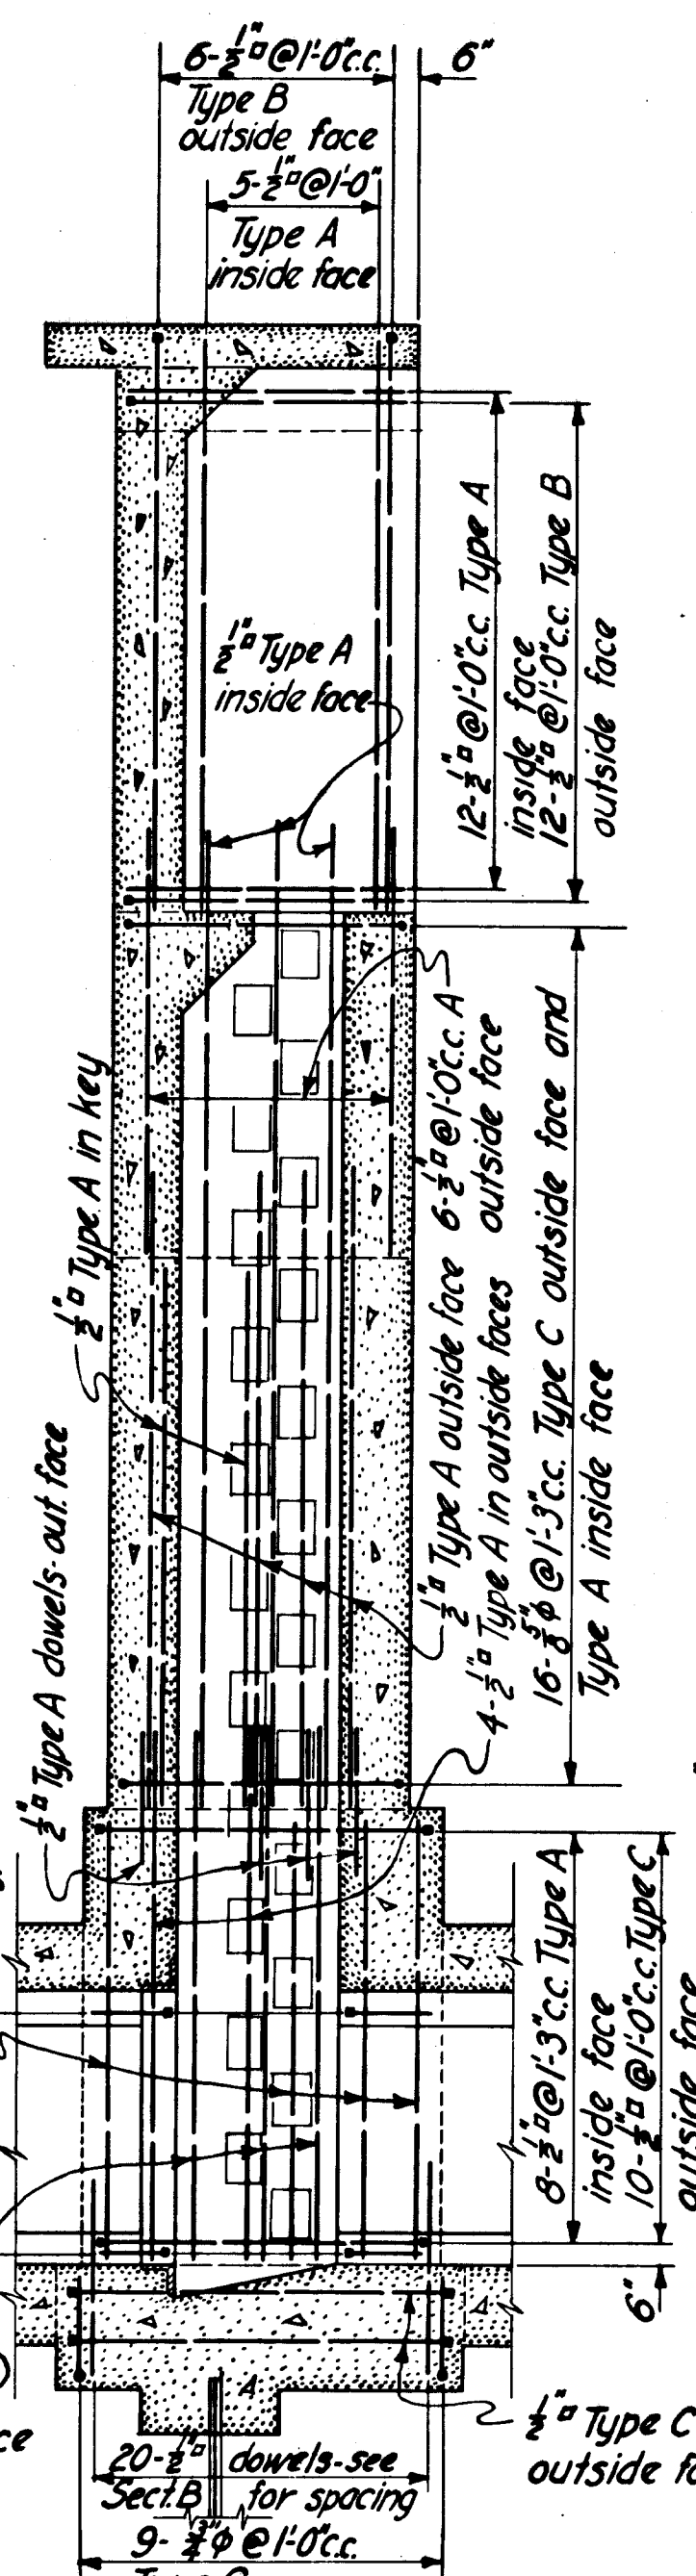


SECTION G 108

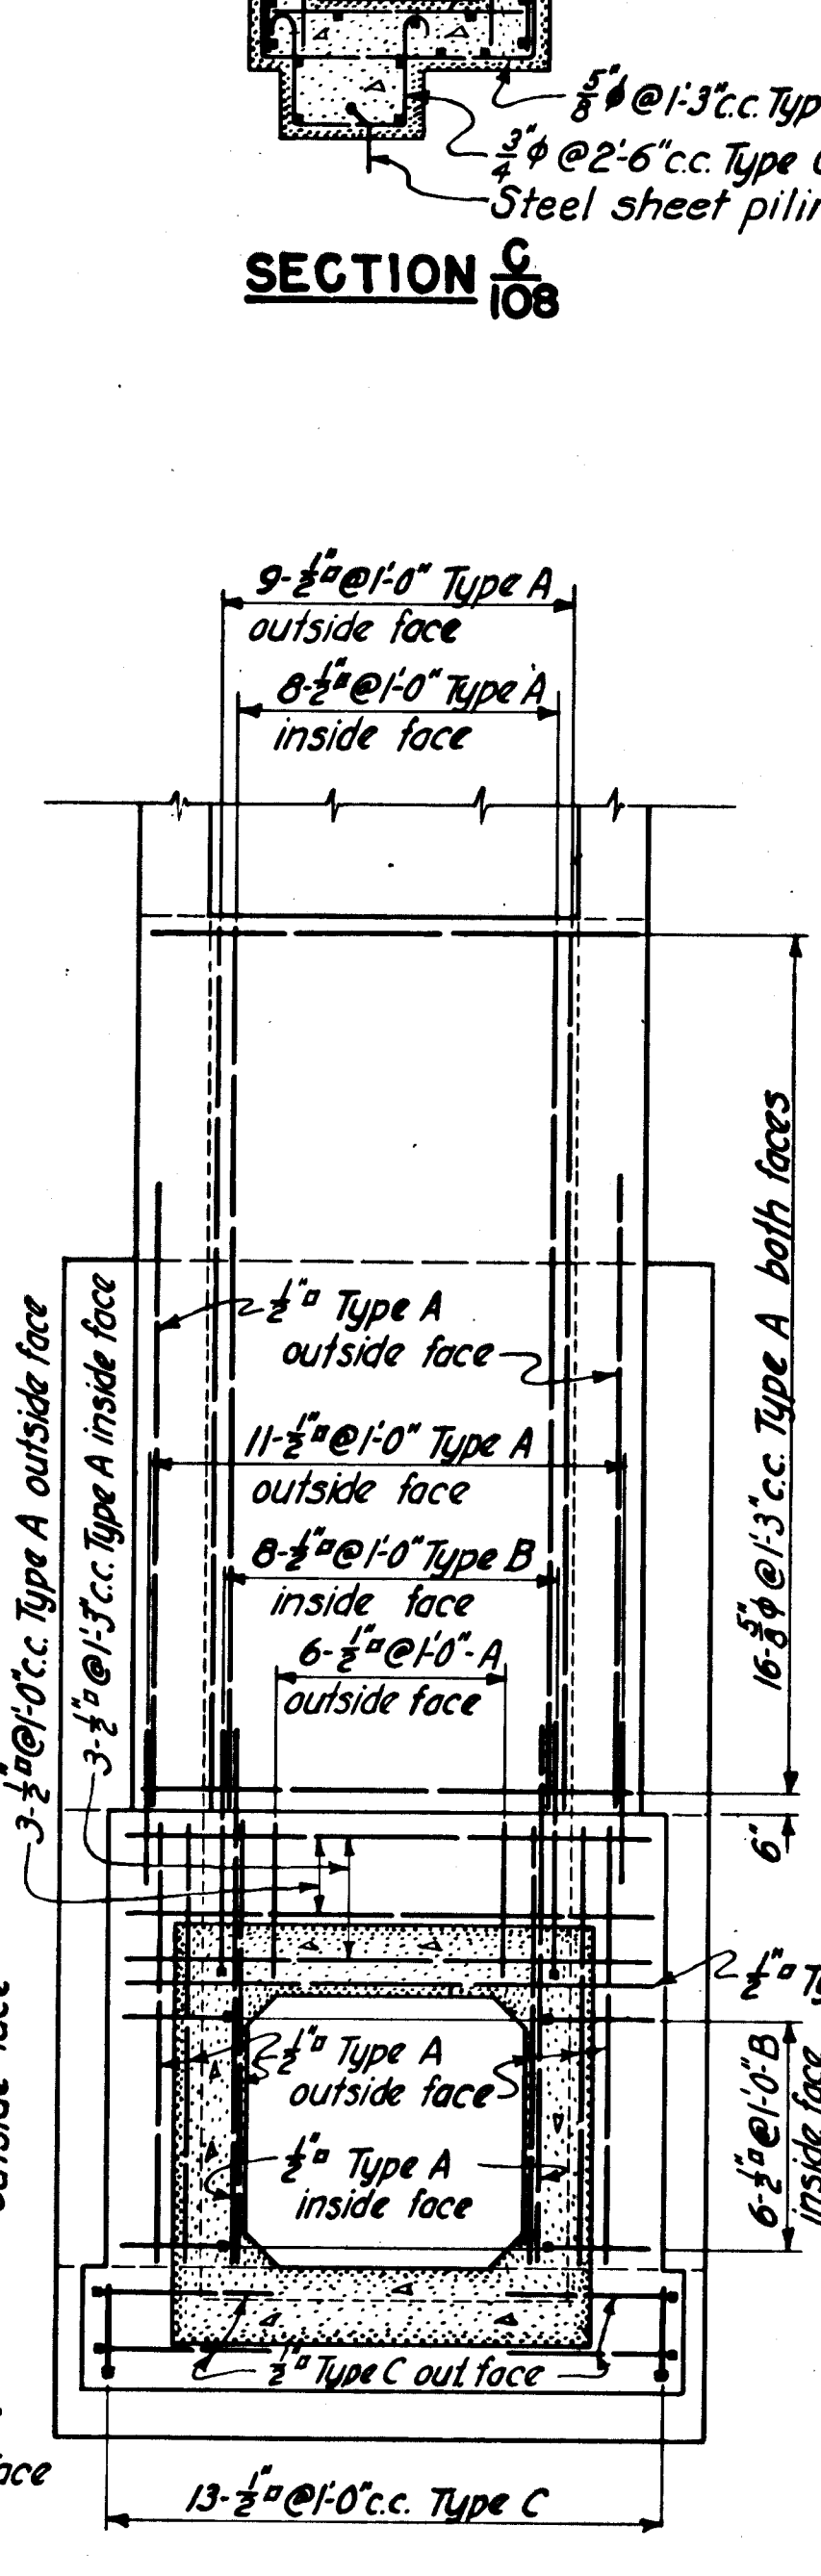


SECTION H 108

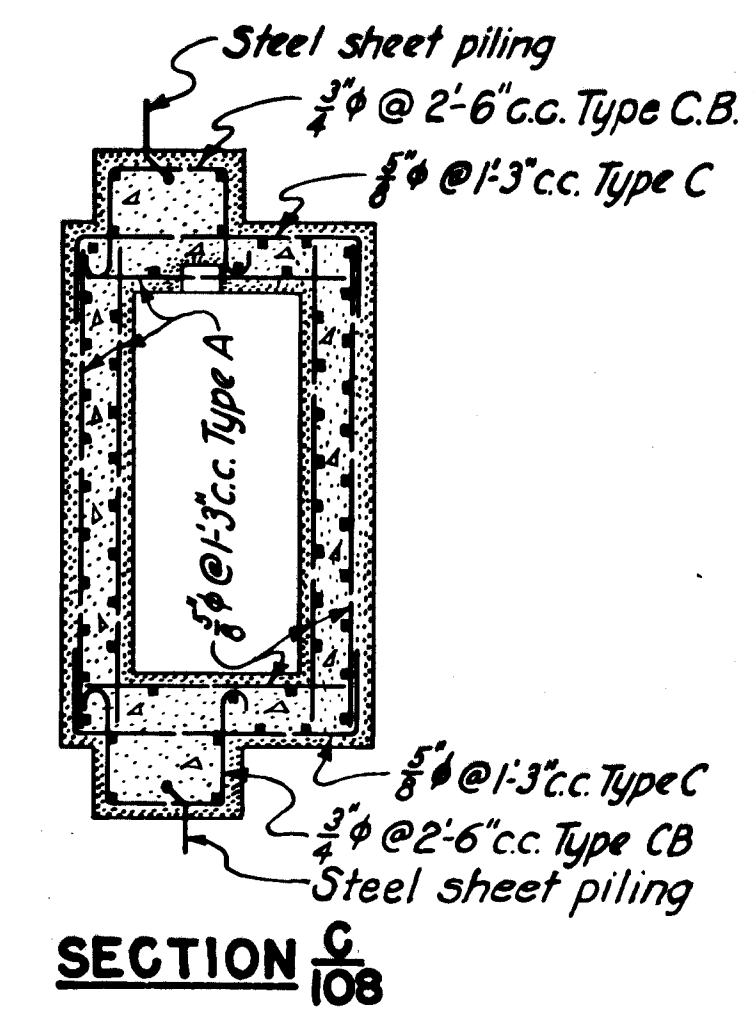

SECTION C 108

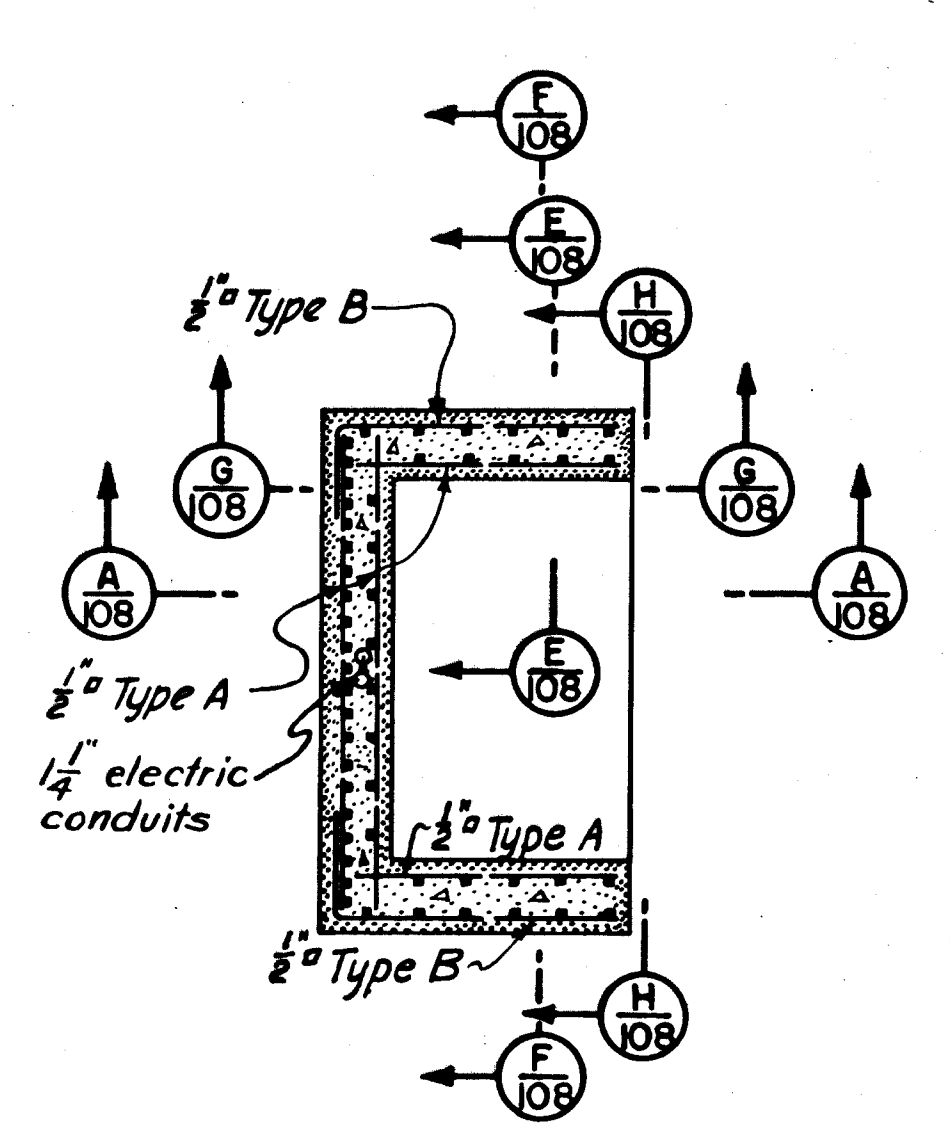

SECTION D 108

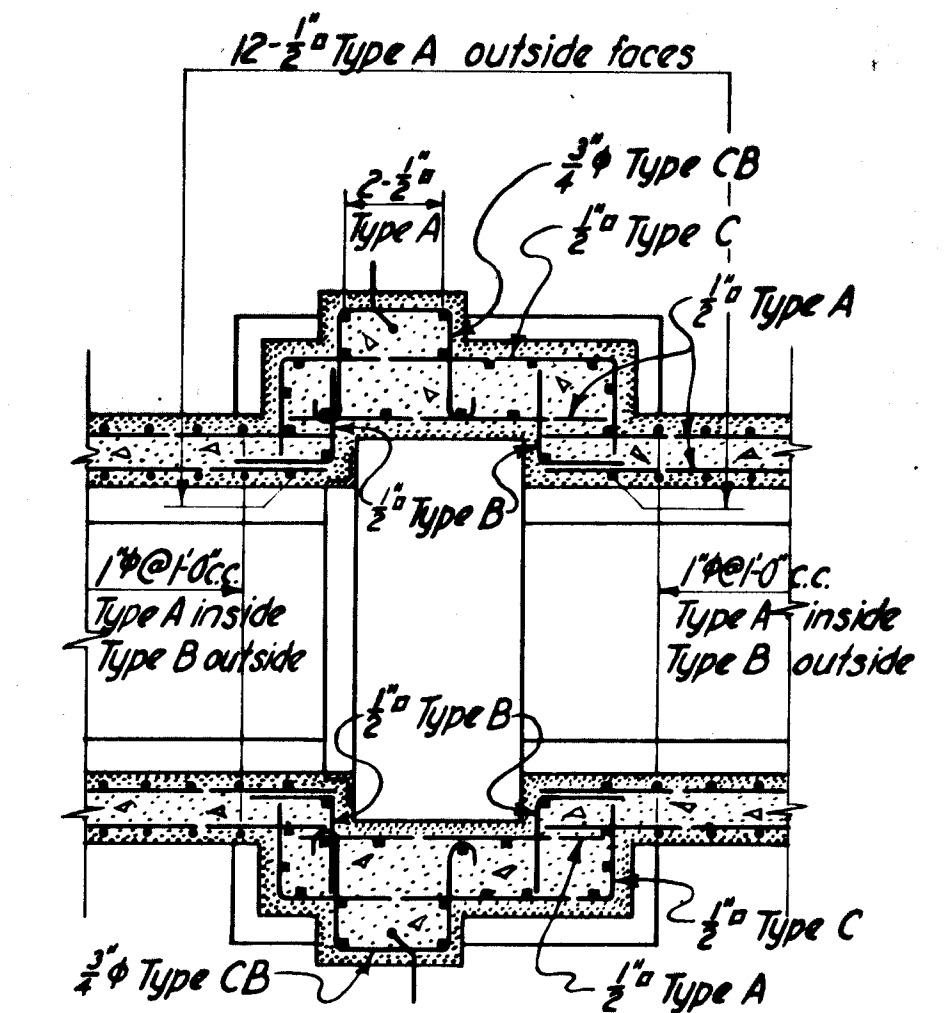

SECTION B 108

NOTES
 For concrete details see Sheet No. 35
 For additional reinforcement details see Sheet No. 107
 For general notes see Sheet No. 107.

CONNECTICUT RIVER FLOOD CONTROL
HARTFORD DIKE
 RIVERFRONT, MORGAN ST. TO STA. 96+73
 KEENEY LANE CONDUIT AND GATE STRUCTURE
 STEEL REINFORCEMENT NO. 2

CONNECTICUT RIVER IN 135 SHEETS SCALE: 1/4" = 1' FT. CONNECTICUT SHEET NO. 108

U. S. ENGINEER OFFICE, PROVIDENCE, R. I., MAY 1940

SUBMITTED: *[Signature]* APPROVAL: *[Signature]* RECOMMENDED: *[Signature]*
 SENIOR ENGINEER PRINCIPAL ENGINEER DISTRICT ENGINEER
 HEAD DESIGN SECTION CHIEF F. C. ENGINEERING DIV.

DESIGNED: *[Signature]* DRAWN: J. H. L. TRACED: J. H. L. CHECKED: *[Signature]*
 ASSOC. ENGINEER

FISCAL YEAR 1940
 FILE NO. CT-4-2568

KEY	DATE	REVISION (Indicated by Δ)	REV. BY	CK. BY	AP. BY
	12-31-45	As built revisions			