

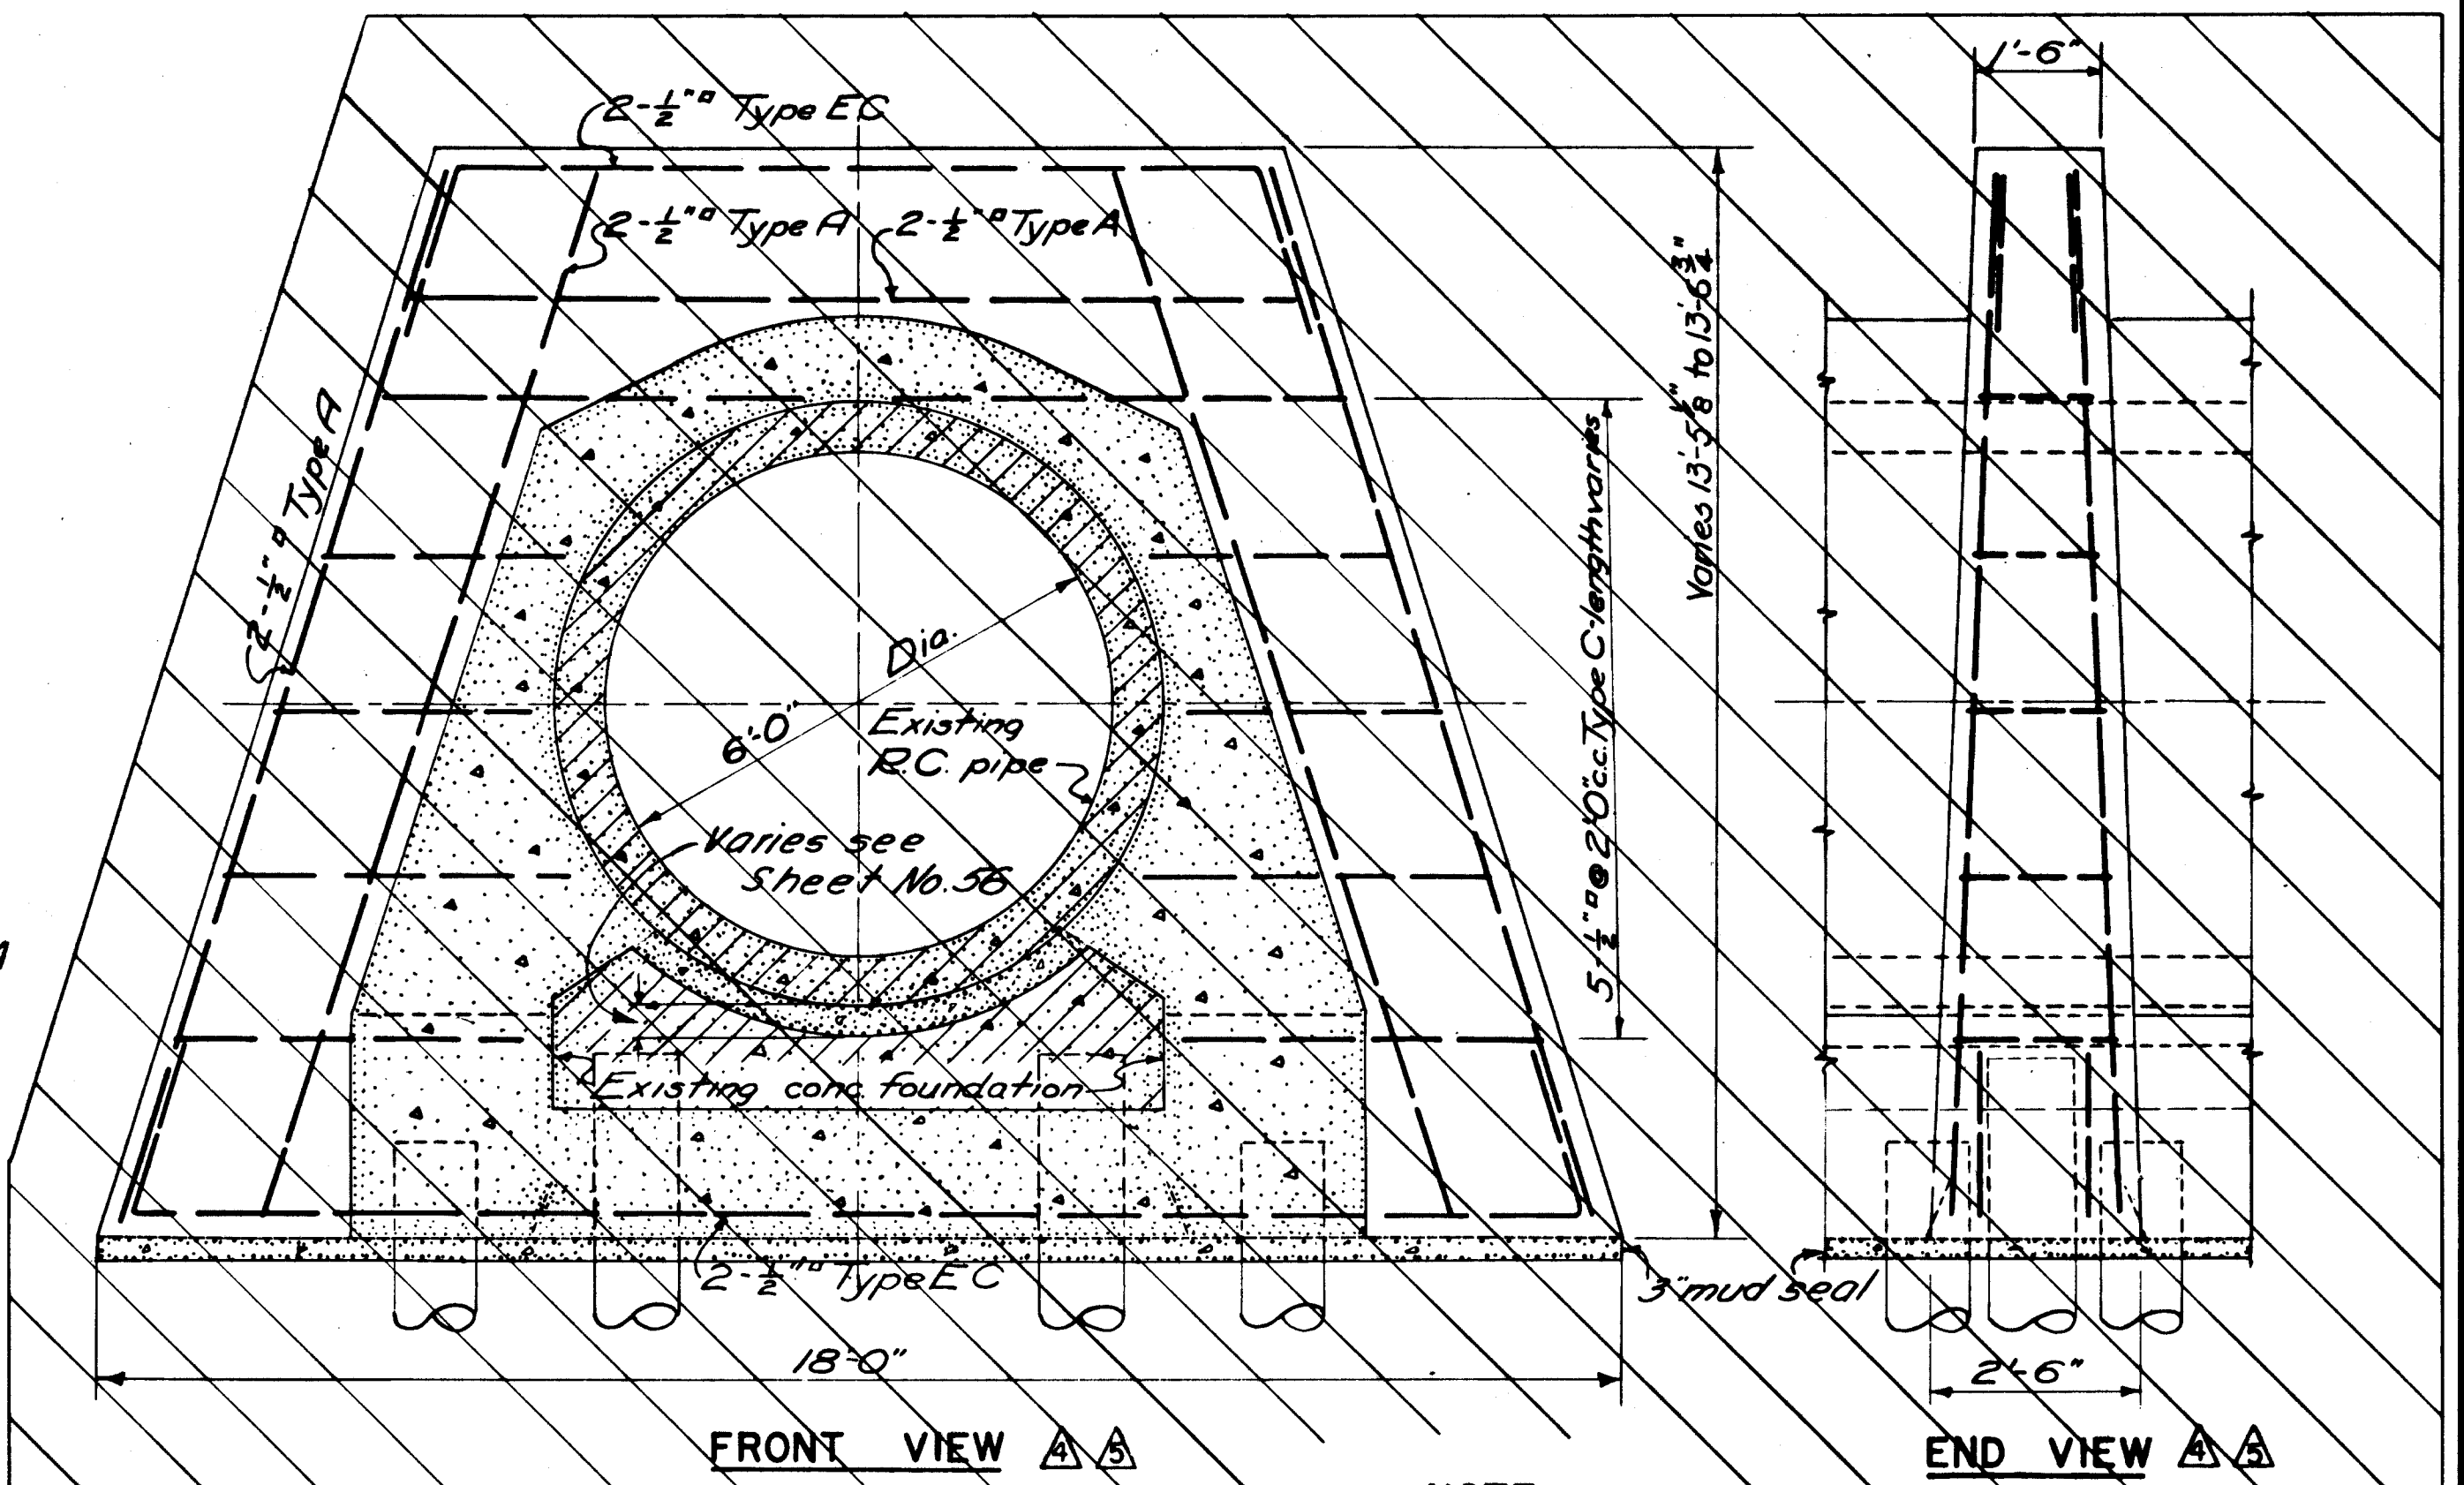
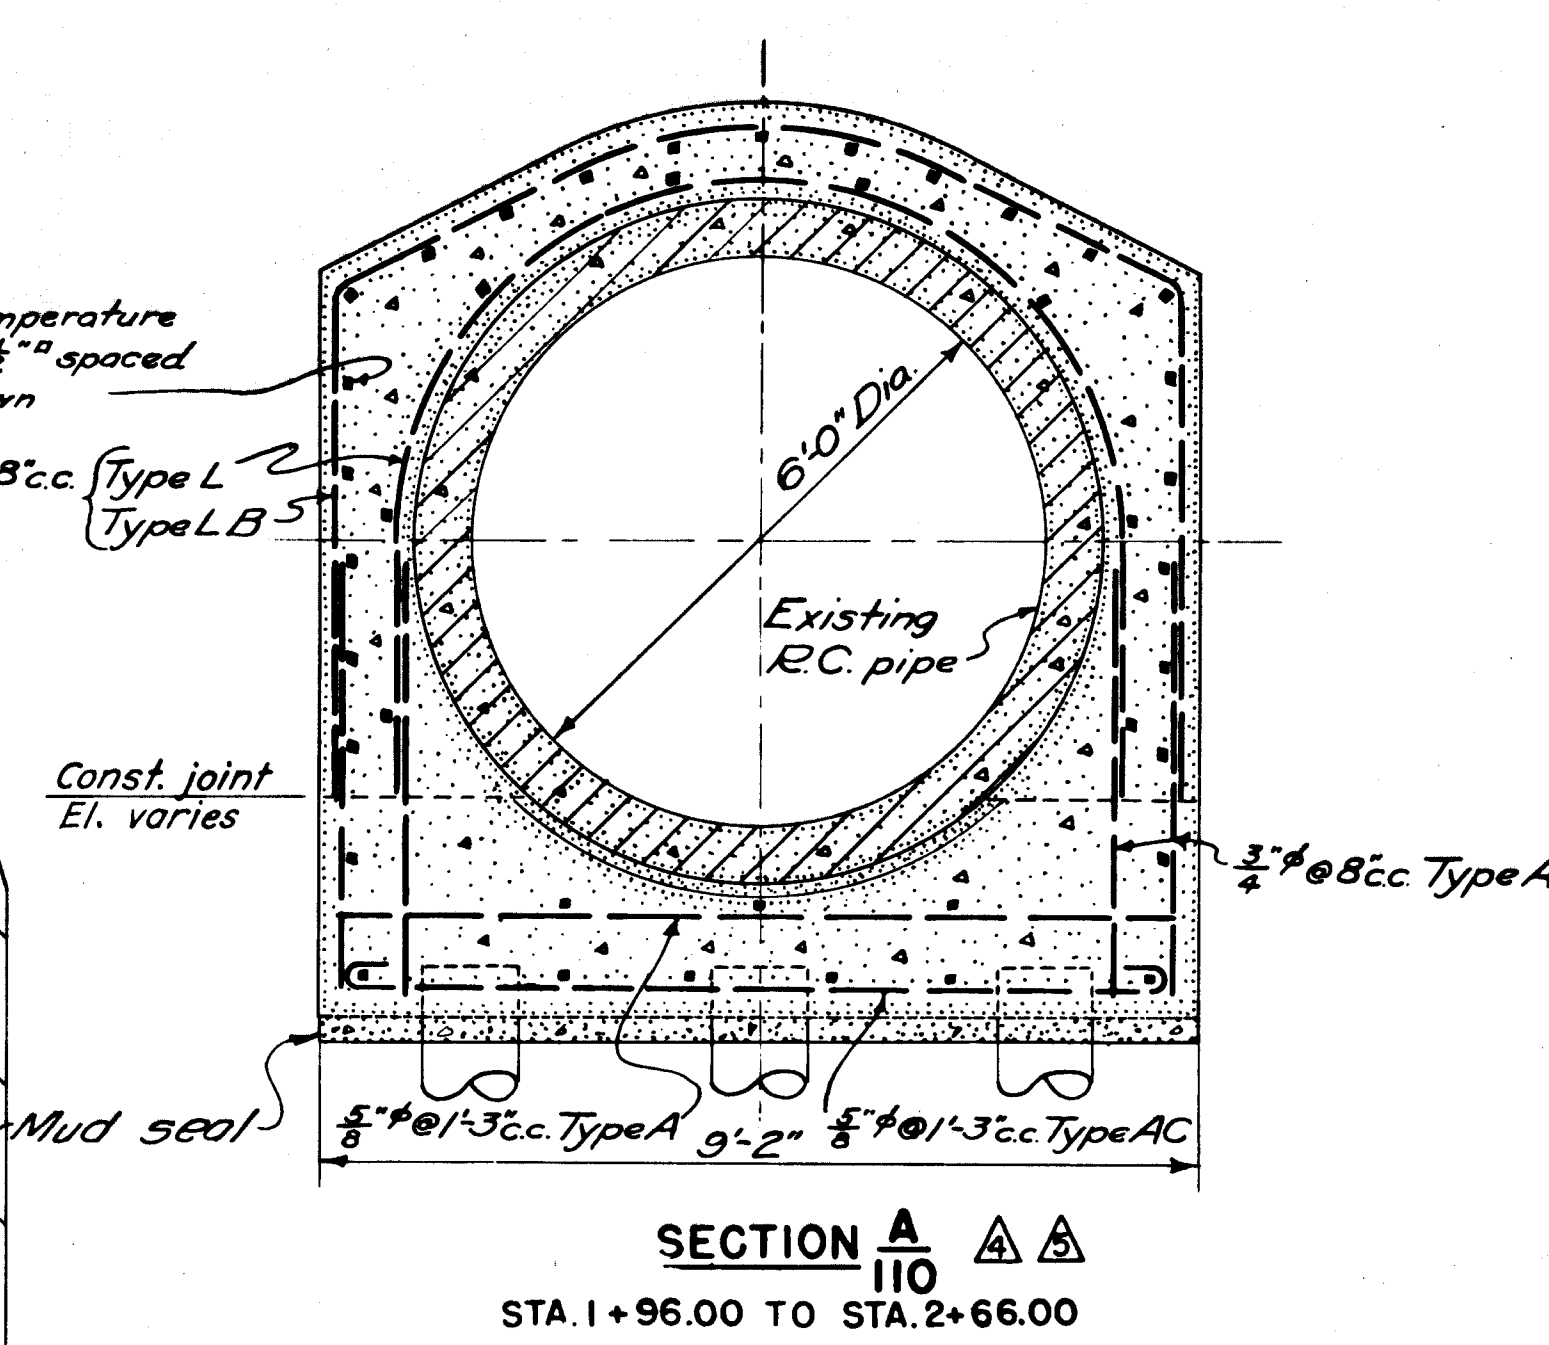
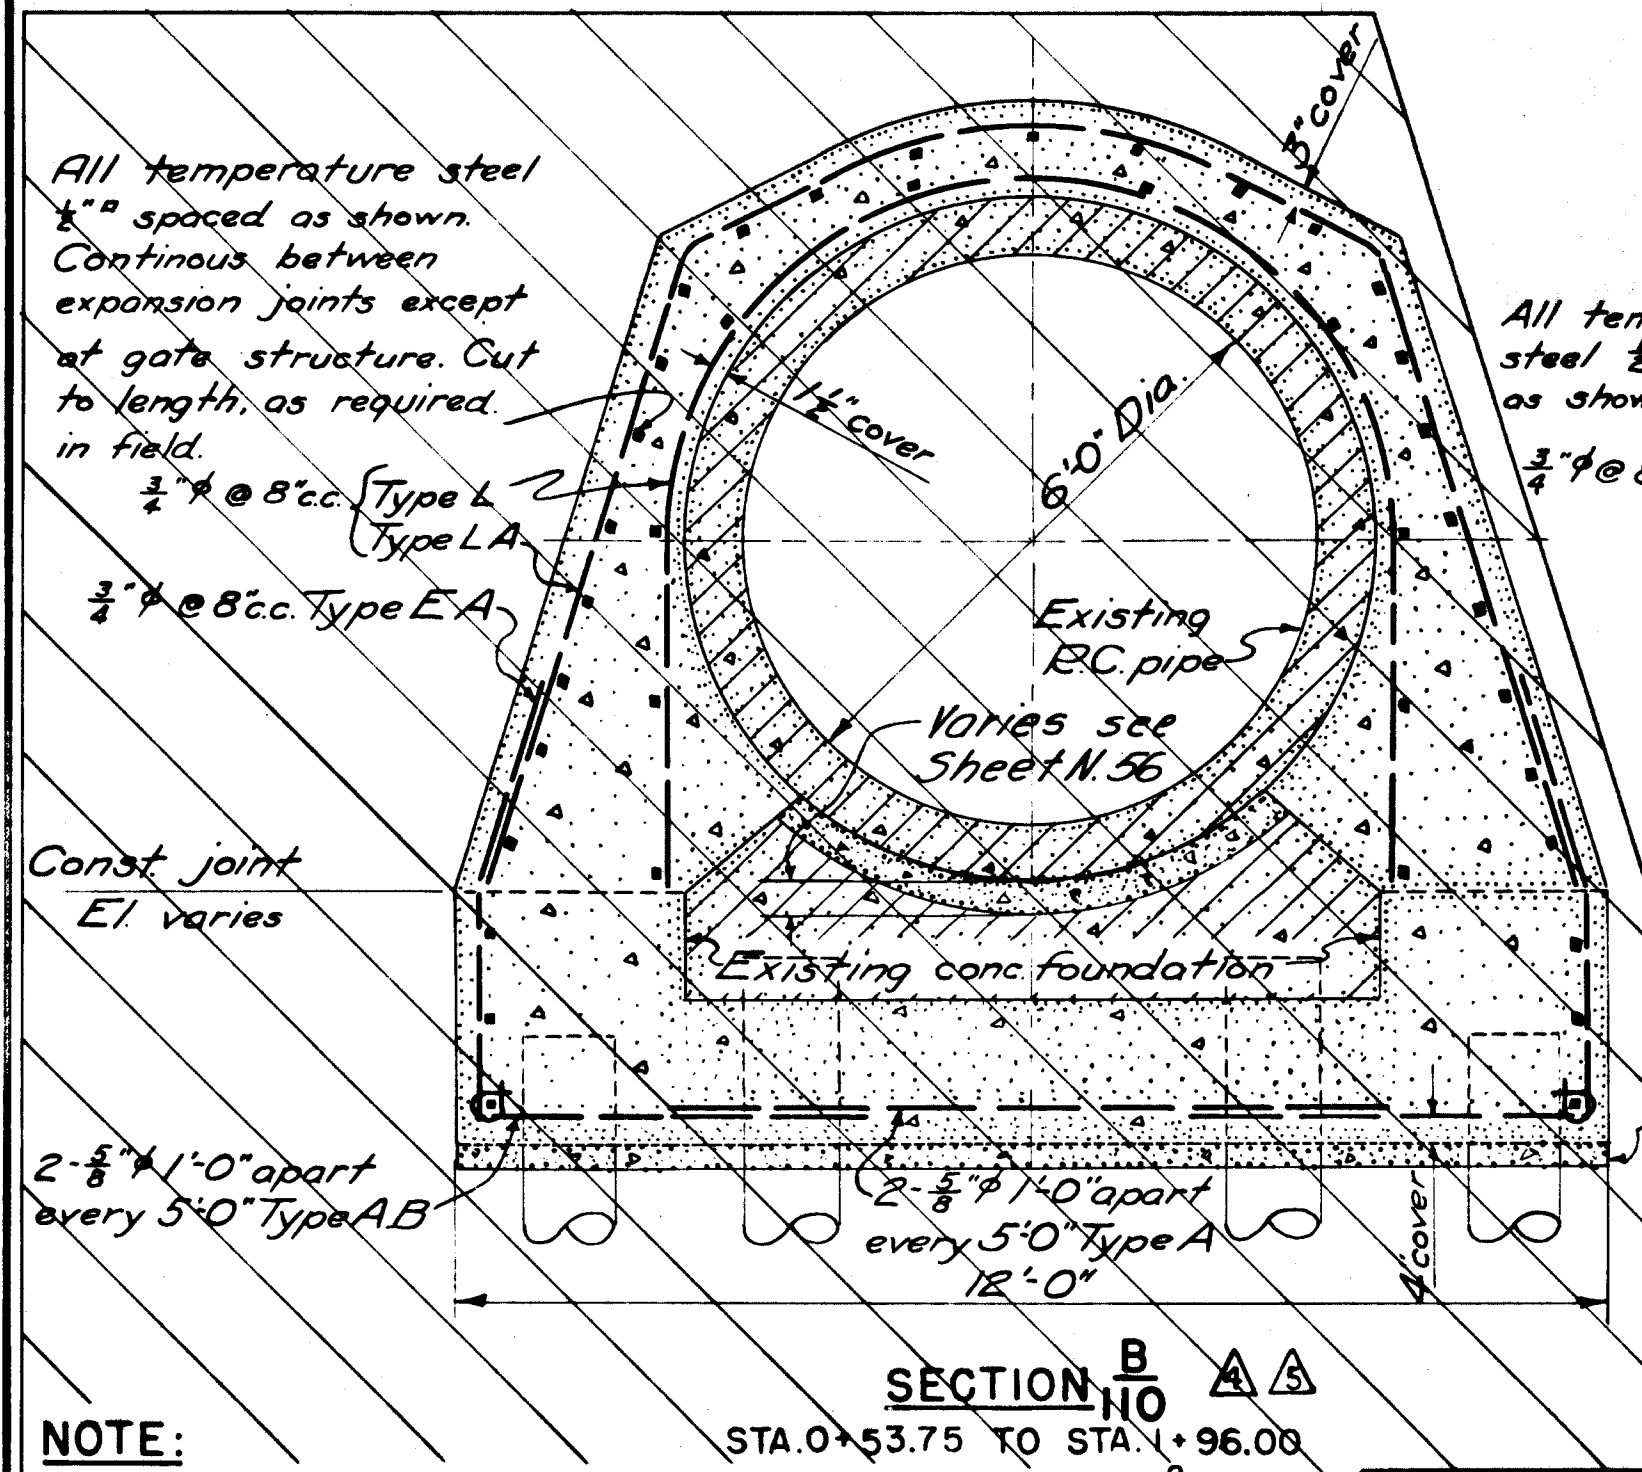
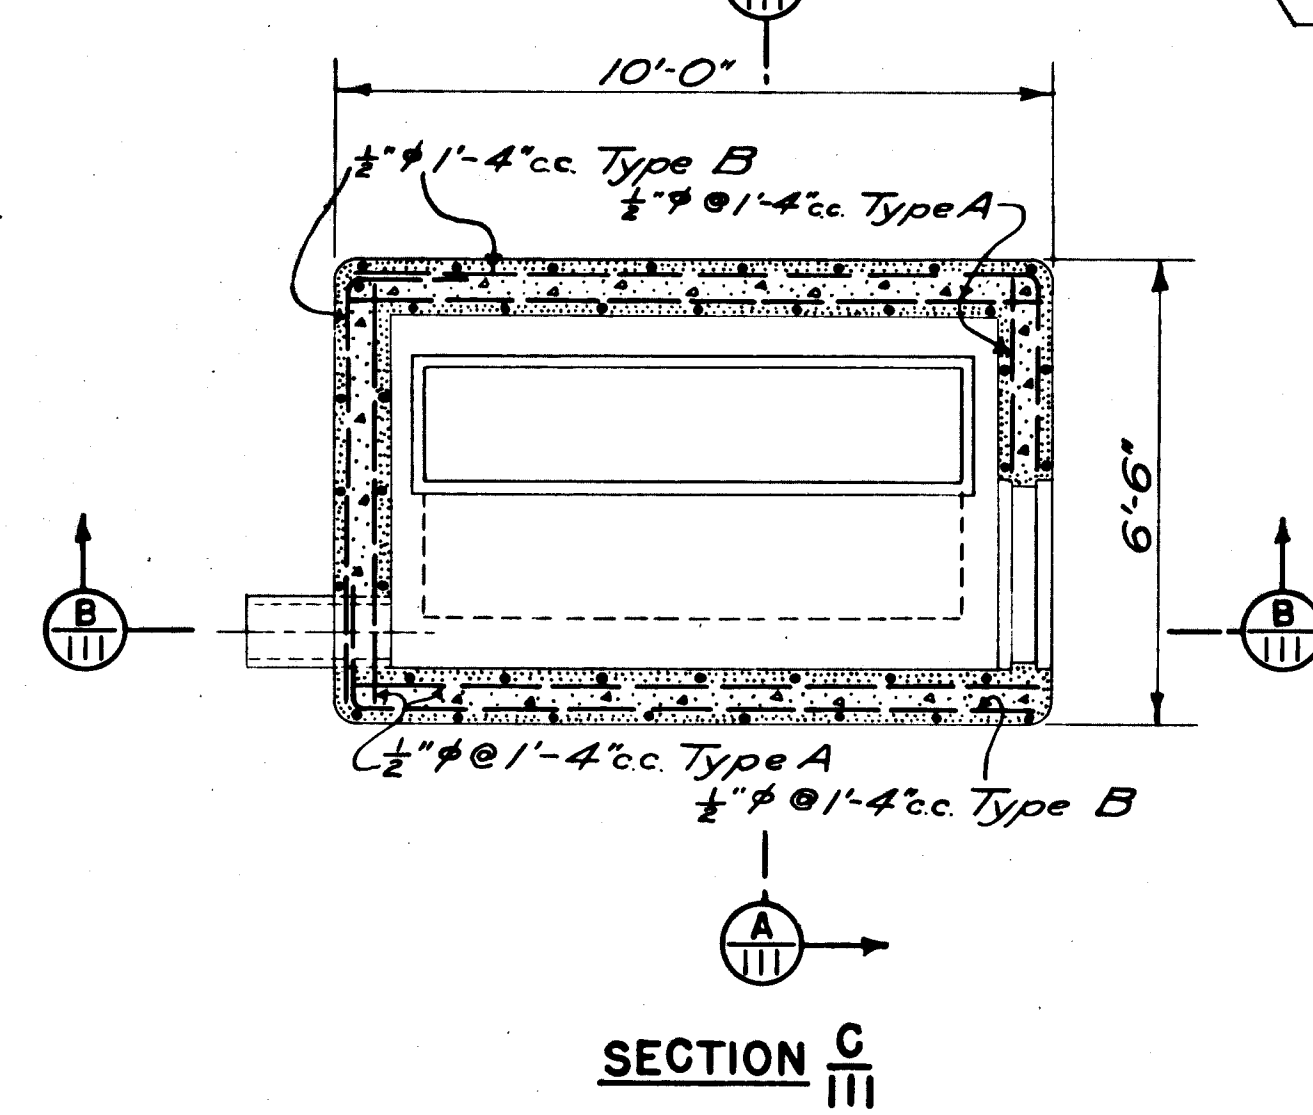


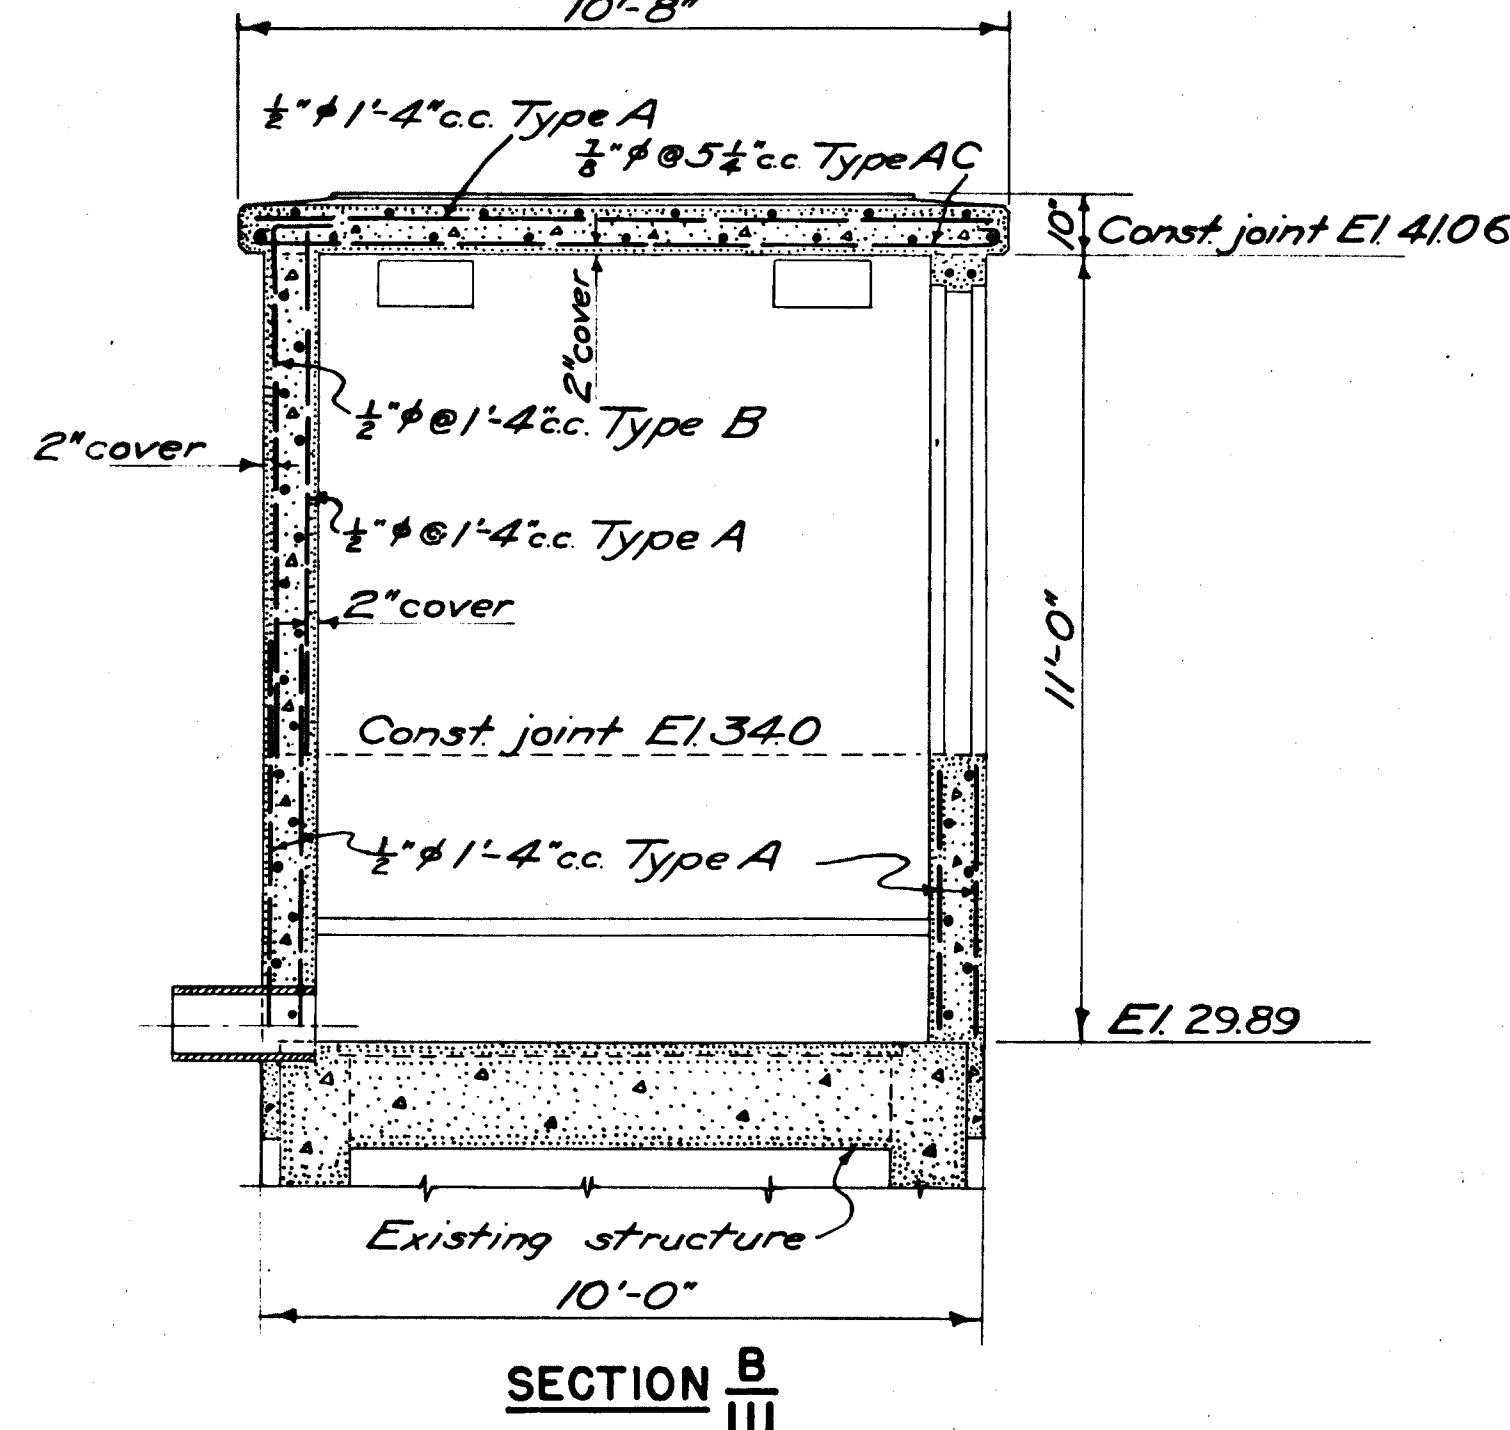

NOTE: For "as built" information covering Section B, see Sheet No. 3, File No. CT-4-3063 of Supplemental Agreement, Reconstruction of Massee St. Sewer, Item Ht. 5 & 7bR, Detail of Massee Conduit.

CONDUIT DETAILS
SCALE 1/2" = 1'-0"

NOTE: For "as built" information covering conduit seep ring, see Sheet No. 6, File No. CT-4-3130 of Supplemental Agreement, Reconstruction of Massee St. Sewer, Item Ht. 5 & 7bR, Detail of Massee Conduit.

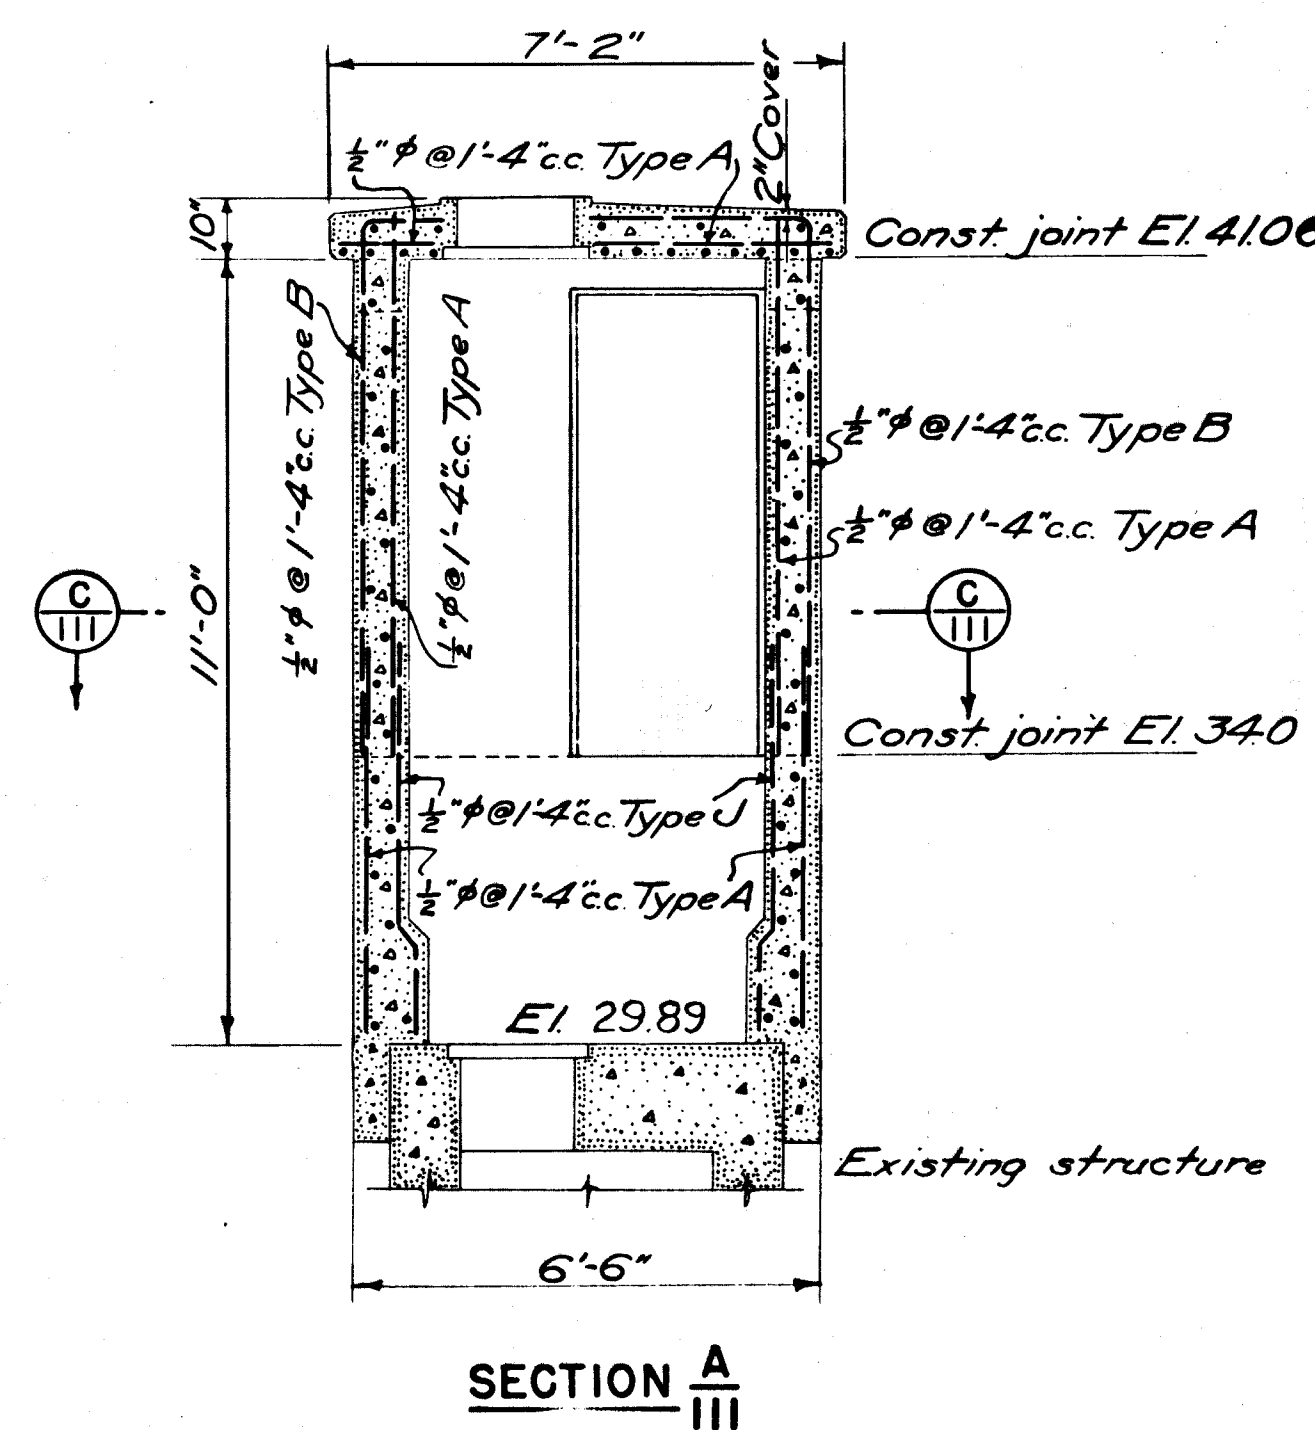

SECTION A
III

SECTION B
III

SECTION C
III

GATE HOUSE

SCALE 1/2" = 1'-0"

NOTES
For concrete details see Sheets No. 56 and 57.
For general notes see Sheet No. 107.
Original steel may be used by shortening splices and increasing cover slightly.

CONNECTICUT RIVER FLOOD CONTROL
HARTFORD DIKE
RIVERFRONT, MORGAN ST. TO STA. 96+73
MASSEK STREET GATE HOUSE & CONDUIT
STEEL REINFORCEMENT NO. 2
CONNECTICUT RIVER
IN 135 SHEETS
SCALE: 1/2" = 1'-0"
SHEET NO. 111
U.S. ENGINEER OFFICE, PROVIDENCE, R.I., MAY 1940
SUBMITTED: [Signature]
APPROVAL RECOMMENDED: [Signature]
APPROVED: [Signature]
DESIGNED: [Signature]
DRAWN: N.I.
CHECKED: [Signature]
FISCAL YEAR 1940
FILE NO. CT-4-2571

KEY	DATE	REVISION (Indicated by Δ)	REV. BY	CK. BY	AP. BY
Δ	12-31-45	As built revisions			
Δ	10/31/40	Mud seal camber & note added	J.C.D.	W.M.	J.B.