
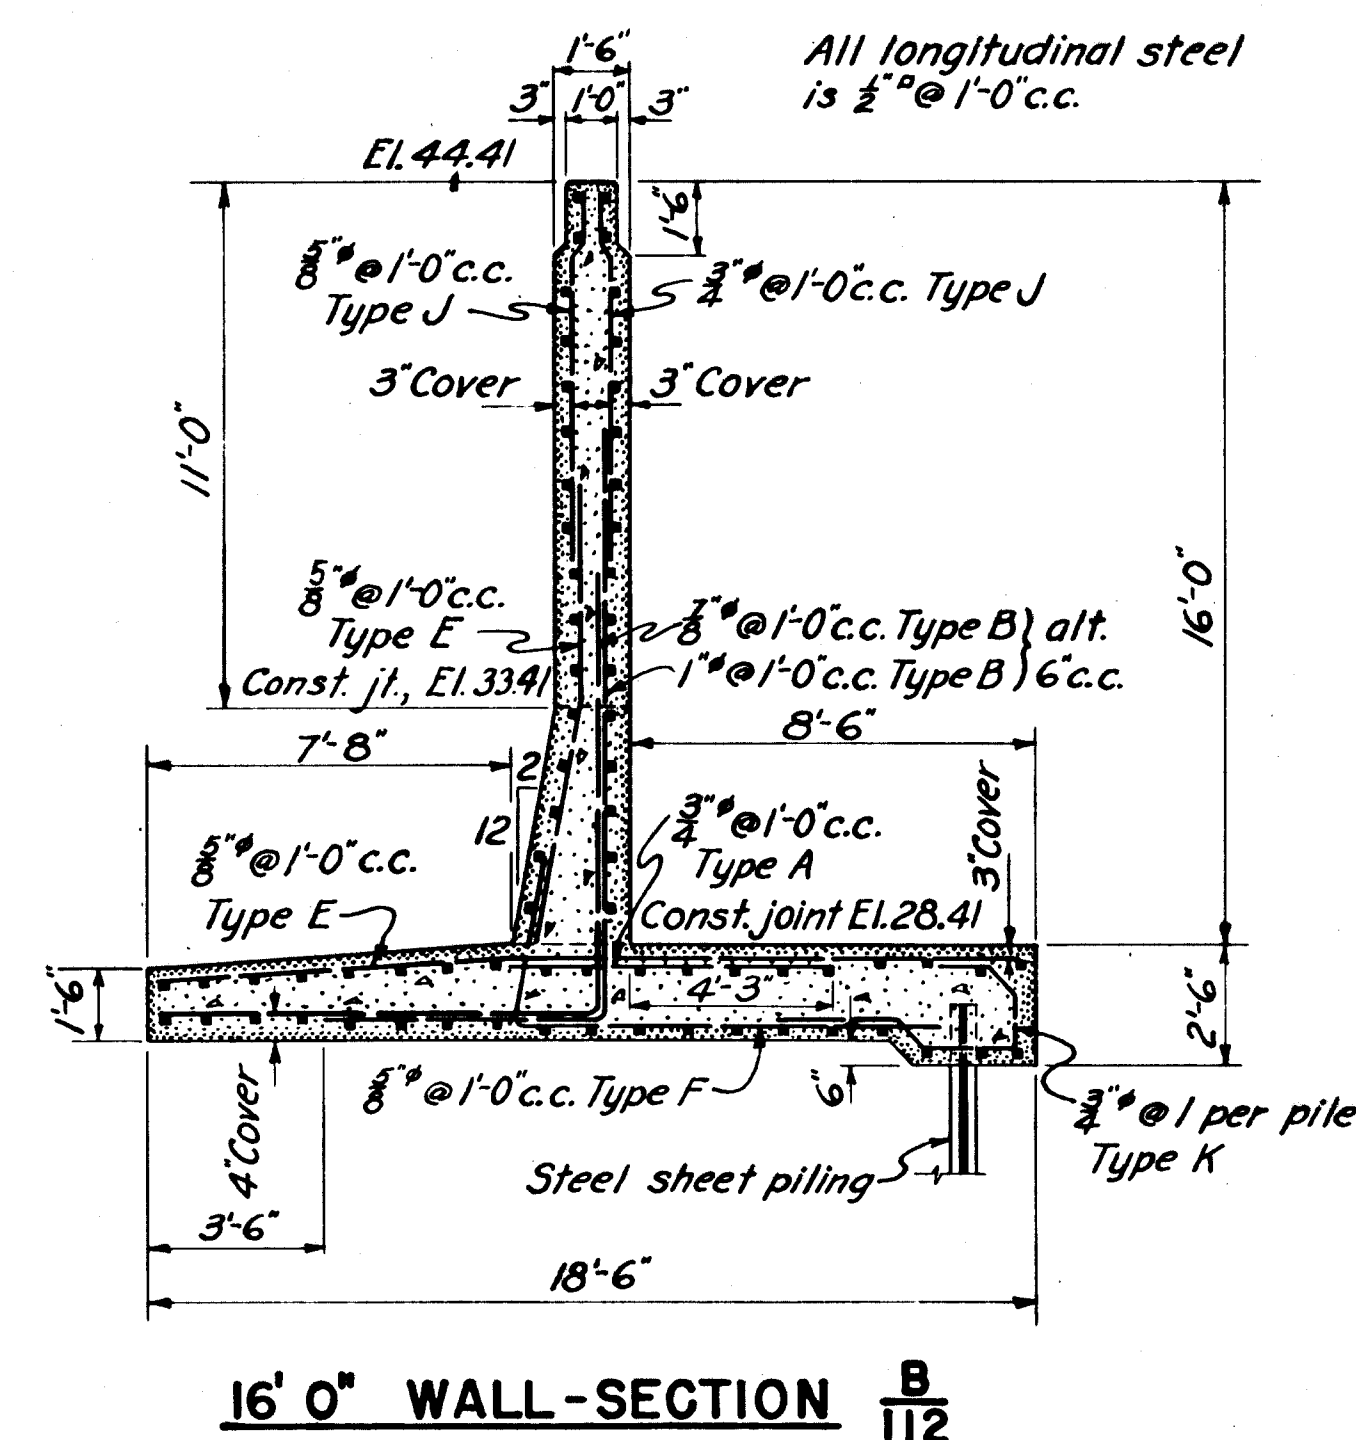
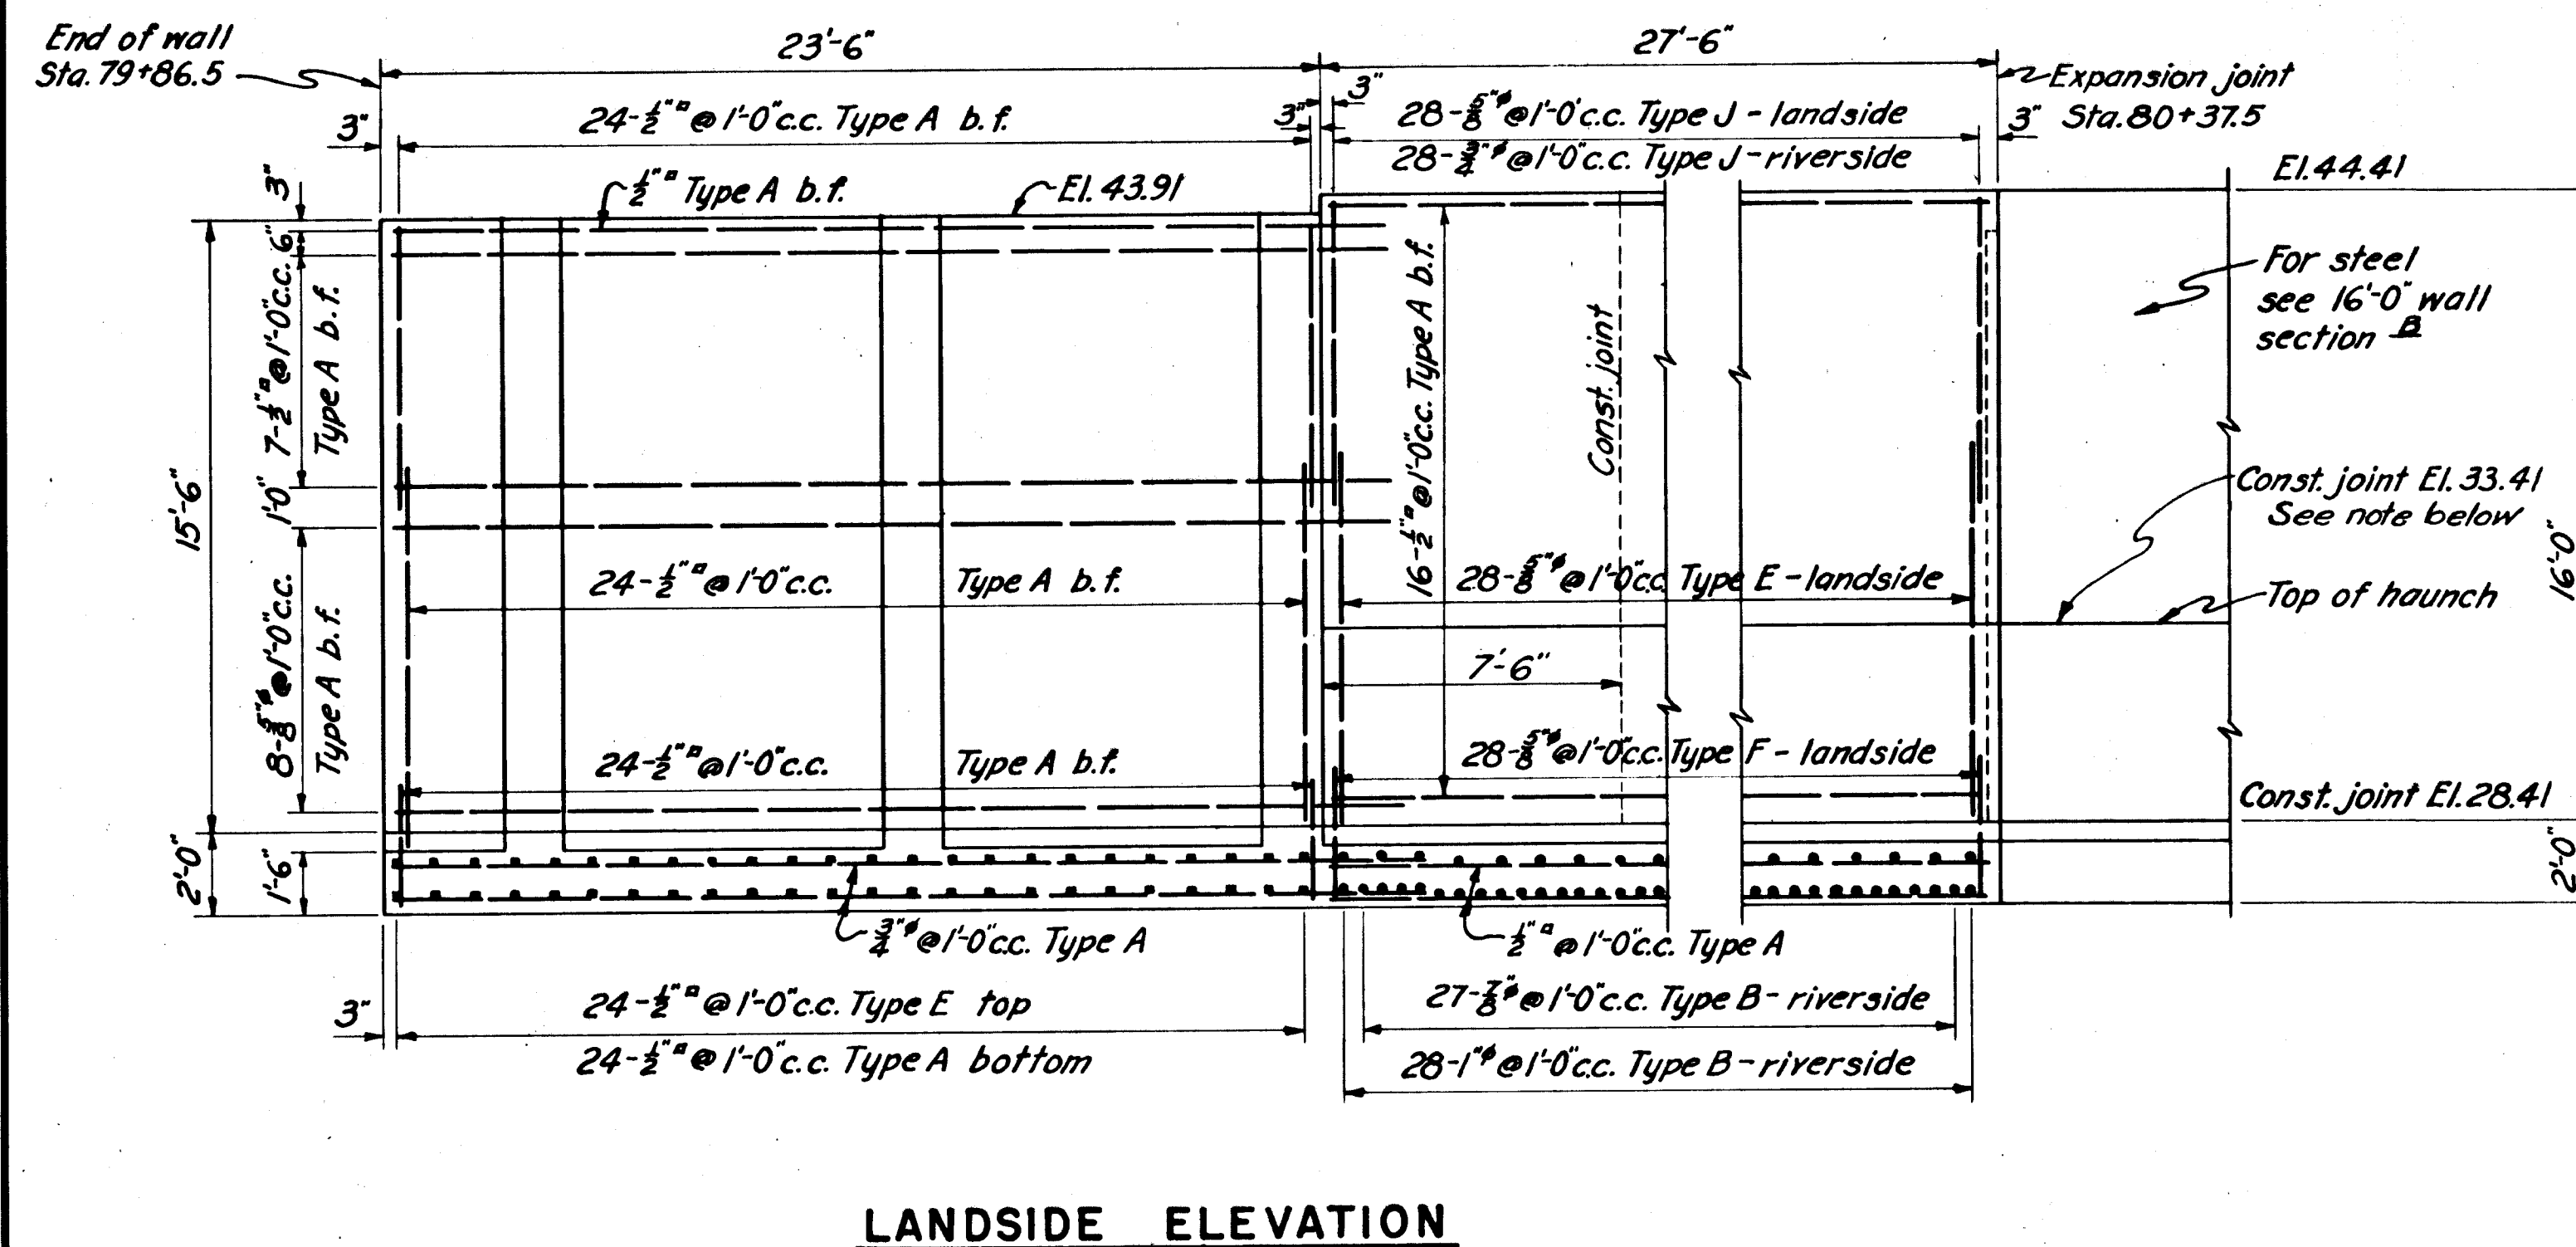
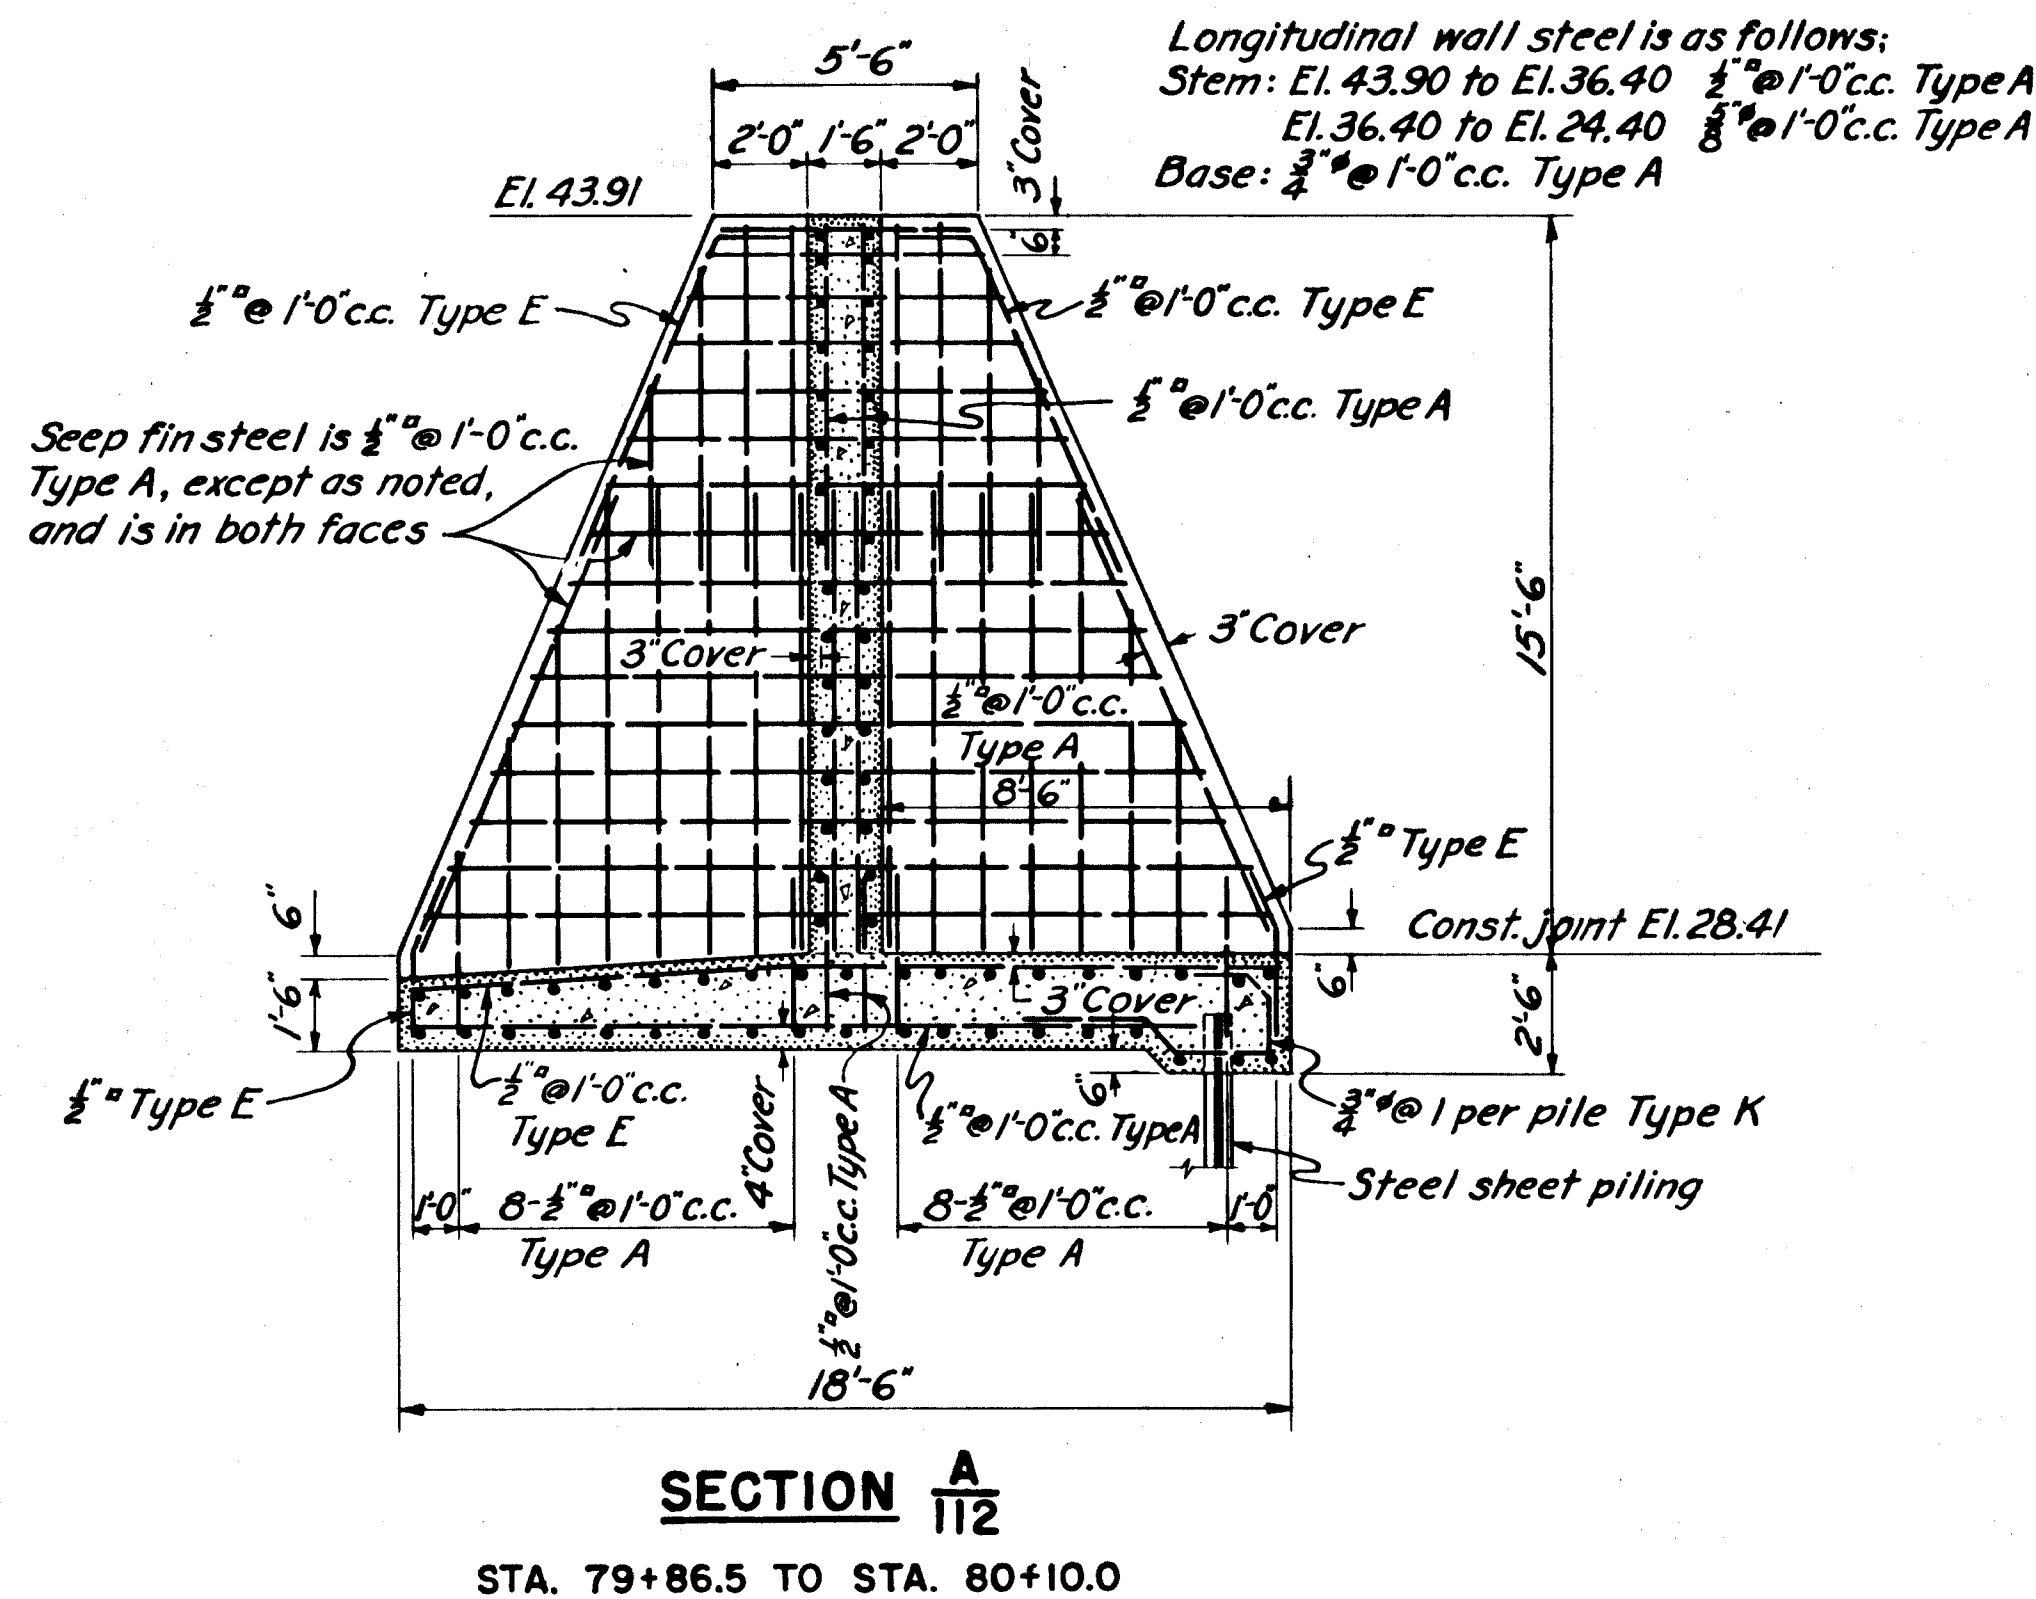


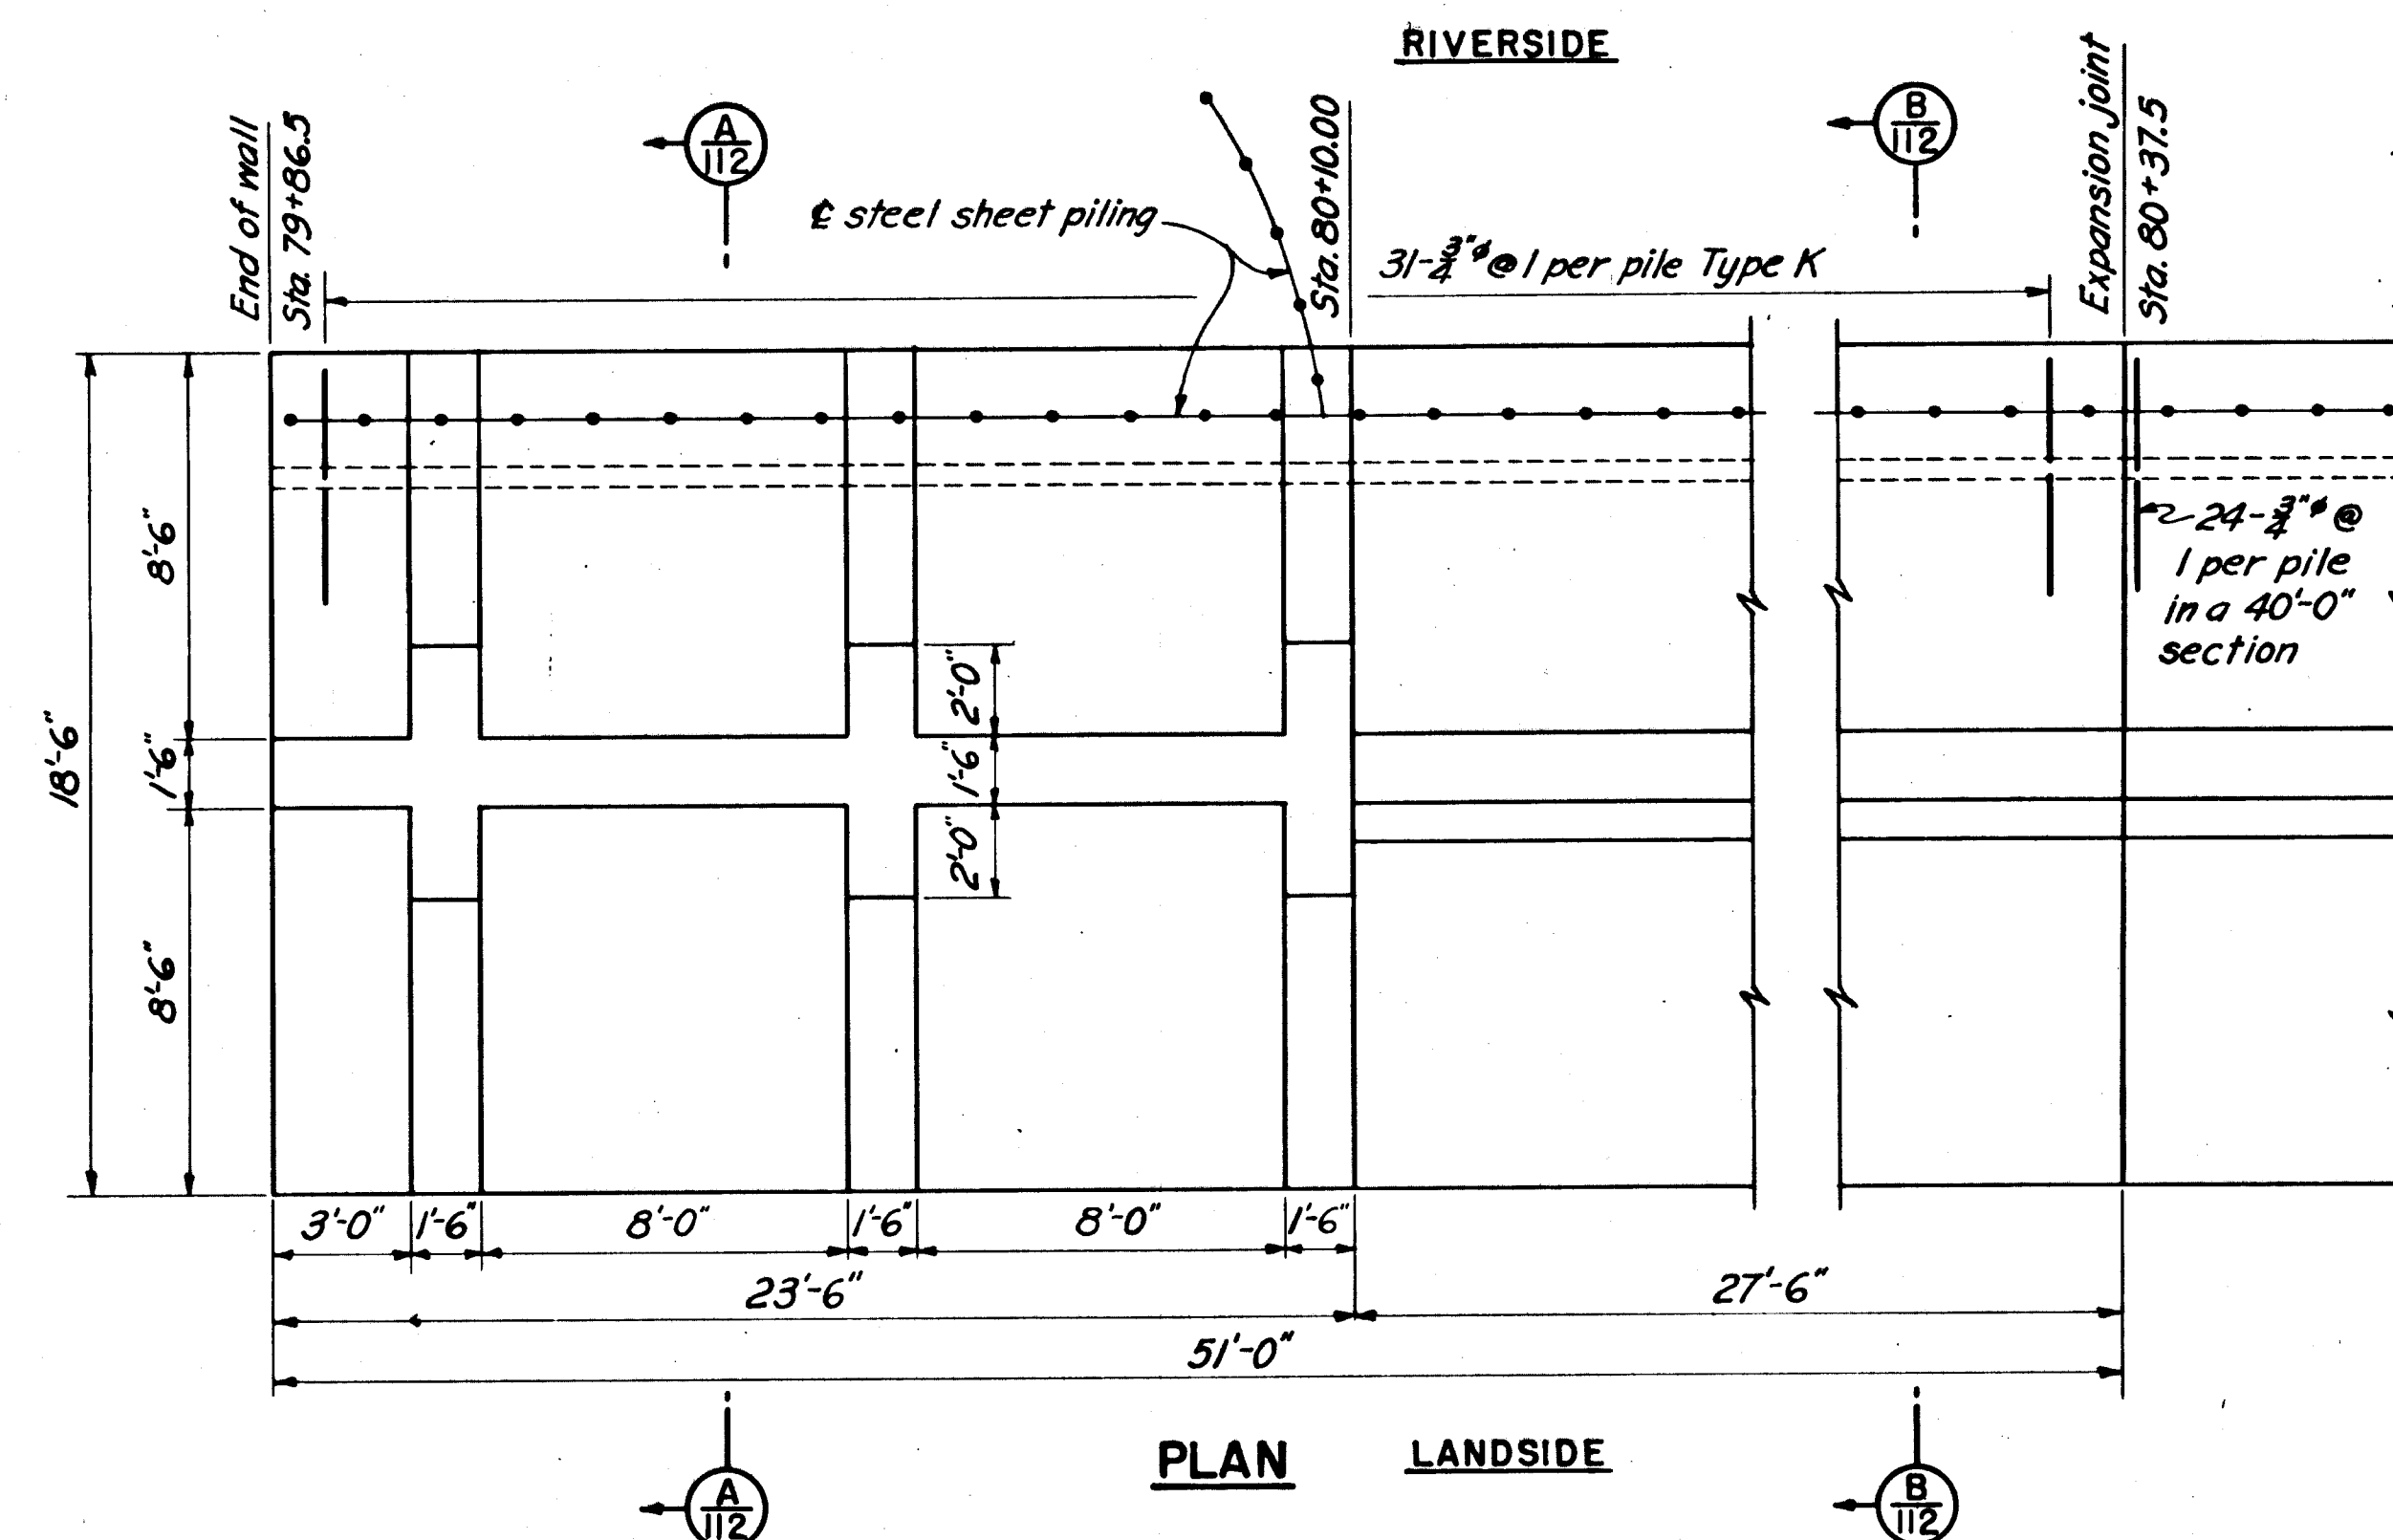

STA. 80+10.0 TO STA. 80+37.5 No joint in stem
 STA. 80+37.5 TO STA. 85+17.5 Jt. in stem at El. 33.41
 (Except at manhole Sta. 84+21; See Sheet No. 63A)

NOTES:

- For concrete details see Sheets No. 59 and 74.
- For bar type schedule see Sheet No. 85.
- The minimum cover for main steel reinforcement is 3" except where concrete is poured against earth in which case it is 4".
- Bar splices are equal in length to forty diameters of the smaller bar.
- Radius of bend of bars is equal to 4 diameters of the bar.
- Payment for furnishing, bending and placing of steel reinforcement was made under Item No. 25.

12-31-45	As built revisions				
3/10/41	Note added				
KEY	DATE	REVISION (Indicated by Δ)	REV. BY	CK. BY	AP. BY

CONNECTICUT RIVER FLOOD CONTROL	
HARTFORD DIKE	
RIVERFRONT, MORGAN ST. TO STA. 96+73	
WALL DETAILS-STA. 79+86.5 TO STA. 85+17.5	
STEEL REINFORCEMENT	
CONNECTICUT RIVER	CONNECTICUT
IN 135 SHEETS	SHEET NO. 112
SCALE: 1/4" = 1' FT.	
U.S. ENGINEER OFFICE, PROVIDENCE, R.I., MAY 1940	
SUBMITTED:	APPROVAL RECOMMENDED:
DESIGNED:	APPROVED:
HEAD, DESIGN SECTION	CHIEF, P.C. ENGINEERING DIV.
ASSOC. ENGINEER	DISTRICT ENGINEER
DRAWN: E.H.V.	FISCAL YEAR 1940
CHECKED: A.S.	FILE NO. CT-4-2572