



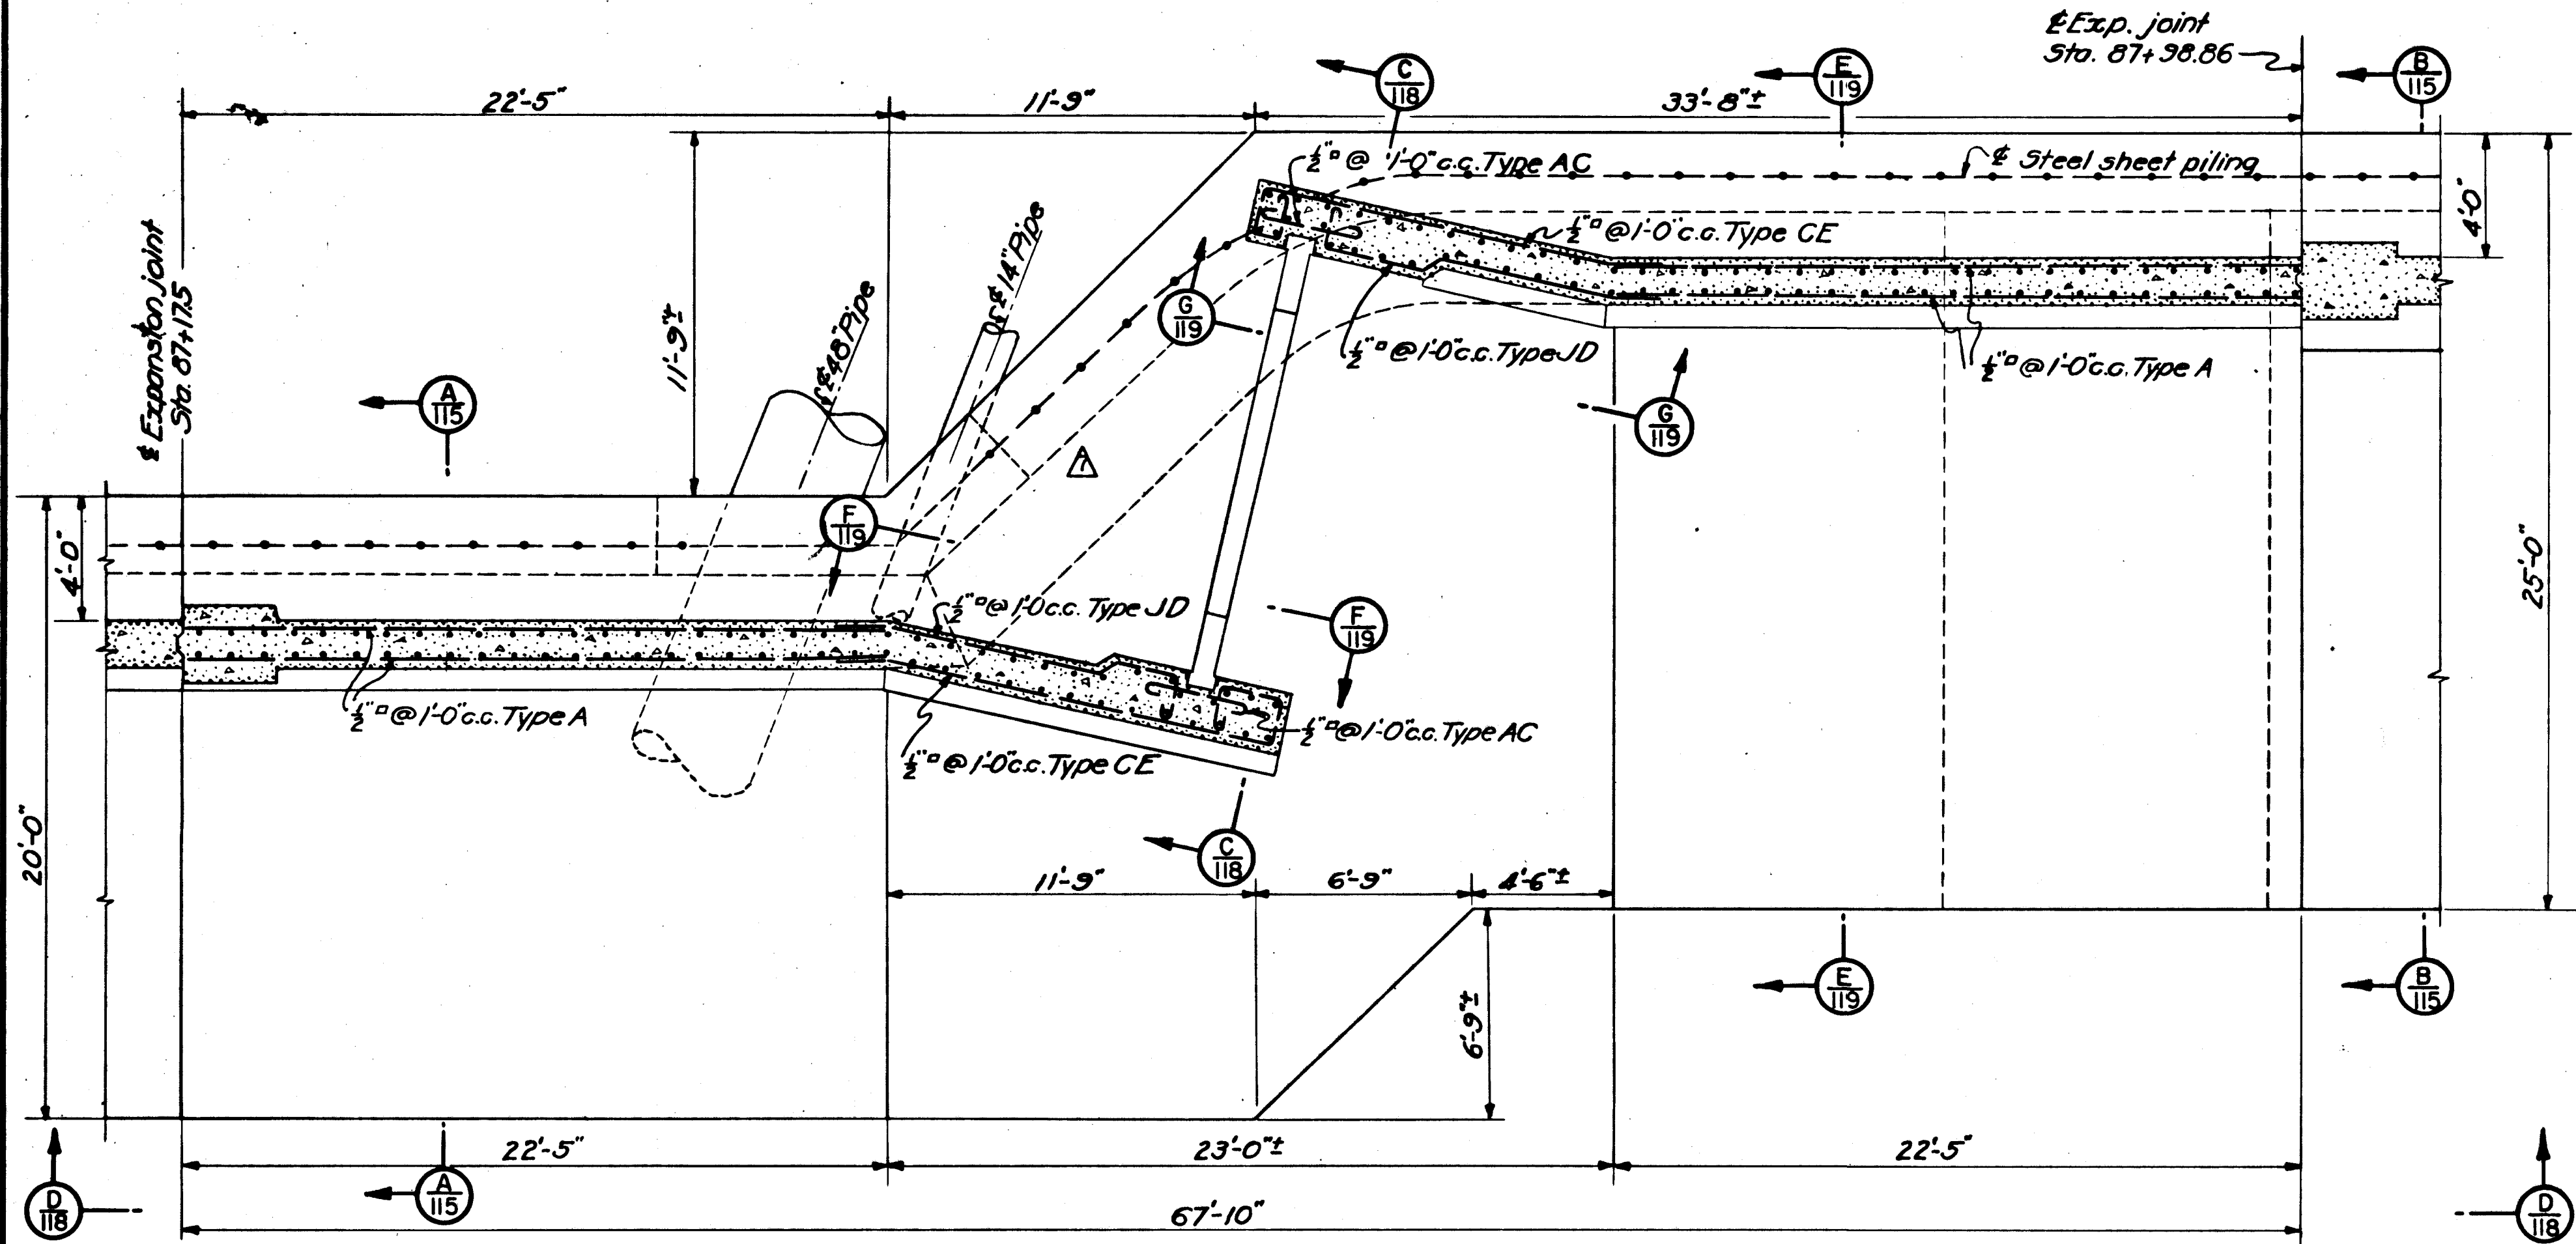


PLAN

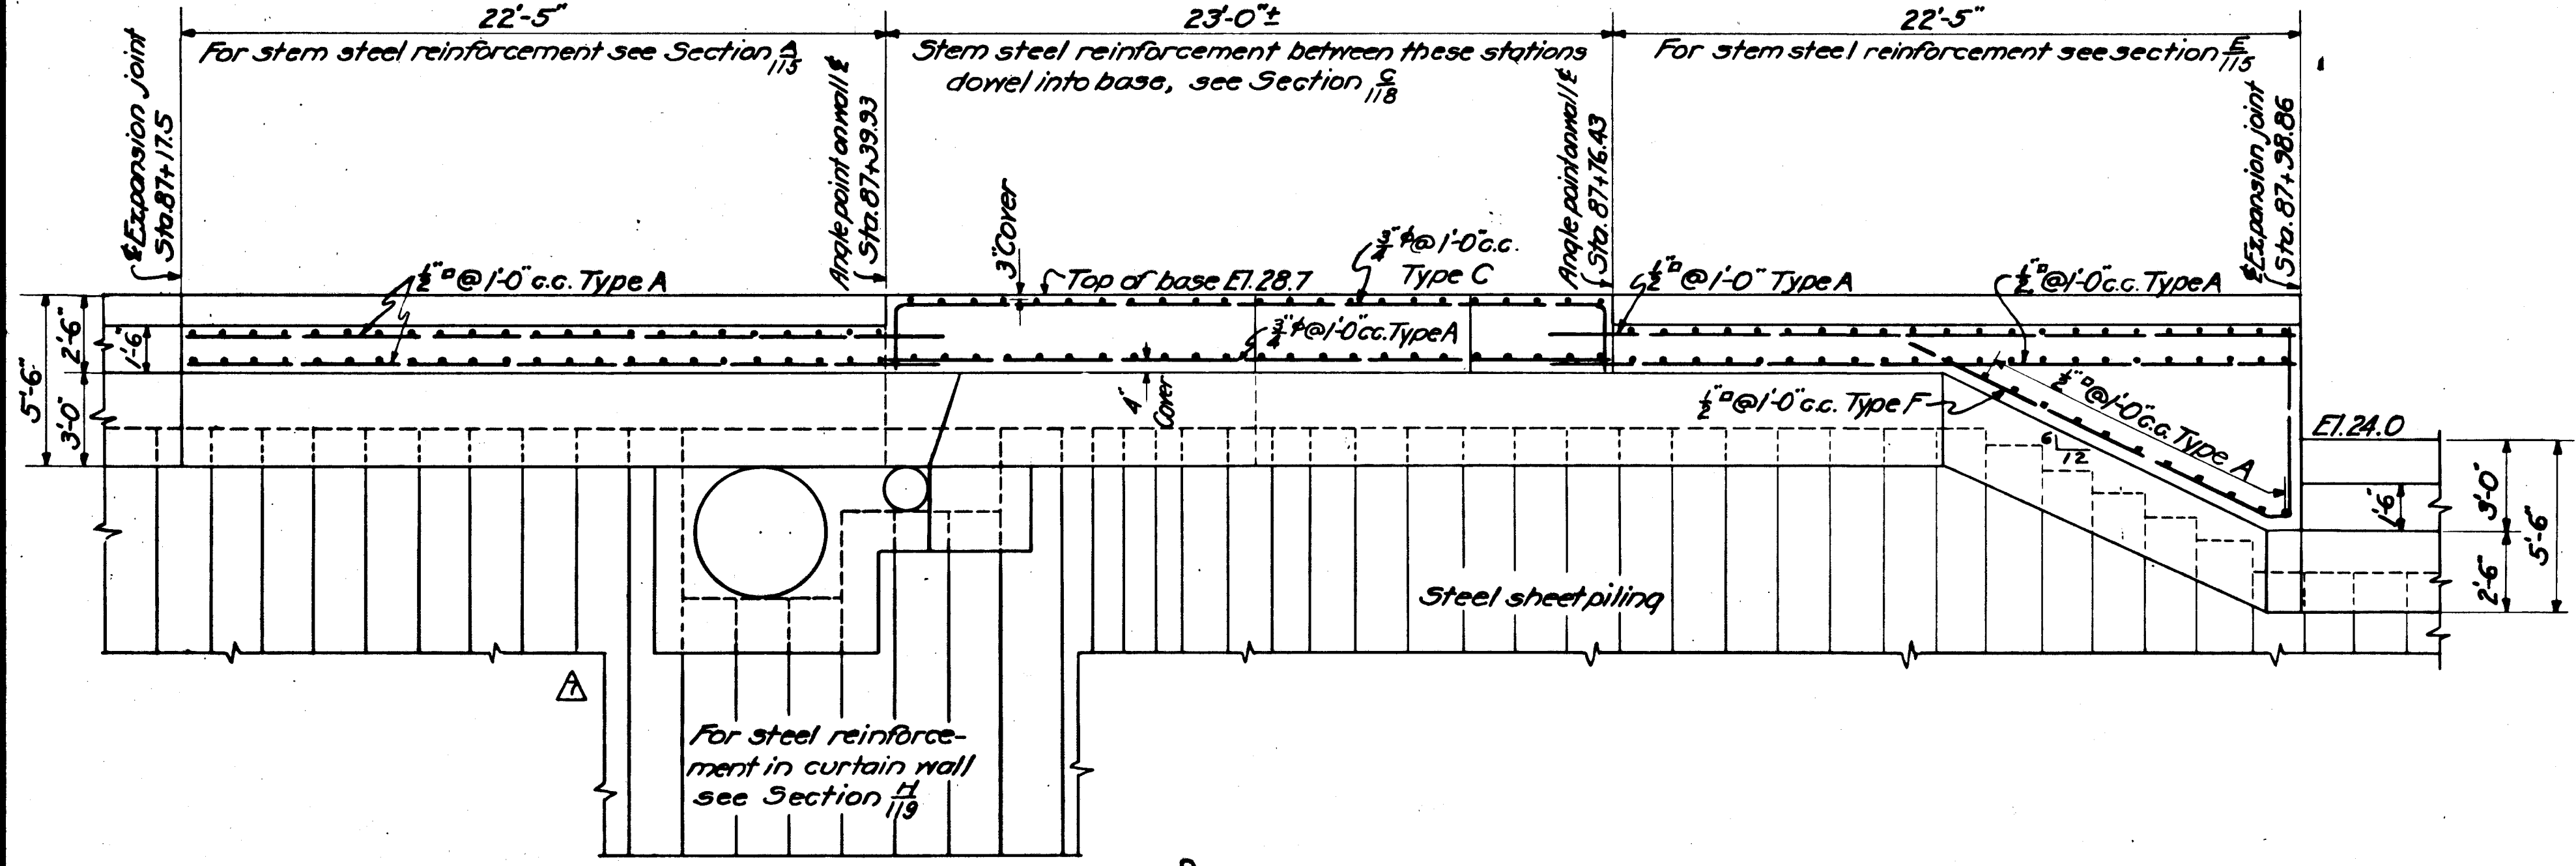

VIEW D 118

ARRANGEMENT OF LONGITUDINAL BASE STEEL

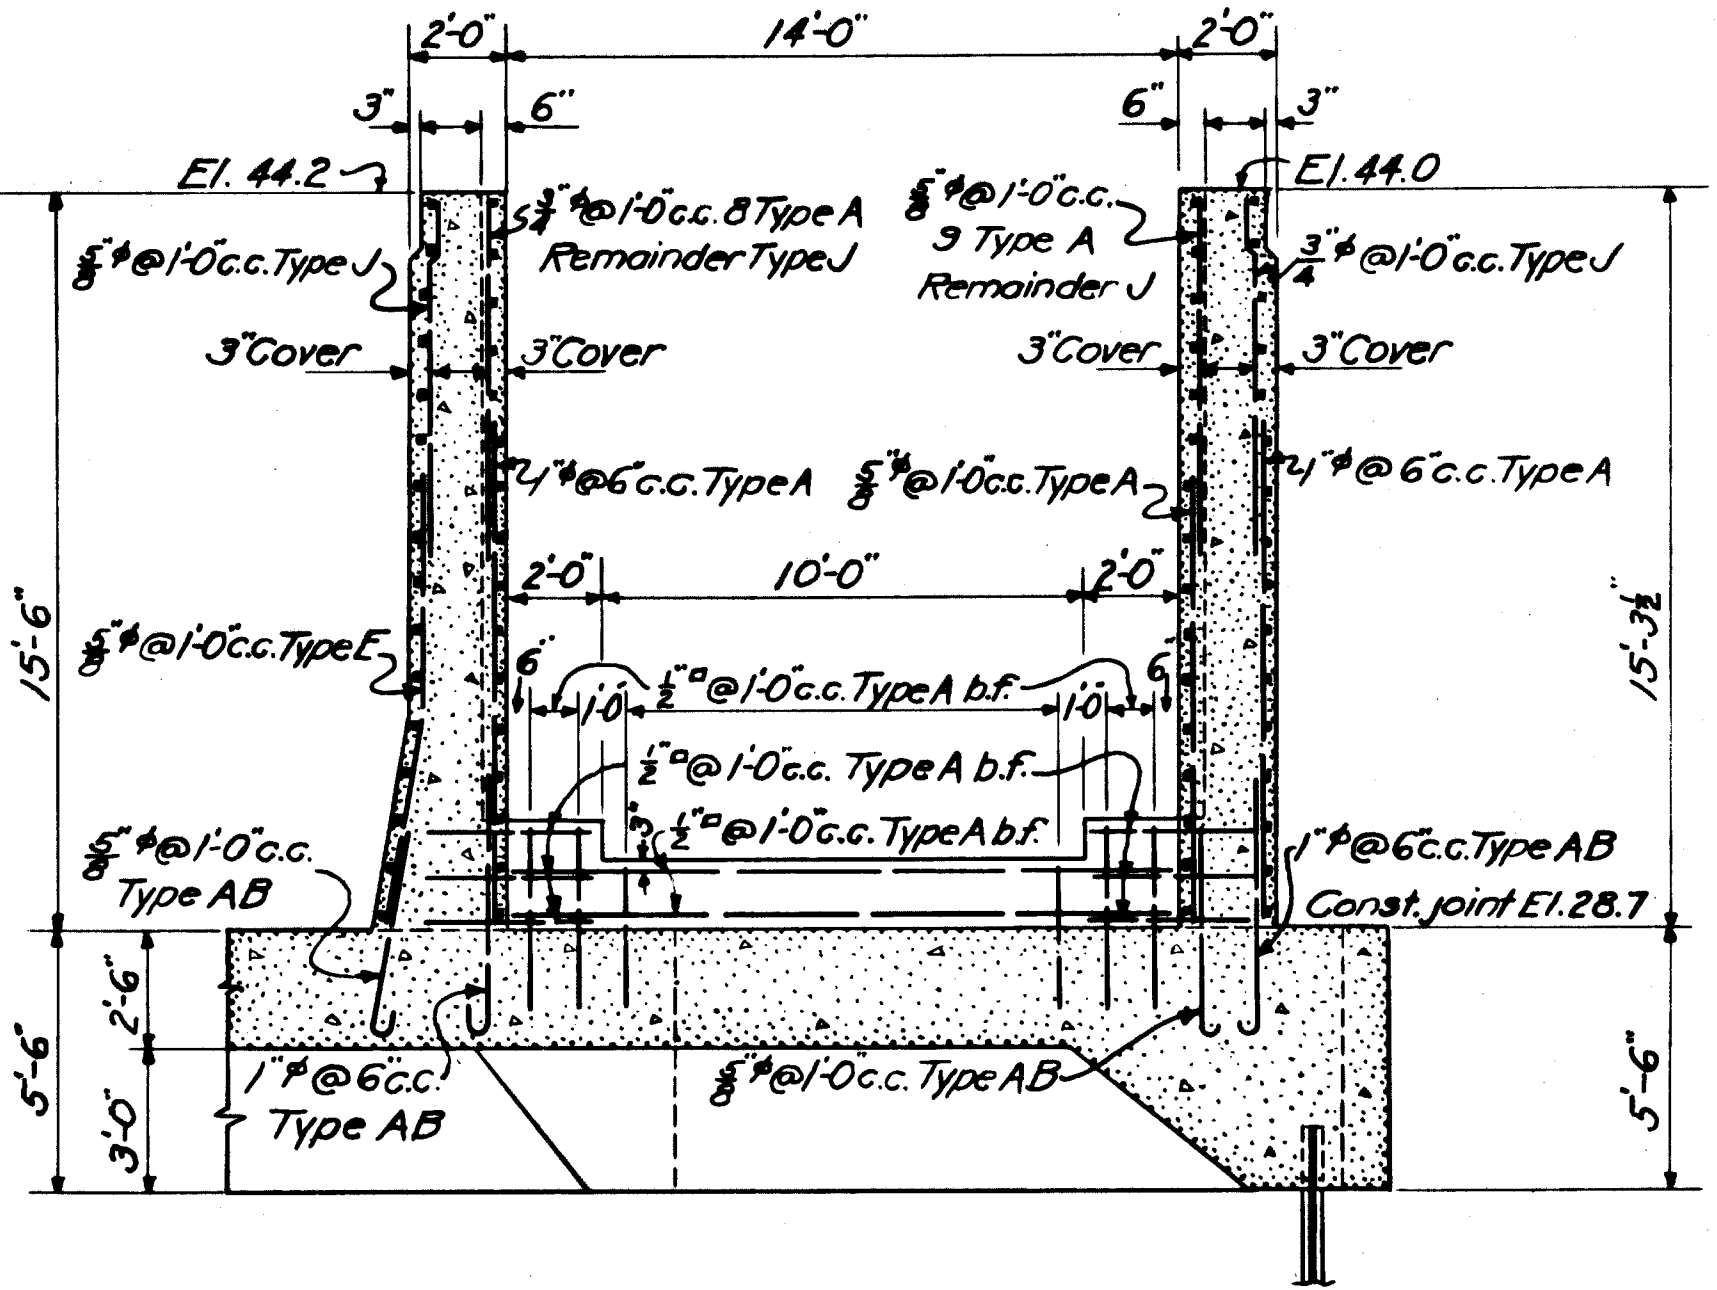

SECTION C 118

NOTES
For concrete details see Sheet No. 65.
For additional reinforcement details see Sheet No. 119.
For general notes see Sheet No. 117.

CONNECTICUT RIVER FLOOD CONTROL			
HARTFORD DIKE			
RIVERFRONT, MORGAN ST. TO STA. 96+73			
STOP-LOG STRUCTURE NO. 2			
STEEL REINFORCEMENT NO. 1			
CONNECTICUT RIVER		CONNECTICUT	
IN 135 SHEETS		SHEET NO. 118	
SCALE 1/4"=1'-0"			
U.S. ENGINEER OFFICE, PROVIDENCE, R.I., MAY 1940			
SUBMITTED:		APPROVAL RECOMMENDED:	
DESIGNED:		DRAWN:	
CHECKED:		TRACED:	
KEY		DATE	
12-31-45		As built revisions	
3-10-41		Change curtain wall	
REVISION (Indicated by Δ)		REV. BY CK. BY AP. BY	