


For monolith at angle point in wall
see Sheet No. 122.

For concrete details see Sheet No. 75.
For additional reinforcement details see Sheets No. 122, 123 & 125
For bar type schedule see Sheet No. 85.
The minimum cover for main steel reinforcement
is 3" except where concrete is poured against earth in
which case it is 4".
Bar splices are equal in length to 40 diameters
of the smaller bar.
Radius of bend of bars is equal to 4 diameters
of the bar.
Payment for furnishing, bending, and placing of steel
reinforcement was made under Item No. 25.

	12-31-45	As built revisions			
KEY	DATE	REVISION (Indicated by Δ)	REV. BY	CK. BY	AP. BY

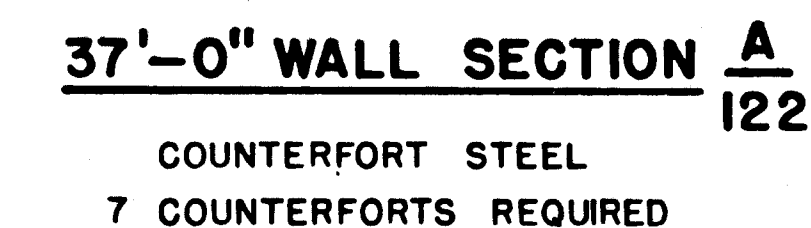

CONNECTICUT RIVER FLOOD CONTROL		
HARTFORD DIKE		
RIVERFRONT, MORGAN ST. TO STA. 96+73		
WALL DETAILS-STA. 89+17.67 TO STA. 90+91		
STEEL REINFORCEMENT NO. 2		
CONNECTICUT RIVER		CONNECTICUT
IN 135 SHEETS	SCALE: 1/4 IN. = 1 FT.	SHEET NO. 121
		
U.S. ENGINEER OFFICE, FORT MONMOUTH, R.I., MAY 1940		
SUBMITTED: <i>Wm B. Fisher</i> SENIOR ENGINEER HEAD, DESIGN SECTION	APPROVAL, RECOMMENDED: <i>W. B. Fisher</i> PRINCIPAL ENGINEER CHIEF, F.C. ENGINEERING DIV.	APPROVED: <i>W. B. Fisher</i> LT COL., CORPS OF ENGINEERS DISTRICT ENGINEER
DESIGNED: <i>W. B. Fisher</i>	DRAWN: E. H. V. TRACED: F. J. B.	FISCAL YEAR 1940 FILE NO. CT-4-2581