



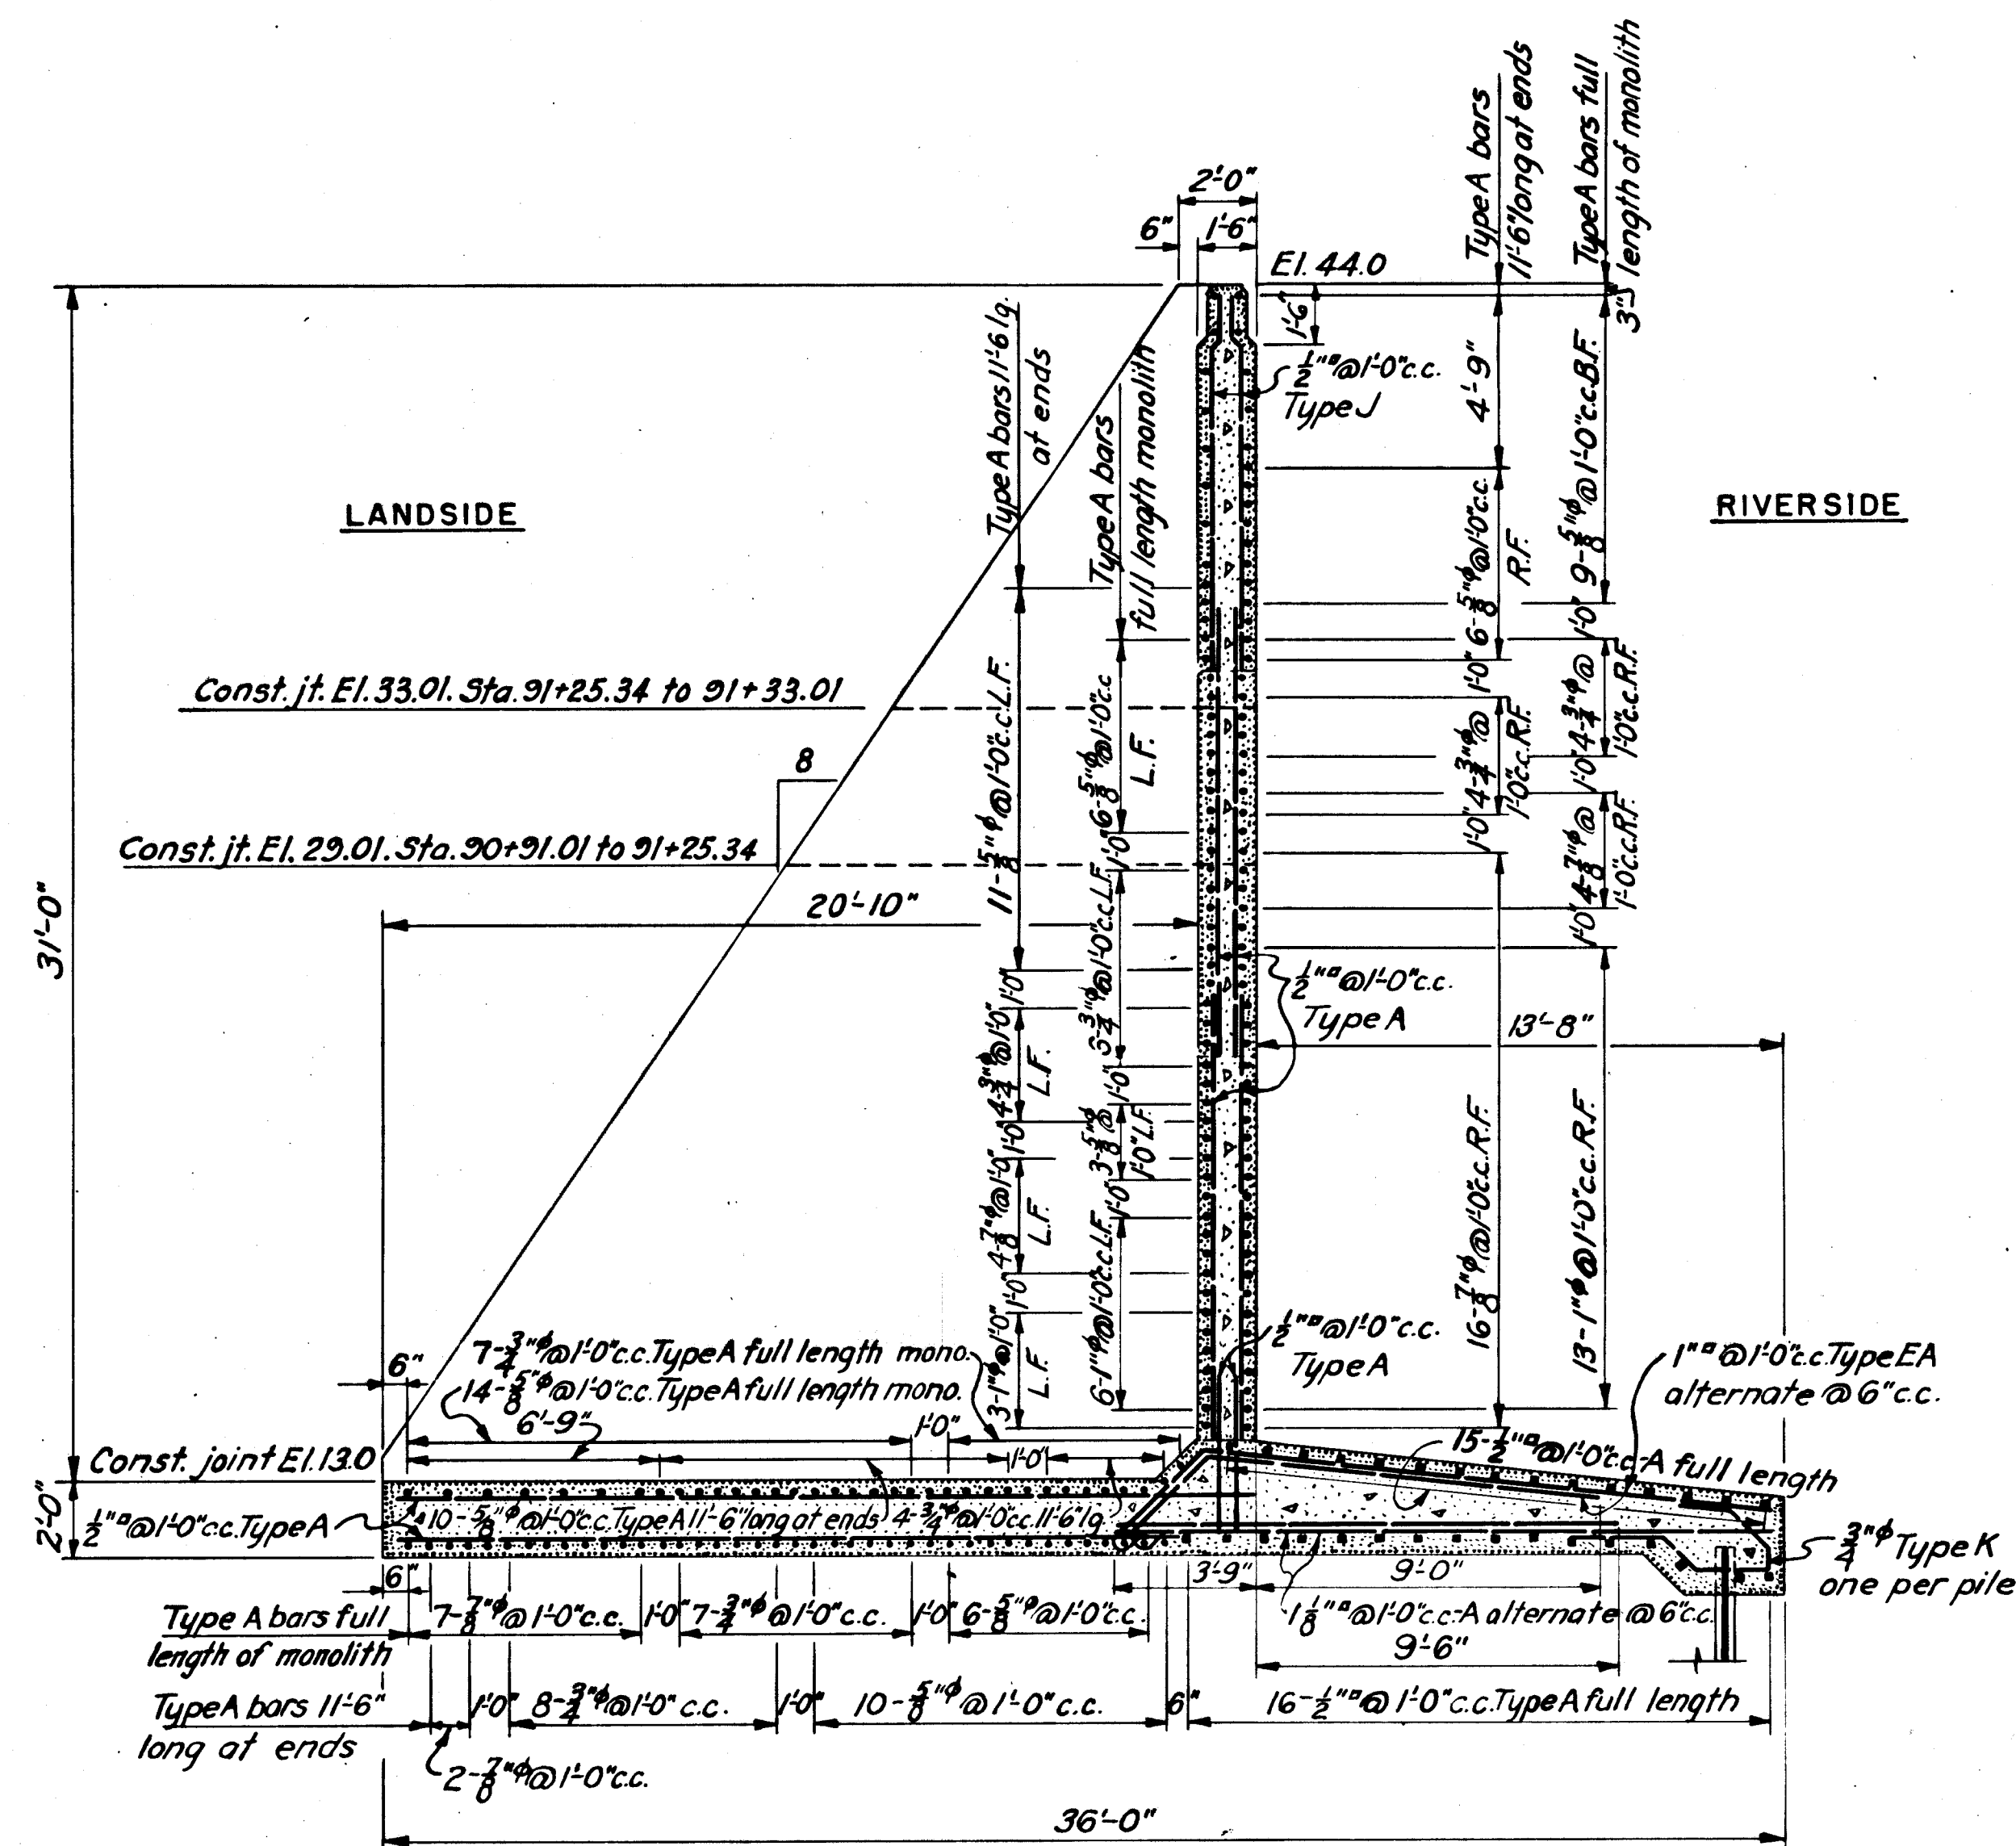


31'-0" WALL SECTION
STEM AND BASE STEEL
STA. 90+91.01 TO STA. 91+33.01

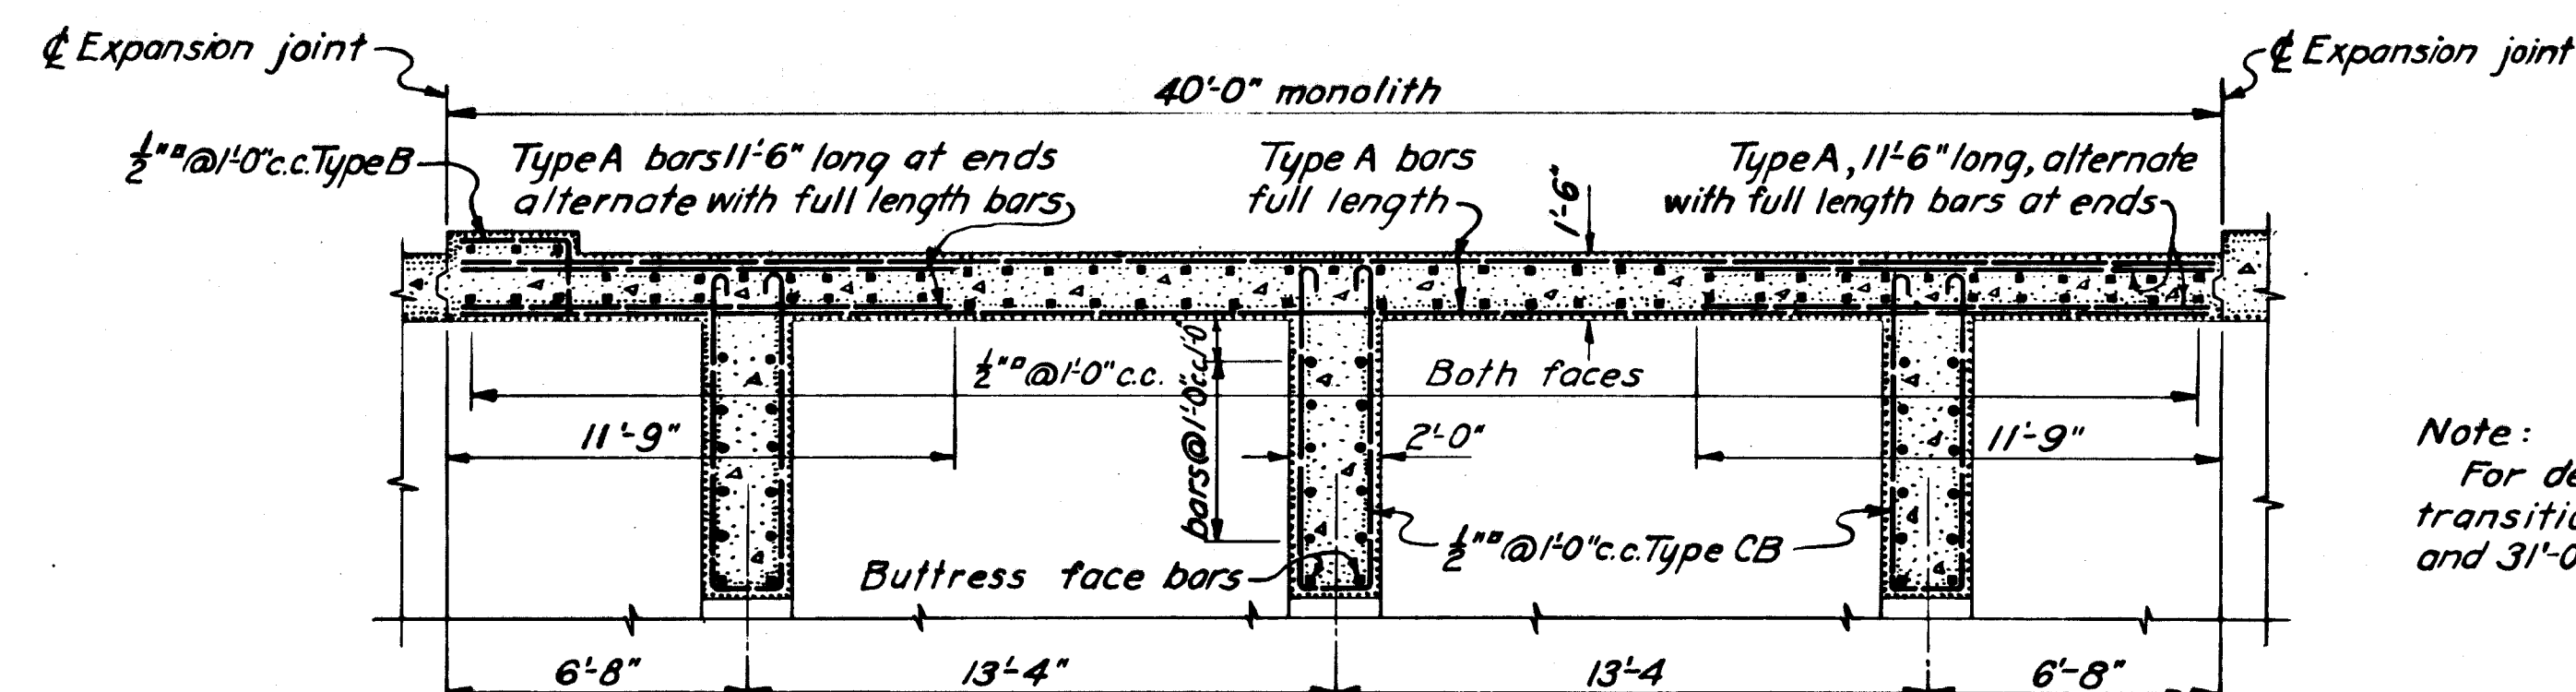

TYPICAL SECTION OF BUTTRESSED WALL
STEEL IN STEM AND BUTTRESS

Note:
For detail of steel in base transition between 34'-0" wall and 31'-0" wall see Sheet No. 125

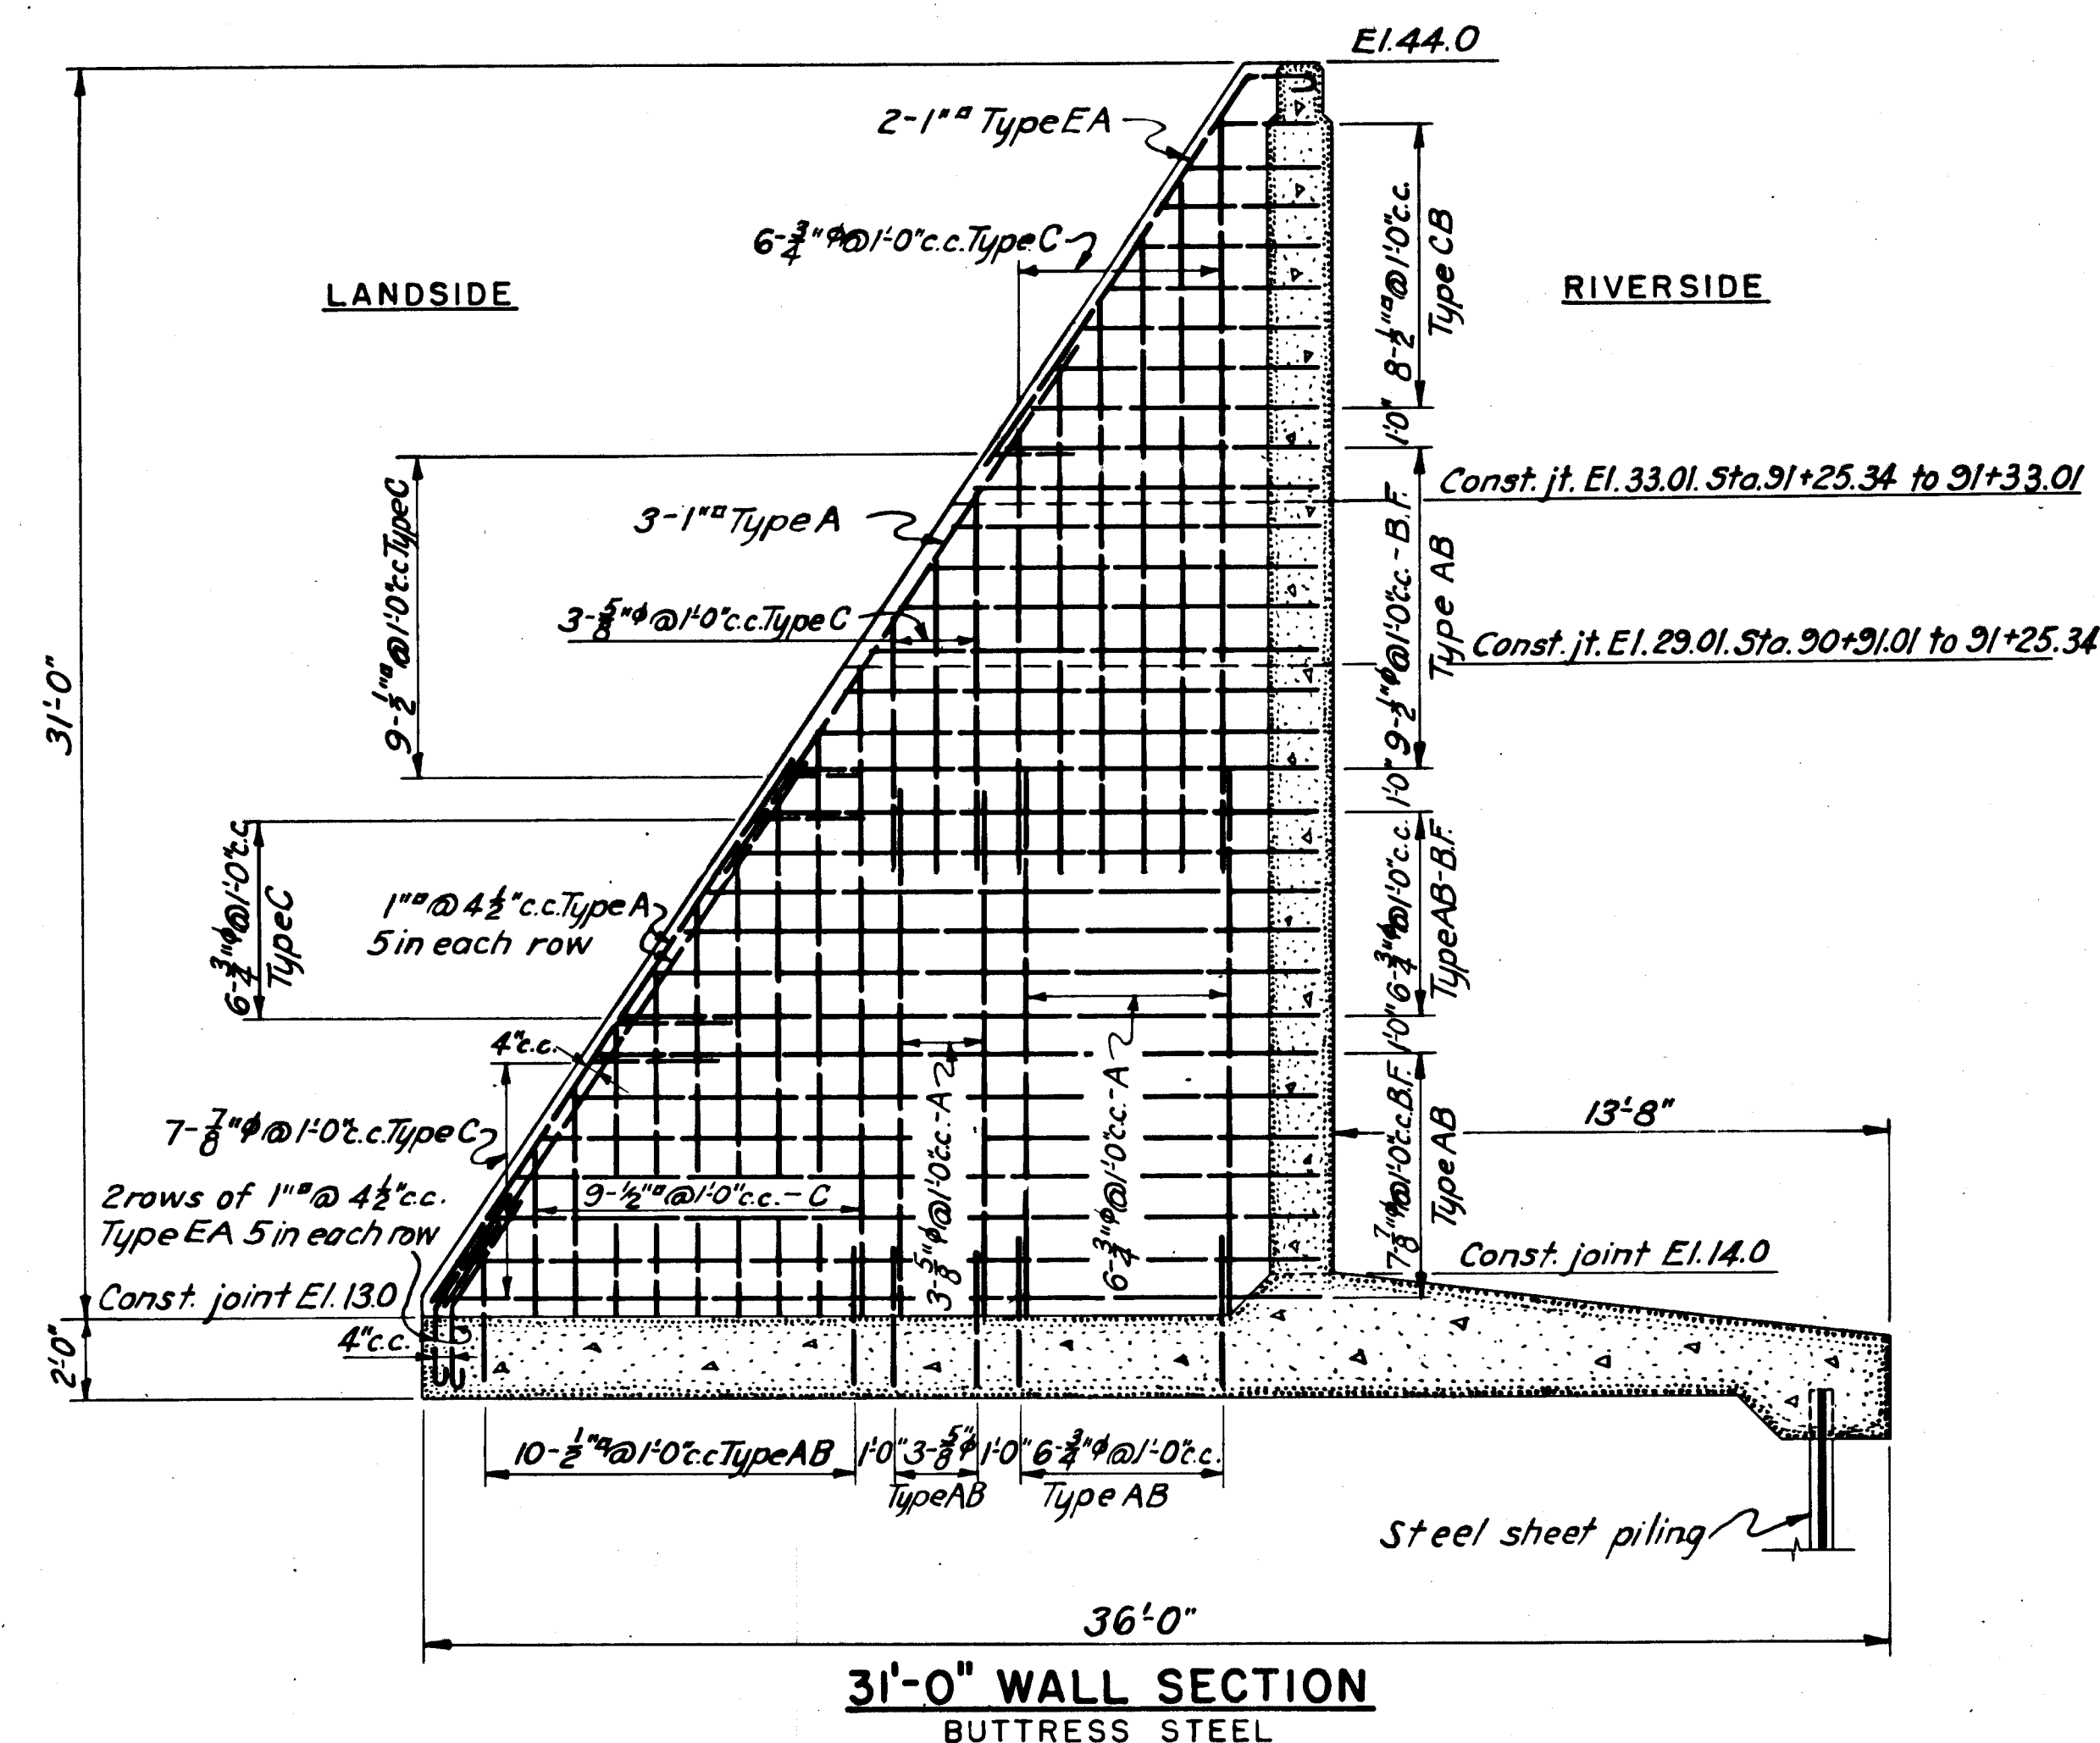

NOTES

For concrete details see Sheet No. 75.
For general notes see Sheet No. 121.

CONNECTICUT RIVER FLOOD CONTROL			
HARTFORD DIKE			
RIVERFRONT, MORGAN ST. TO STA. 96+73			
WALL DETAILS-STA. 90+91 TO STA. 91+33.01			
STEEL REINFORCEMENT			
CONNECTICUT RIVER	SCALE: 1/4" = 1 FT.		CONNECTICUT
IN 135 SHEETS			SHEET NO. 123
U.S. ENGINEER OFFICE, PROVIDENCE, R.I., MAY 1940			
SUBMITTED:	APPROVAL:	RECOMMENDED:	APPROVED:
W. B. Burns	W. B. Burns	W. B. Burns	W. B. Burns
SENIOR ENGINEER	PRINCIPAL ENGINEER	CHIEF, F.C. ENGINEERING DIV.	LTCOL, CORPS OF ENGINEERS
HEAD, DESIGN SECTION	DESIGNED:	TRACED:	FISCAL YEAR 1940
DESIGNED:	TRACED:	CHECKED:	FILE NO. CT-4-2583

KEY	DATE	REVISION (Indicated by Δ)	REV. BY	CK. BY	AP. BY
	12-31-45	As built revisions			