

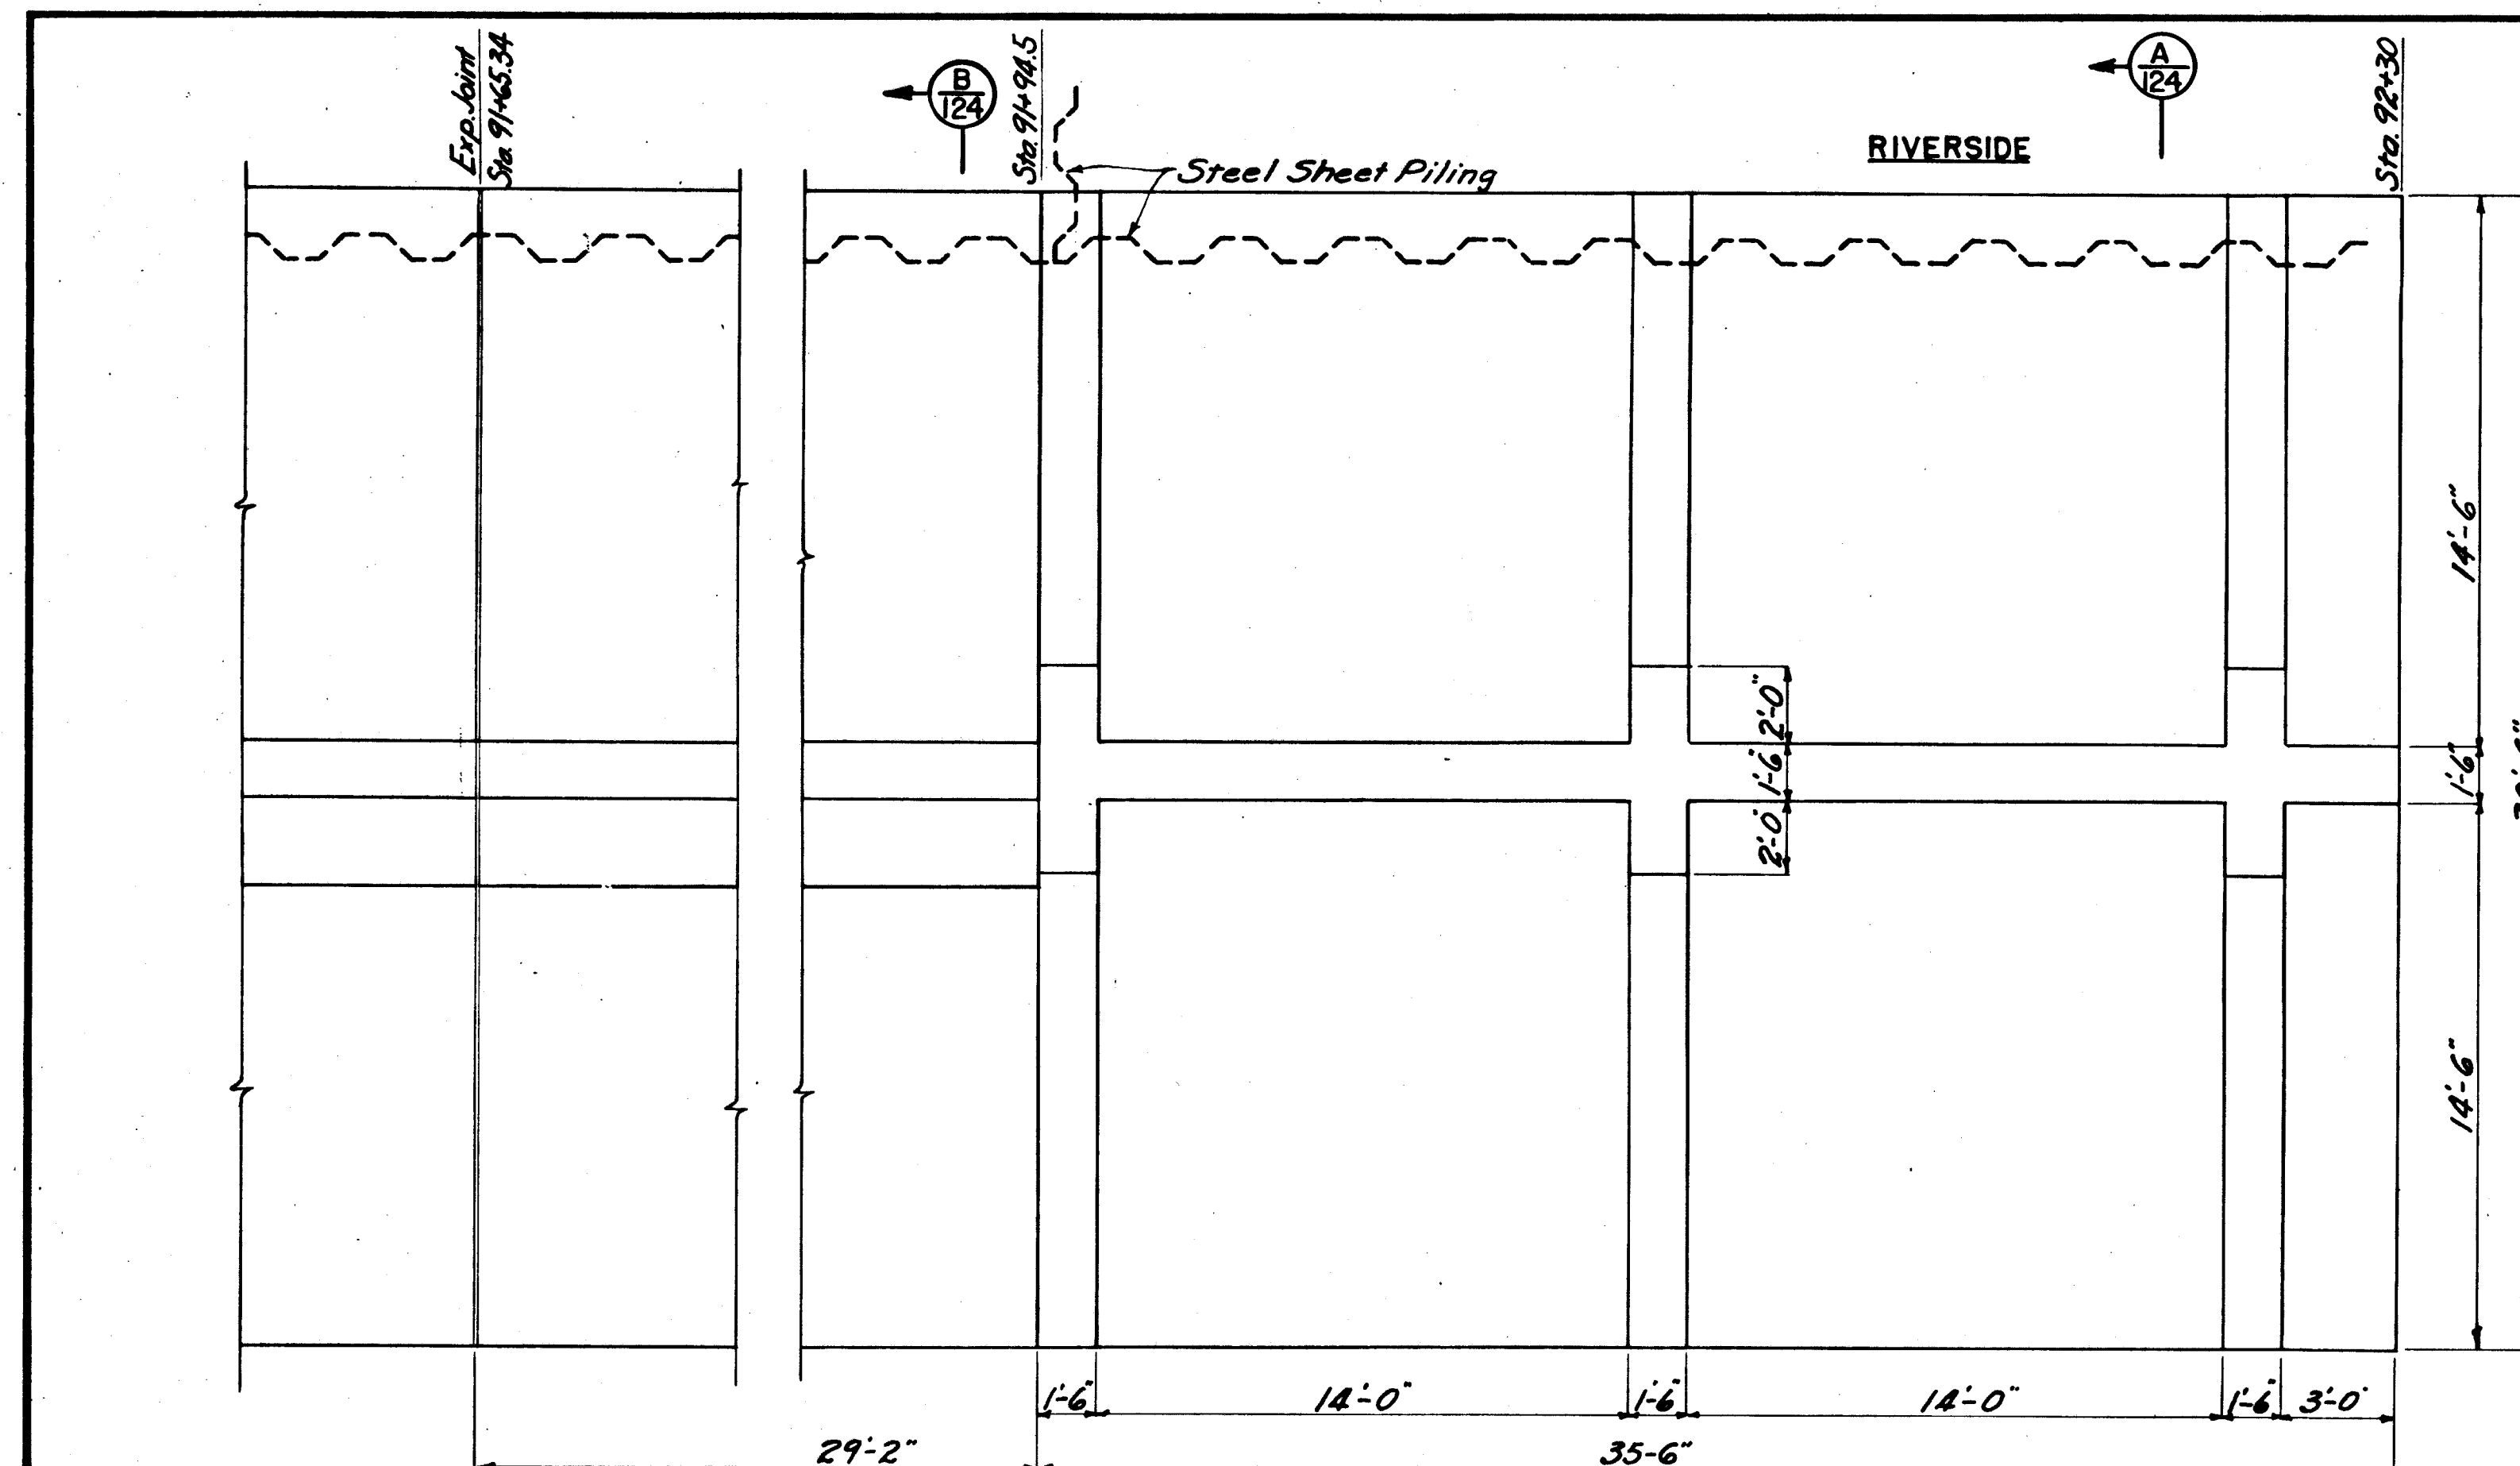
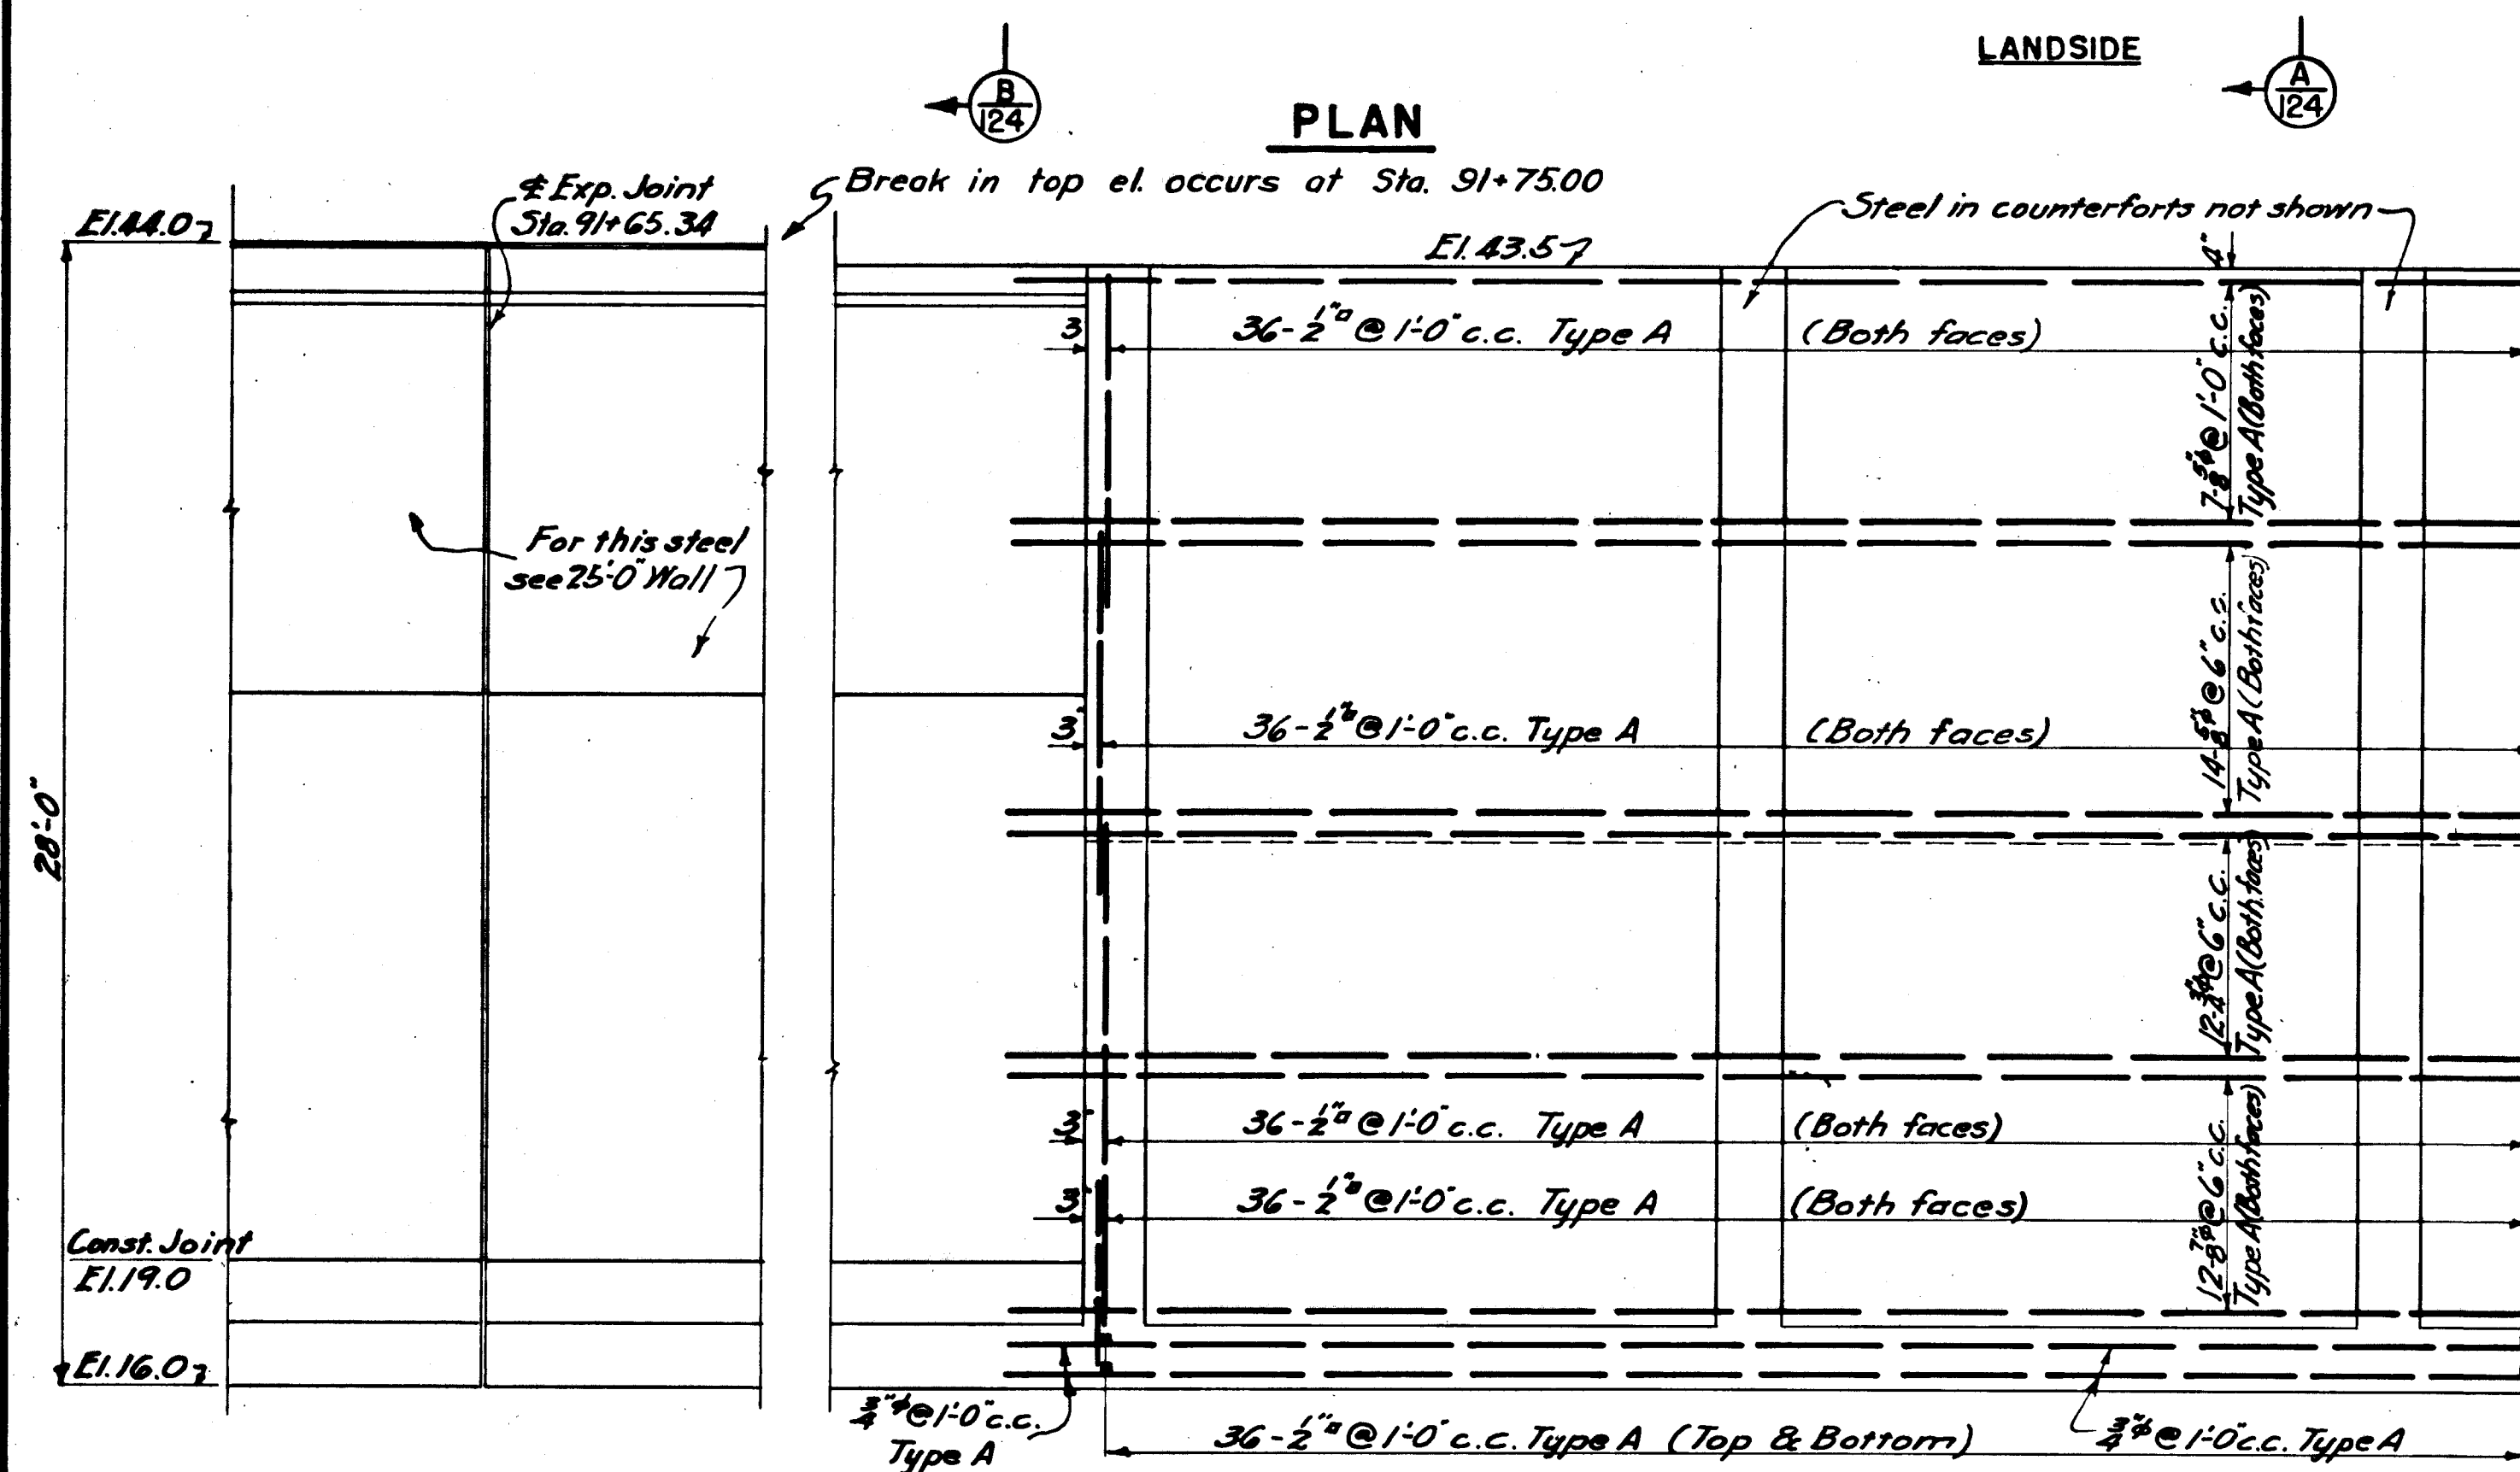


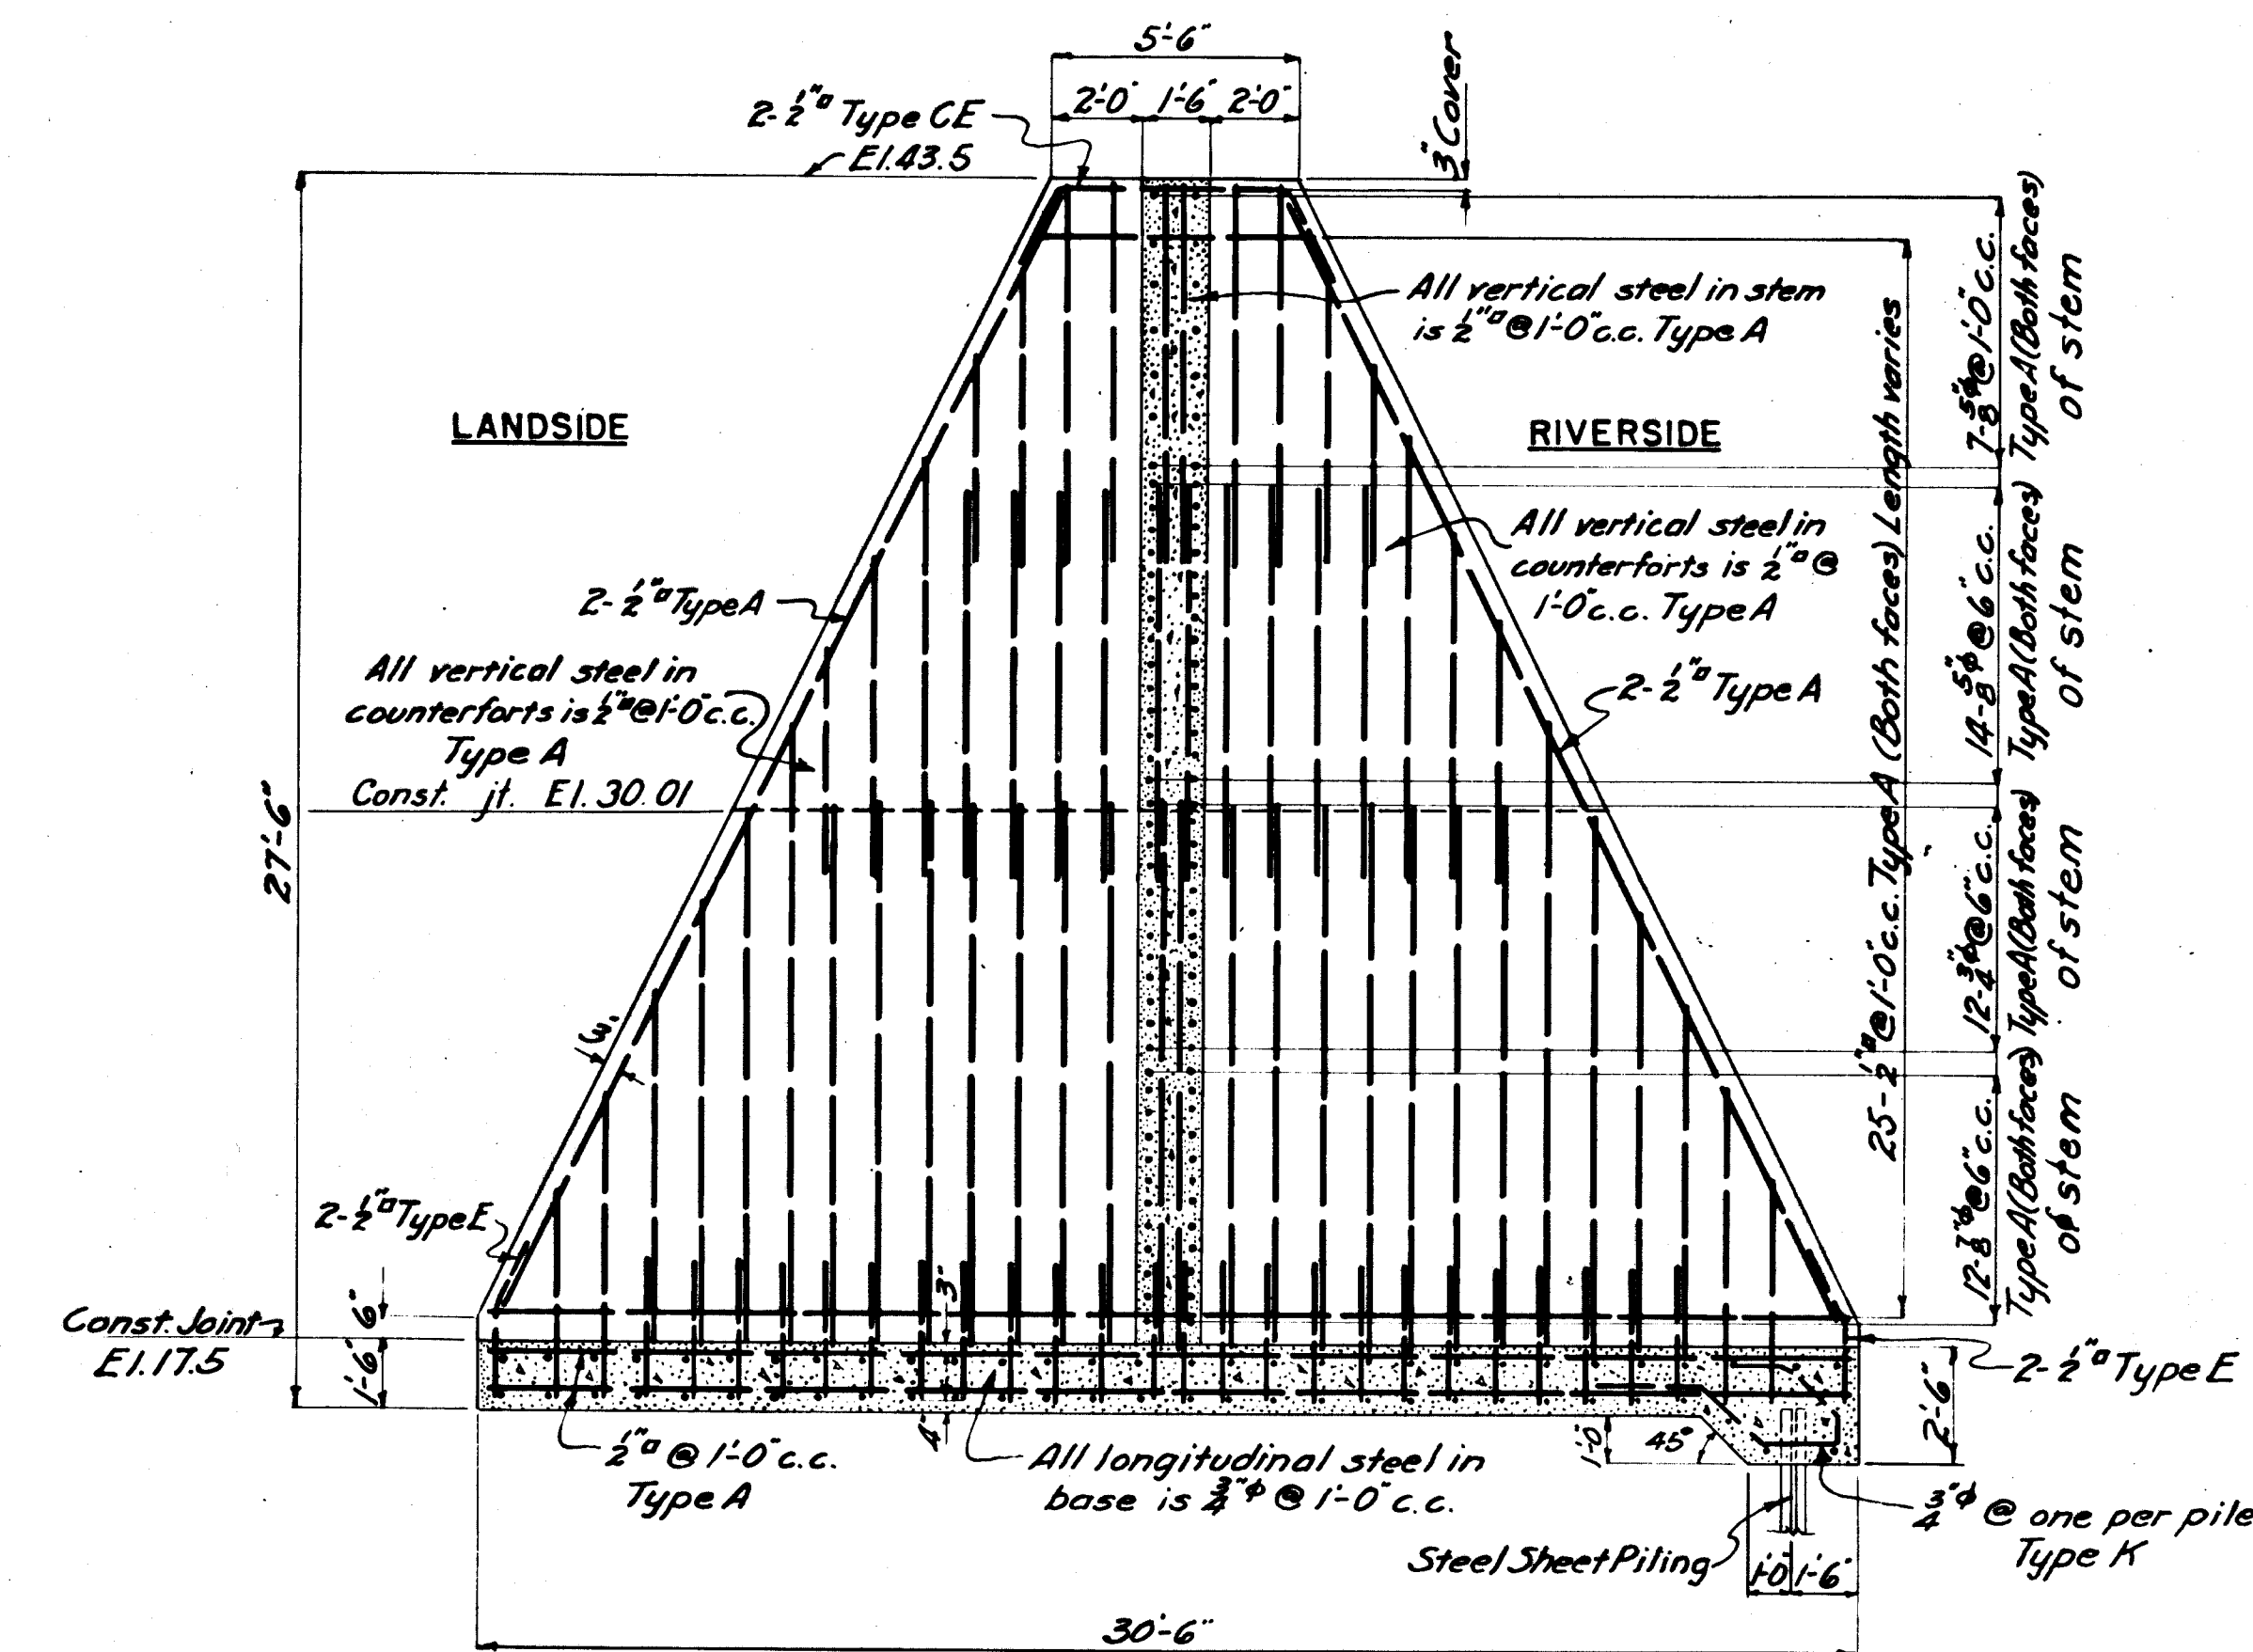

PLAN

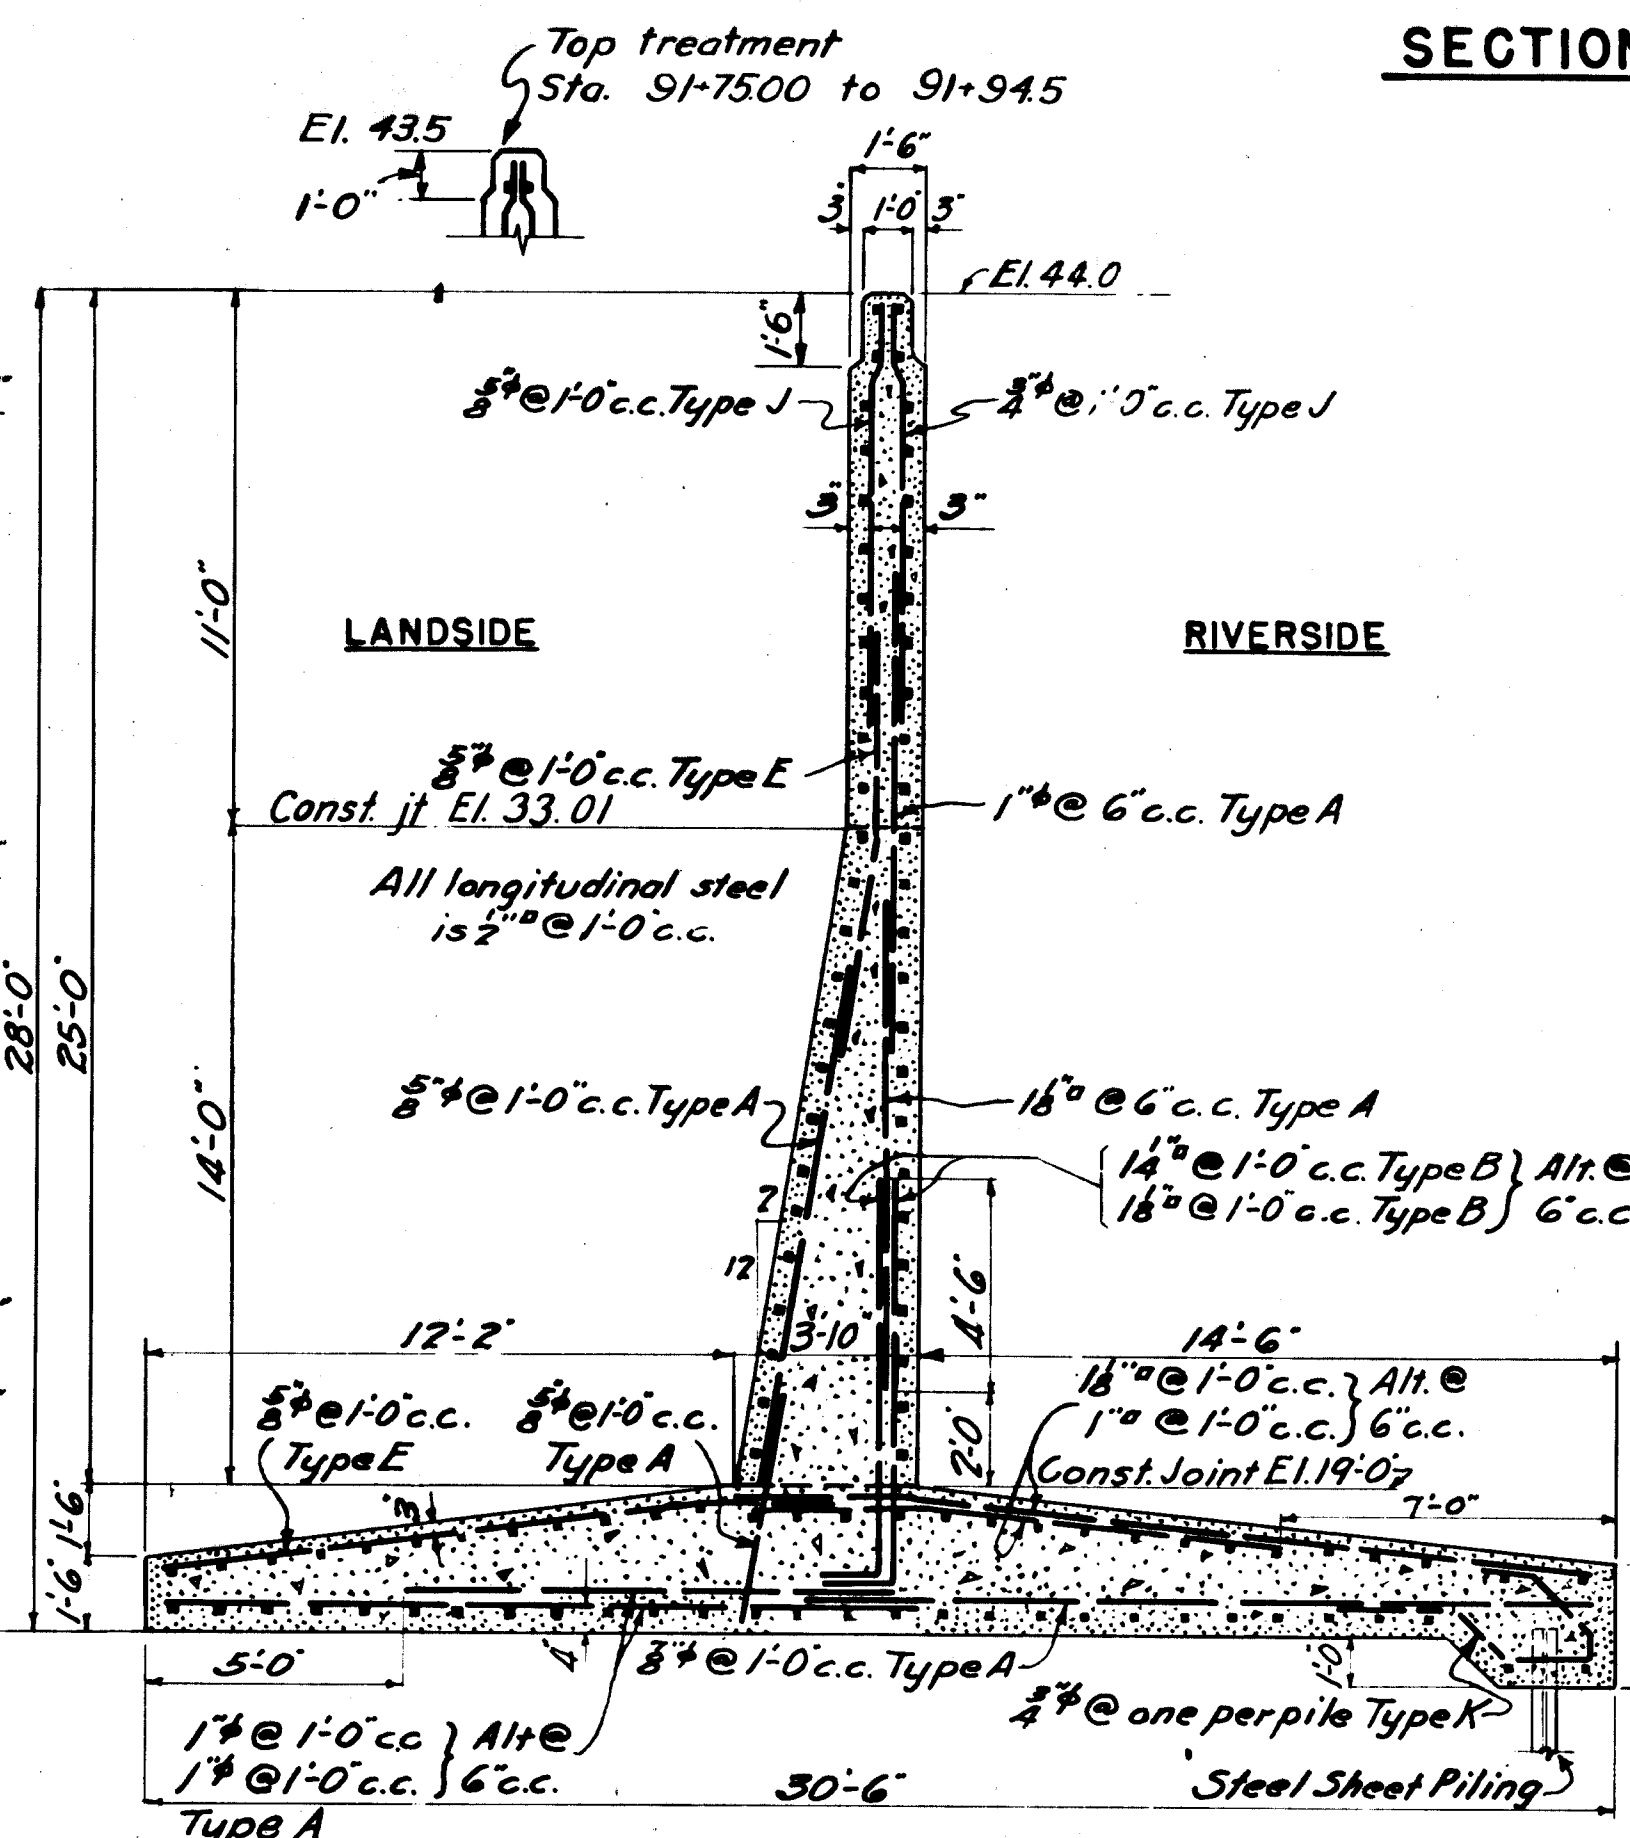



LANDSIDE ELEVATION

SECTION A
12425'-0" WALL SECTION B
124

NOTES

- For concrete details, see Sheets No. 63
For key to bar types see Sheet No. 124
The minimum cover for main steel reinforcement is 3" except where concrete is poured against earth in which case it is 4"
Bar splices are equal in length to 40 diameters of the smaller bar.
Radius of bend of bar is equal to 4 diameters of the bar.
Payment for furnishing, bending and placing of steel reinforcement was made under Item No. 25

	12-31-45	As built revisions			
KEY	DATE	REVISION (Indicated by Δ)		REV. BY	CK. BY
				AP. BY	

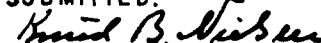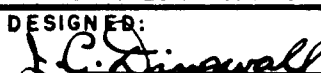CONNECTICUT RIVER FLOOD CONTROL					
HARTFORD DIKE					
RIVERFRONT, MORGAN ST. TO STA. 96+73.					
WALL DETAILS - STA. 91+33.01 TO STA. 92+30.					
REINFORCEMENT					
CONNECTICUT RIVER			CONNECTICUT		
IN 135 SHEETS		SCALE: 1/4 IN. = 1 FT.		SHEET NO. 124	
					
U.S. ENGINEER OFFICE, PROVIDENCE, R.I., MAY 1940					
SUBMITTED:		APPROVAL RECOMMENDED:		APPROVED:	
					
SENIOR ENGINEER		PRINCIPAL ENGINEER		LTCOL., CORPS OF ENGINEERS	
H.D. DESIGN SECTION		CHIEF OF ENGINEERING DIV.		DISTRICT ENGINEER	
DESIGNED BY:		DRAWN:		FISCAL YEAR 1940	
		J. S. M.		FILE NO. CT-4-2584	
ASSOC. ENGINEER		CHECKED: R. L. J.			