



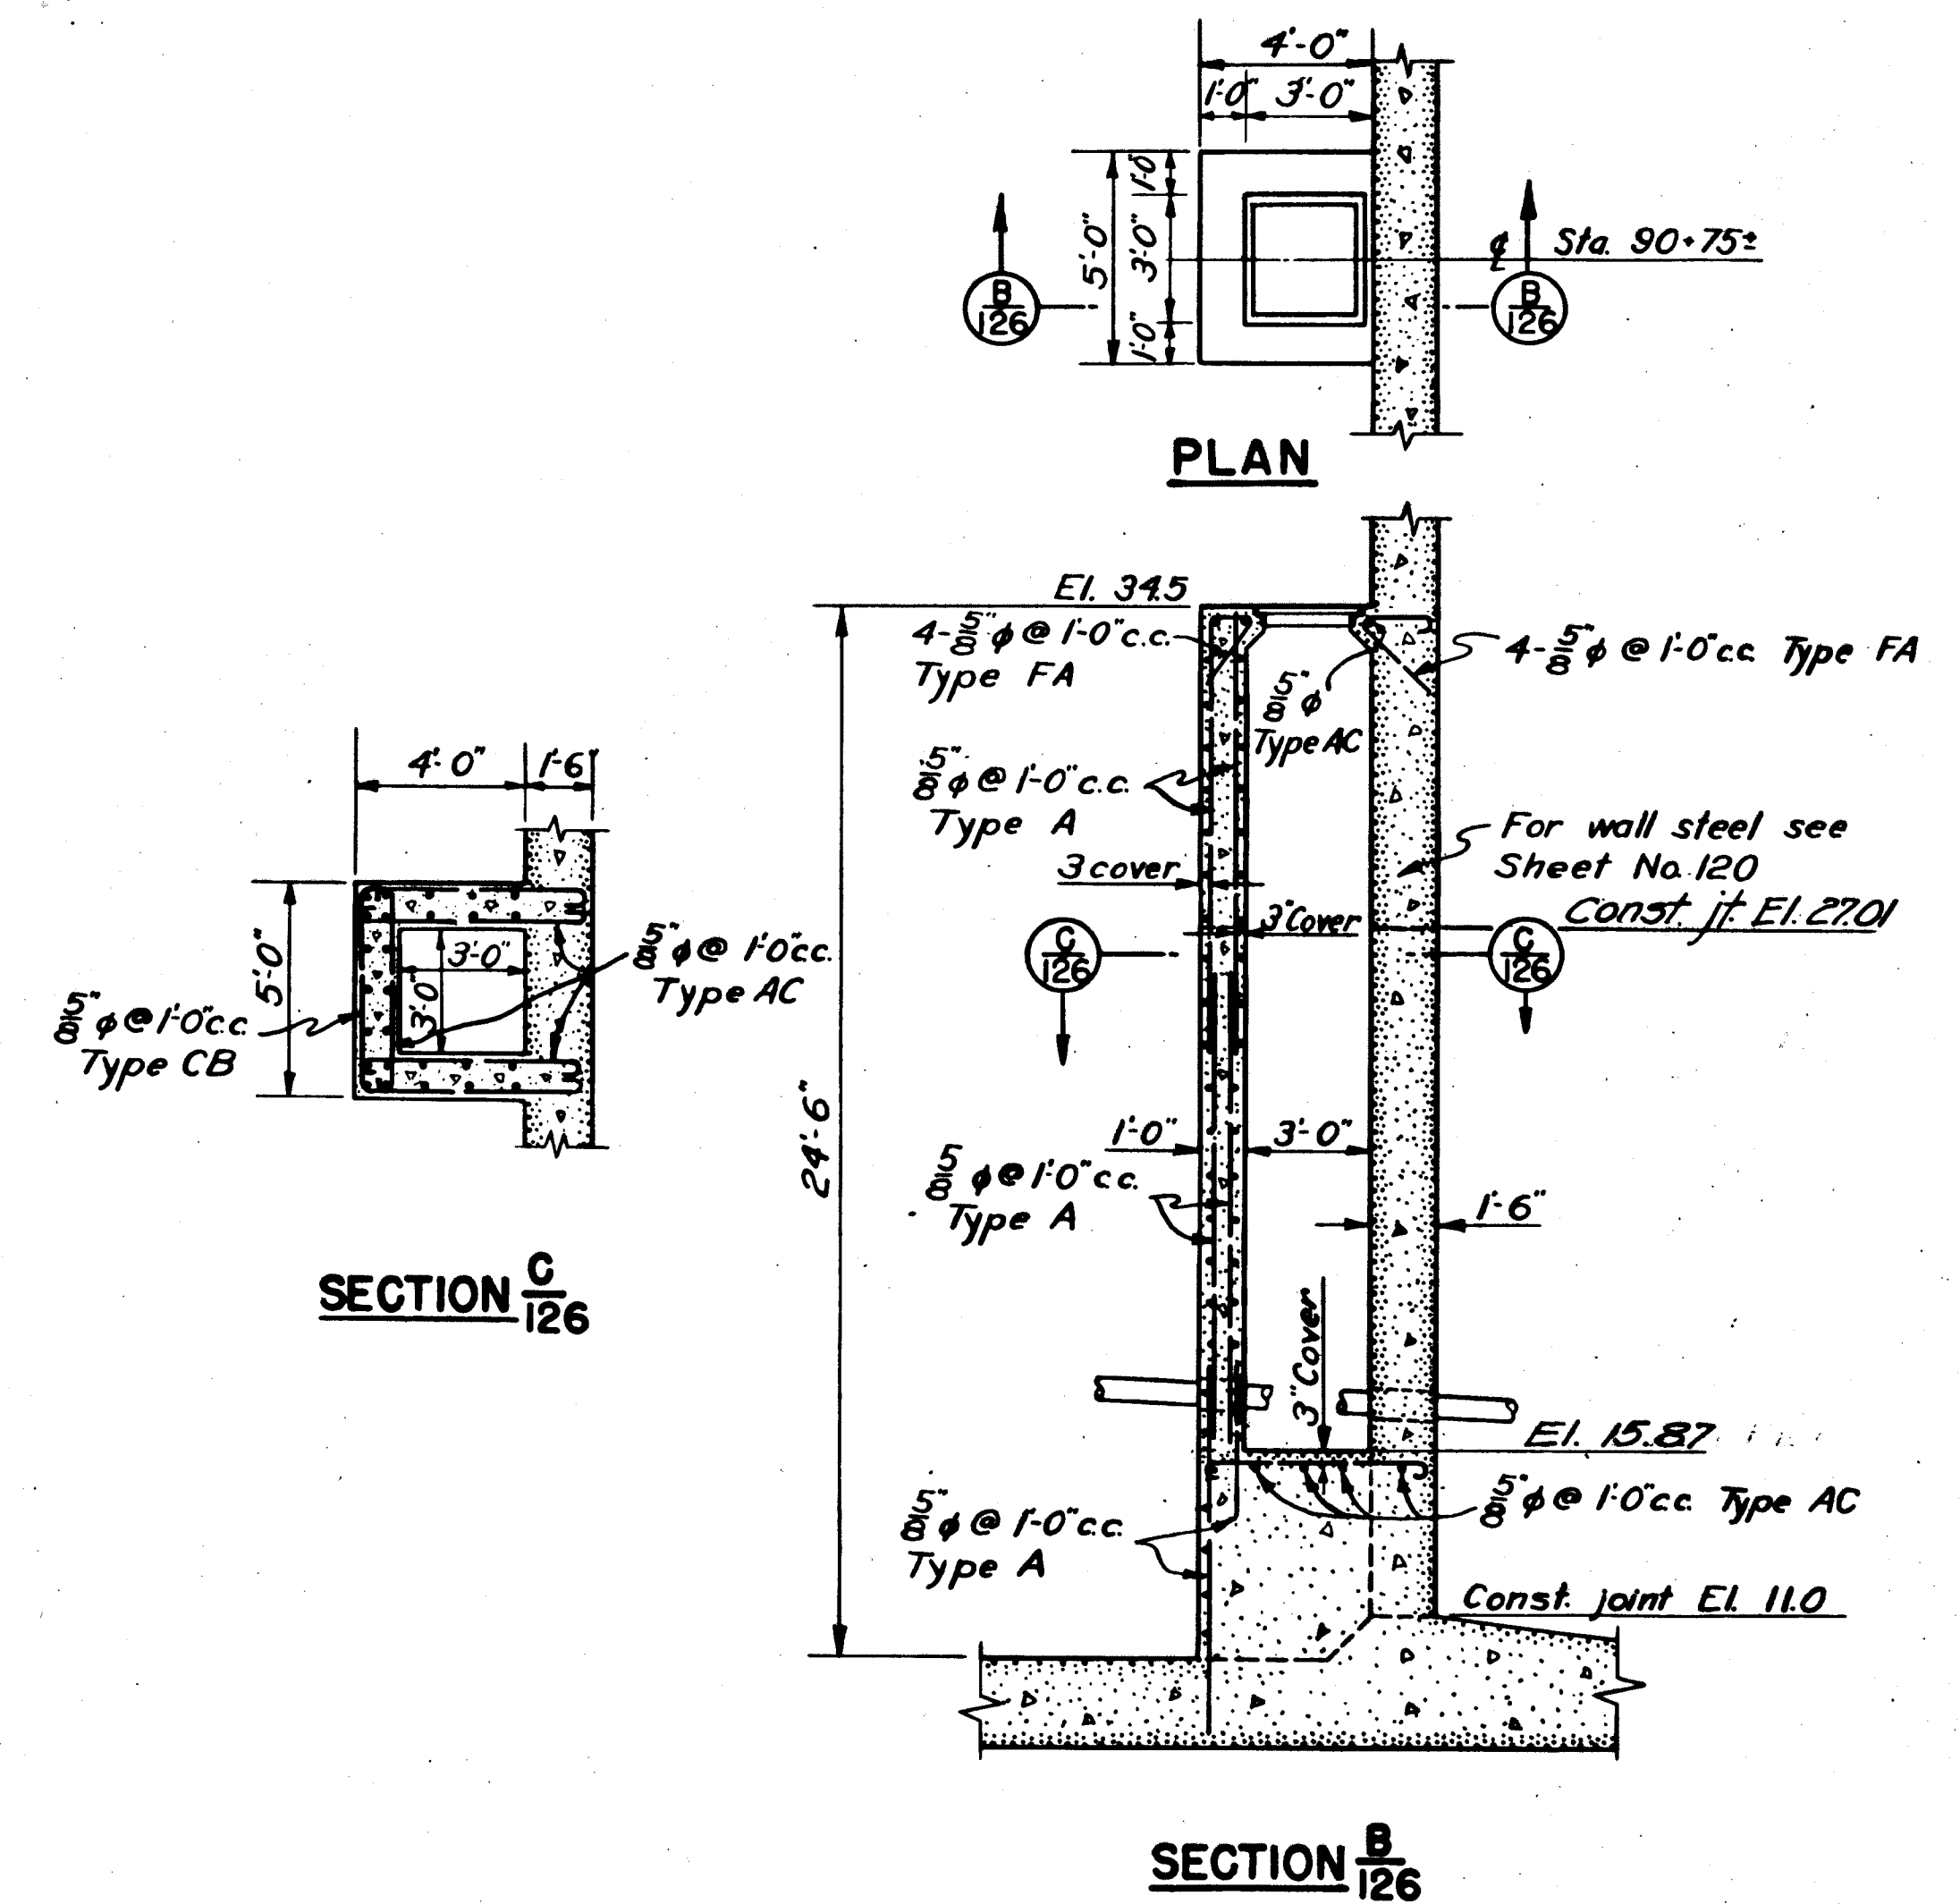

NOTES:-
For general notes see Sheet No. 125
For concrete pile plan see Sheet No. 61

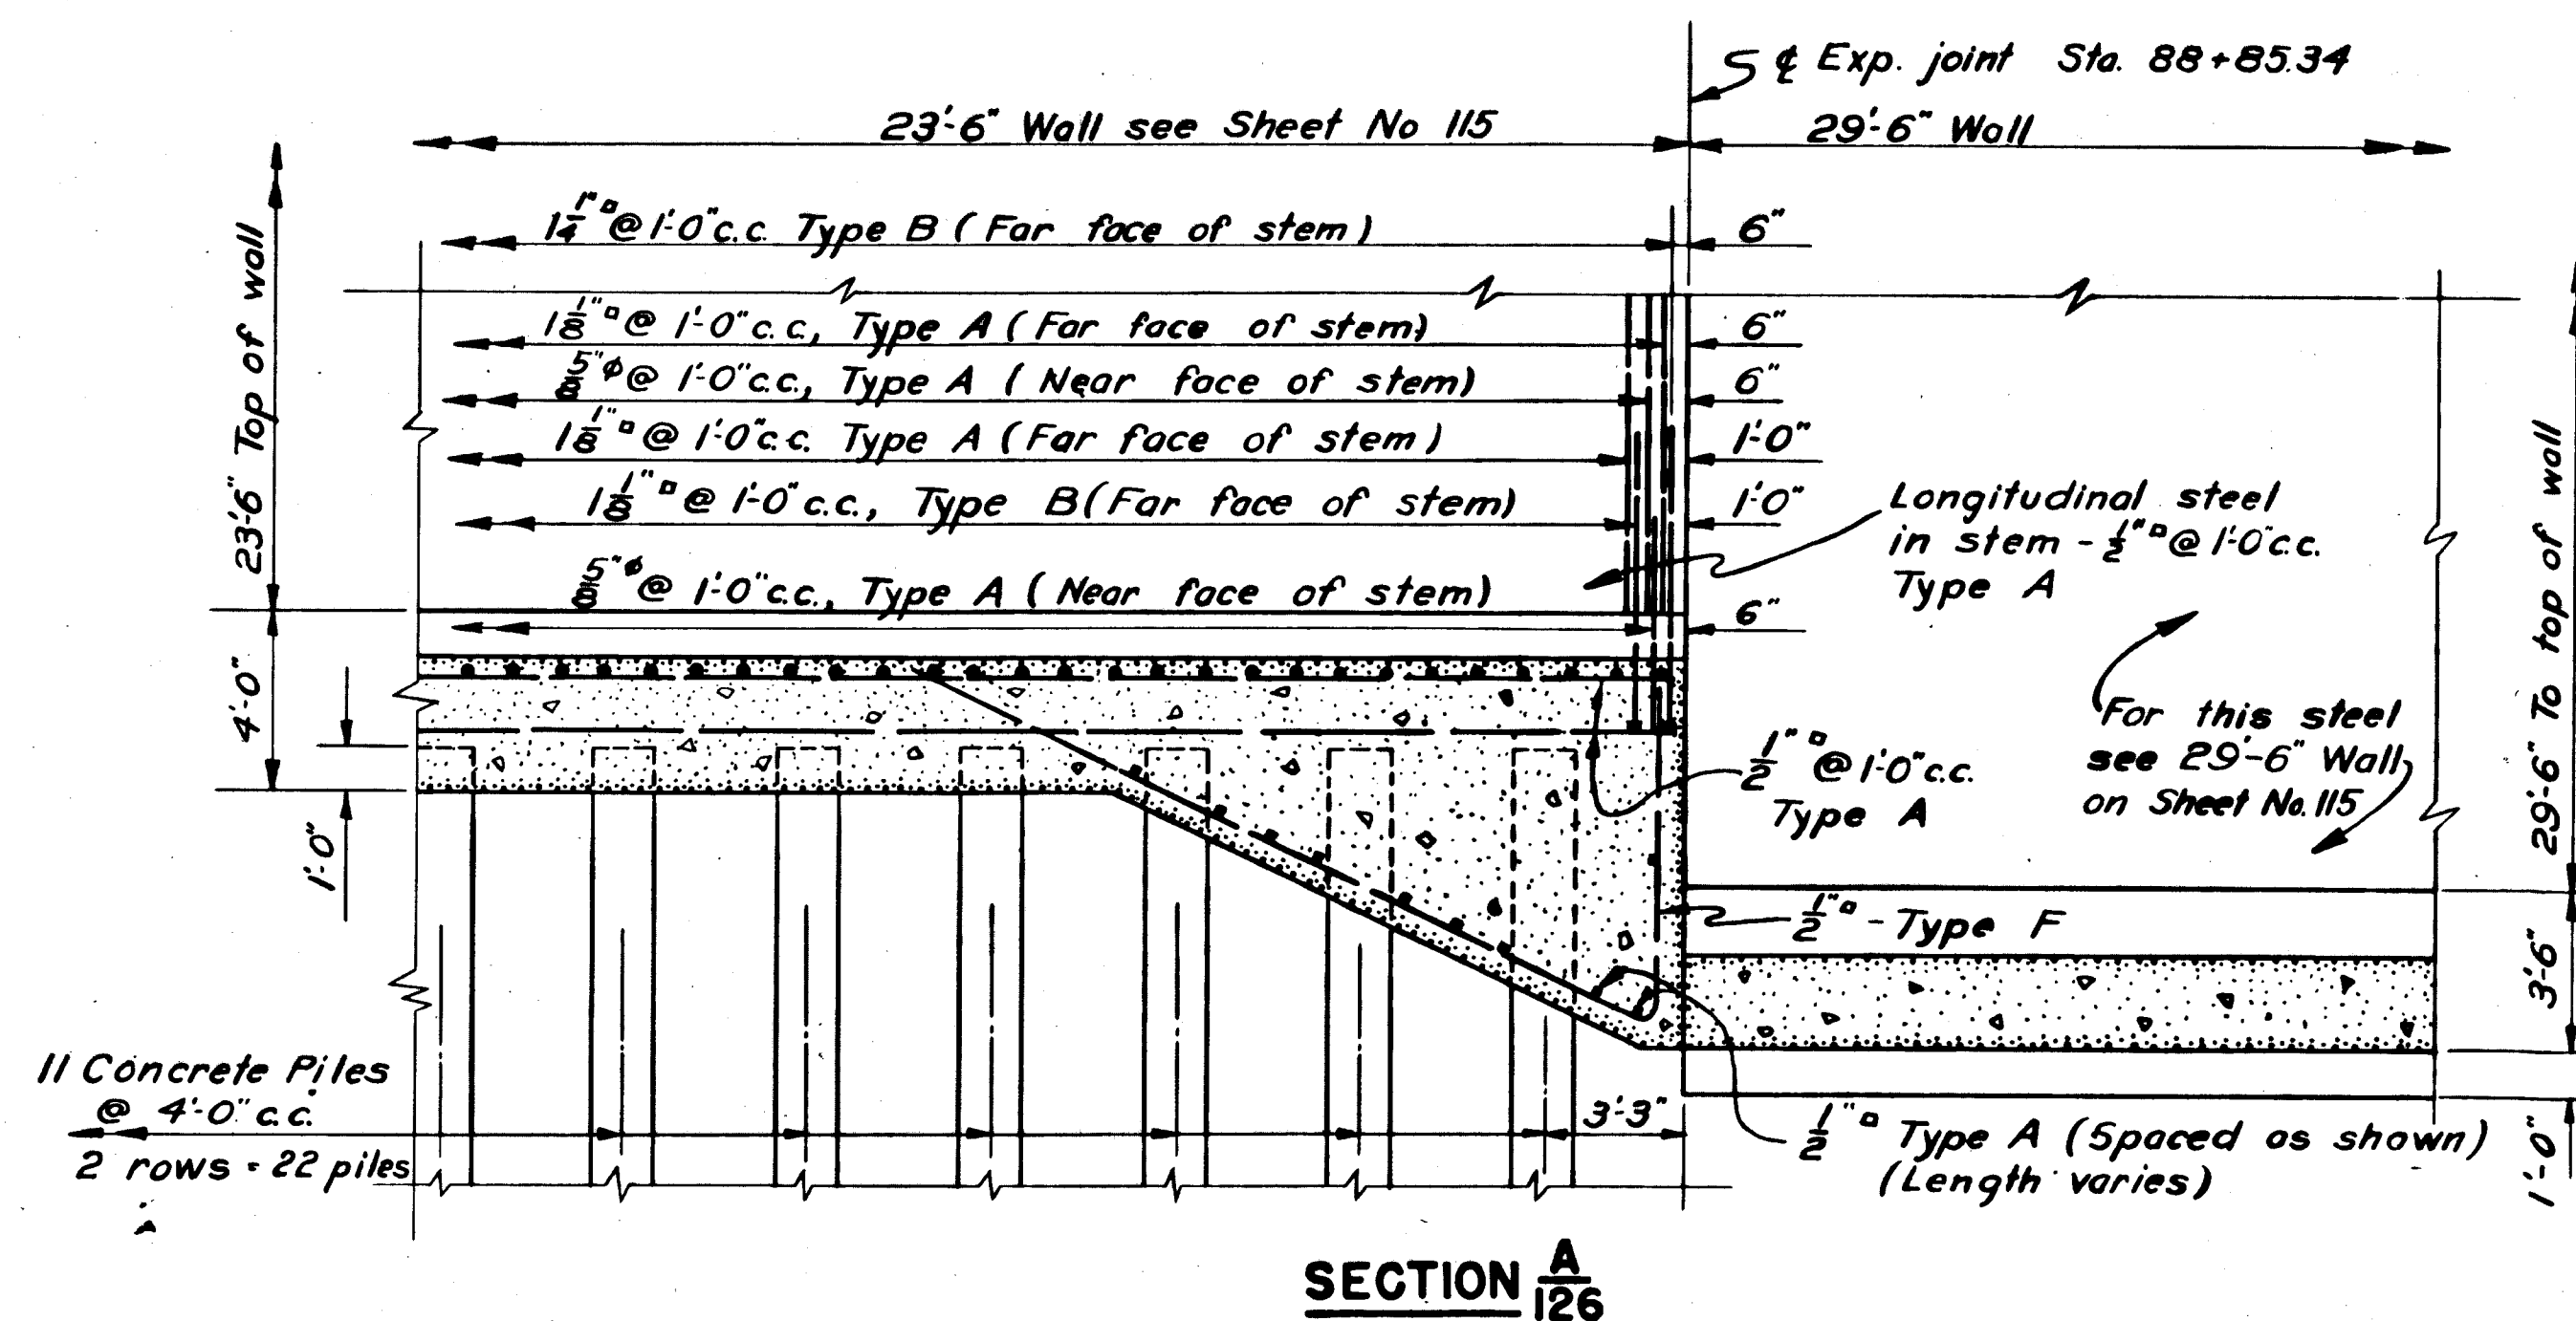

	12-31-45	As built revisions			
KEY	- DATE	REVISION (Indicated by Δ)	REV. BY	CK. BY	AP. BY

CONNECTICUT RIVER		FLOOD CONTROL	
HARTFORD DIKE RIVERFRONT, MORGAN ST. TO STA 96+73 GENERAL WALL DETAILS STEEL REINFORCEMENT NO. 2			
CONNECTICUT RIVER		CONNECTICUT	
IN 135 SHEETS	SCALE: 1/4 IN. = 1 FT.	SHEET NO. 126	
U.S. ENGINEER OFFICE, PROVIDENCE, R.I.,		MAY 1940	
SUBMITTED:	APPROVAL RECOMMENDED:	APPROVED:	
<i>Edward B. McNeil</i>	<i>Ed Burriss</i>	<i>W. C. Bradley</i>	
SENIOR ENGINEER	PRINCIPAL ENGINEER	COL., CORPS OF ENGINEERS	
HEAD, DESIGN SECTION	CHIEF, P.C. ENGINEERING DIV.	DISTRICT ENGINEER	
DESIGNED:	DRAWN: J. S. M.	FISCAL YEAR 1940	
<i>J. C. McNeil</i>	TRACE: I. E. H.	FILE NO. CT-4-2586	
13507 ENGINEER	CHECKED: E. H. H.		