
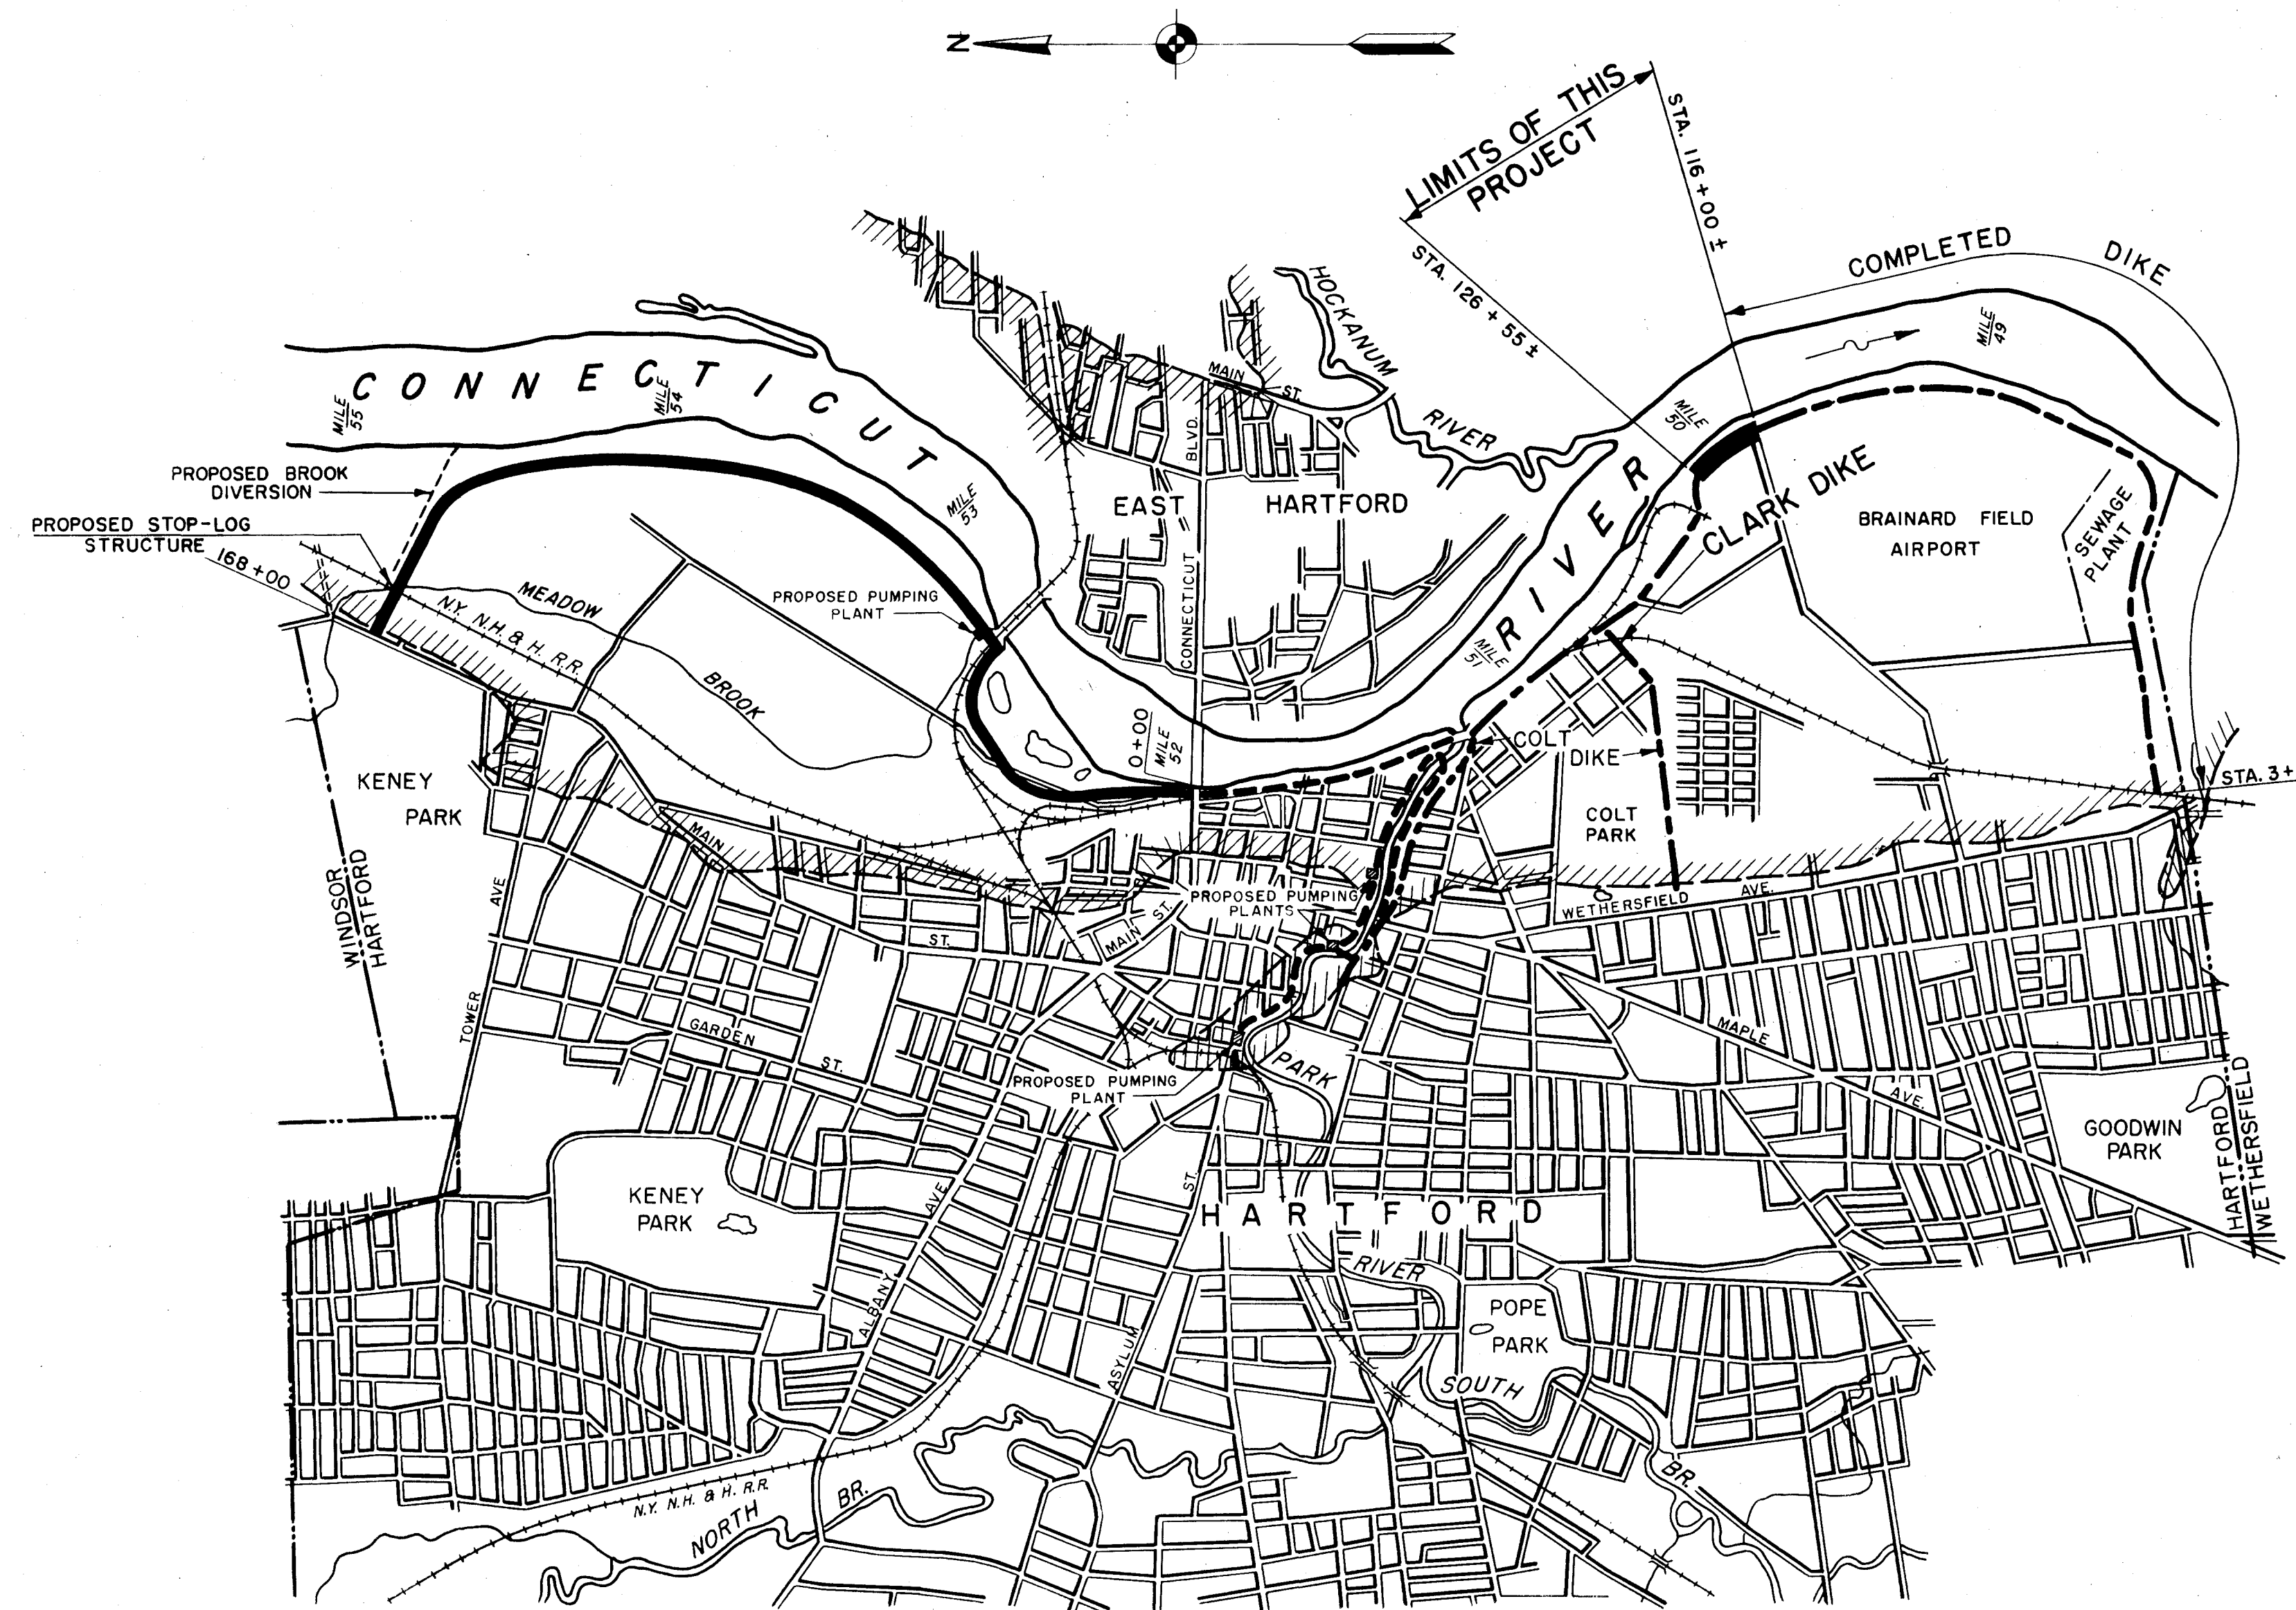


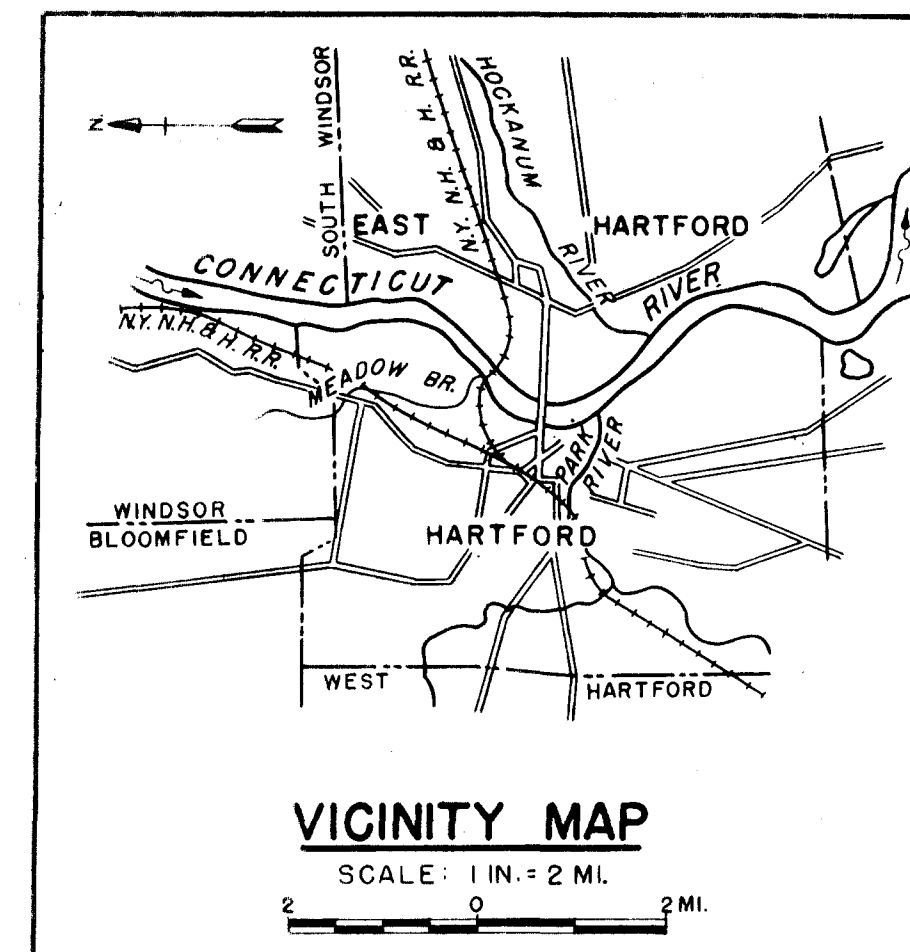

INDEX TO DRAWINGS

<u>SHEET NO.</u>	<u>DESCRIPTION</u>	<u>FILE NO.</u>
1	PROJECT LOCATION AND INDEX	CT- 4 - 1867
2	BORROW AREAS	CT -2 - 1186
3	GENERAL PLAN	CT -4 - 1868
4	TYPICAL SECTIONS	CT - 4 - 1869
5	TYPICAL SECTIONS AND DETAILS	CT - 4 - 1870
6	REVISED MANHOLE DETAILS	CT -4 - 3576
7	PROFILE AND LAYOUT OF RAMP AT STA. 117+50	CT -4 - 3577

LEGEND

Project	
Present Dike	
Under Construction	
Future Construction	
Overflow Limits of the March 1936 Flood	

	12-31-45	As built revisions (sheets 6 and 7 added)			
KEY	DATE	REVISION (Indicated by Δ)	REV.BY	CK.BY	AP.BY

CONNECTICUT	RIVER	FLOOD CONTROL
CLARK DIKE		
AVIATION ROAD - 900 FEET NORTH		
PROJECT LOCATION AND INDEX		
HARTFORD, CONN.		
CONNECTICUT RIVER		CONNECTICUT
IN 7 SHEETS	SCALE: 1 IN = 2000 FT.	SHEET NO. 1
U.S. ENGINEER OFFICE, PROVIDENCE, R.I.		
SUBMITTED:		APPROVAL RECOMMENDED:
SENIOR ENGINEER HEAD DESIGN SECTION	PRINCIPAL ENGINEER CHIEF OF ENGINEERING DIV.	LT COL. CORPS OF ENGINEERS DISTRICT ENGINEER
DESIGNED:	DRAWN: P.D.M. TRACED: M.H.M. CHECKED:	FILE NO. CT-4-1867
ASSOC. ENGINEER		