
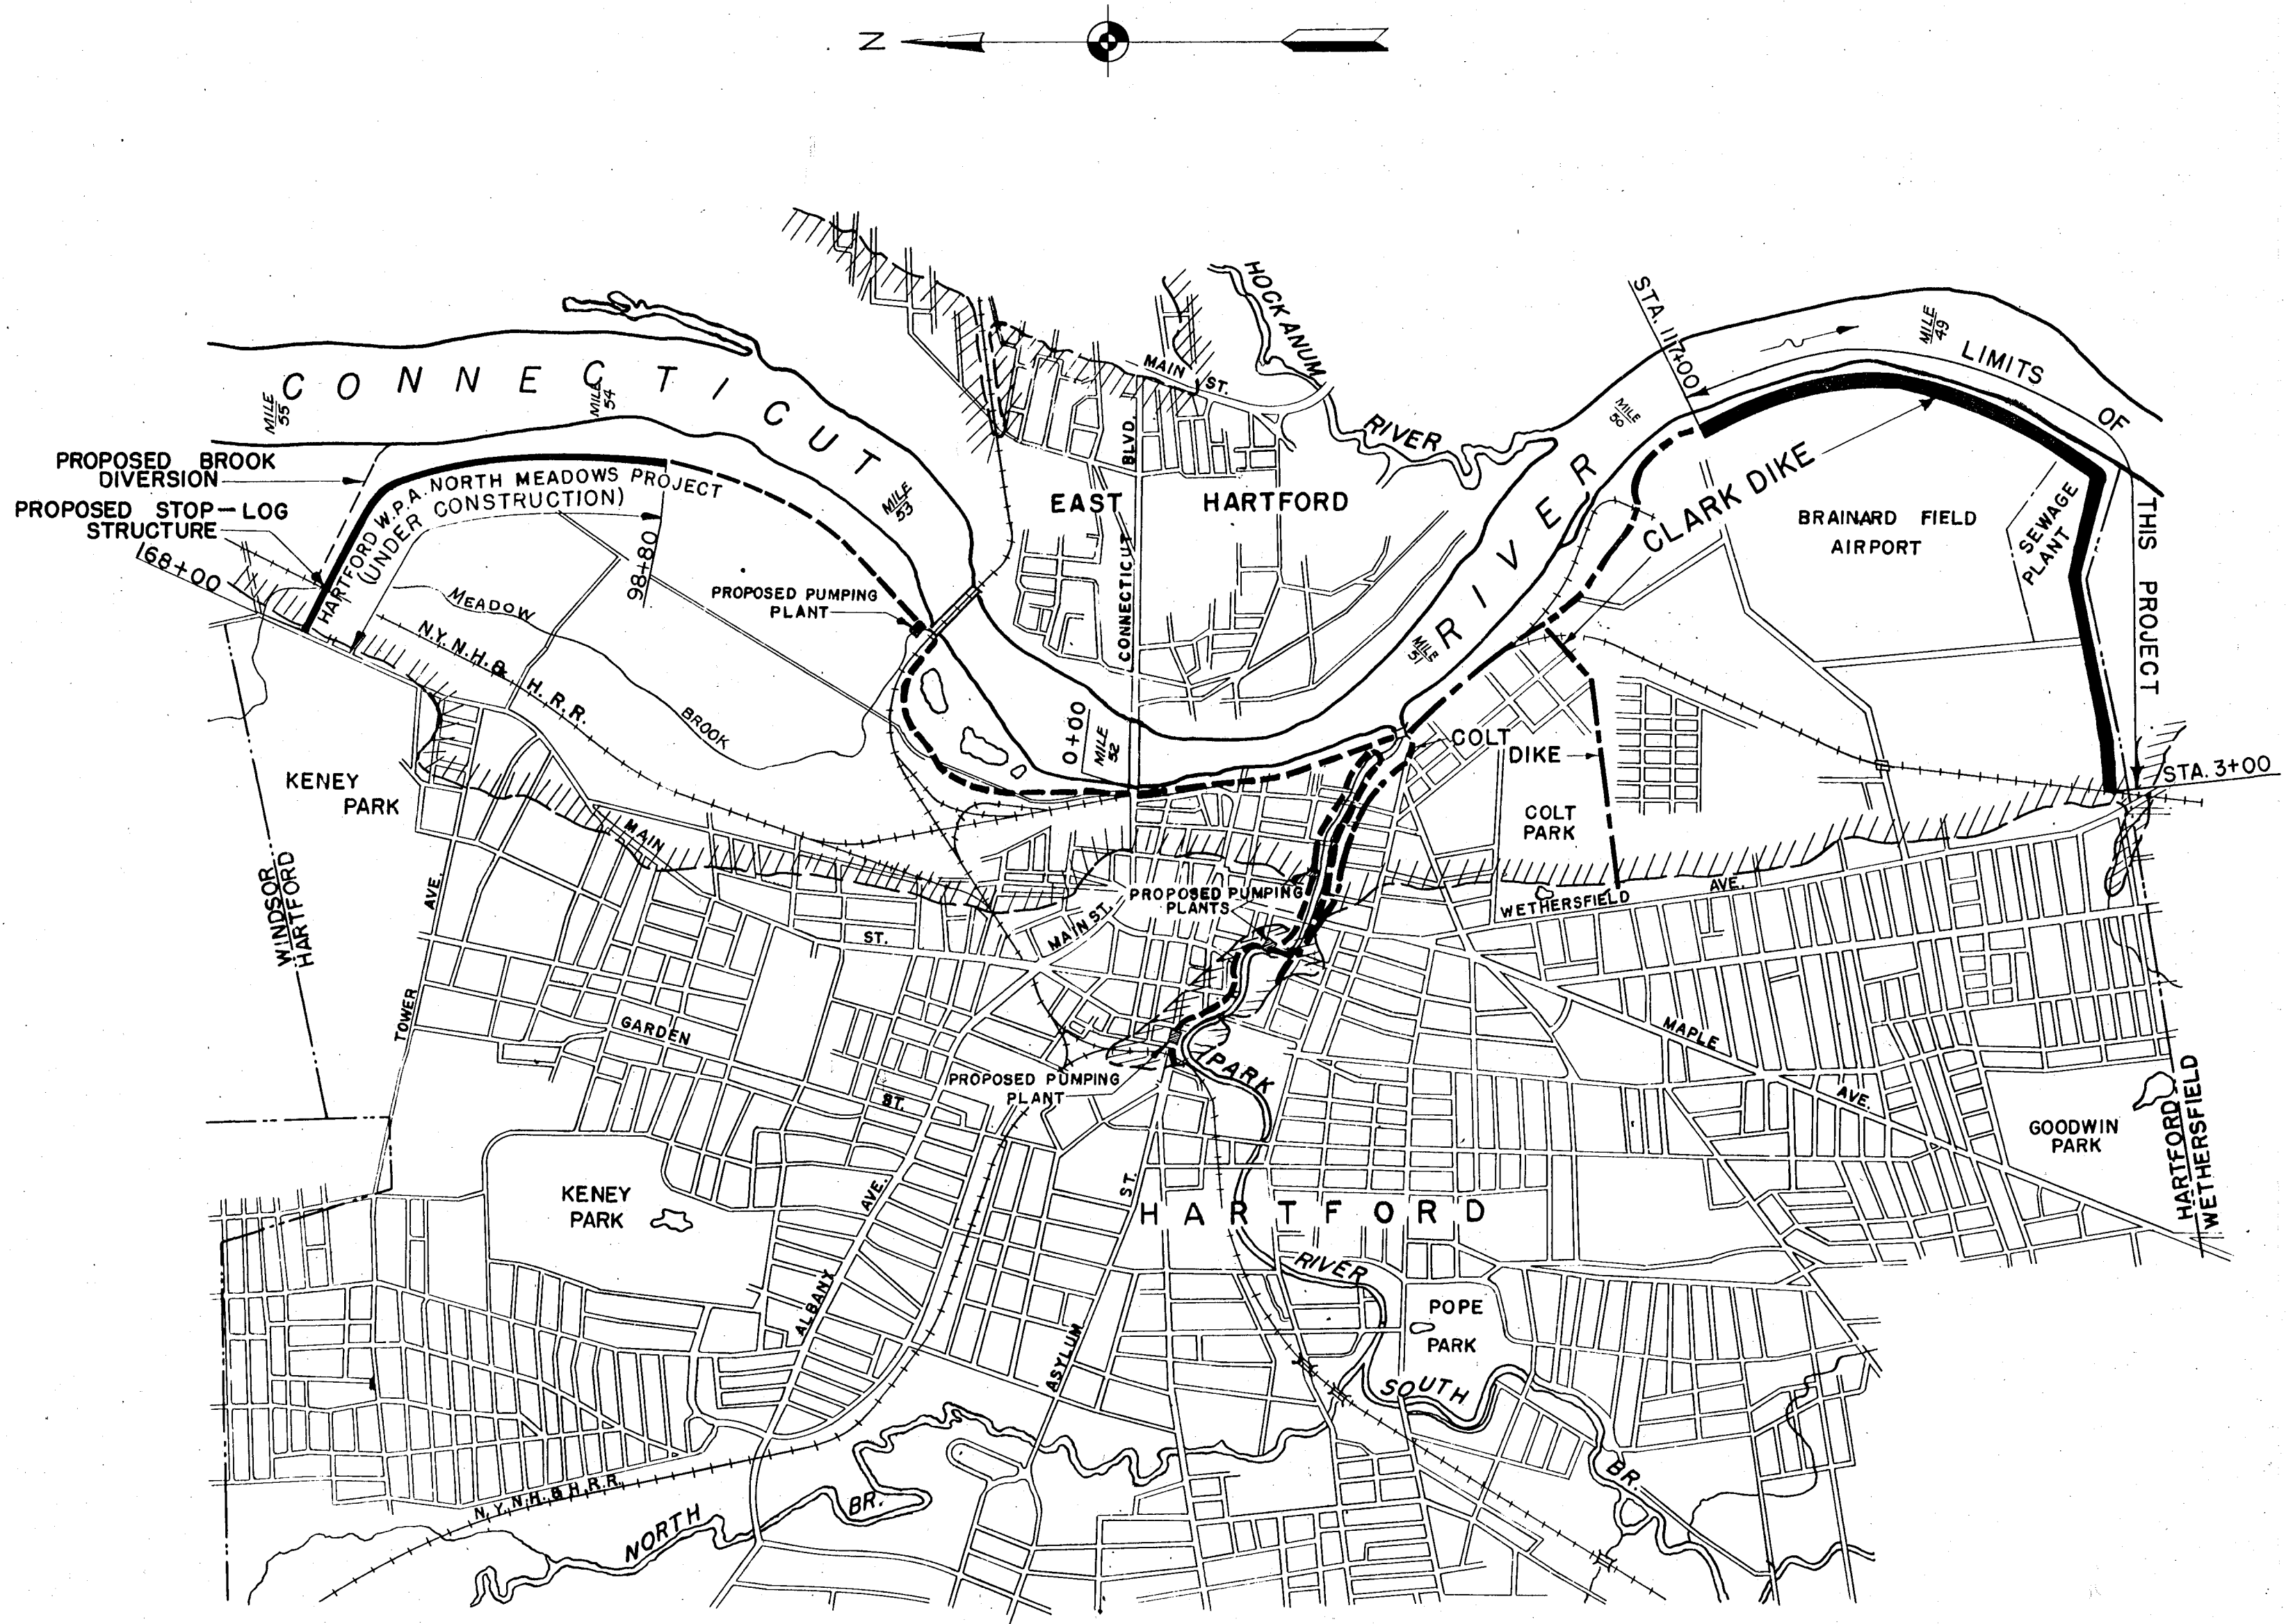


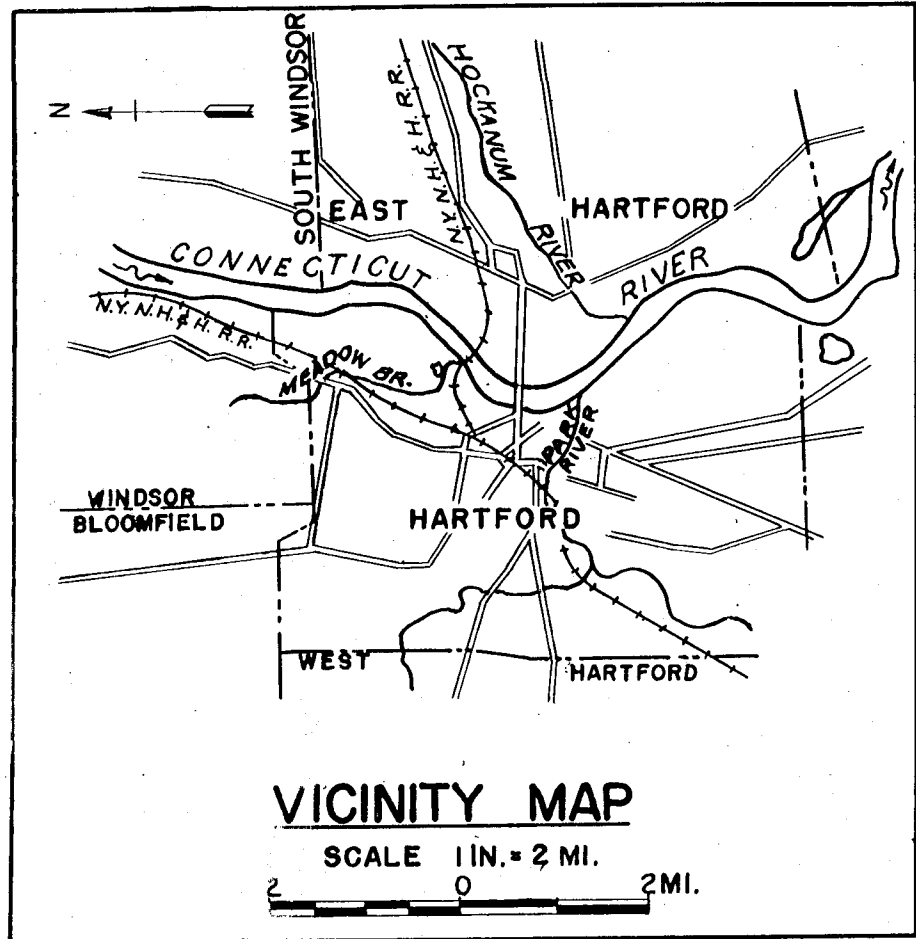

LOCATION MAP

INDEX TO DRAWINGS

SHEET NO.	DESCRIPTION	FILE NO.
1	PROJECT LOCATION AND INDEX	CT-4-1147
2	BORROW AREAS	CT-2-1118
3	GENERAL PLAN	CT-4-1145
4	TYPICAL SECTIONS	CT-4-1146
5	TYPICAL SECTIONS AND DETAILS	CT-4-1240
6	DETAILS OF RAMP AT STA. 7+00	CT-4-1241
7	DETAILS OF RAMPS AT STA. 43+00	CT-4-1242
8	TOE DRAINAGE DETAILS	CT-4-1310
9	PROPOSED ALINEMENT OF ROAD AND DRIVEWAY TO PUMPING STATION STA. 5+51.68 TO STA. 7+75	CT-4-357H

LEGEND

Project	—
Present Dike.	—
Under Construction.	—
Future Construction	—
Overflow Limits of the March 1936 Flood	—

CONNECTICUT RIVER FLOOD CONTROL
CLARK DIKE
REPAIR & COMPLETION FROM STA. 3+00 TO 117+00
PROJECT LOCATION AND INDEX
HARTFORD, CONNECTICUT

CONNECTICUT RIVER, CONNECTICUT
IN 9 SHEETS SCALE 1 IN. = 2000 FT. SHEET NO. 1

U. S. ENGINEER OFFICE, PROVIDENCE, R. I. DEC. 1938

SUBMITTED: *W. B. Nichols* APPROVAL RECOMMENDED: *W. B. Nichols*
SENIOR ENGINEER PRINCIPAL ENGINEER
CHIEF, DESIGN SECTION CHIEF, E. C. ENGINEERING DIV.
DESIGNED: *J. H. Carter* DRAWN BY: *J. T. M.* FILE NO. CT-4-1147
ASST. ENGINEER TRACED BY: *W. R. H.* TO ACCOMPANY SPECIFICATIONS
CHECKED BY: *J. J. M.* DATED: DEC. 3, 1938

DATE	REVISION	REV. BY	CK. BY	AP. BY
12-31-45	AS BUILT REVISIONS (SHEET 9 ADDED)			
3-6-39	ADDED SHEET 8 TO SET	<i>J. H.</i>	<i>W. R.</i>	<i>J. H.</i>