

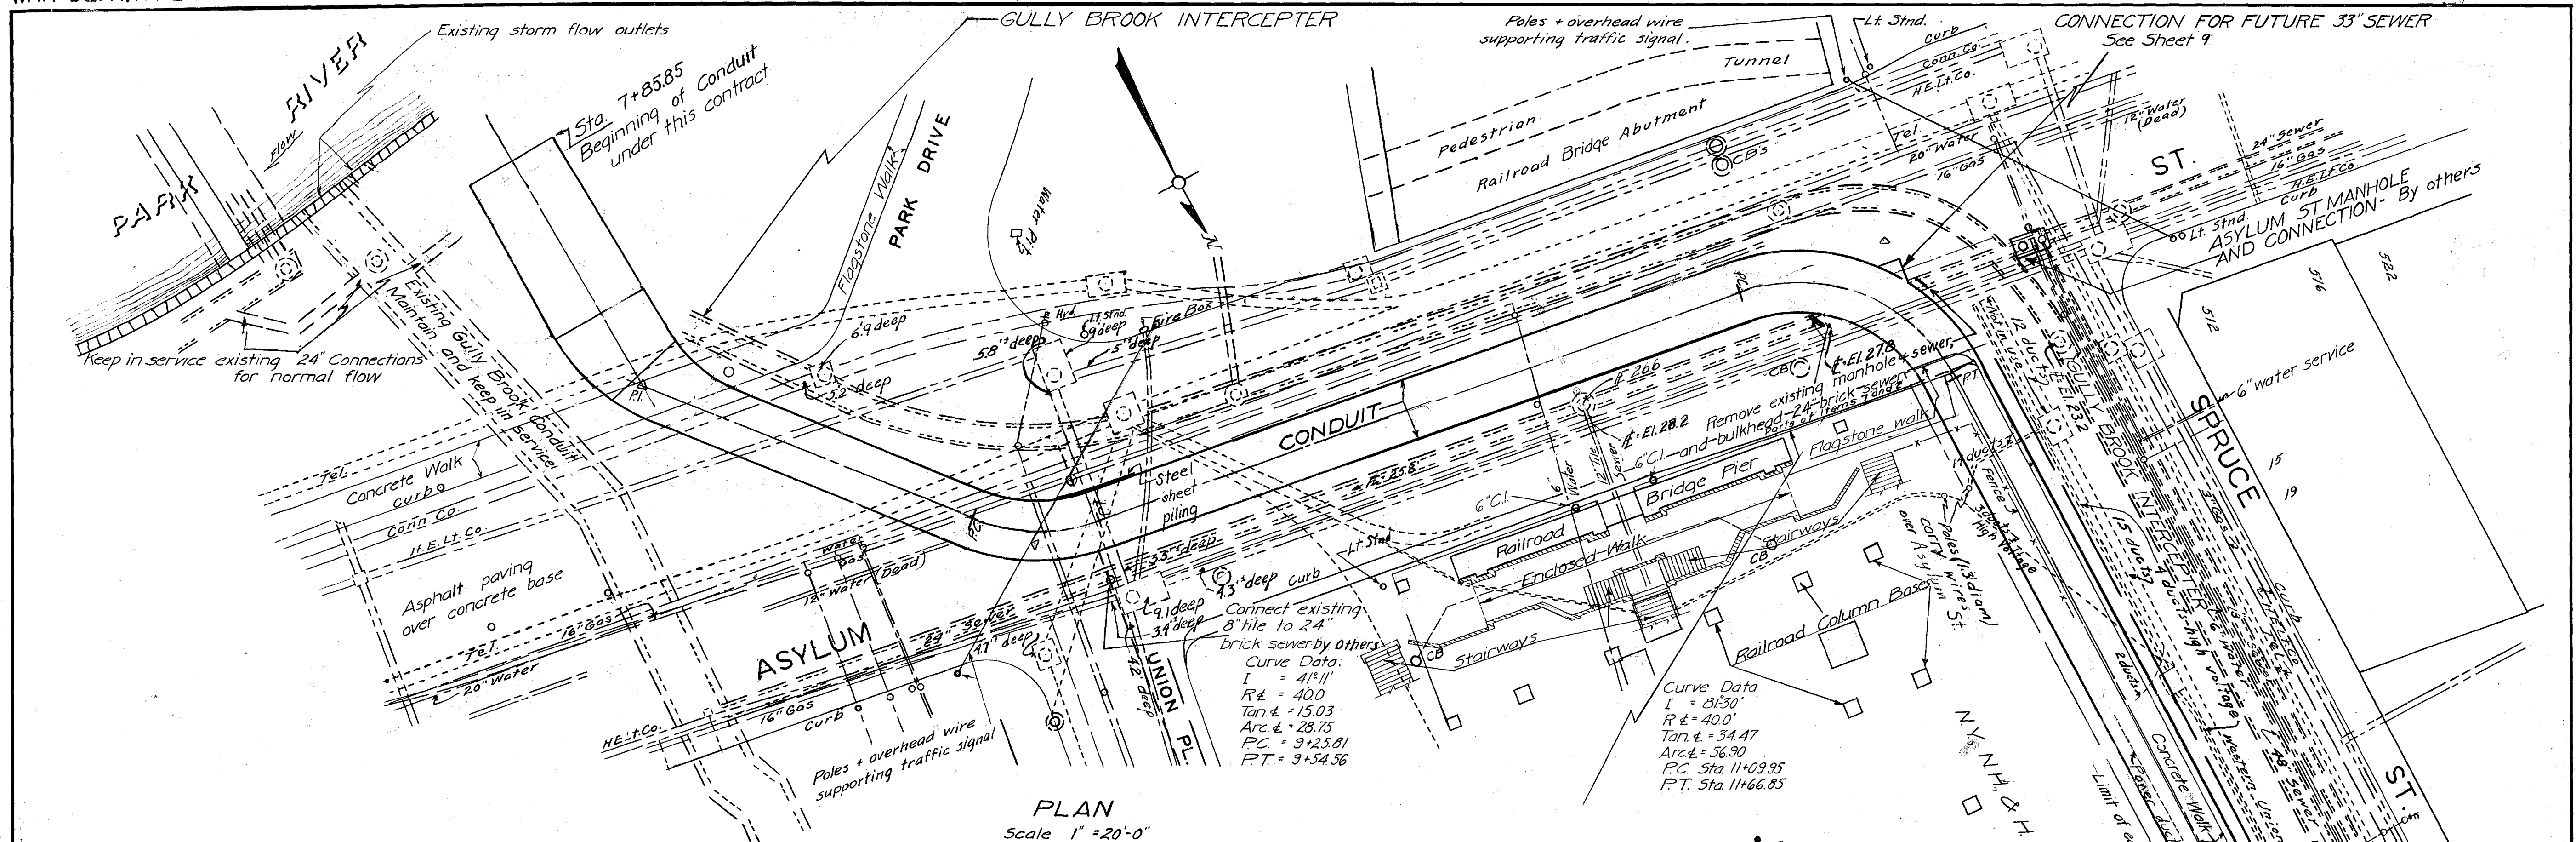
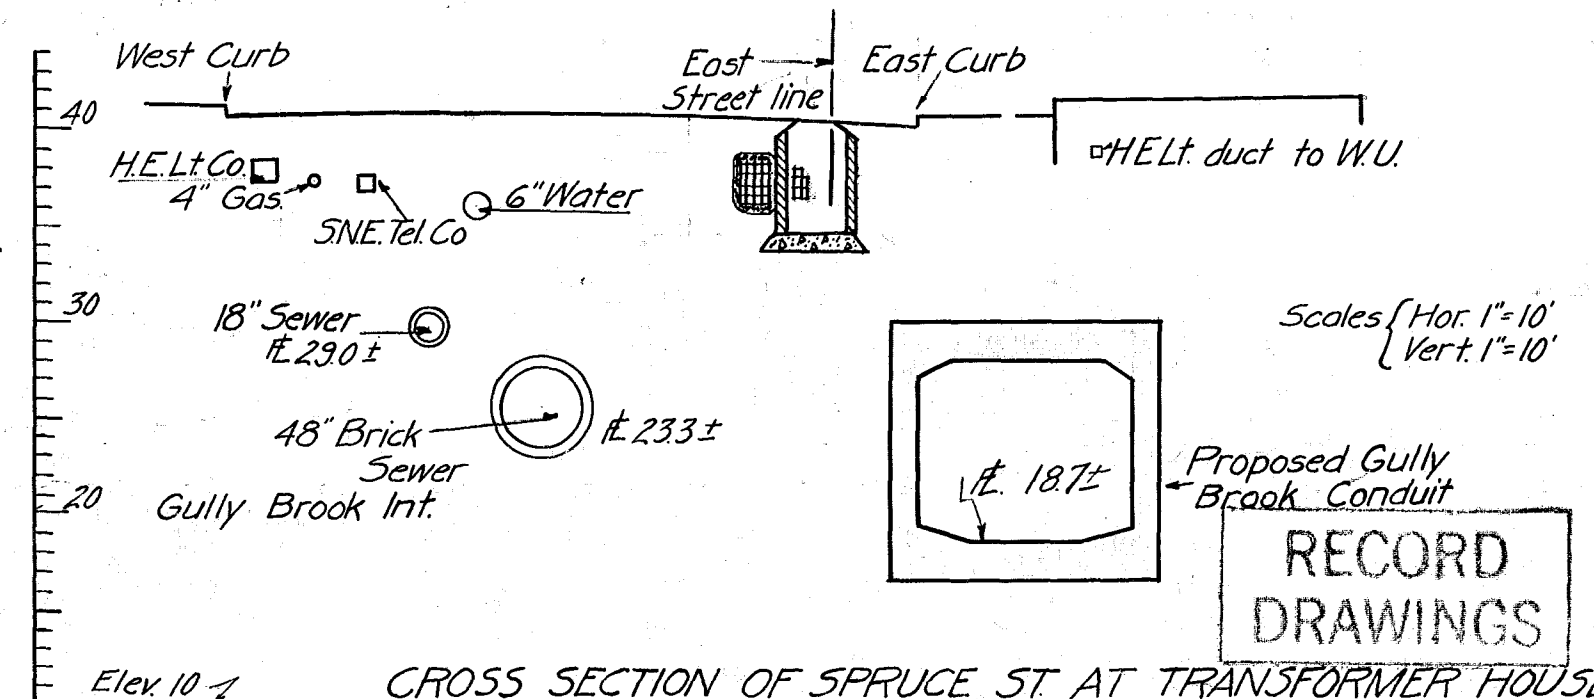


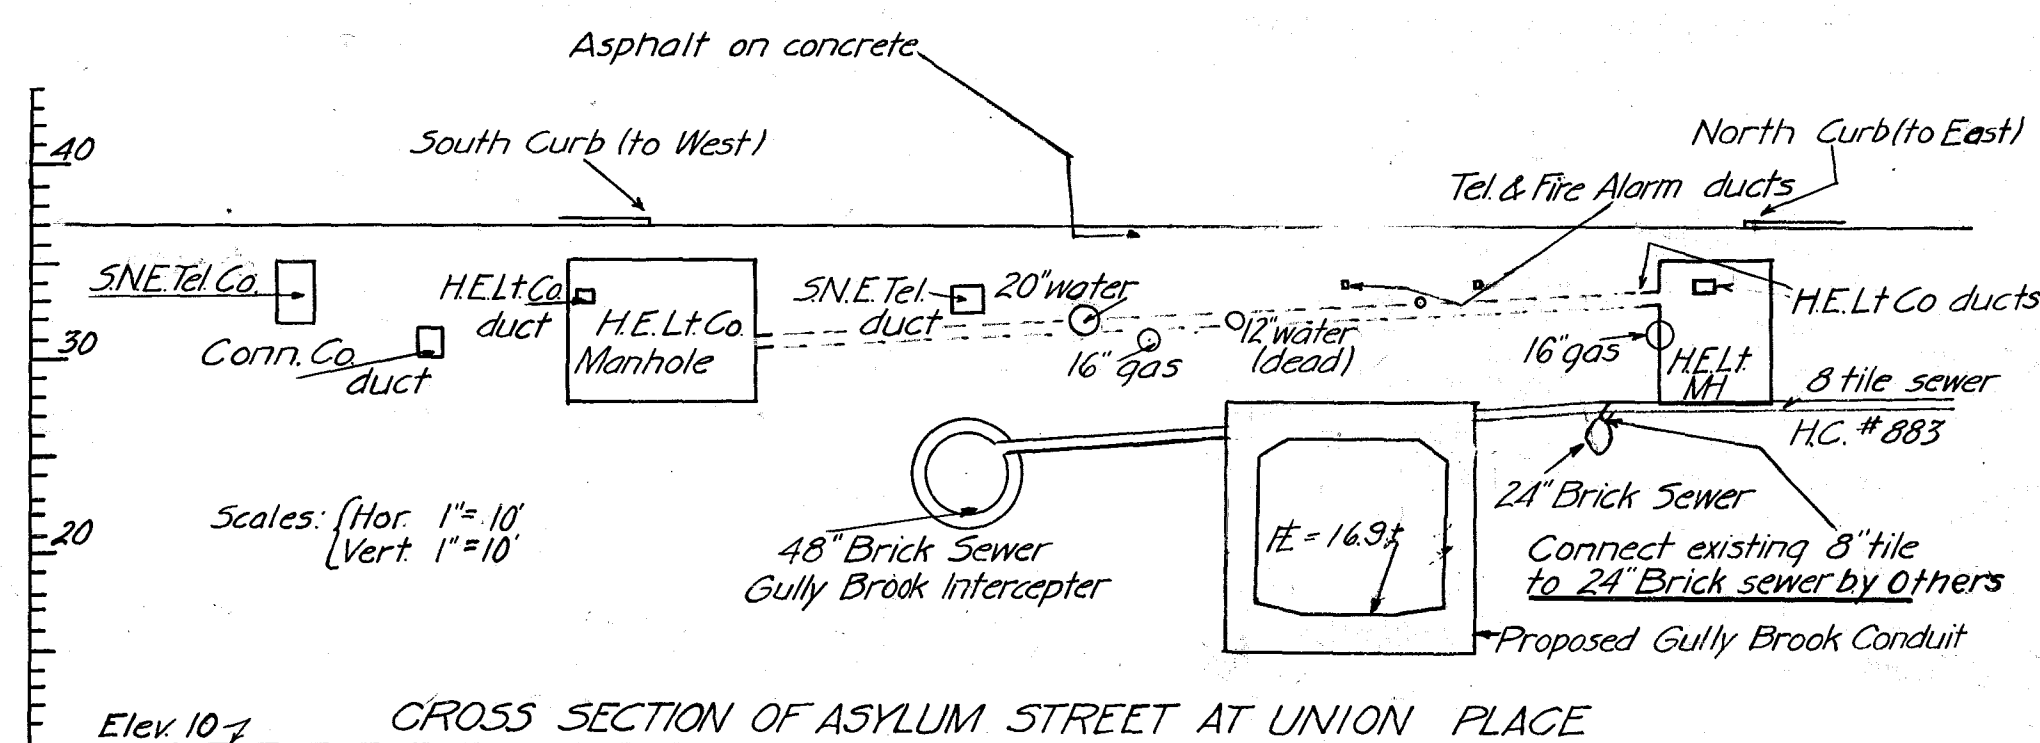

NOTE  
Elevations refer to Hartford City Datum.

Highest recorded level from Park River freshet 296 (1934)  
Highest recorded level from Conn River freshet 385 (1936)

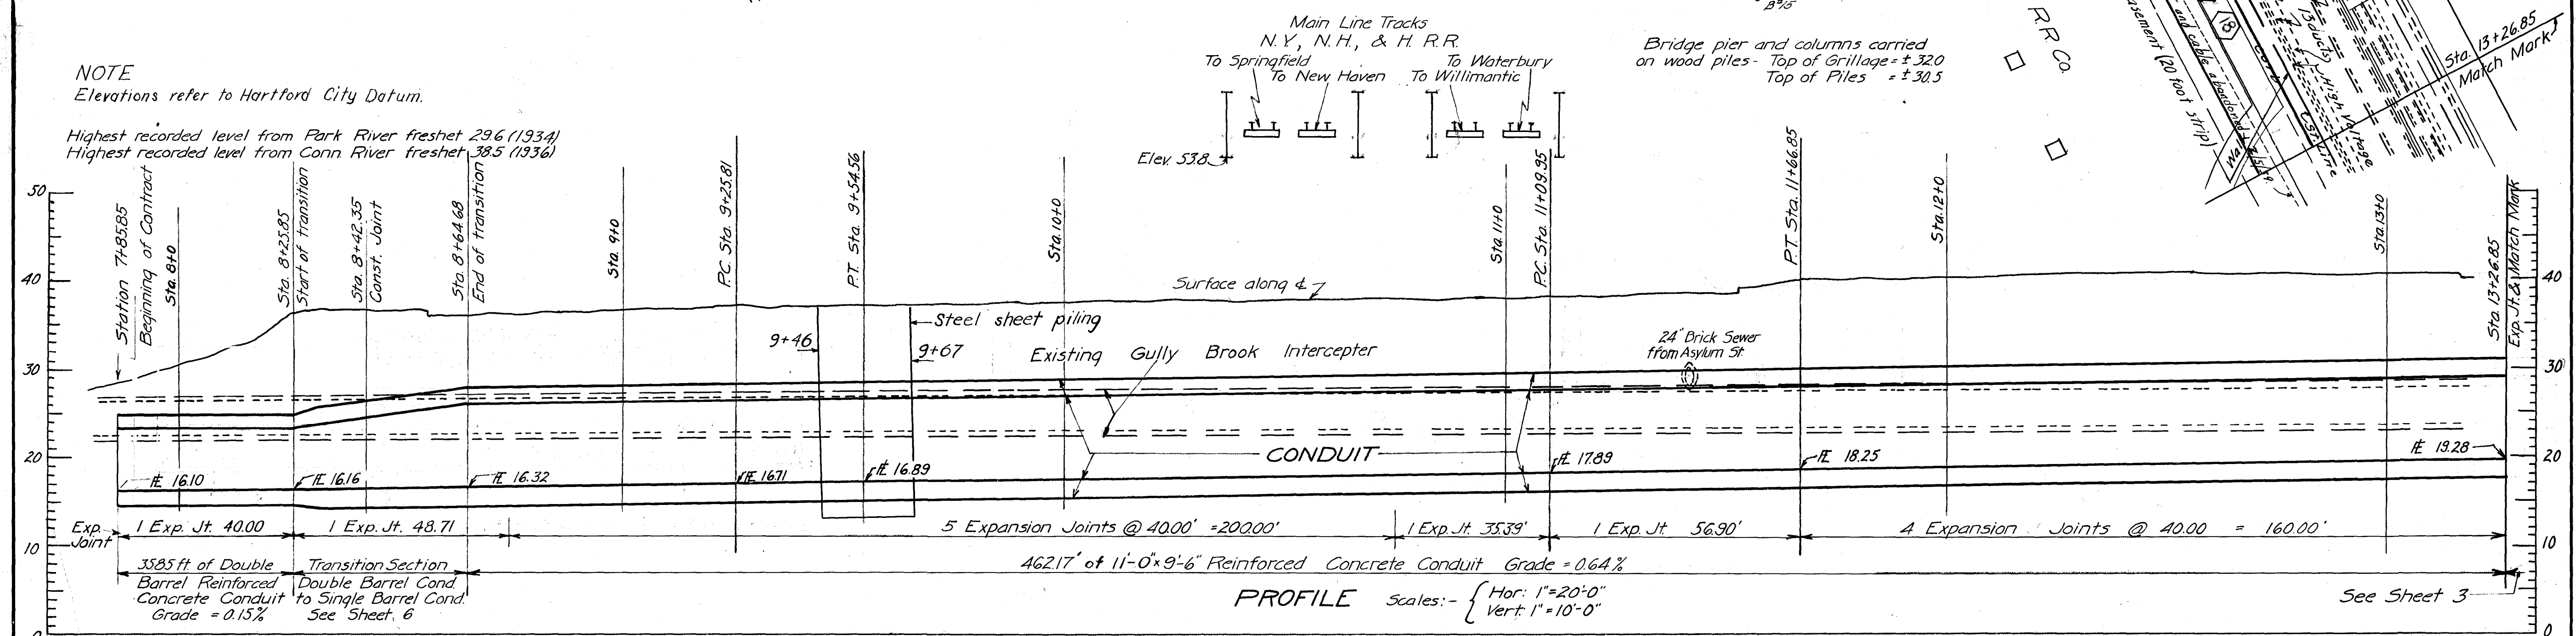

| 12-31-45                                         | As built revisions |                           |       |                    |      |
|--------------------------------------------------|--------------------|---------------------------|-------|--------------------|------|
| KEY                                              | DATE               | REVISION (Indicated by Δ) | REV'D | CHK'D              | AP'D |
| CONNECTICUT RIVER FLOOD CONTROL                  |                    |                           |       |                    |      |
| GULLY BROOK CONDUIT                              |                    |                           |       |                    |      |
| HARTFORD, CONN.                                  |                    |                           |       |                    |      |
| PLAN AND PROFILE ASYLUM ST. AND SPRUCE ST.       |                    |                           |       |                    |      |
| STA. 7+85.85 to STA. 13+26.85                    |                    |                           |       |                    |      |
| PARK RIVER                                       |                    | CONNECTICUT               |       | SHEET NO. 2        |      |
| IN 9 SHEETS                                      |                    | SCALE: 1 IN. = 20 FT.     |       | 20' 0' 40'         |      |
| U.S. ENGINEER OFFICE, PROVIDENCE, R.I. JULY 1943 |                    |                           |       |                    |      |
| REVIEWED BY:                                     |                    | APPROVED:                 |       | APPROVED:          |      |
| E. M. Viner                                      |                    | S. J. Viner               |       | S. J. Viner        |      |
| ENGINEER                                         |                    | CHIEF ENGINEER            |       | DISTRICT ENGINEER  |      |
| BASIC DESIGN                                     |                    | BY                        |       | FILE NO. CT-4-3150 |      |
| THE CITY OF HARTFORD                             |                    | CHECKED: A. W. S.         |       |                    |      |