


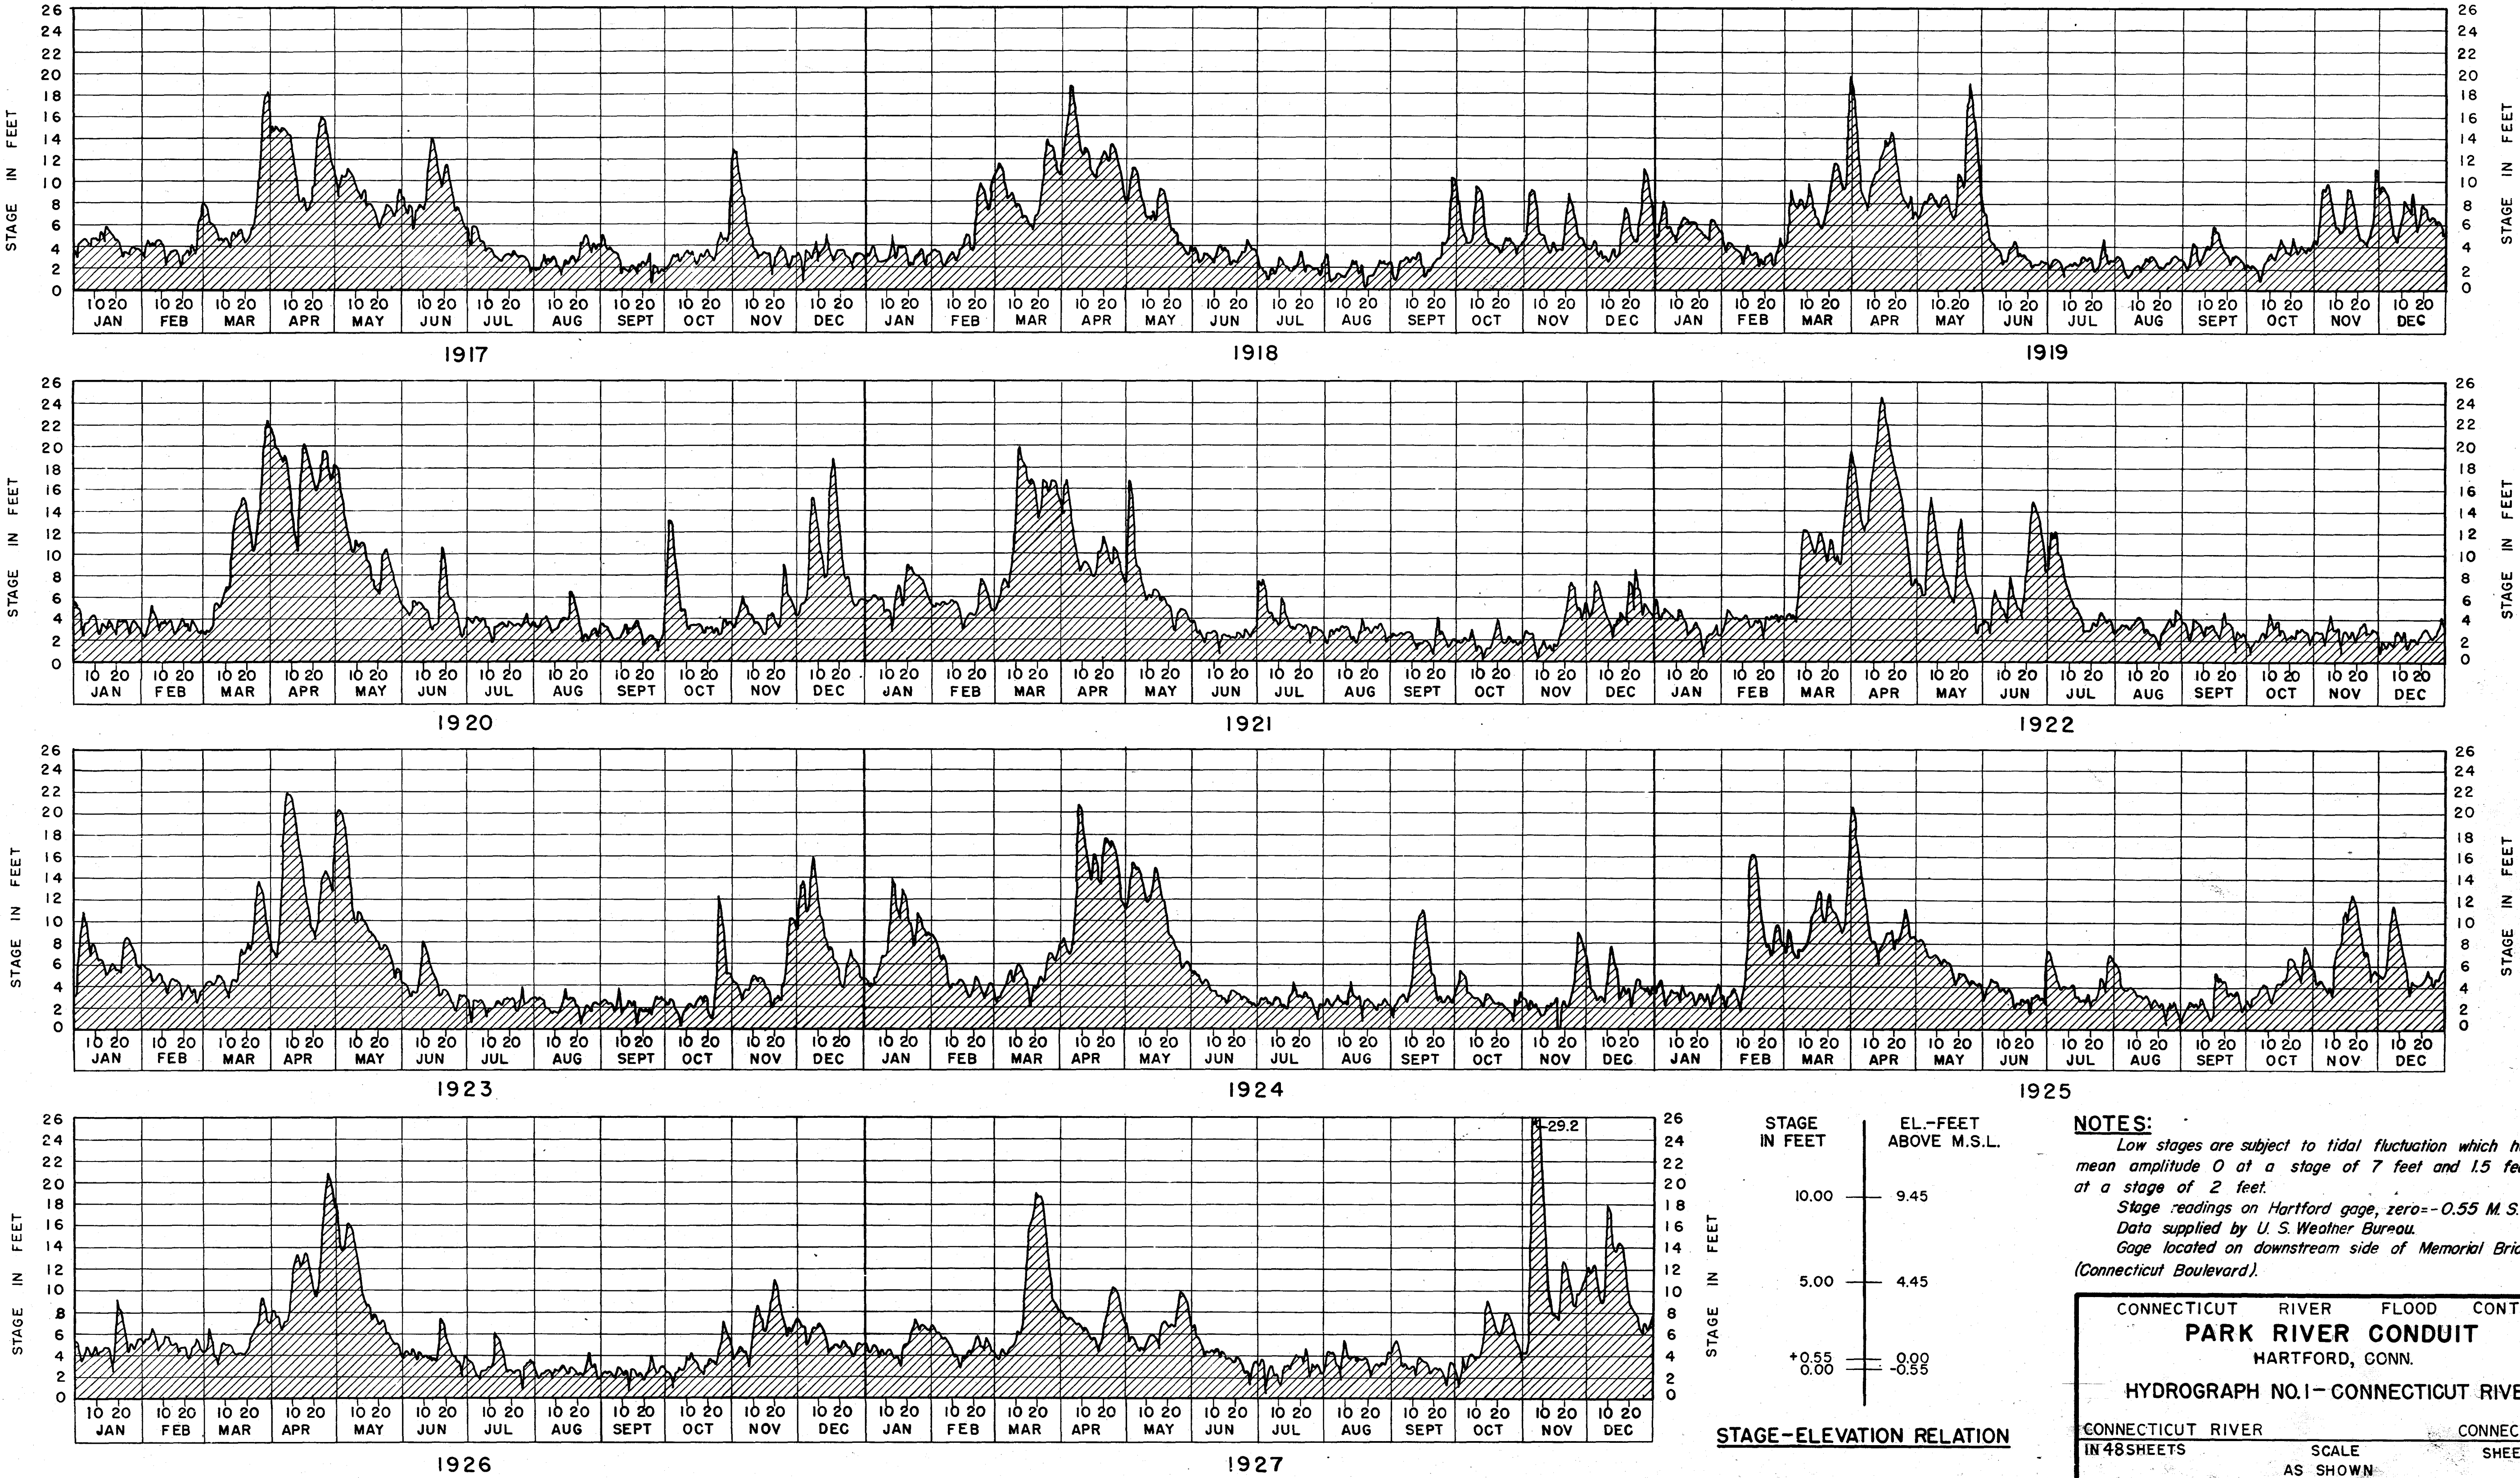

NOTES:
Low stages are subject to tidal fluctuation which has a mean amplitude 0 at a stage of 7 feet and 1.5 feet at a stage of 2 feet.
Stage readings on Hartford gage, zero=-0.55 M.S.L.
Data supplied by U. S. Weather Bureau.
Gage located on downstream side of Memorial Bridge (Connecticut Boulevard).

CONNECTICUT RIVER FLOOD CONTROL	
PARK RIVER CONDUIT	
HARTFORD, CONN.	
HYDROGRAPH NO.1- CONNECTICUT RIVER	
CONNECTICUT RIVER	CONNECTICUT
IN 48 SHEETS	SHEET NO. 2
SCALE AS SHOWN	
U.S. ENGINEER OFFICE, PROVIDENCE, R.I., MAY, 1940	
SUBMITTED: <i>John B. Drake</i>	APPROVED: <i>W. B. Burns</i>
ENGINEER	PRINCIPAL ENGINEER
HEAD, HYDRAULICS SECTION	CHIEF, F.C. ENGINEERING DIV.
COMPILED: <i>George W. White</i>	TRACED BY: P.J.G.
ASSOC. ENGINEER	CHECKED BY:
FISCAL YEAR 1940	
FILE NO. CT-3-1174	

RECORD
DRAWINGS

KEY	DATE	REVISION (Indicated by Δ)	REV.BY	CK.BY	AP.BY
	12-31-45	As built			