


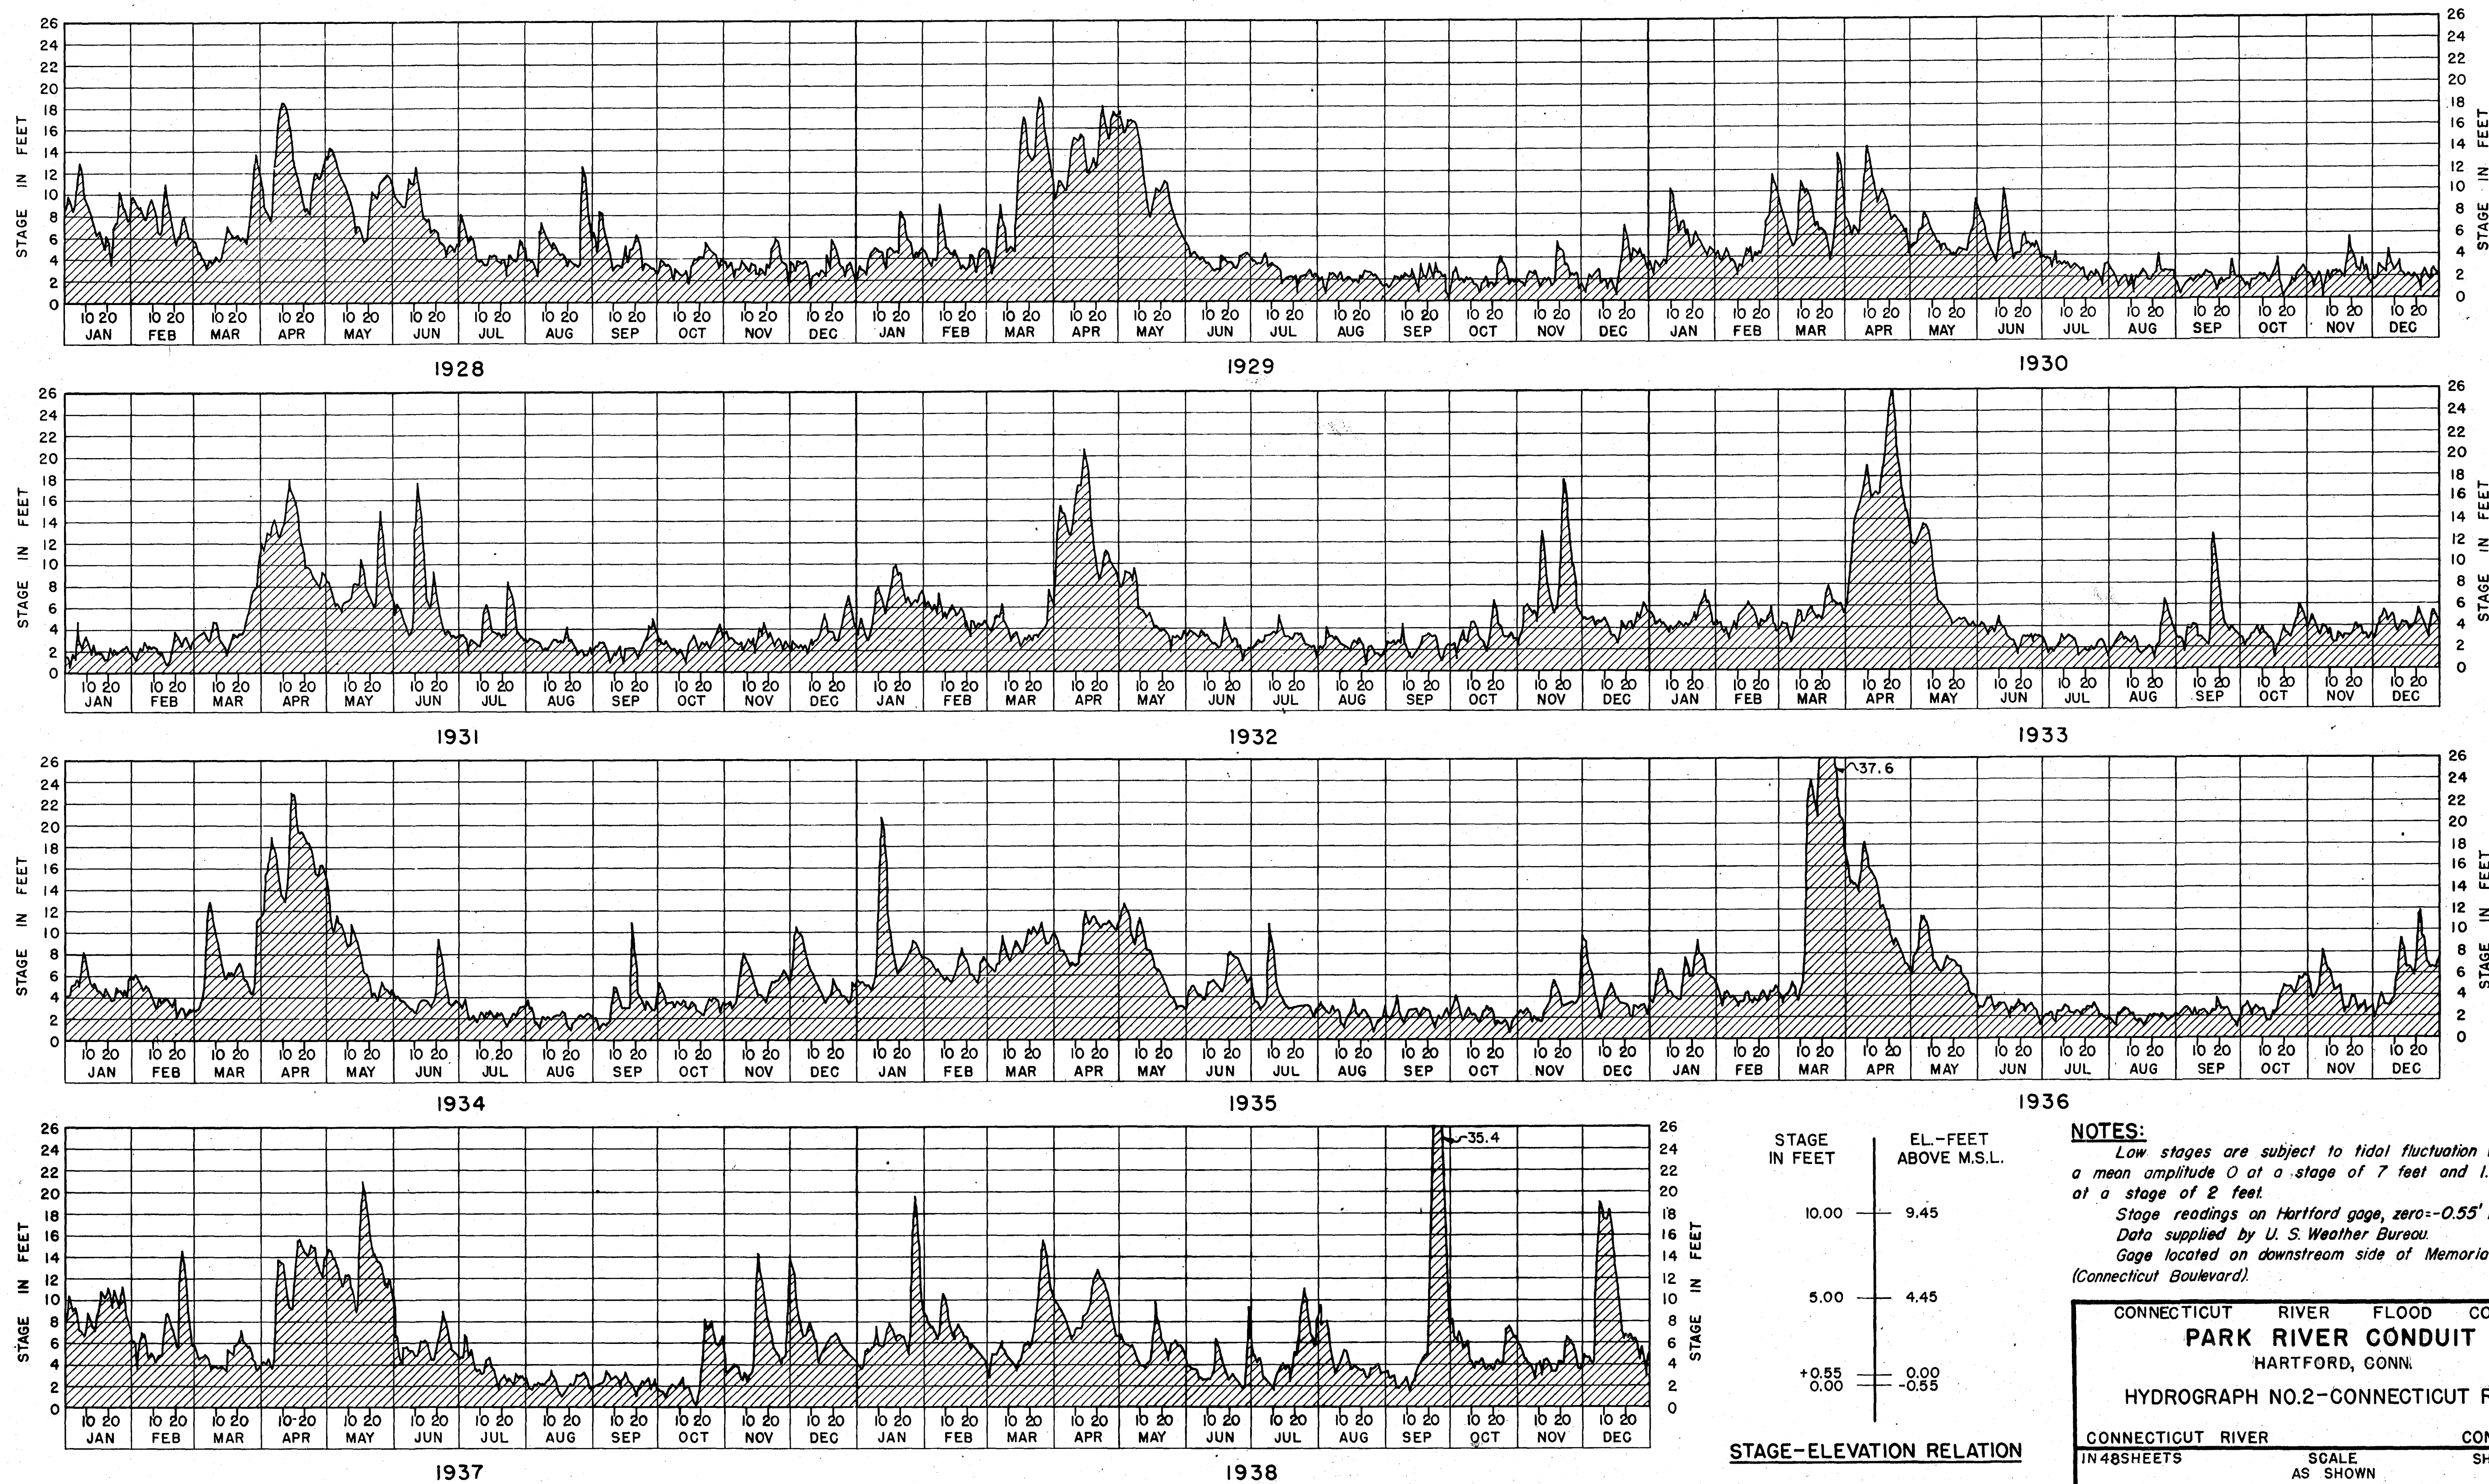

NOTES:

Low stages are subject to tidal fluctuation which has a mean amplitude 0 at a stage of 7 feet and 1.5 feet at a stage of 2 feet.

Stage readings on Hartford gage, zero = -0.55' M.S.L.

Data supplied by U. S. Weather Bureau.

Gage located on downstream side of Memorial Bridge (Connecticut Boulevard).

CONNECTICUT RIVER FLOOD CONTROL
PARK RIVER CONDUIT
HARTFORD, CONN.

HYDROGRAPH NO.2-CONNECTICUT RIVER

CONNECTICUT RIVER IN 48 SHEETS
SCALE AS SHOWN
CONNECTICUT SHEET NO. 3

U. S. ENGINEER OFFICE, PROVIDENCE, R.I., MAY 1940

SUBMITTED BY <i>John B. Davis</i> ENGINEER	APPROVAL <i>W. W. V. & F. C. T.</i> PRINCIPAL ENGINEER	RECOMMENDED BY <i>W. W. V. & F. C. T.</i> CHIEF, P. C. ENGINEERING DIV.	APPROVED BY <i>W. W. V. & F. C. T.</i> DISTRICT ENGINEER
COMPILED BY <i>W. W. V. & F. C. T.</i> ASSOC. ENGINEER	DRAWN BY <i>W. W. V. & F. C. T.</i> CHECKED BY <i>W. W. V. & F. C. T.</i>	FISCAL YEAR 1940 FILE NO. CT-3-1175	

RECORD
DRAWINGS

KEY	DATE	REVISION (Indicated by Δ)	REV. BY	CK. BY	AP. BY
	12-31-45	As built			