

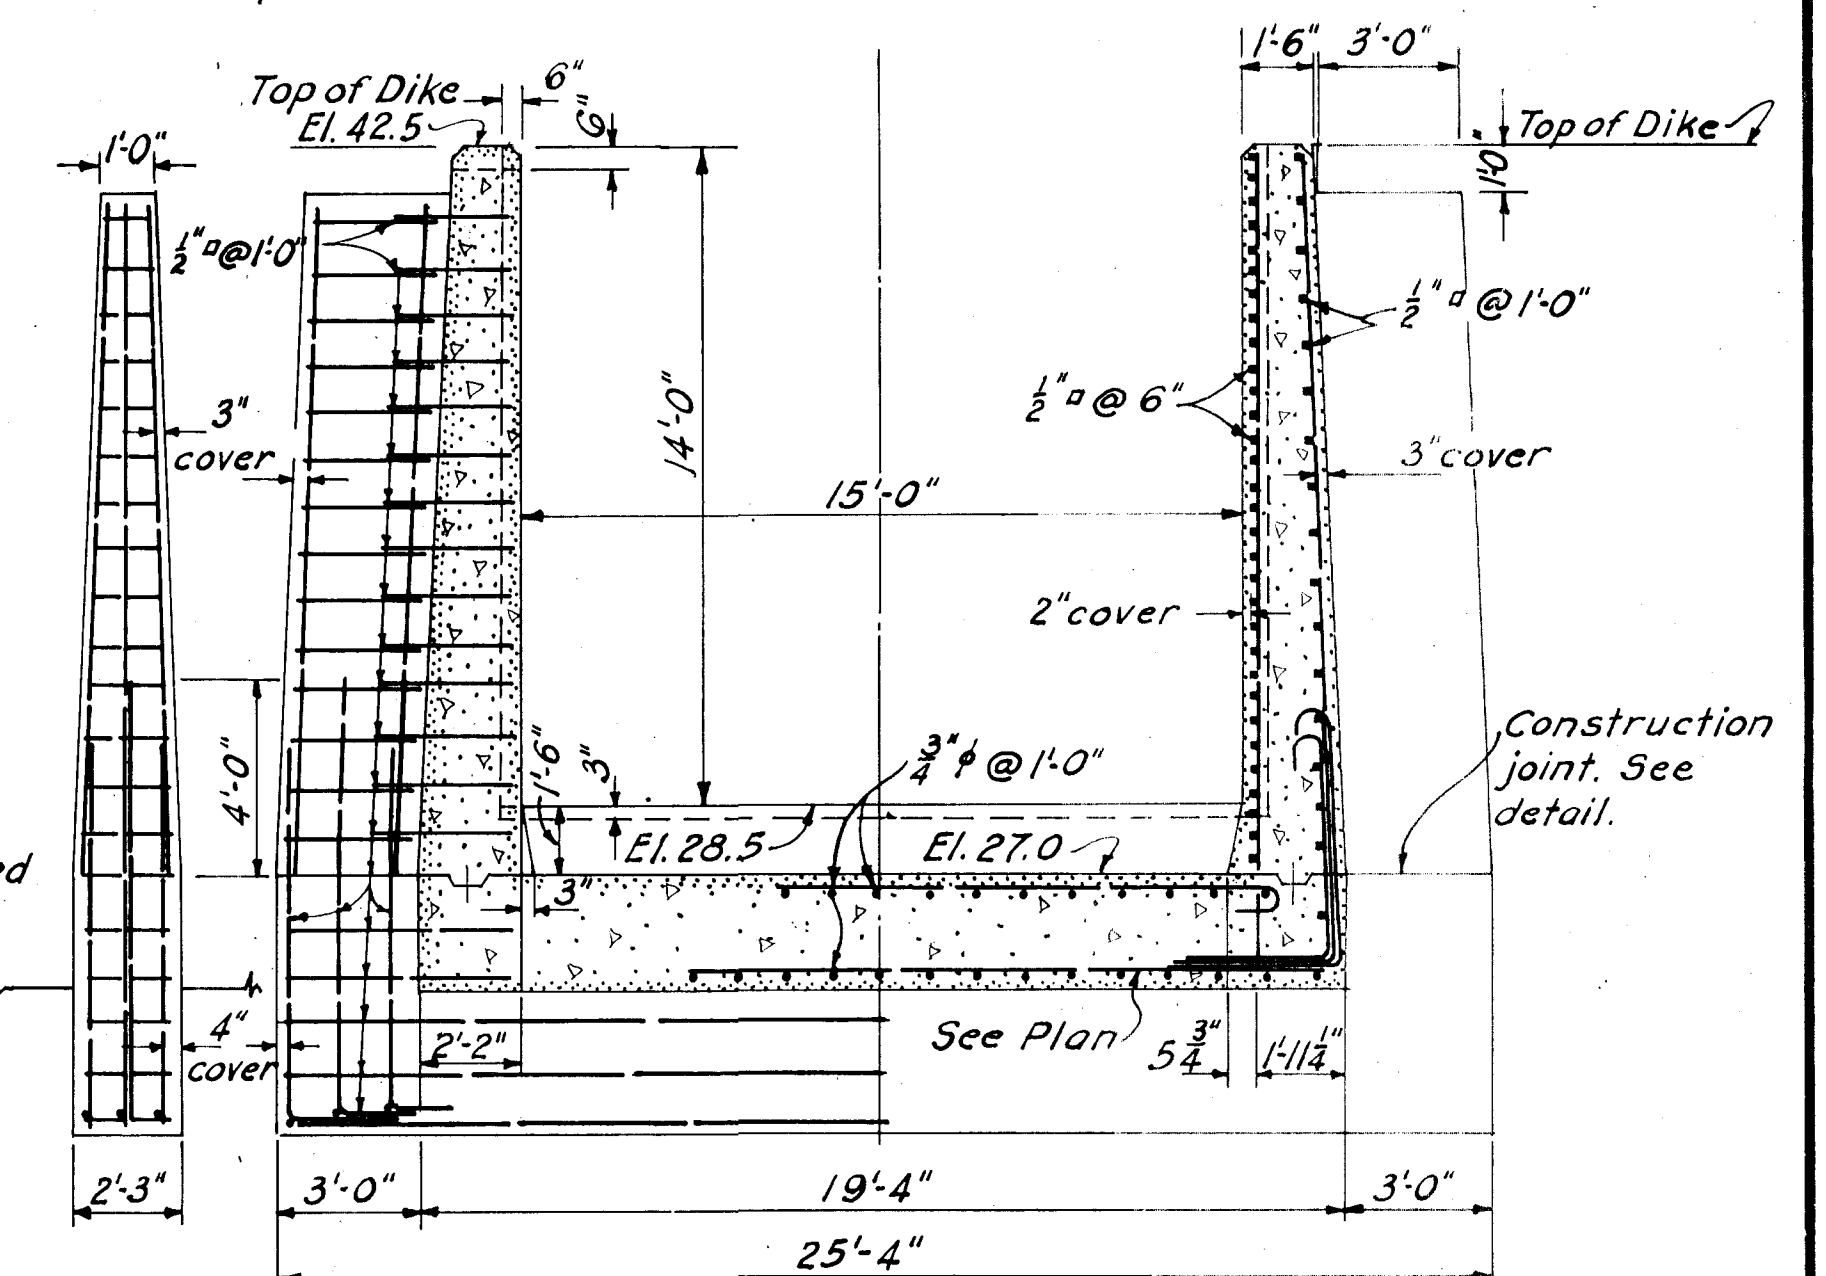


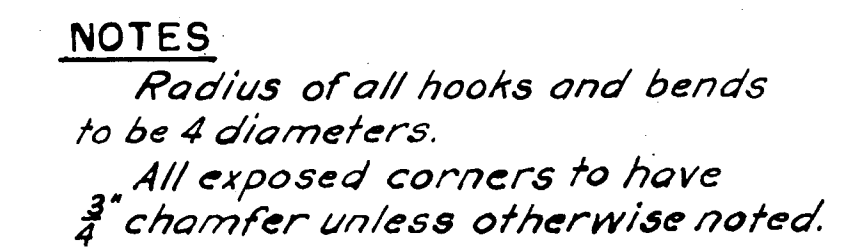


SECTION B-B

NOTE SCALE: $\frac{1}{4}$ "
All steel shown in this section
is symmetrical about center line

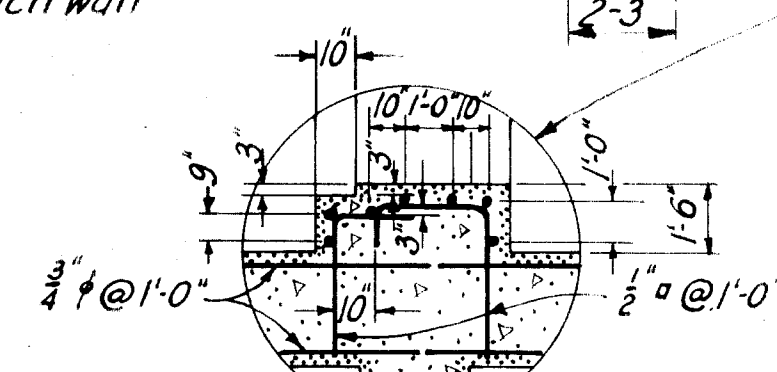


DETAIL OF STOP-LOG BASE

SCALE: $\frac{1}{4}'' = 1'-0''$

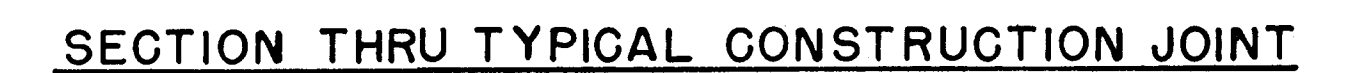

SCALE : 1" = 1'-0"

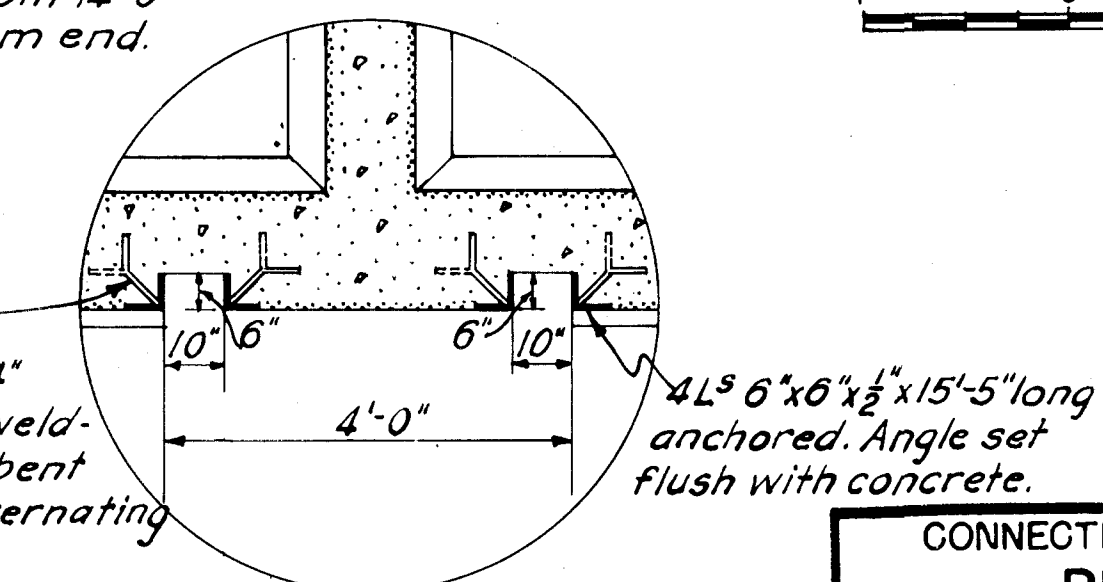

DETAIL OF LOG GROOVES

SCALE : $\frac{3''}{8} = 1'-0''$



PLAN OF STOP-LOG STRUCTURE

SCALE : $\frac{1}{4}'' = 1'-0''$

NOTE
Steel in base symmetrical about
both horizontal center lines.

TRACED FROM ORIGINAL SIGNED COPY ON FILE IN DISTRICT OFFICE					
	12-31-45	As built revisions			
	5-27-38	Base bars revised	W.E.R. J.A.O.	I.O.T.	T.S.B.
	5-20-38	Seep rings & shear keys revised	P.J.G.	I.O.T.	T.S.B.
	3-30-38	EN's, E's and dimensions added	H.P.J.	J.G.D.	T.S.B.
KEY	DATE	REVISION (Indicated by Δ)	REV BY	CK BY	AP BY

CONNECTICUT RIVER FLOOD CONTROL		
PROPOSED DIKE WORK HARTFORD, CONN.		
STOP-LOG STRUCTURE STA. 5+49.90 STEEL REINFORCEMENT		
CONNECTICUT RIVER		CONNECTICUT
IN 7 SHEETS	SCALE: 1/4 IN. = 1 FT.	SHEET NO. 4
U. S. ENGINEER OFFICE, PROVIDENCE, R.I., FEB. 1938		
SUBMITTED: <i>T.S. Burns</i> PRINCIPAL ENGINEER CHIEF ENGINEERING SECTION	APPROVAL RECOMMENDED: <i>R.E. York</i> CAPT. CORPS OF ENGRS DISTRICT ENGINEER	APPROVED: <i>J.S. Bragdon</i> LT COL. CORPS OF ENGINEERS DISTRICT ENGINEER
DESIGNED: <i>J.G. Dingwall</i> ASST. ENGINEER	DRAWN: H. J. P. TRACED: A. G. T. CHECKED: J. G. P. Jr.	FILE NO. CT-4-3898 TO ACCOMPANY SPECIFICATIONS DATED FEB. 24, 1938