
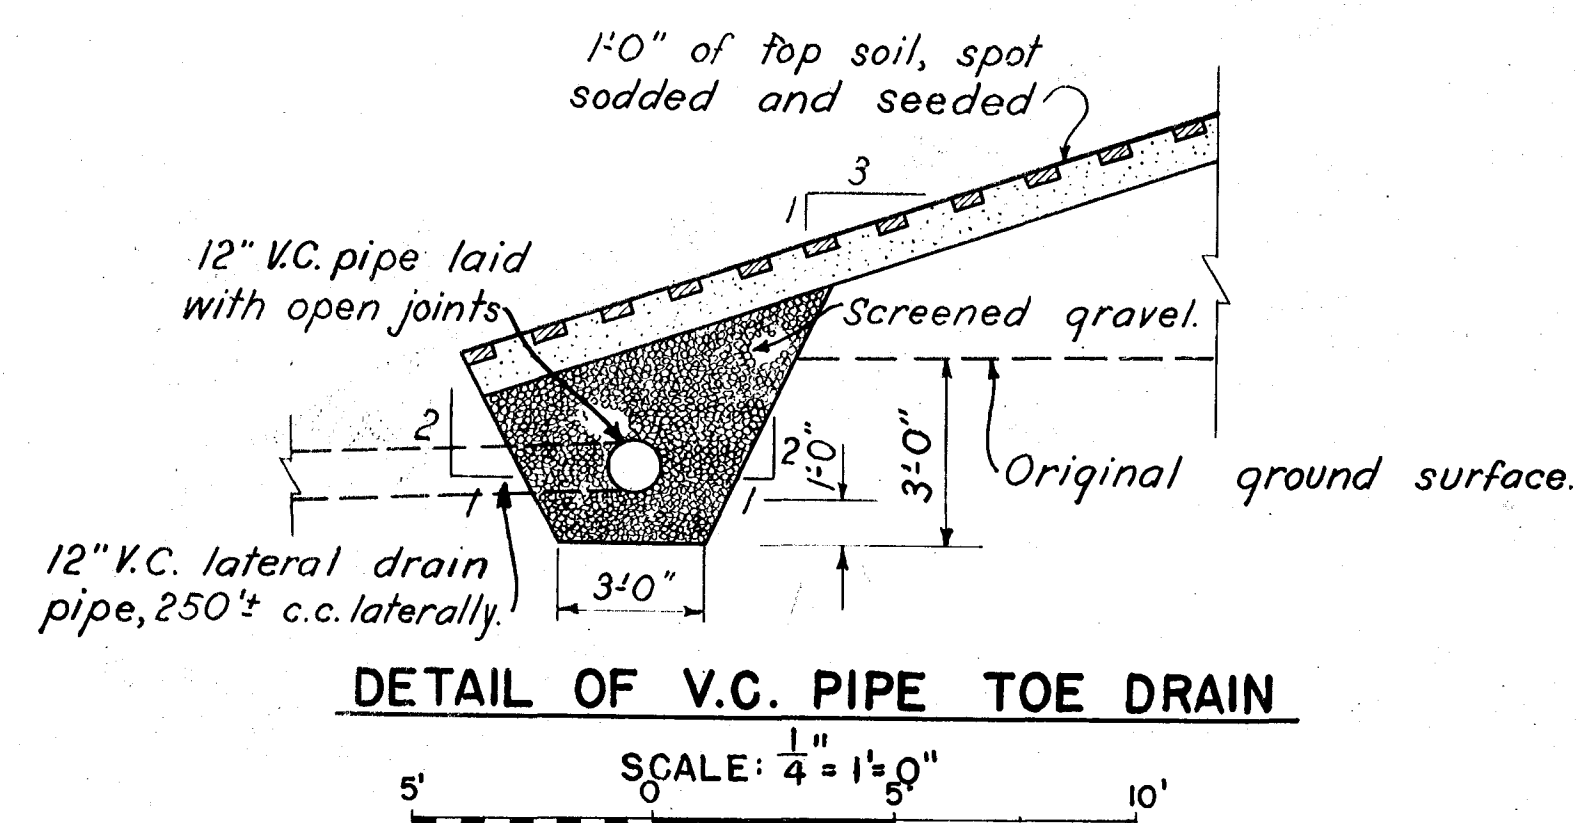
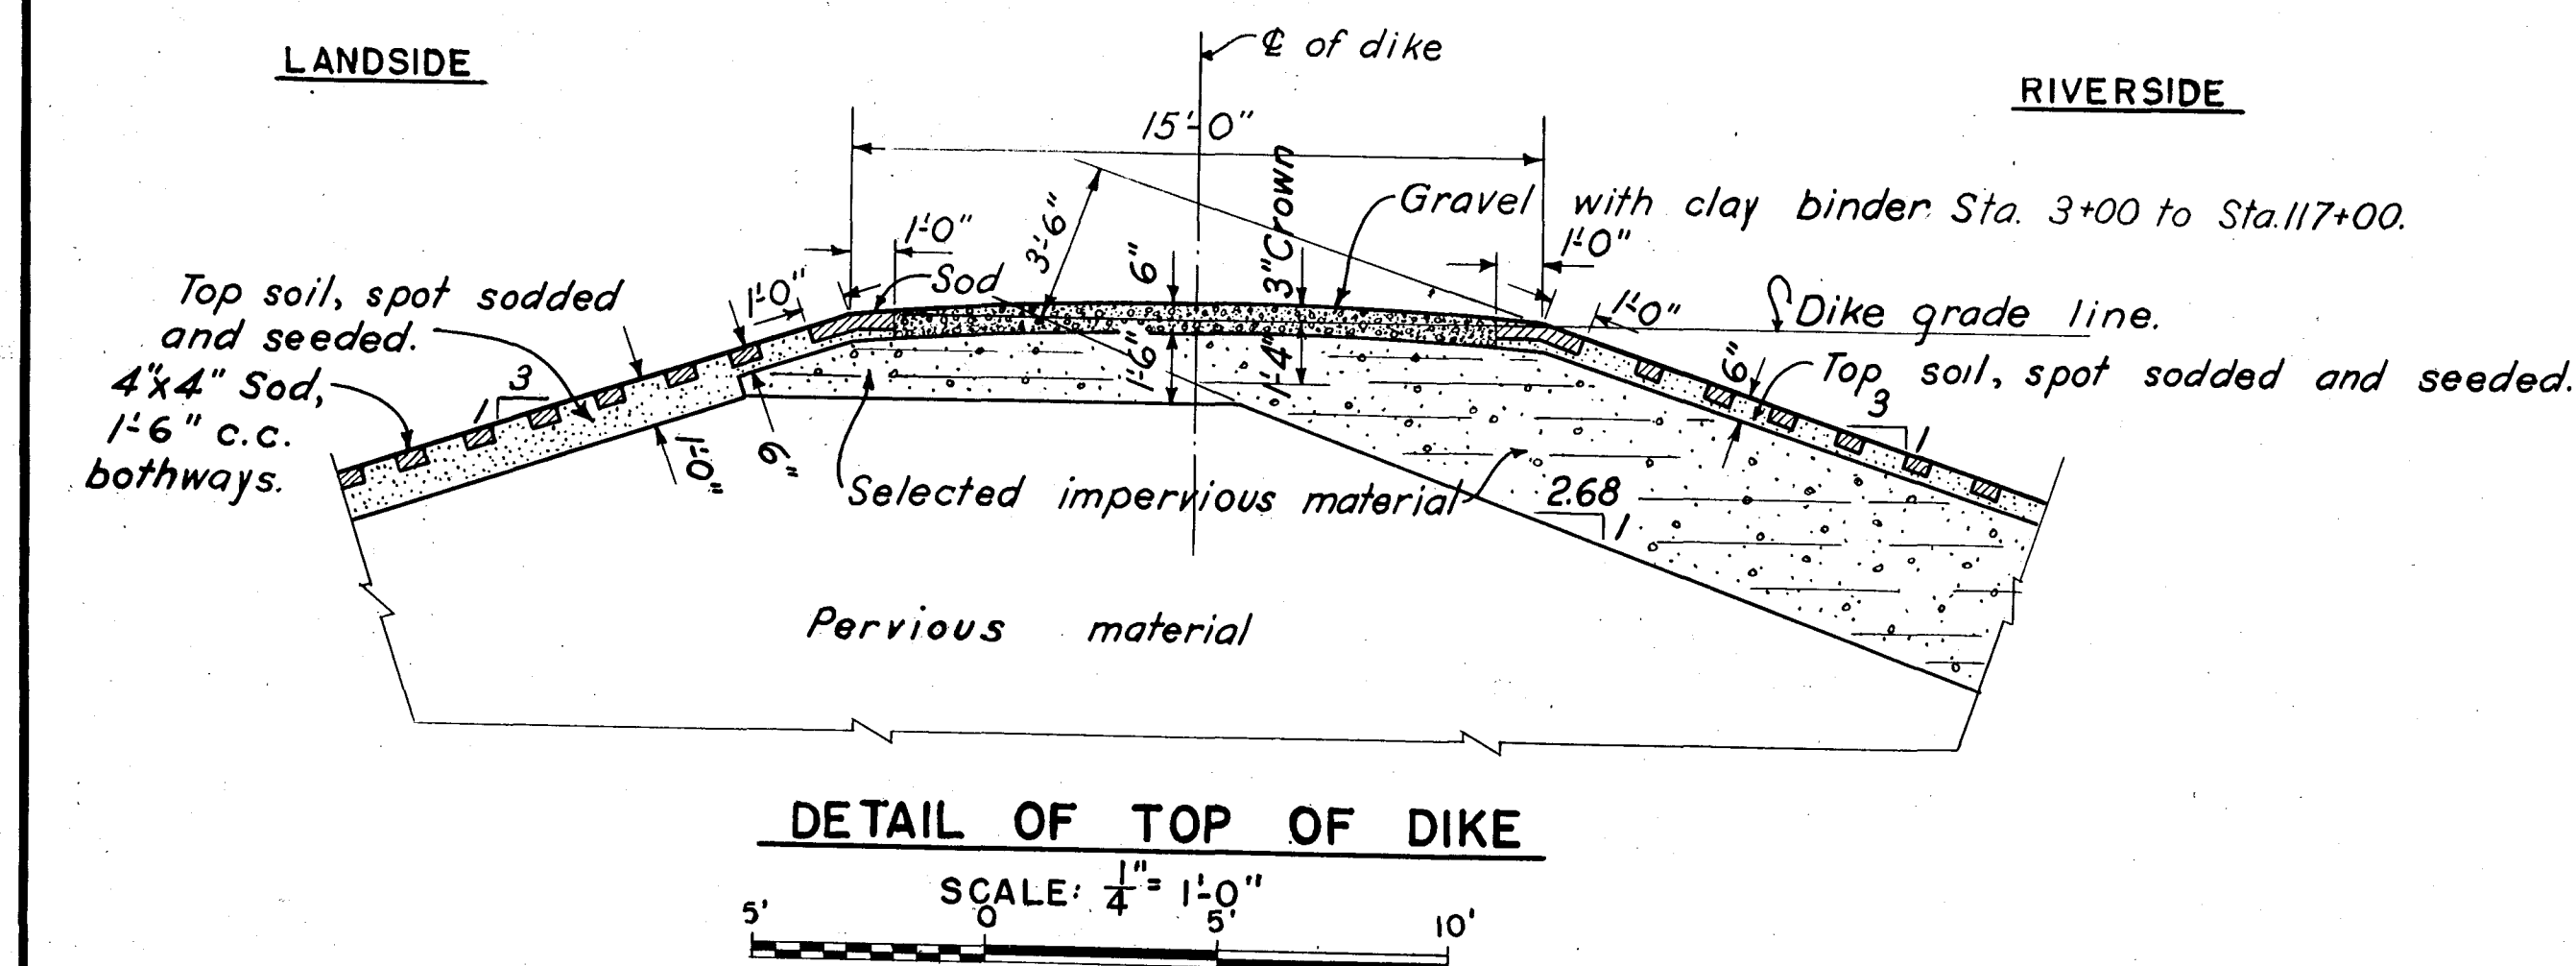
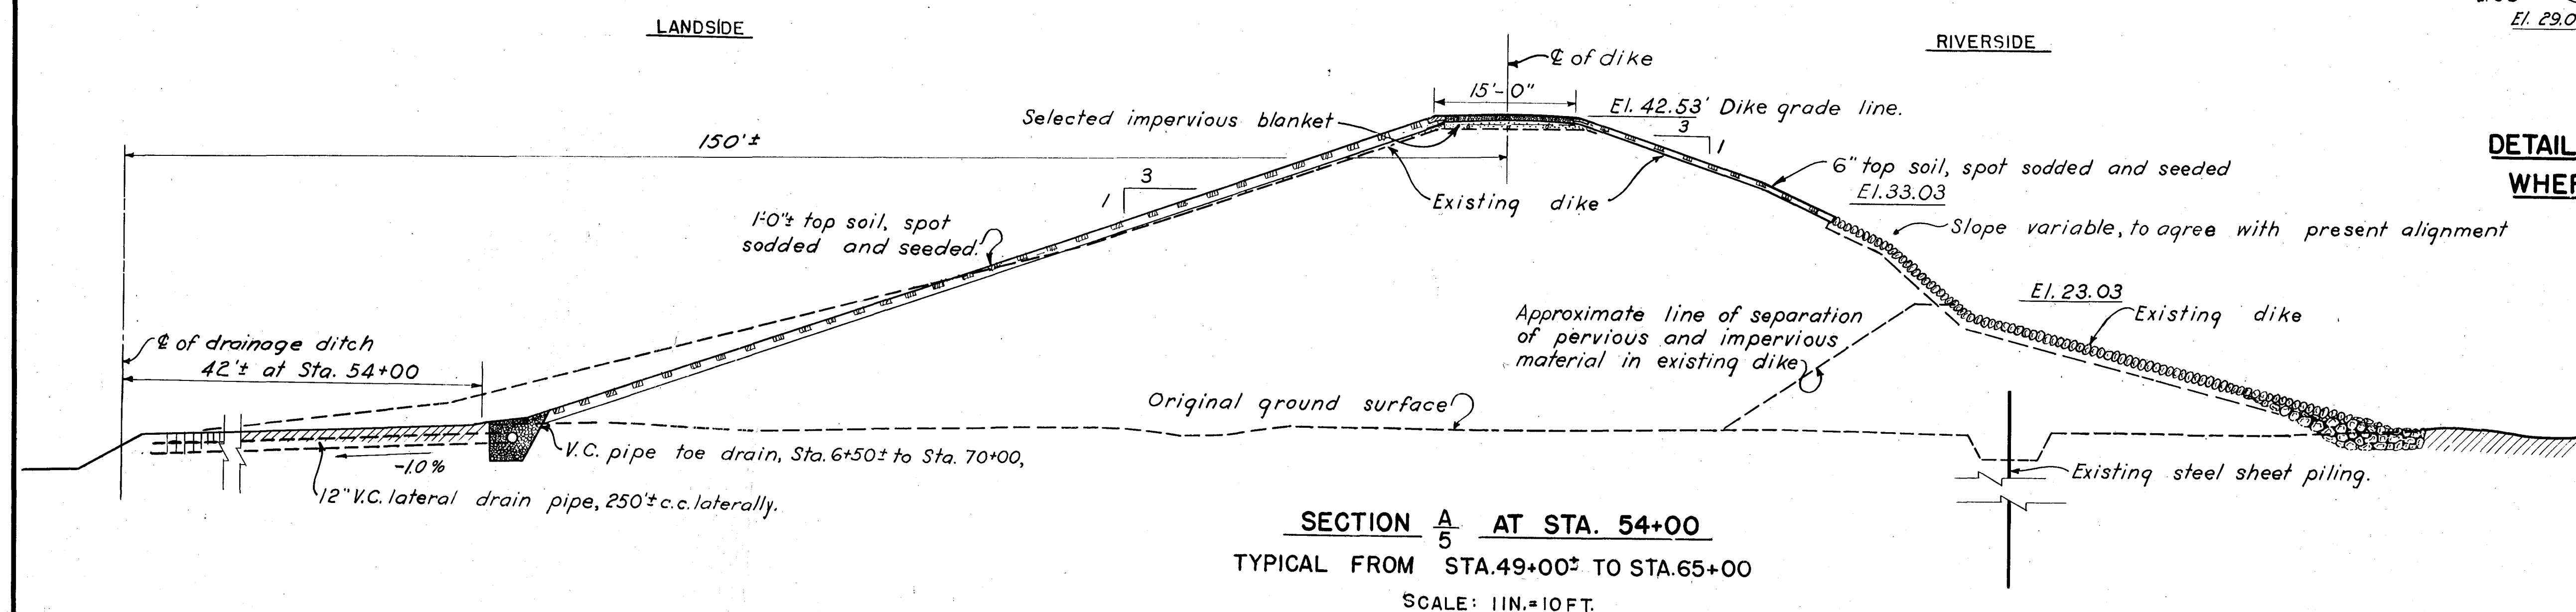


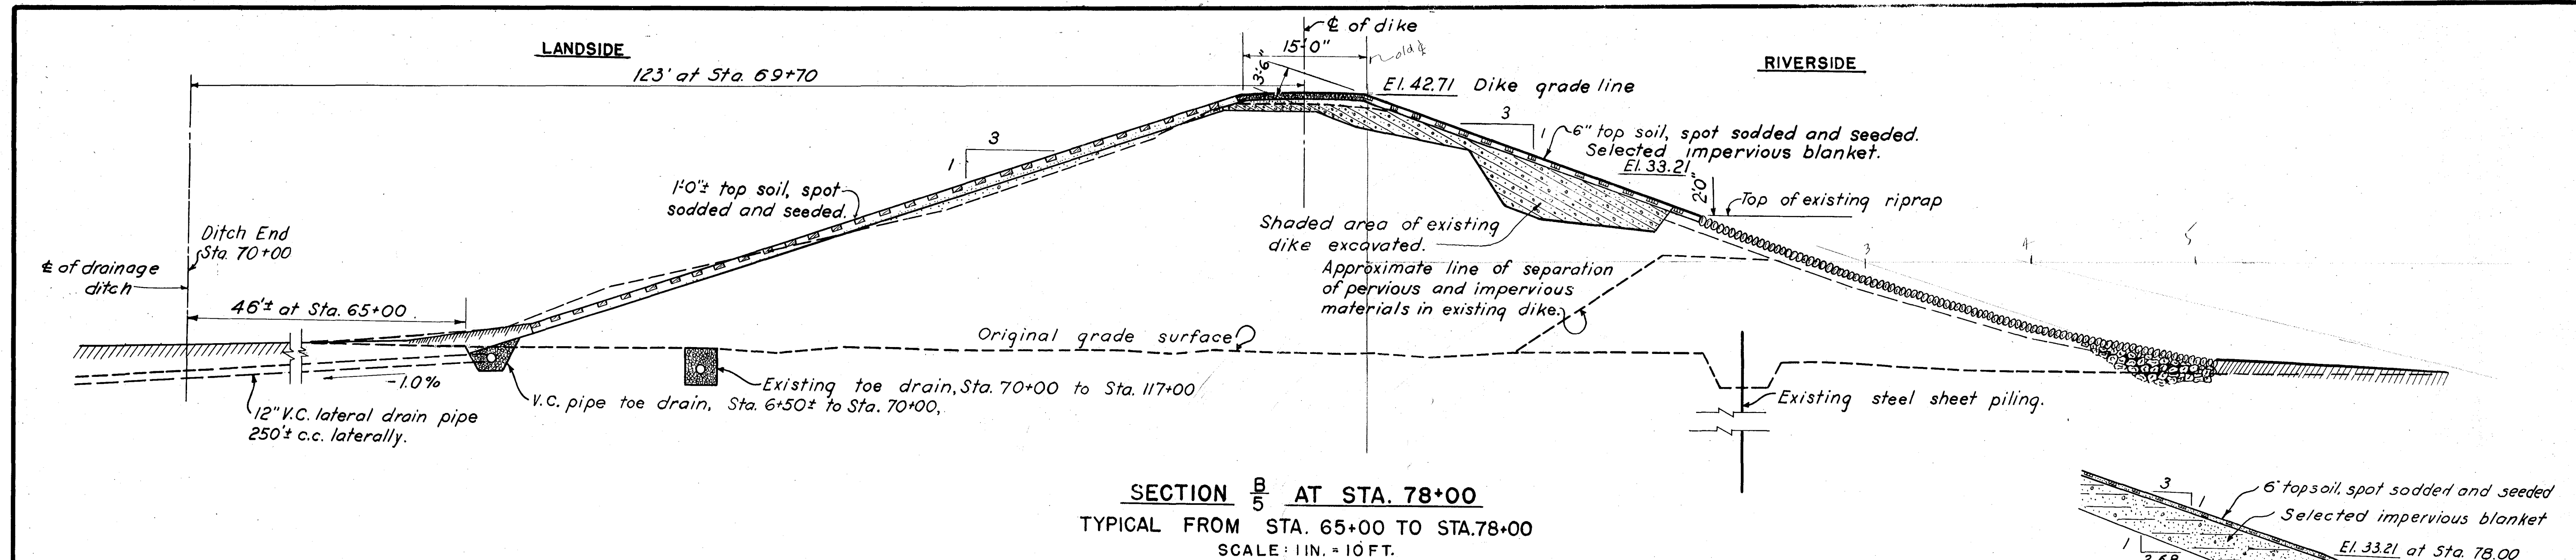

NOTES

Elevations refer to Mean Sea level datum.
For general plan see Sheet No. 3.
Existing 6" layer of top soil from sta. 78+00 to sta. 117+00 adequate. This section to be repaired only.
For profile of drainage ditch and toe drain trench see Sheet No. 8.

12-31-45	As built revisions			
3-27-39	IMPERV. BLANKET THICKNESS MODIFIED	J.S.	H.B.N.	J.S.
3-6-39	REVISED DRAINAGE DETAILS	J.S.	J.S.	J.S.
DATE	REVISION	REV. BY	CK. BY	AP. BY

CONNECTICUT RIVER FLOOD CONTROL			
CLARK DIKE			
REPAIR & COMPLETION FROM STA. 3+00 TO 117+00			
TYPICAL SECTIONS AND DETAILS			
HARTFORD, CONNECTICUT			
CONNECTICUT RIVER,	CONNECTICUT		
IN 9 SHEETS	SCALE: 1 IN. = 10 FT.	SHEET NO. 5	
U. S. ENGINEER OFFICE, PROVIDENCE, R. I., DEC. 1938			
SUBMITTED:	APPROVAL RECOMMENDED:	APPROVED:	
HEAD, DESIGN SECTION	CHIEF, F.C. ENGINEERING DIV.	DISTRICT ENGINEER	
DESIGNED BY J.S.	DRAWN BY F.F.C.	FILE NO. CT-4-1240	
CHECKED BY J.S.	CHECKED BY J.S.	TO ACCOMPANY SPECIFICATIONS DATED DEC. 15, 1938	