

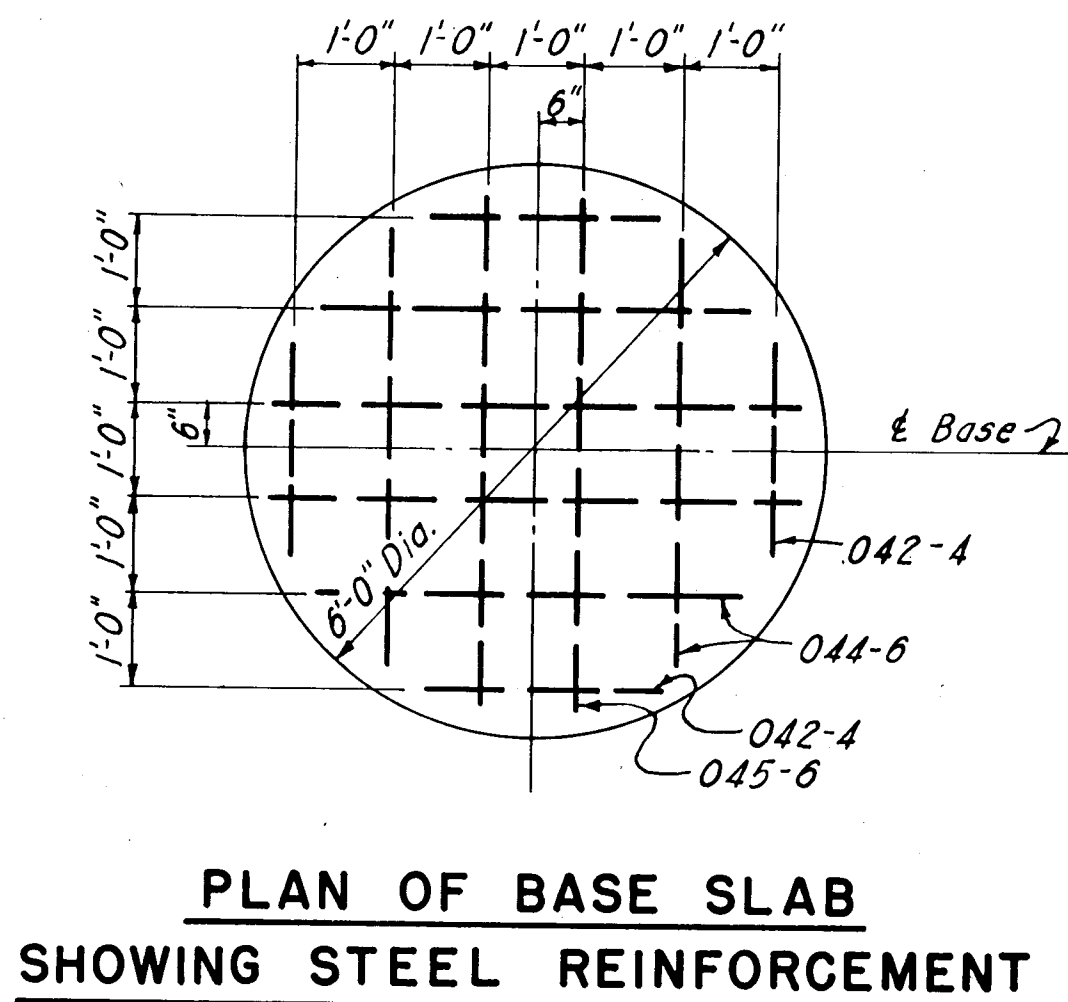
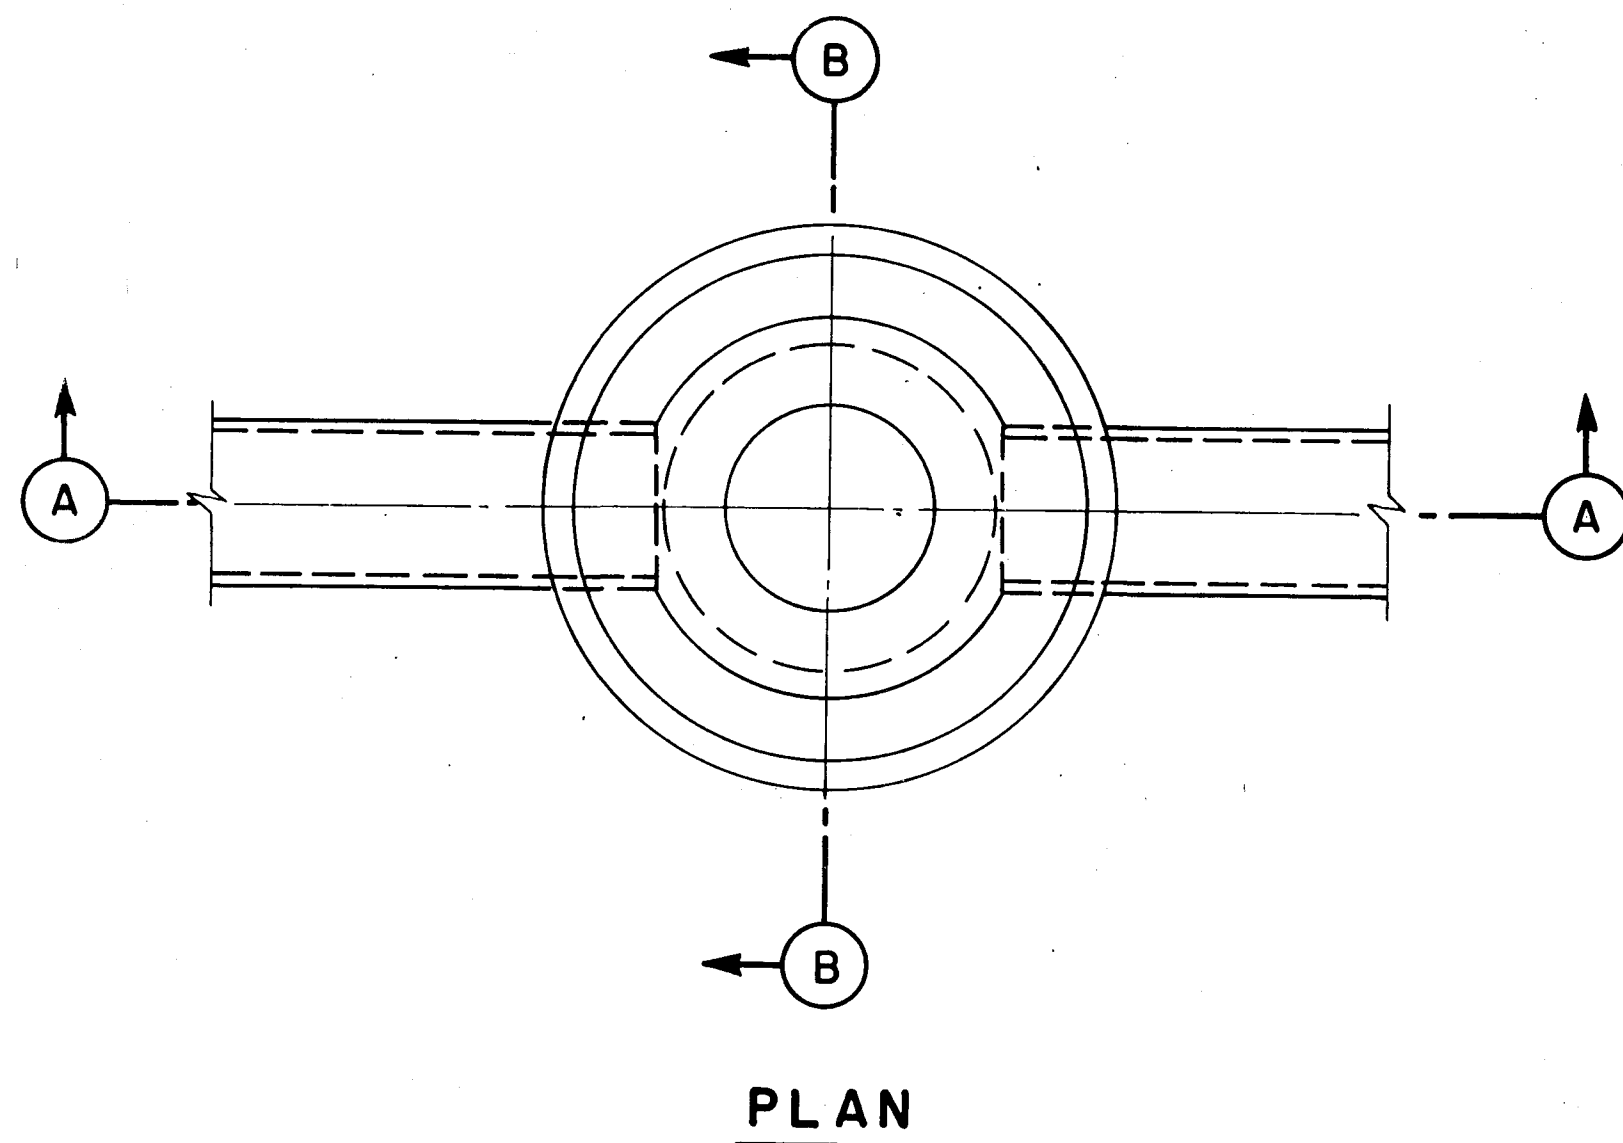


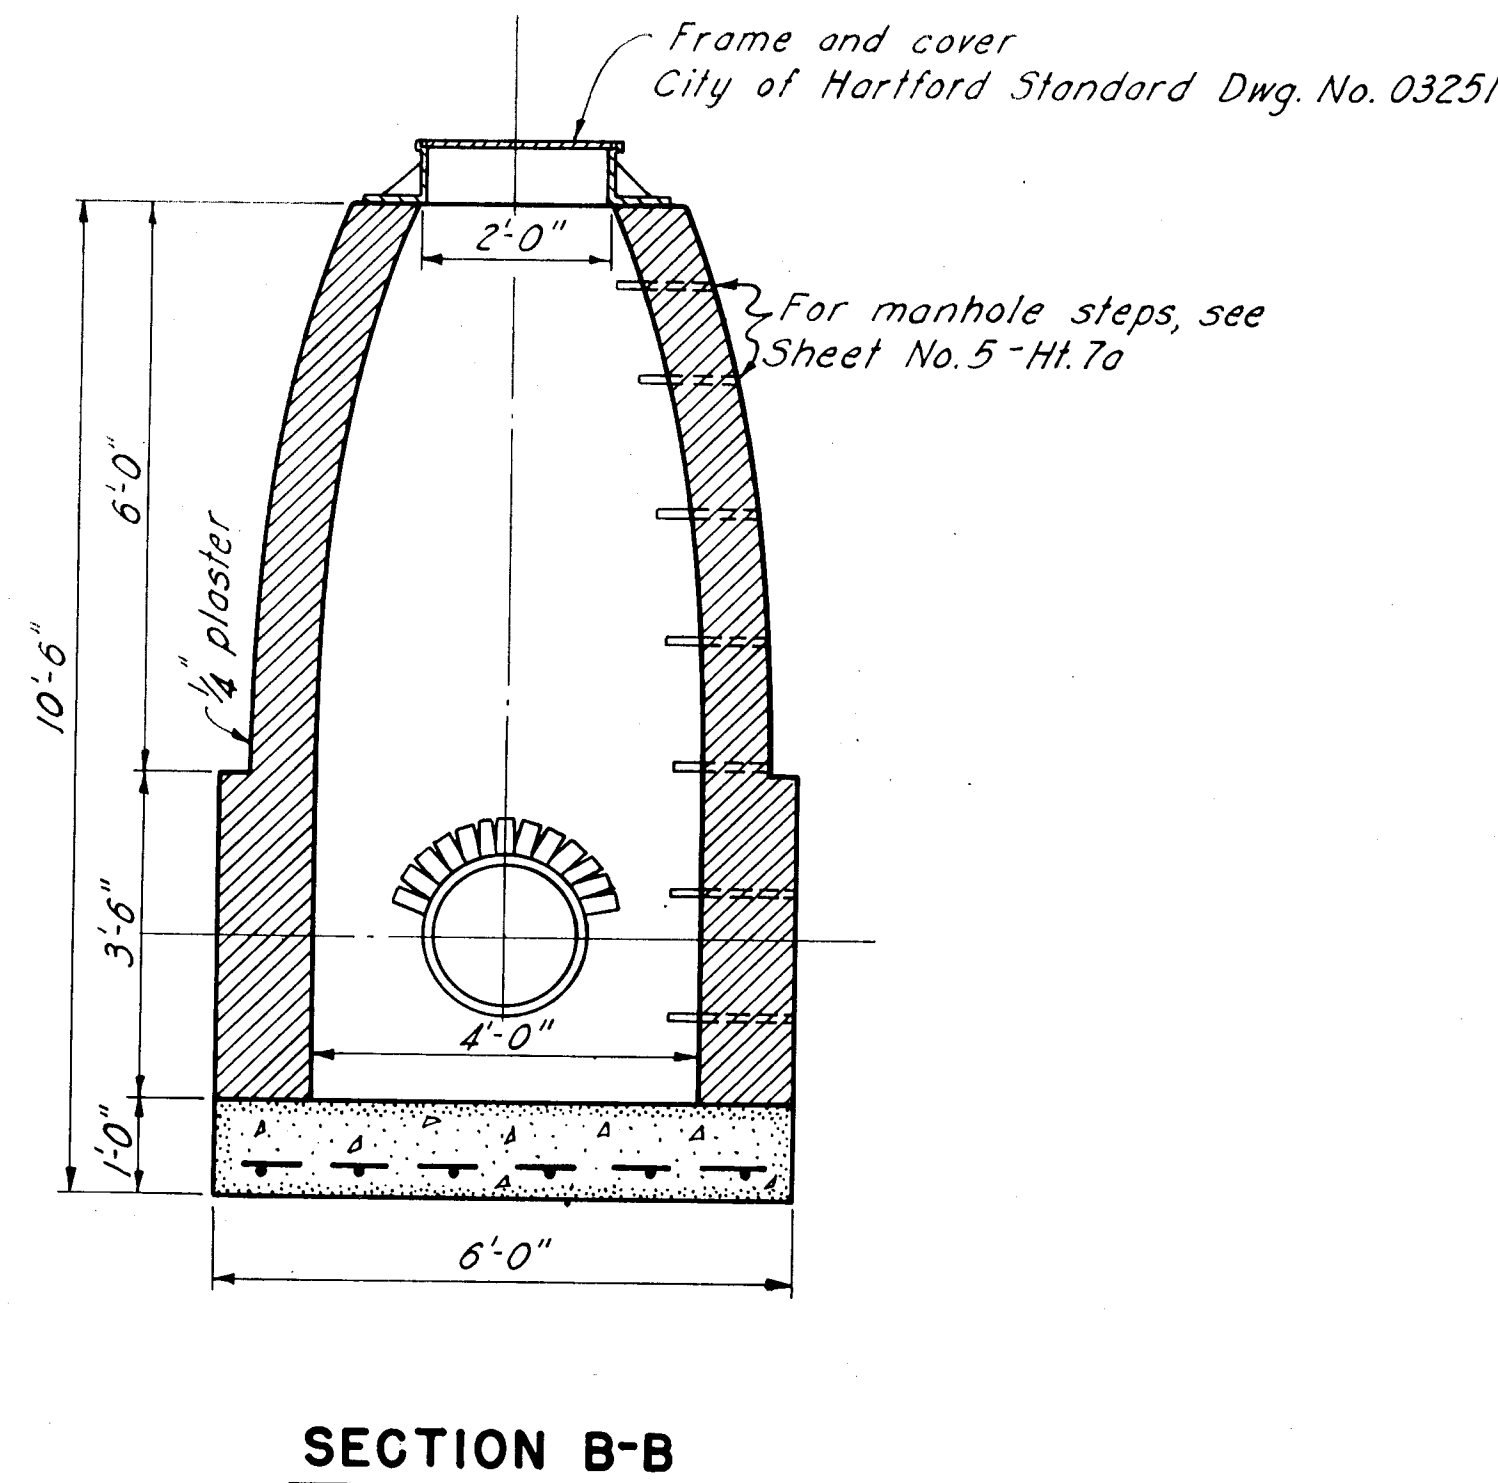

REINFORCEMENT SCHEDULE							
TYPE	SIZE	LENGTH	BENDING DIAGRAM	NO. REQ'D	WGT. EACH	TOTAL BAR WT.	REMARKS
042-4	1/2" ϕ	2'-4"	Straight	8	1.56	12.48	Base slab
044-6	1/2" ϕ	4'-6"	do	8	3.01	24.08	do
045-6	1/2" ϕ	5'-6"	do	8	3.67	29.36	do

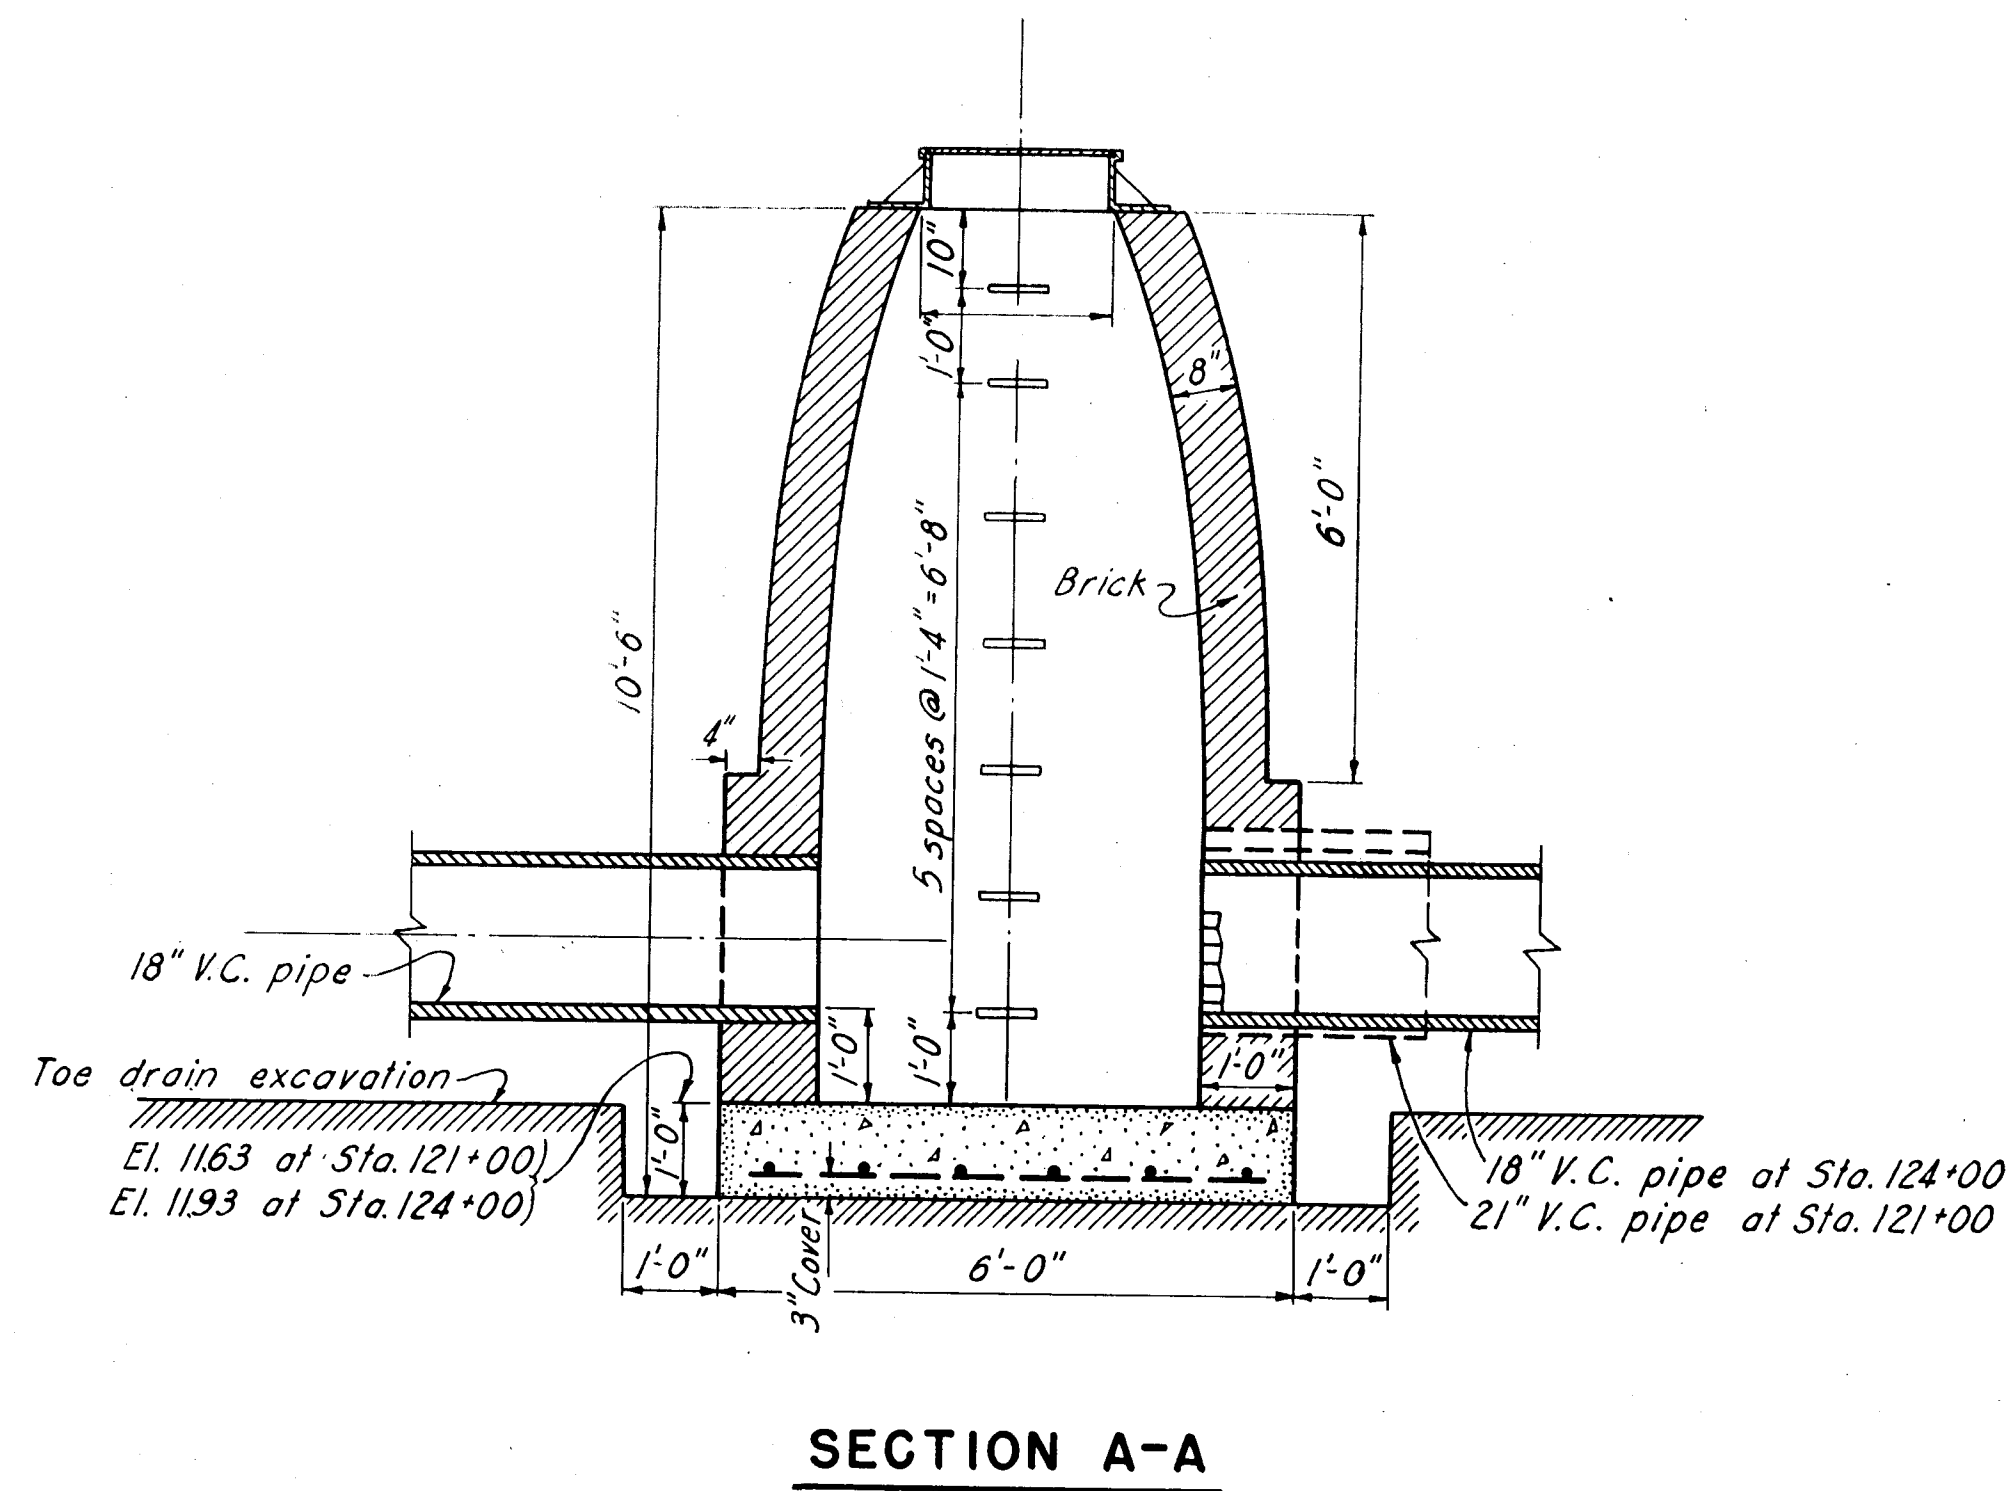

NOTES

Elevations refer to Mean Sea Level Datum.
All concrete shown on this sheet shall be Class "A".
Manhole as shown is at Sta. 124+00.
Manhole at Sta. 121+00 same as shown except as noted.
Manhole frame and cover to be standard as shown on City of Hartford Dwg. No. 03251.
This sheet supersedes "Details of Manholes" shown on Sheet No. 5.

	12/31/45	As built				
KEY	DATE	REVISION (Indicated by Δ)	REV. BY	CHK. BY	AP. BY	

THIS SHEET ADDED TO SET 12-31-45

CONNECTICUT RIVER FLOOD CONTROL

CLARK DIKE

AVIATION ROAD - 900 FEET NORTH

REVISED MANHOLE DETAILS

HARTFORD, CONN.

CONNECTICUT RIVER

IN 7 SHEETS

SCALE: 1/2" = 1 FT.

SHEET NO. 6

U. S. ENGINEER OFFICE, PROVIDENCE, R. I., OCT. 1939

PREPARED BY AREA OFFICE

EAST HARTFORD, CONN.

FILE NO. CT-4-3576