



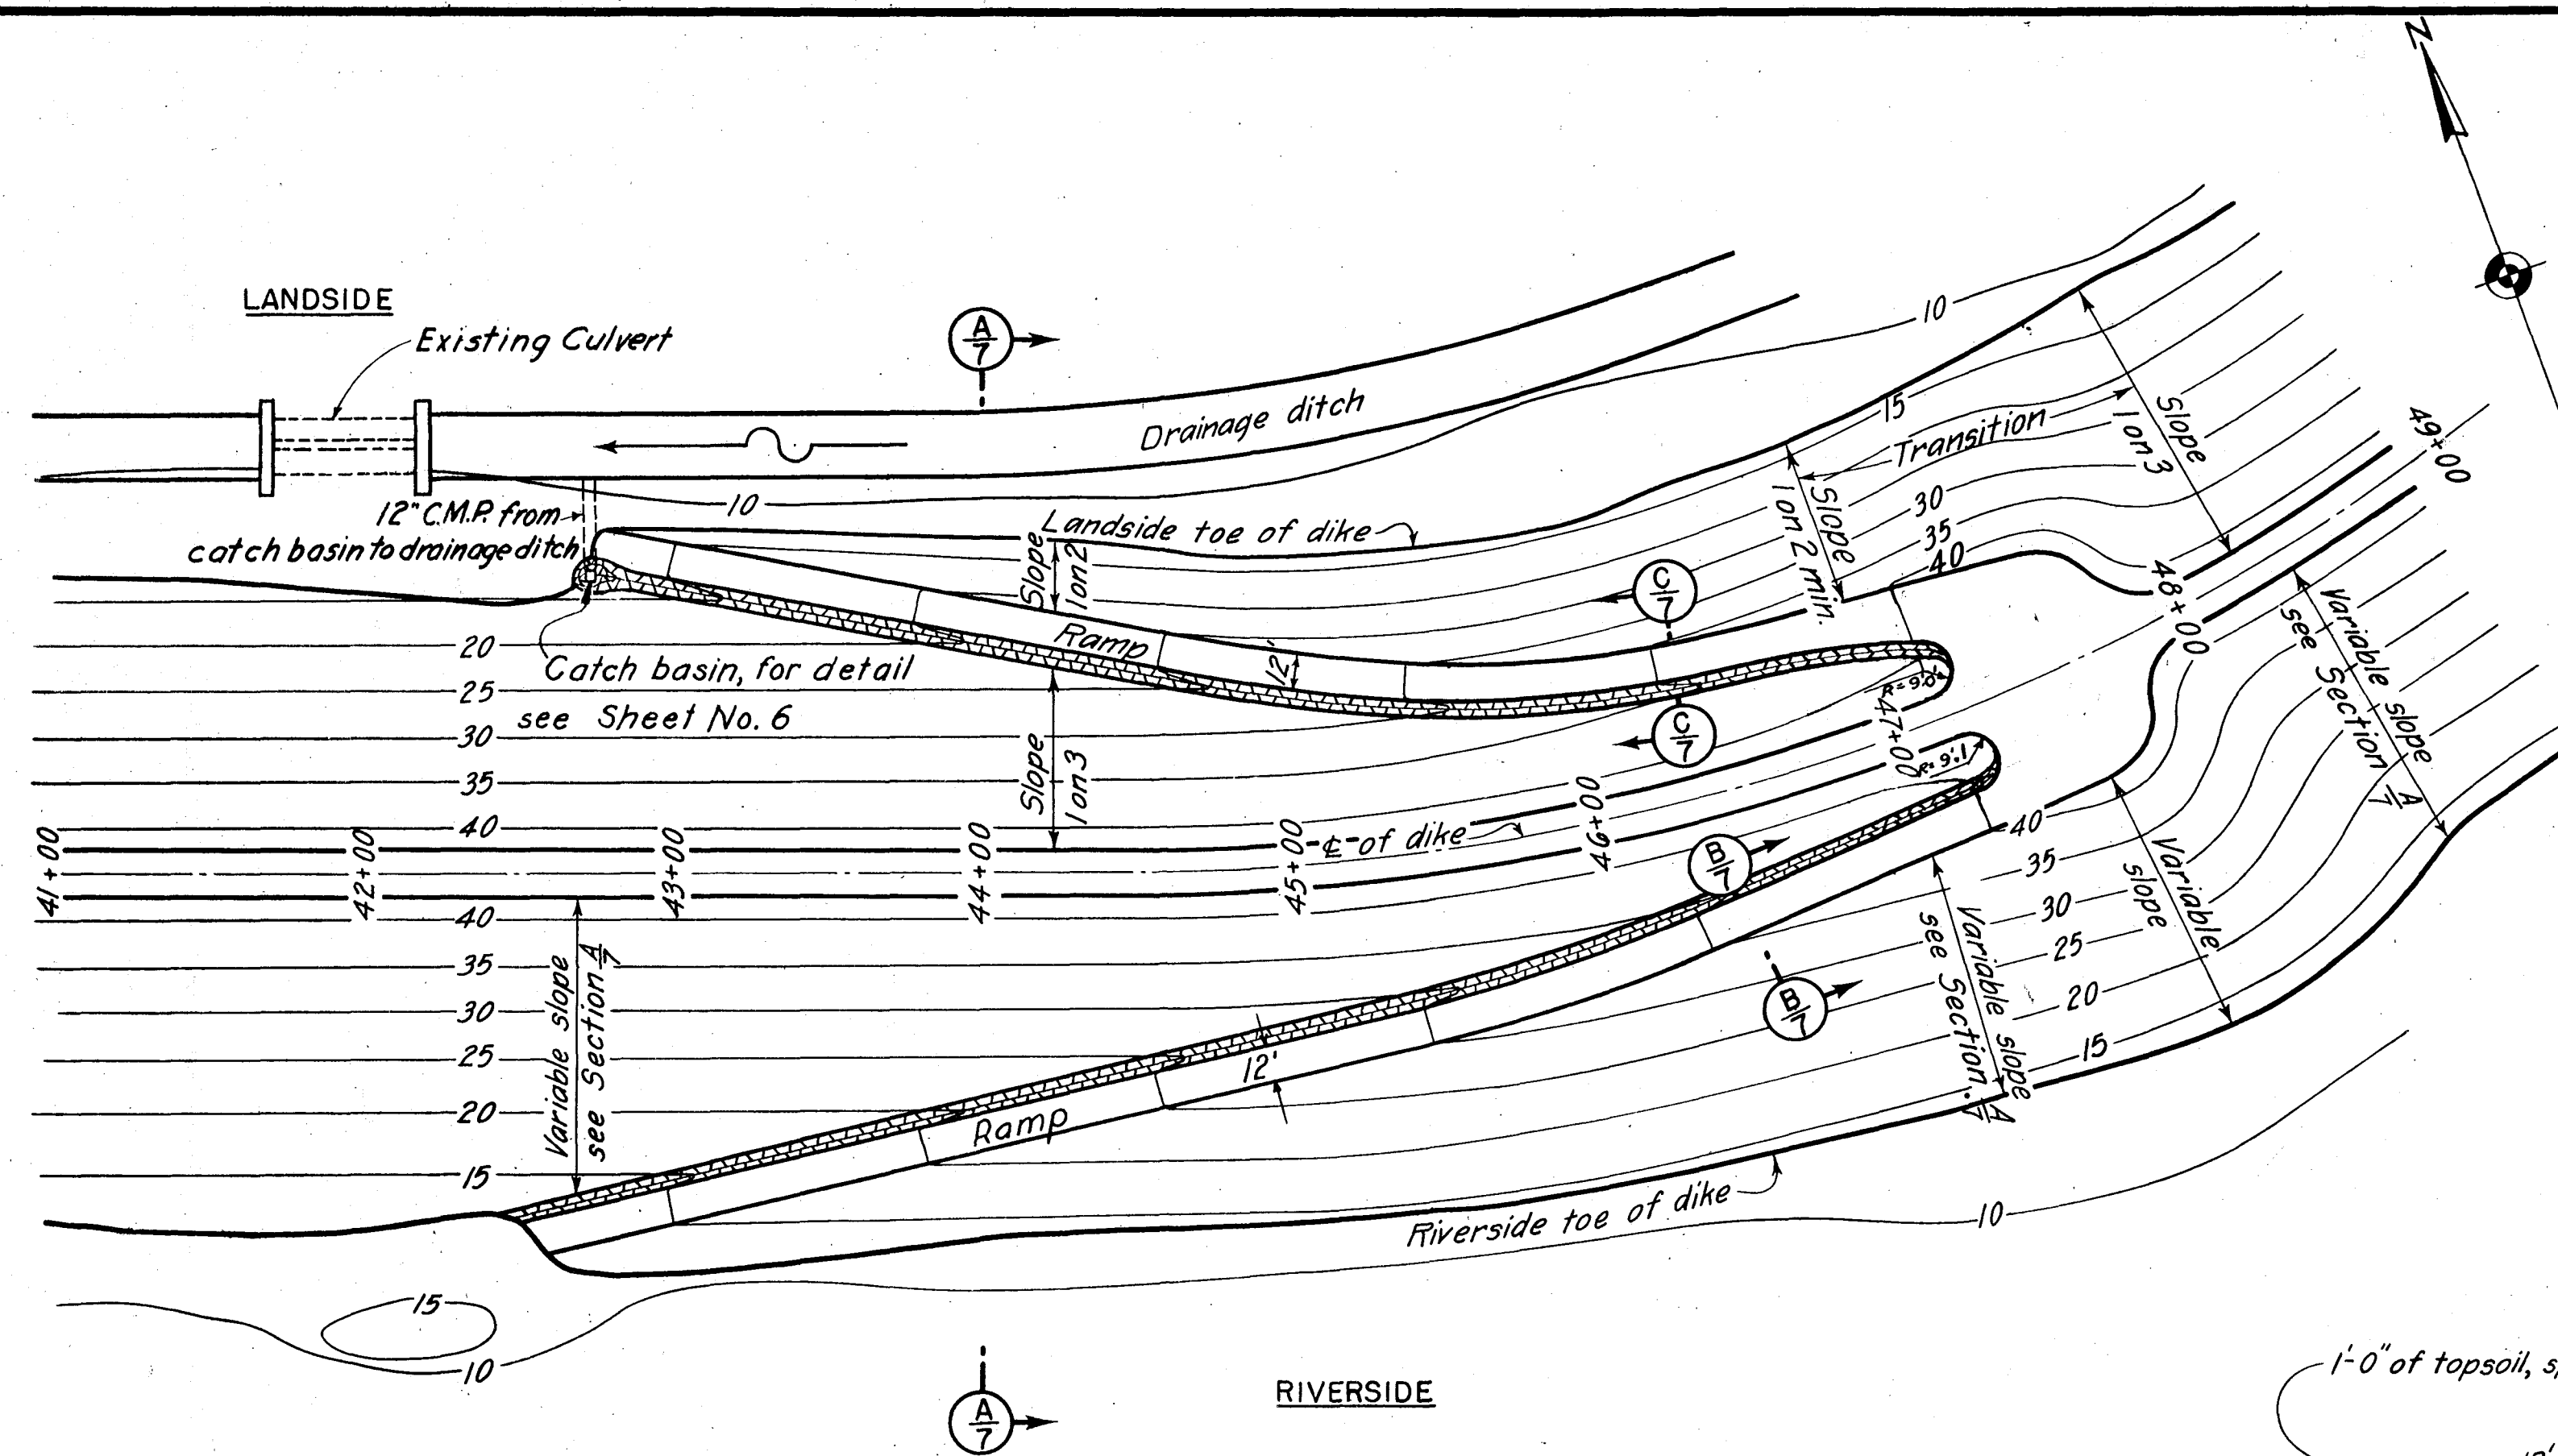

PLAN OF RAMPS


SCALE: 1" = 50'

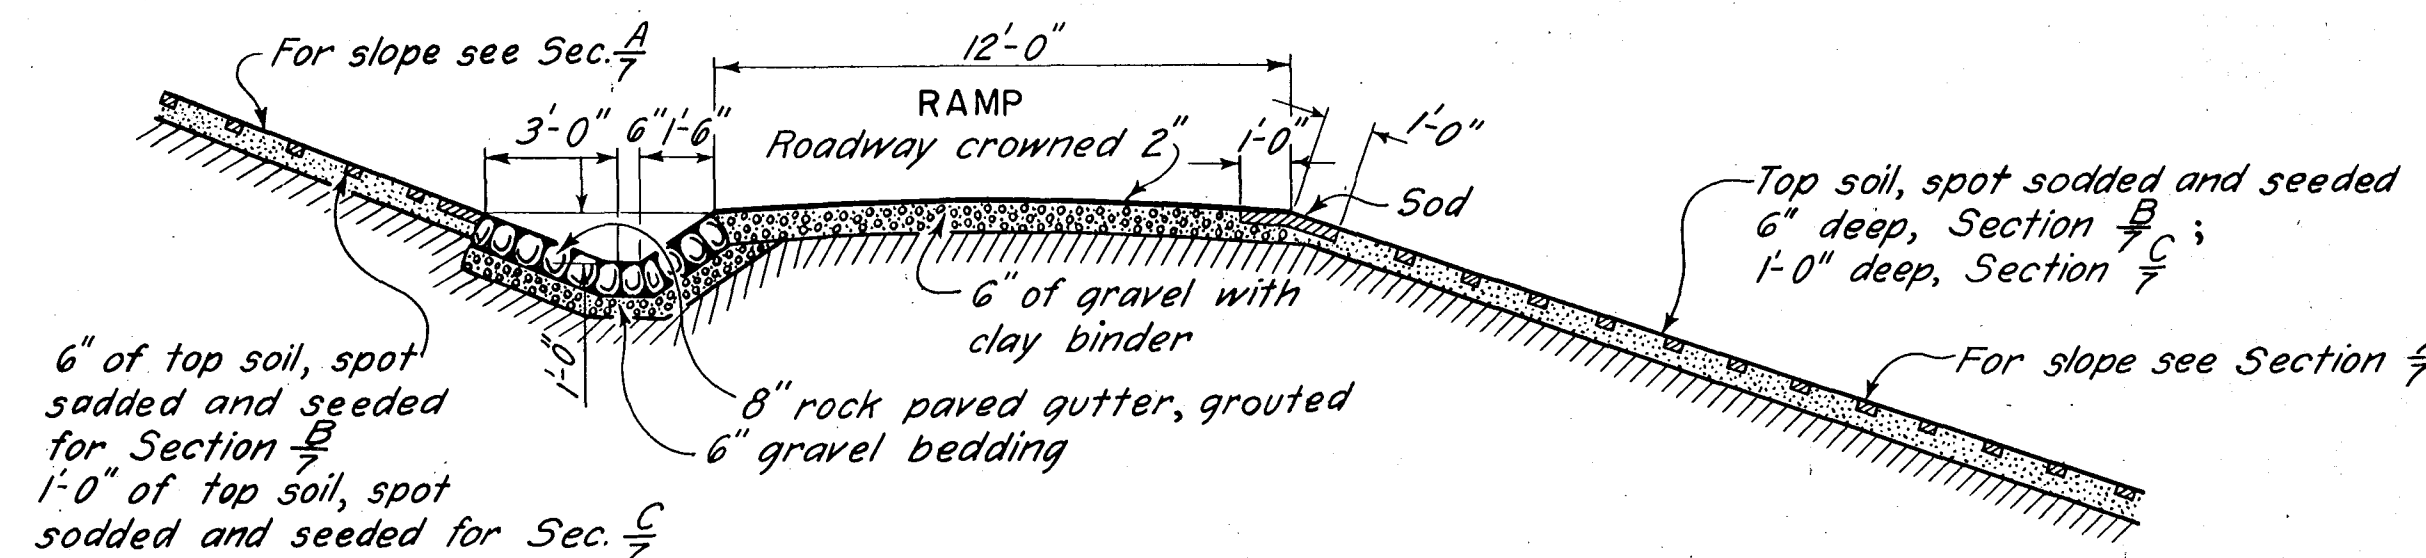

SECTION B7


SECTION C SAME EXCEPT AS NOTED

SCALE 1/4" = 1'-0"

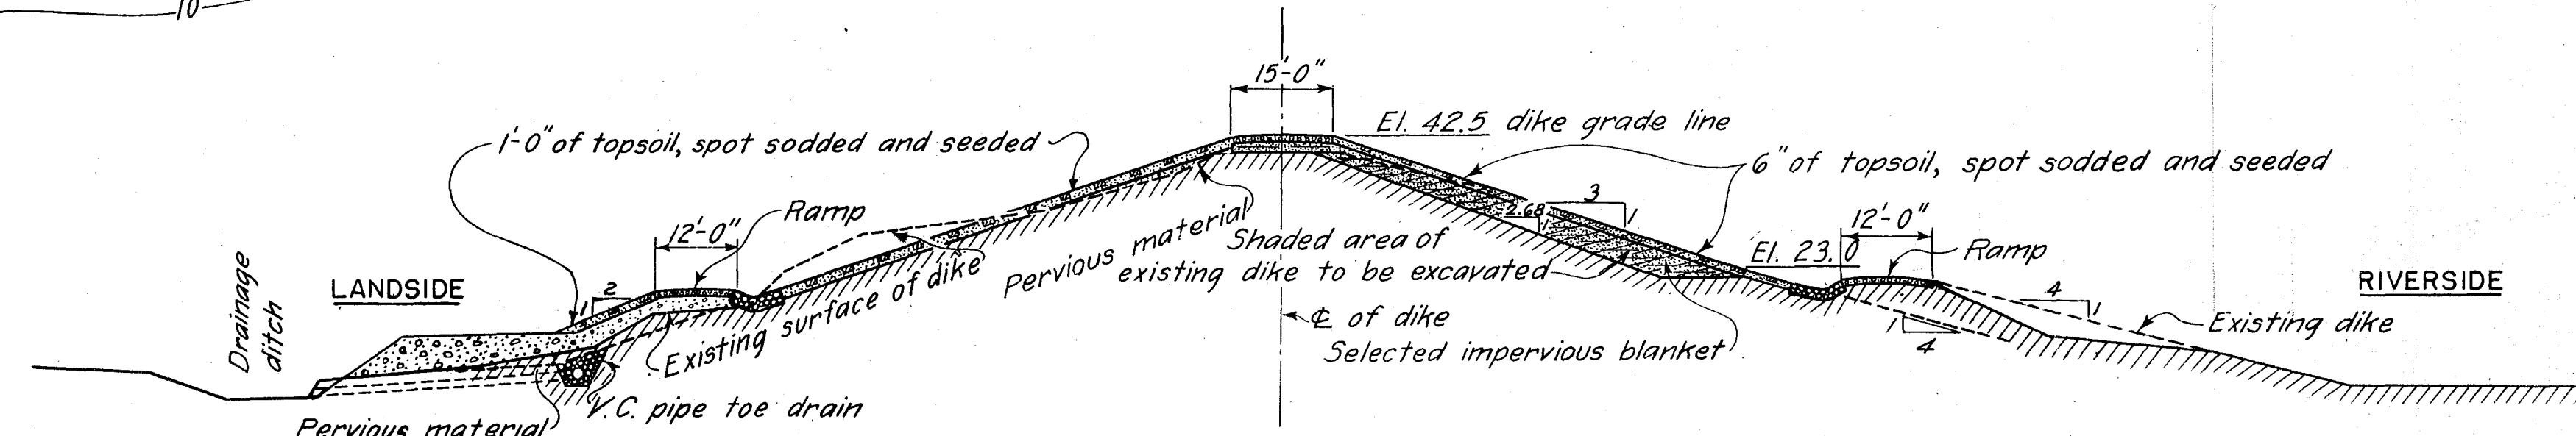

SECTION A7

SCALE: 1" = 20'

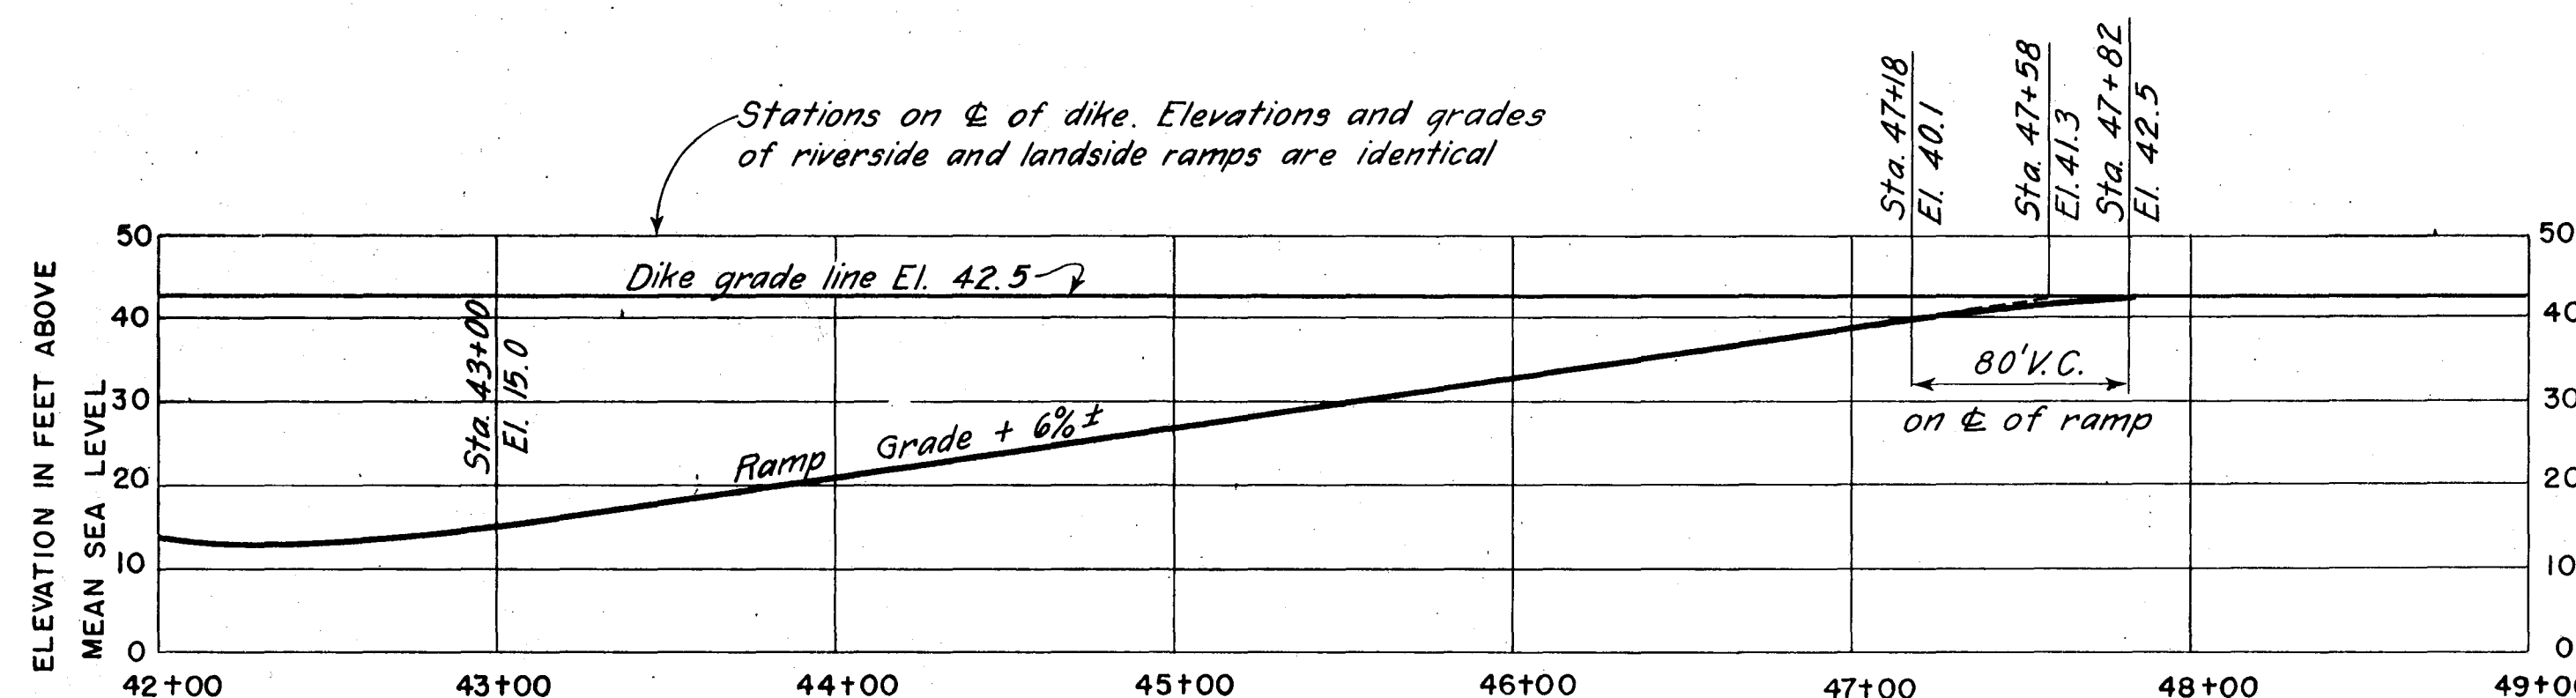

PROFILE OF RAMPS

SCALE HOR. 1" = 50'
VER. 1" = 20'

NOTES:
Elevations refer to Mean Sea Level datum
For general plan see Sheet No. 6.

12-31-45	As built revisions			
3-6-39	ADDED CATCH BASIN	J.L.	W.D.	J.B.B.
DATE	REVISION	REV BY	CK BY	AP BY

CONNECTICUT RIVER FLOOD CONTROL	
CLARK DIKE	
REPAIR & COMPLETION FROM STA 3+00 TO 117+00	
DETAILS OF RAMPS AT STA. 43+00	
HARTFORD, CONNECTICUT	
CONNECTICUT RIVER	CONNECTICUT
IN 9 SHEETS	SHEET NO. 7
SCALE: 1 IN. = 50 FT.	
U.S. ENGINEER OFFICE PROVIDENCE R.I. DEC. 1938	
SUBMITTED: <i>W.D. W.</i>	APPROVAL RECOMMENDED: <i>J.S. S.</i>
SENIOR ENGINEER	PRINCIPAL ENGINEER
HEAD DESIGN SECTION	CHIEF, E.C. ENGINEERING DIV.
DESIGNED: <i>J. W.</i>	DRAWN BY: <i>R.G.T.</i>
ASSOC. ENGINEER	TRACED BY: <i>W.L.W.R.H.</i>
	CHECKED BY: <i>S.T.W.</i>
FILE NO. C1-4-1242	TO ACCOMPANY SPECIFICATION DATED DEC. 15, 1938.