

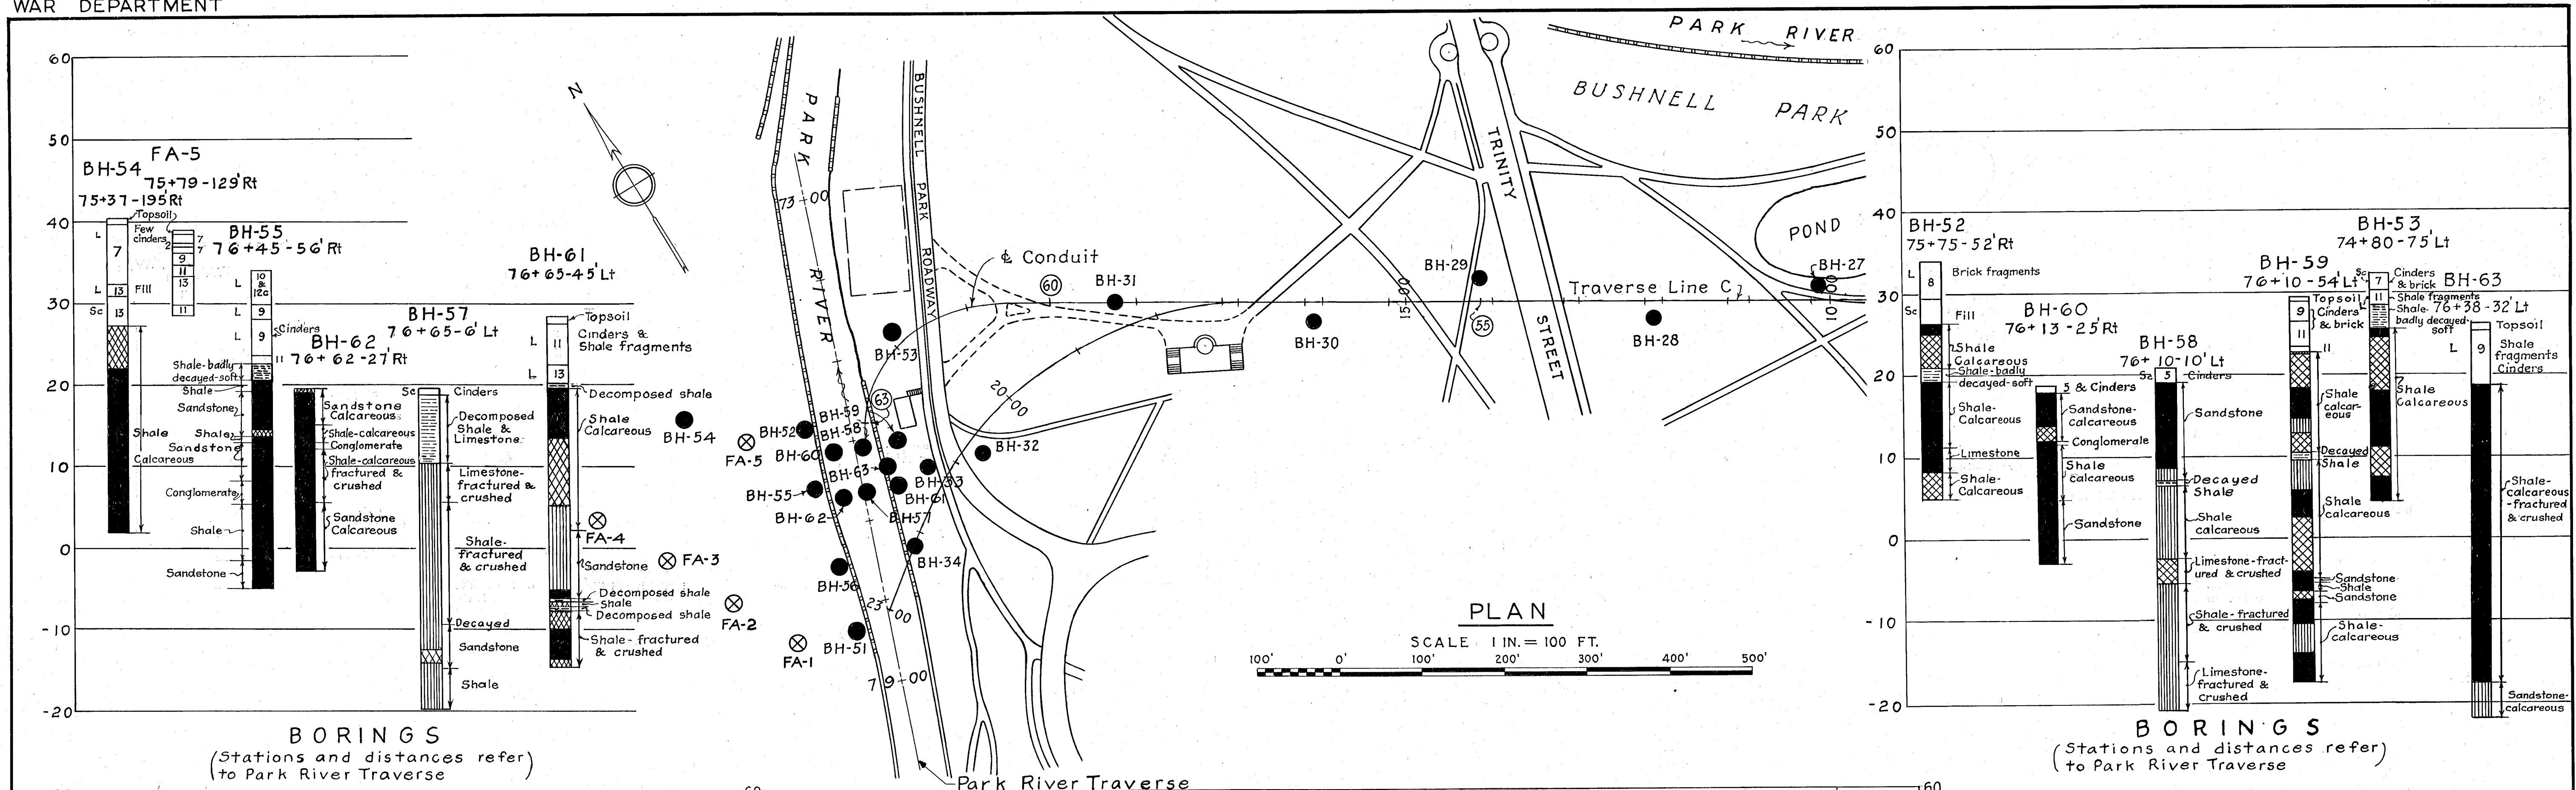


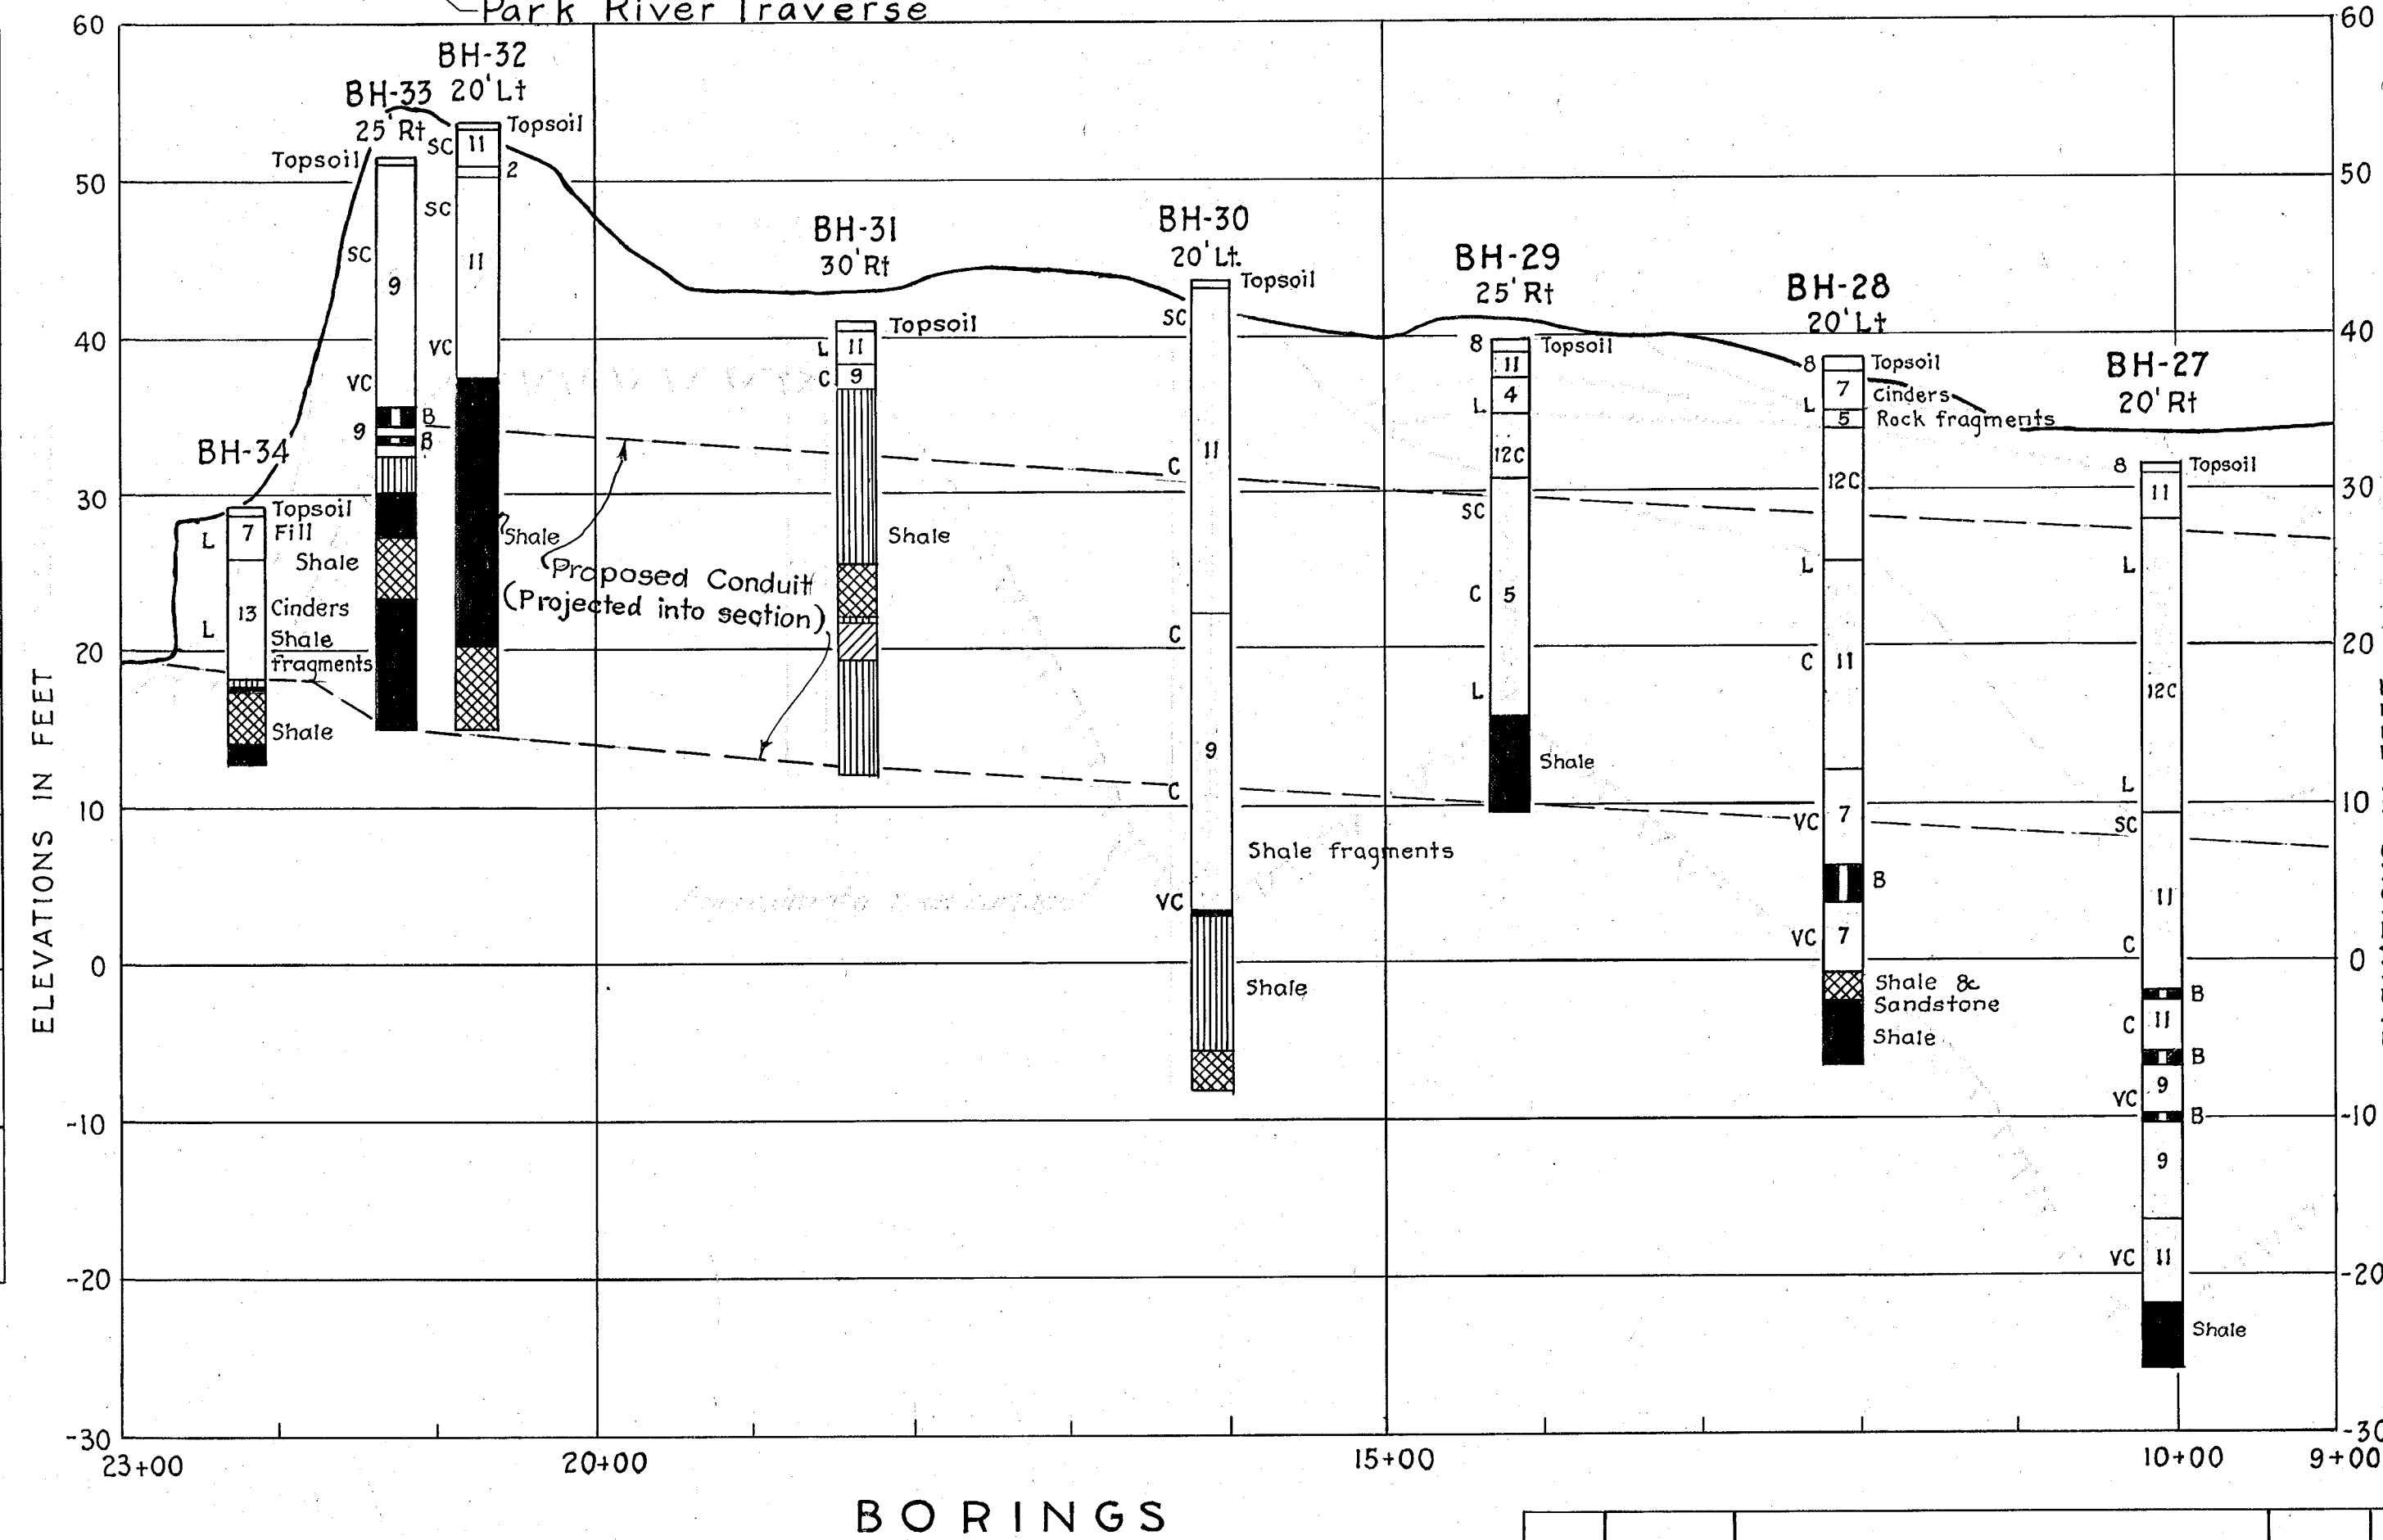

NOTES:
For general notes, legend and description of soil classes, see "Subsurface Explorations No. 2."
⊗ FA indicates foundation auger boring.
Elevations refer to Mean Sea Level Datum.

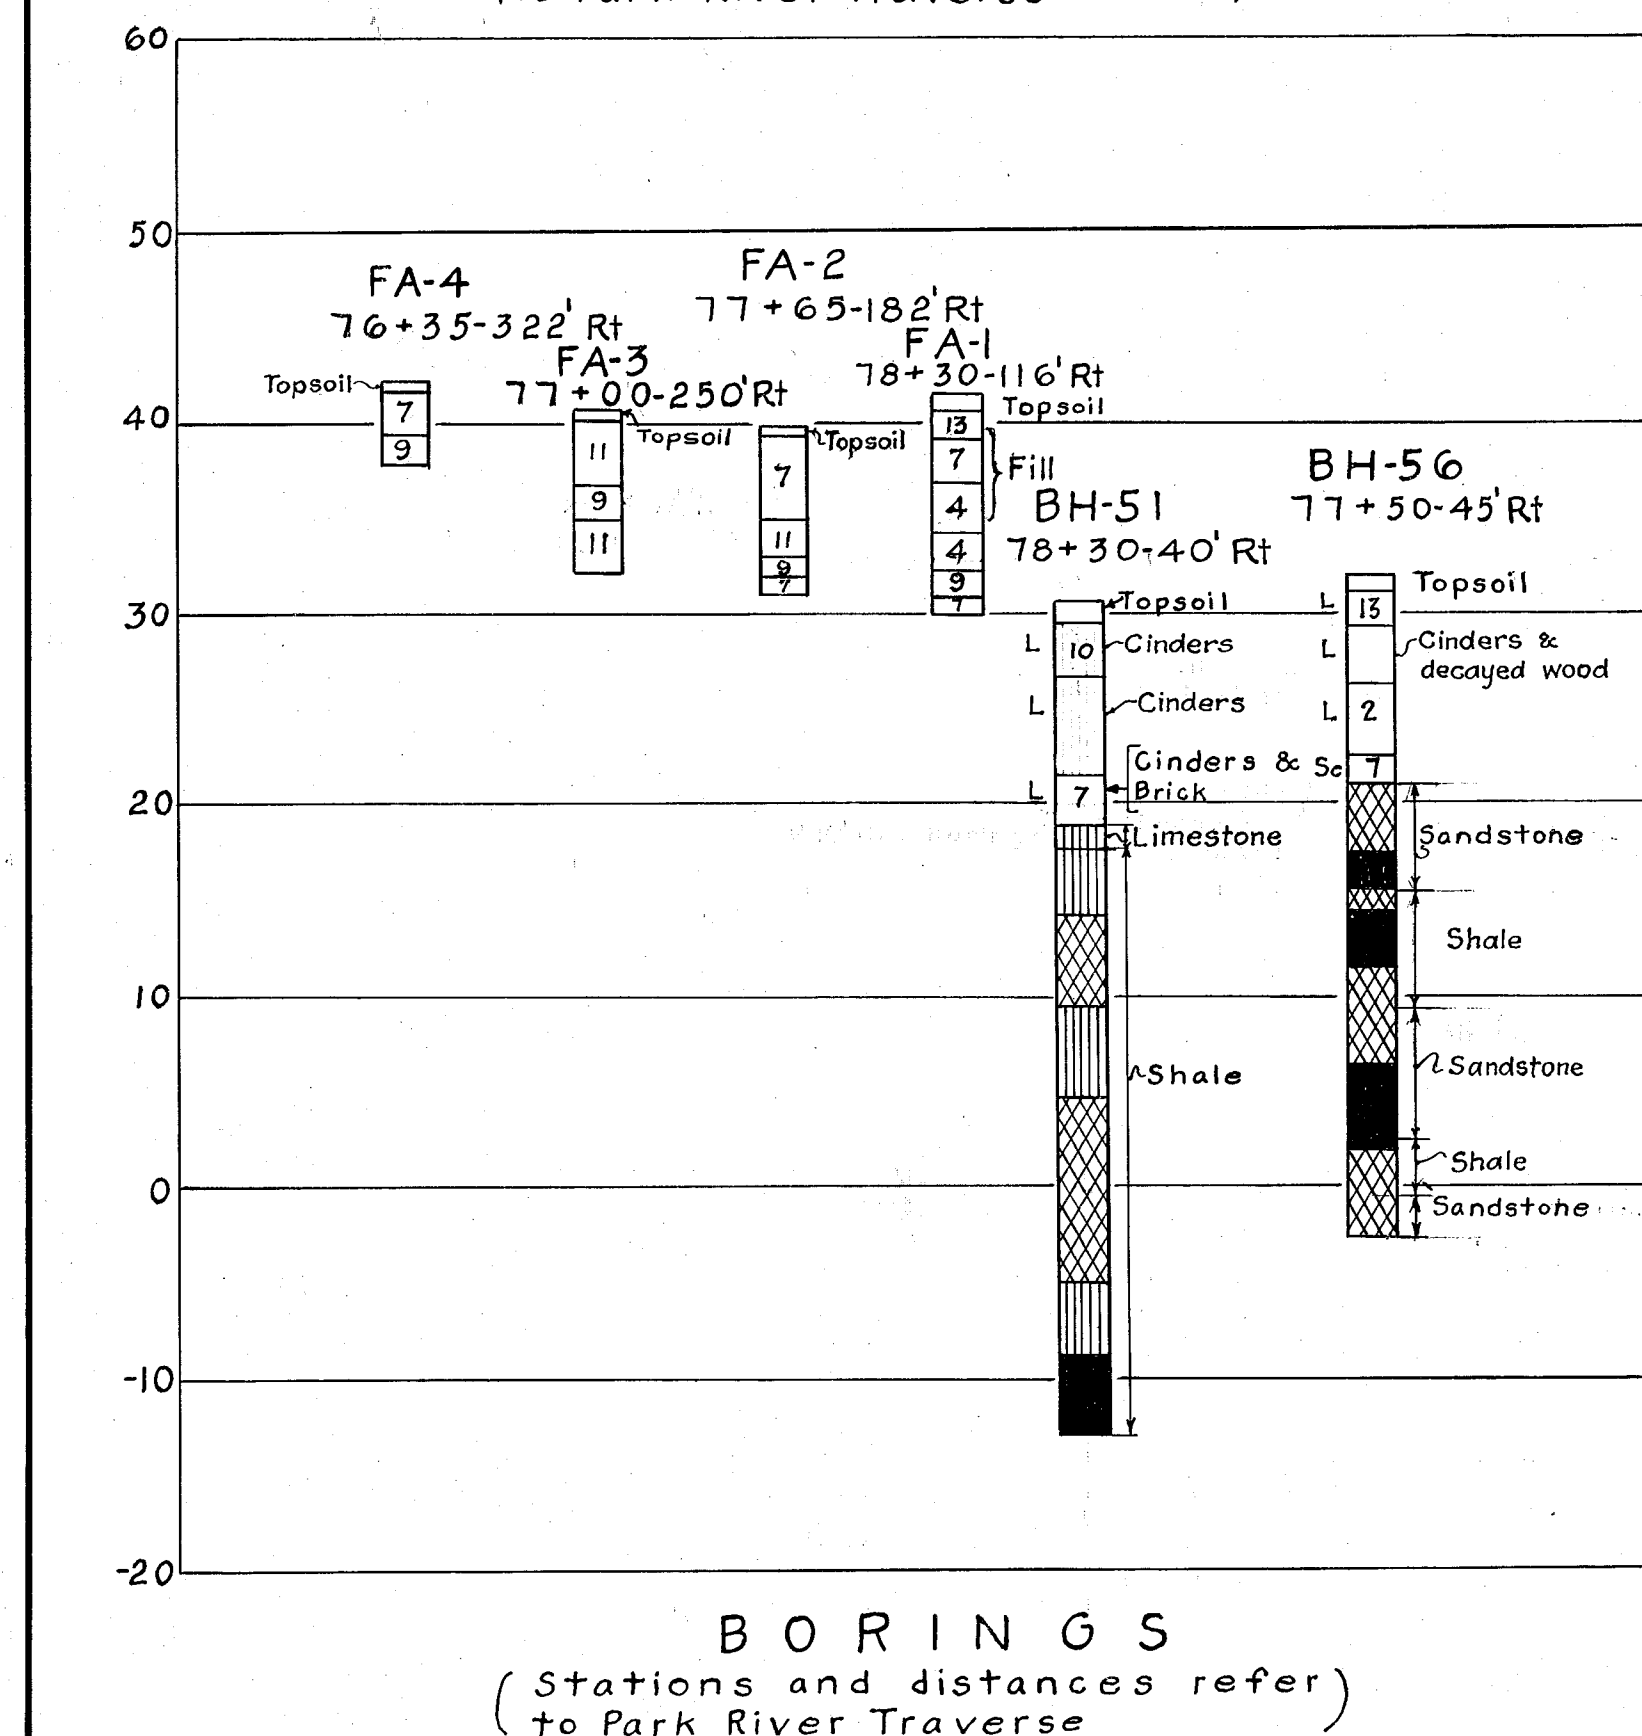

METCALF & EDDY
ENGINEERS
BOSTON, MASS.

KEY	DATE	REVISION (Indicated by Δ)	REV. BY	CK. BY	AP. BY
	12-31-45	As built.			

CONNECTICUT RIVER FLOOD CONTROL		
PARK RIVER CONDUIT		
HARTFORD, CONN.		
SUBSURFACE EXPLORATIONS NO. 4		
CONNECTICUT RIVER	CONNECTICUT	
IN 48 SHEETS	SCALE 1" = 100'	SHEET NO. 8
U.S. ENGINEER OFFICE PROVIDENCE, R.I.		MAY 1940
REVIEWED SENIOR GEOLOGIST HEAD, GEOLOGY SECTION	APPROVAL RECOMMENDED PRINCIPAL ENGINEER CHIEF E.C. ENGINEERING DIV.	APPROVED DISTRICT ENGINEER
SUBMITTED: METCALF & EDDY BOSTON, MASS.	DRAWN BY: E.S.B. TRACED BY: E.S.B. CHECKED BY: P.W.T.	FILE NO. CT-2-1289