
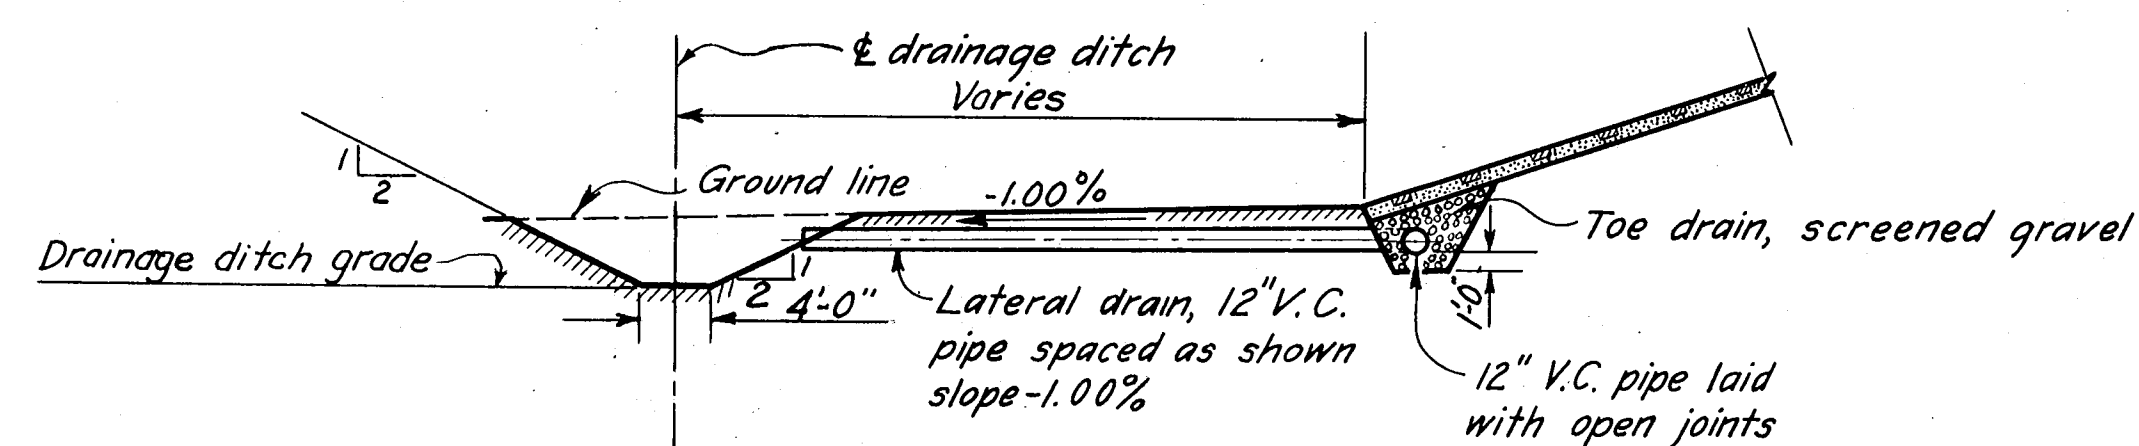
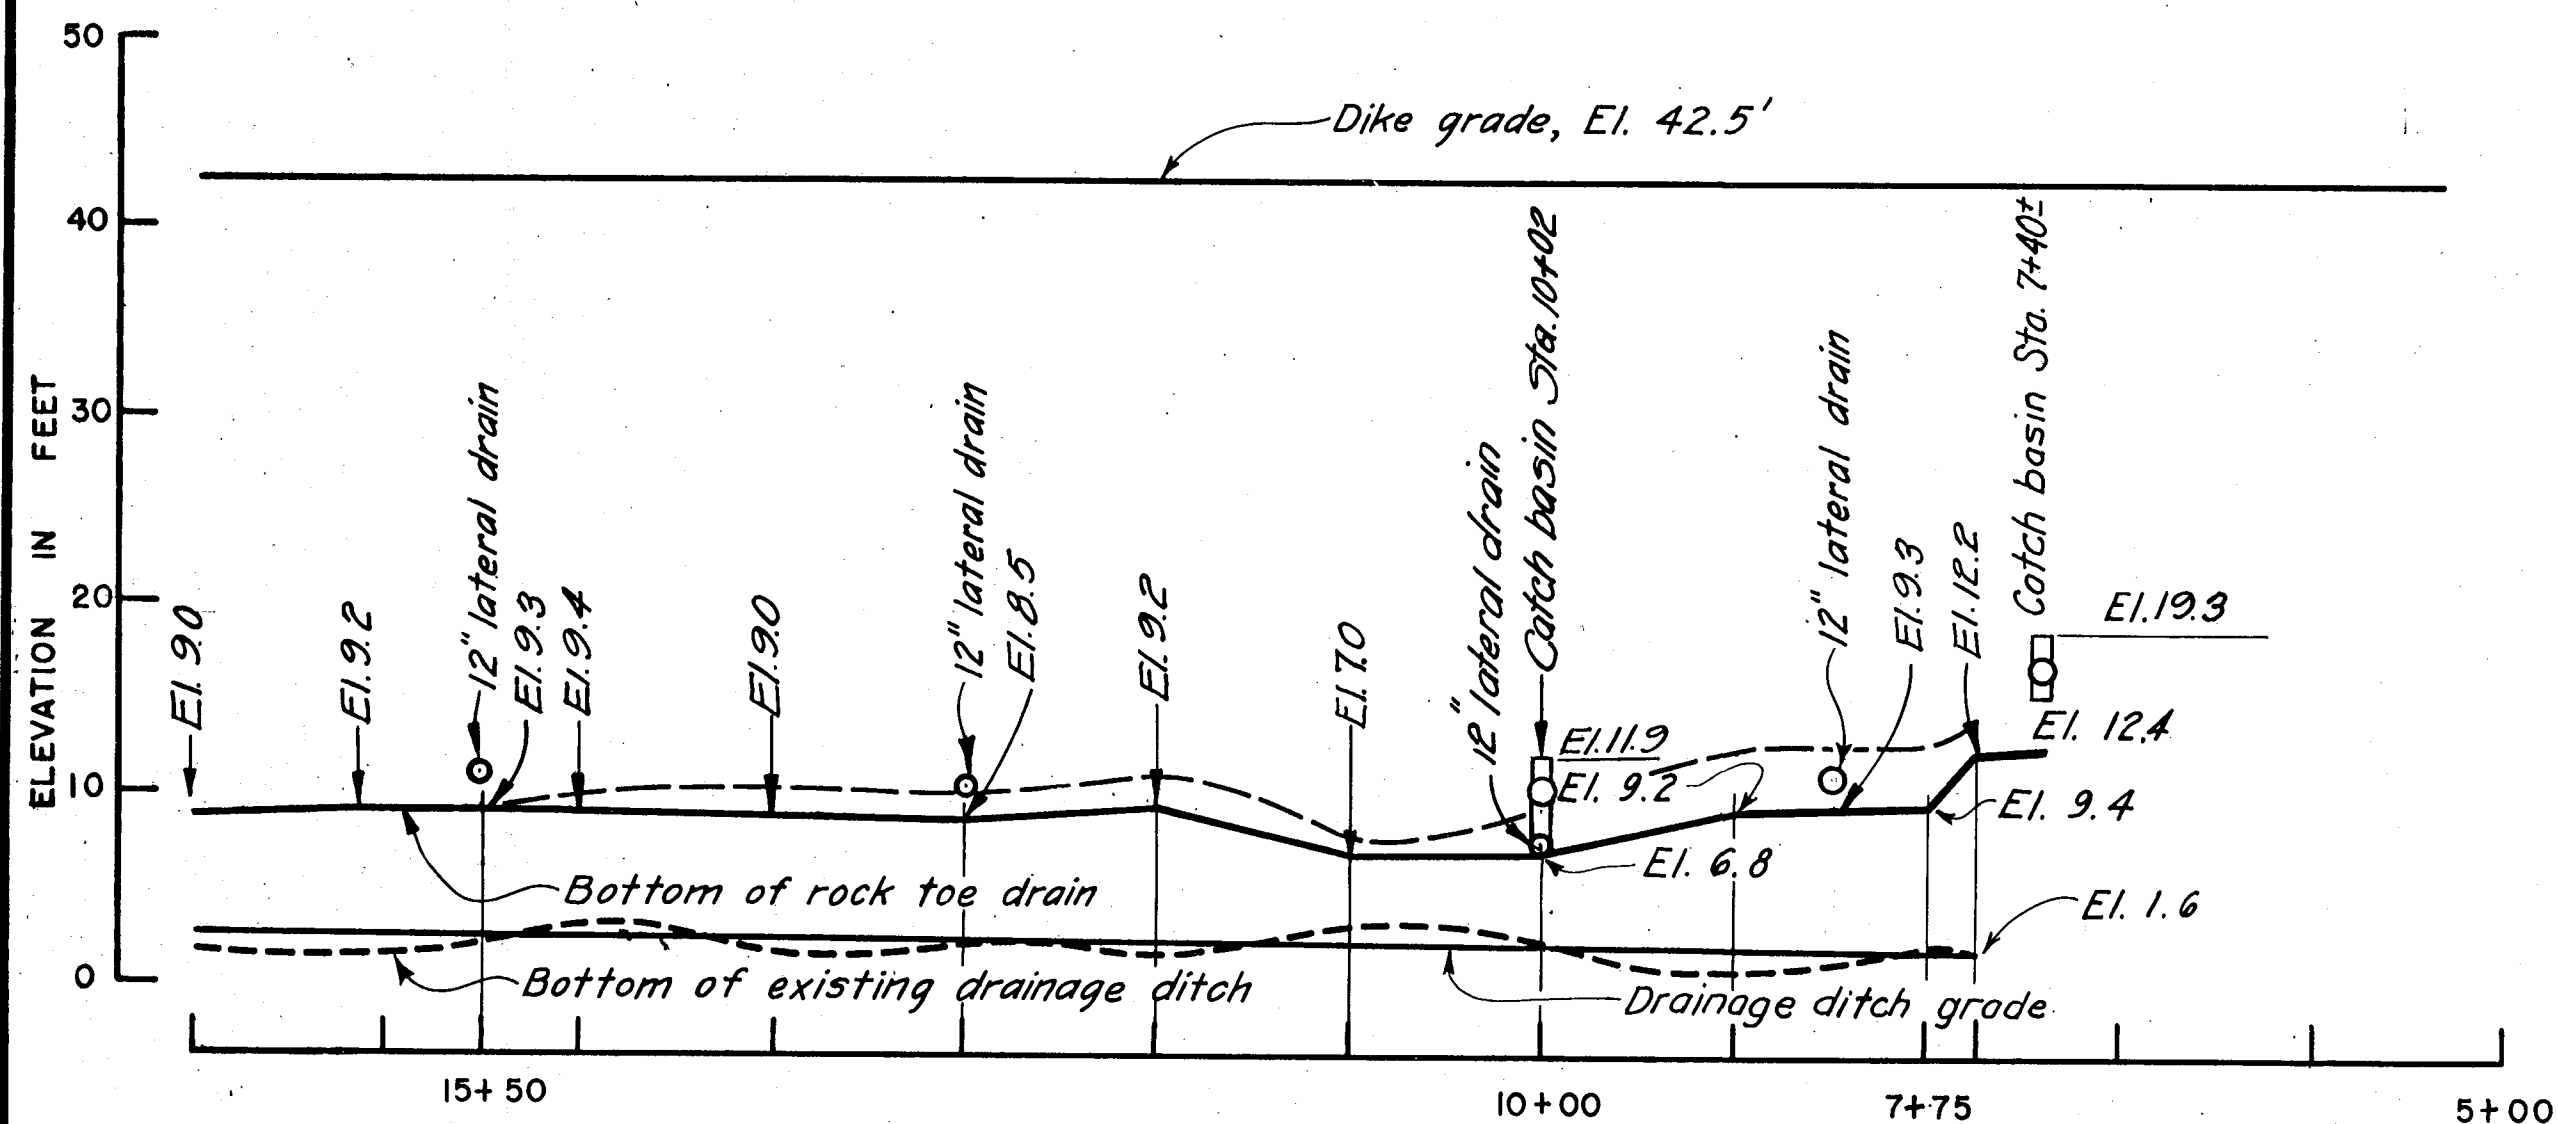
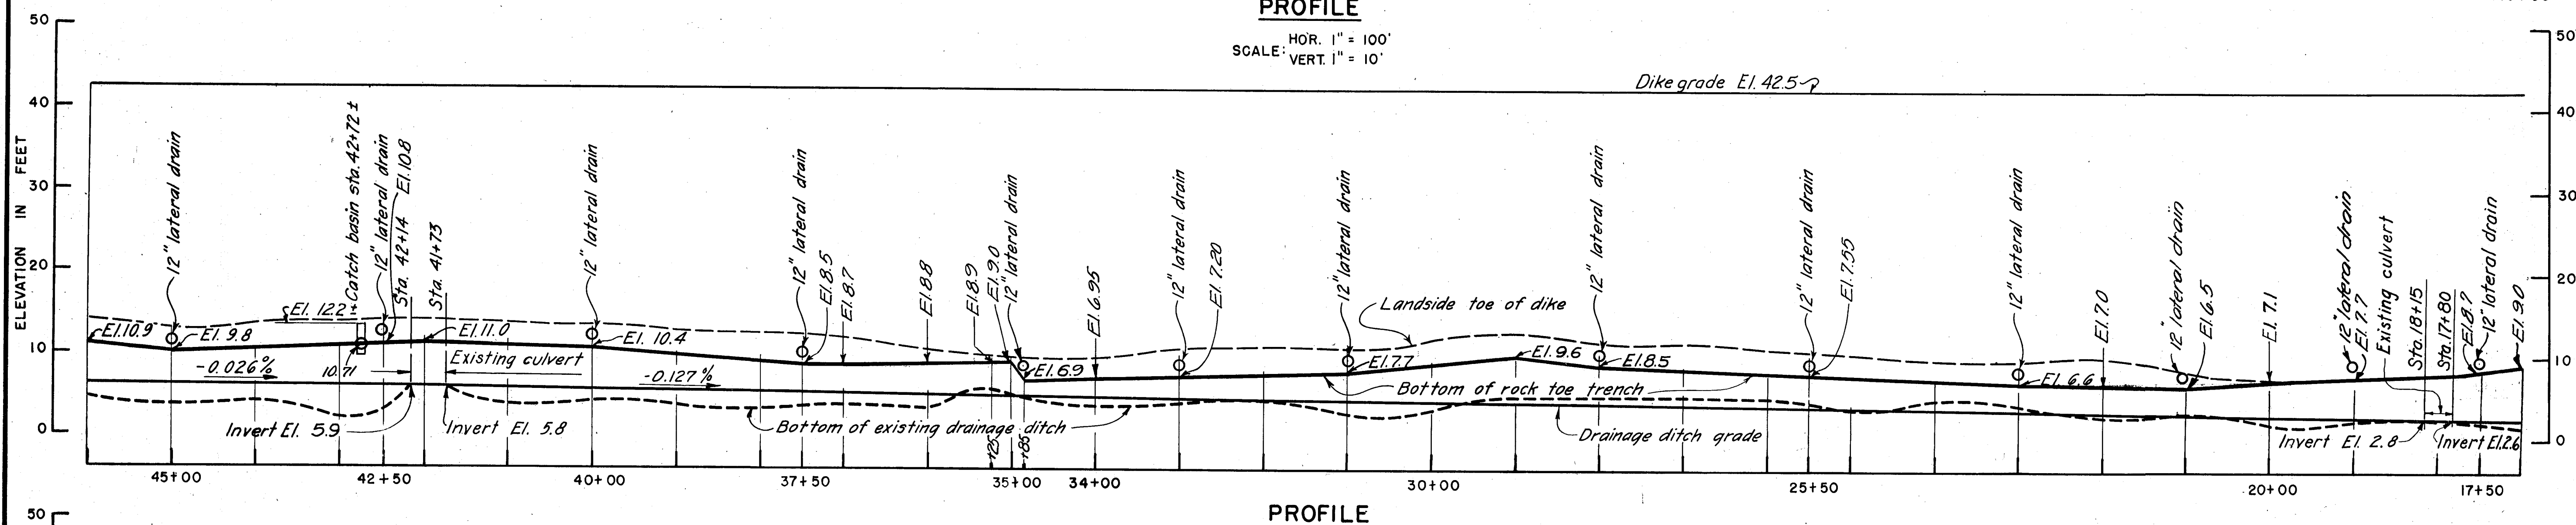


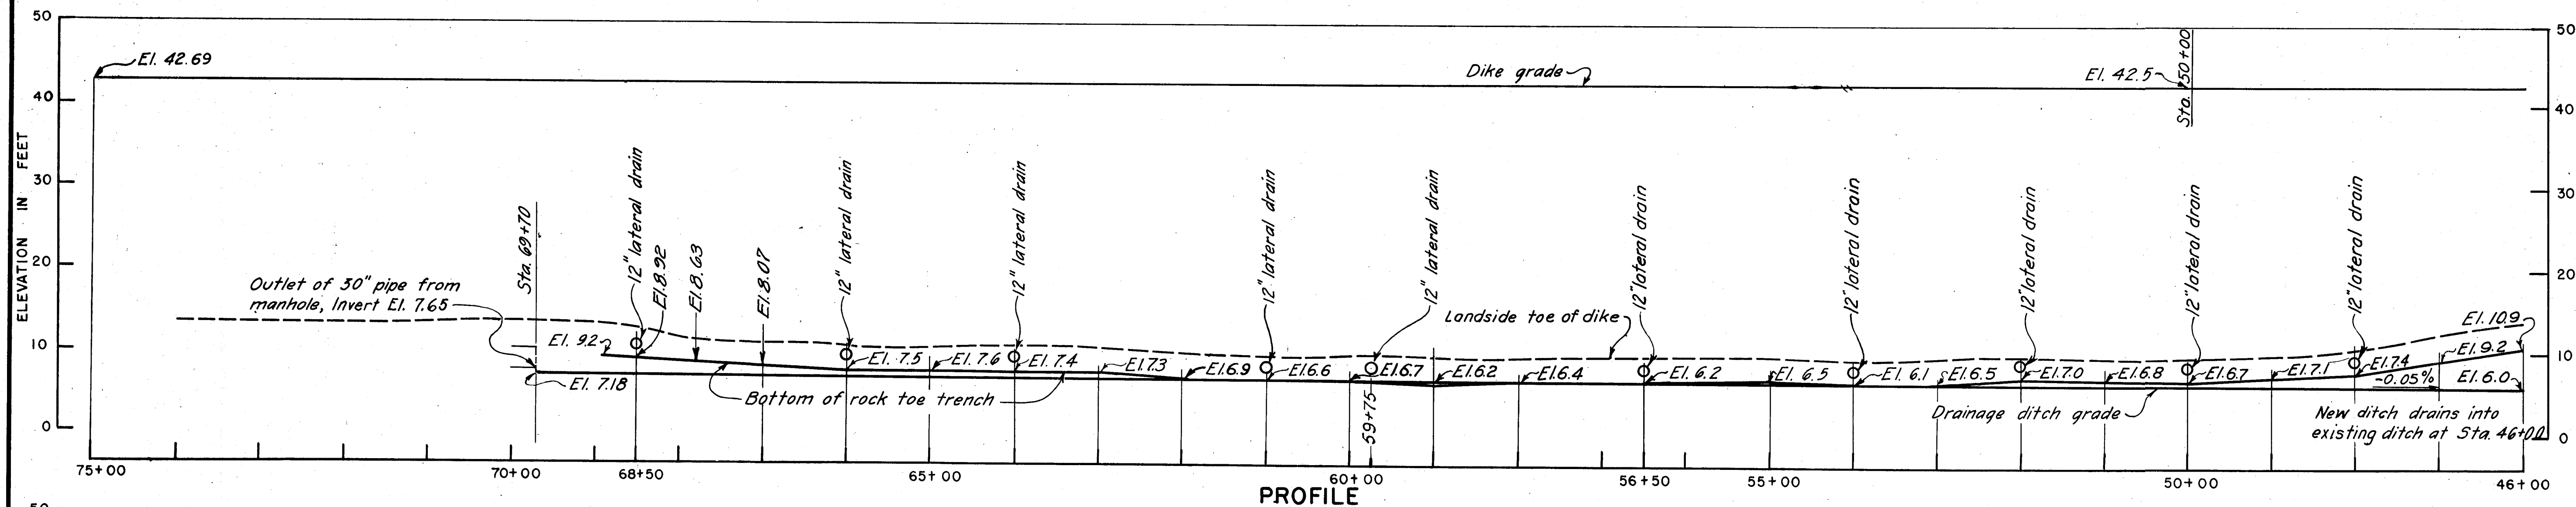

NOTES:

Elevations refer to Mean Sea Level Datum.
For details of catch basins, see Sheet No. 6.
For typical dike sections, see Sheet Nos. 4 & 5.
For General Plan, see Sheet No. 3.

DATE	REVISION	REV. BY	CK. BY	AP. BY
12/31/45	As built revisions			

CONNECTICUT RIVER FLOOD CONTROL	
CLARK DIKE	
REPAIR & COMPLETION FROM STA. 3+00 TO 117+00	
TOE DRAINAGE DETAILS	
HART FORD, CONNECTICUT	
CONNECTICUT RIVER	CONNECTICUT
IN 9 SHEETS	SCALE: 1 IN. = 100 FT.
SHEET NO. 8	
U.S. ENGINEER OFFICE PROVIDENCE, R.I., MARCH, 1939	
SUBMITTED: <i>W. B. Nelson</i>	APPROVED: <i>J. D. Burns</i>
DESIGNED: <i>J. Hart</i>	DRAWN BY: <i>F. F. C.</i>
TRACED BY: <i>W. L. & W. H.</i>	CHECKED BY: <i>S. J. M.</i>
FILE NO. CT-4-1310	TO ACCOMPANY SPECIFICATIONS DATED DEC. 15, 1938