
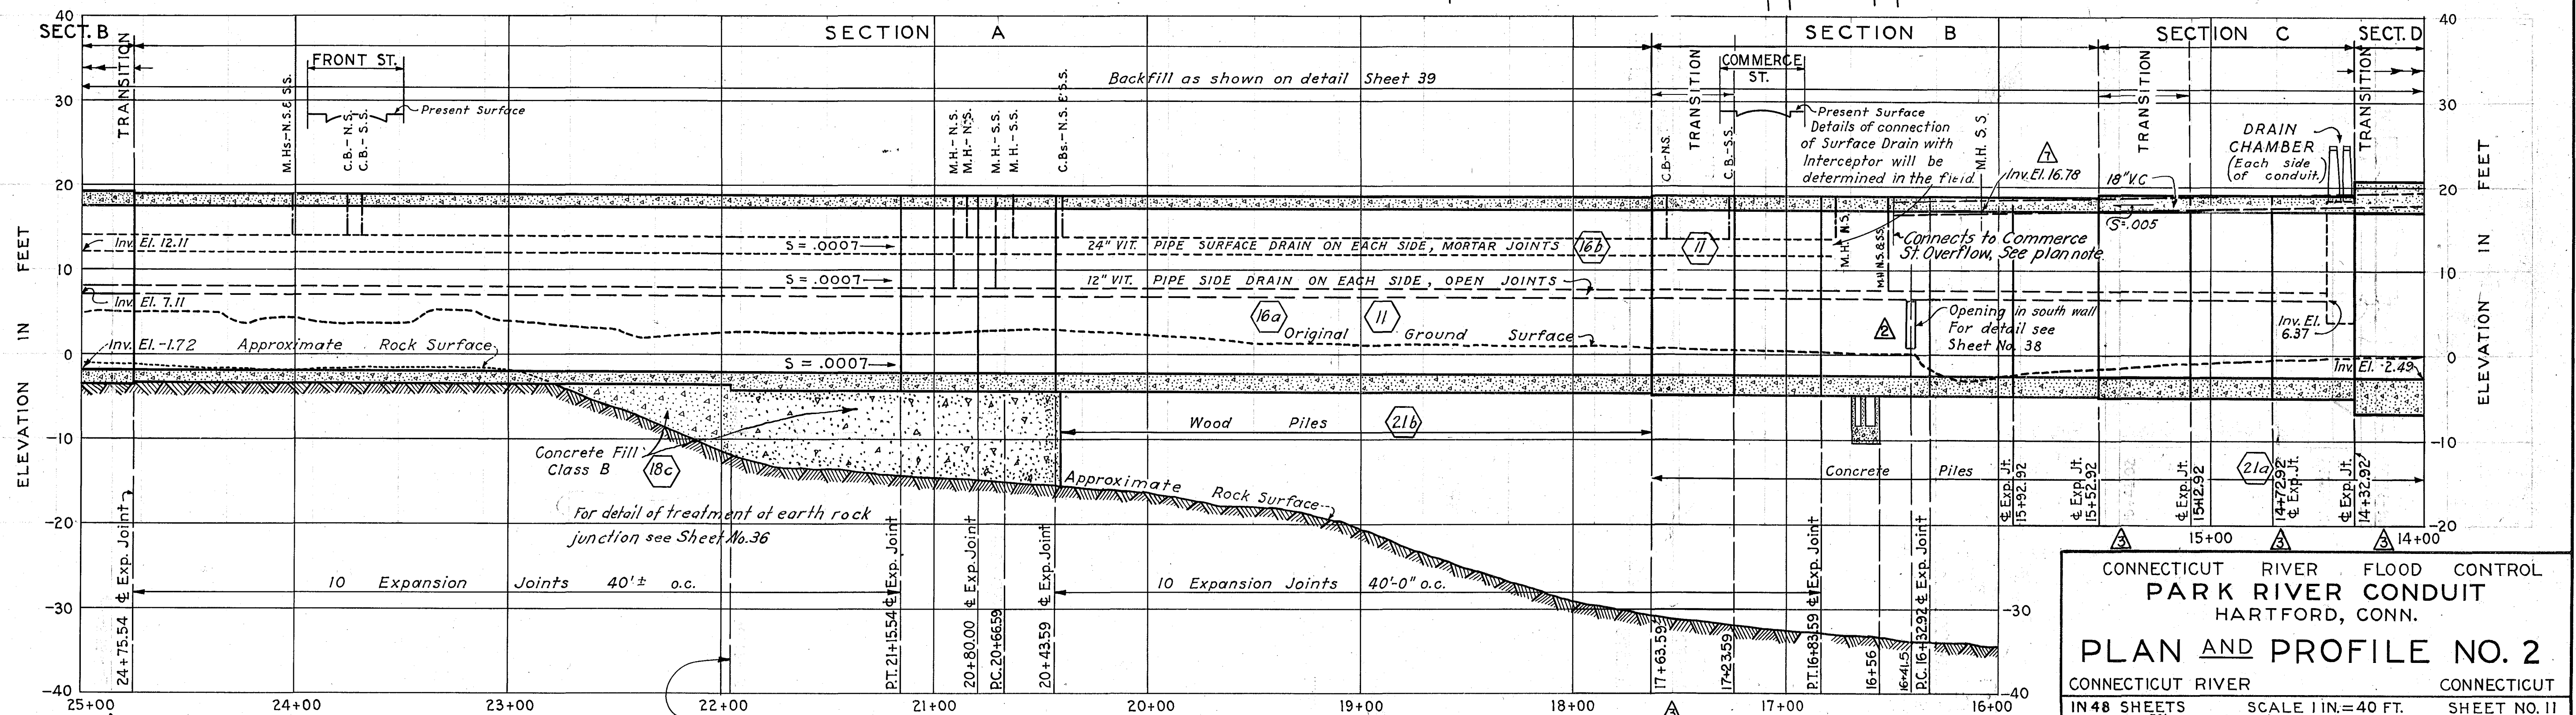


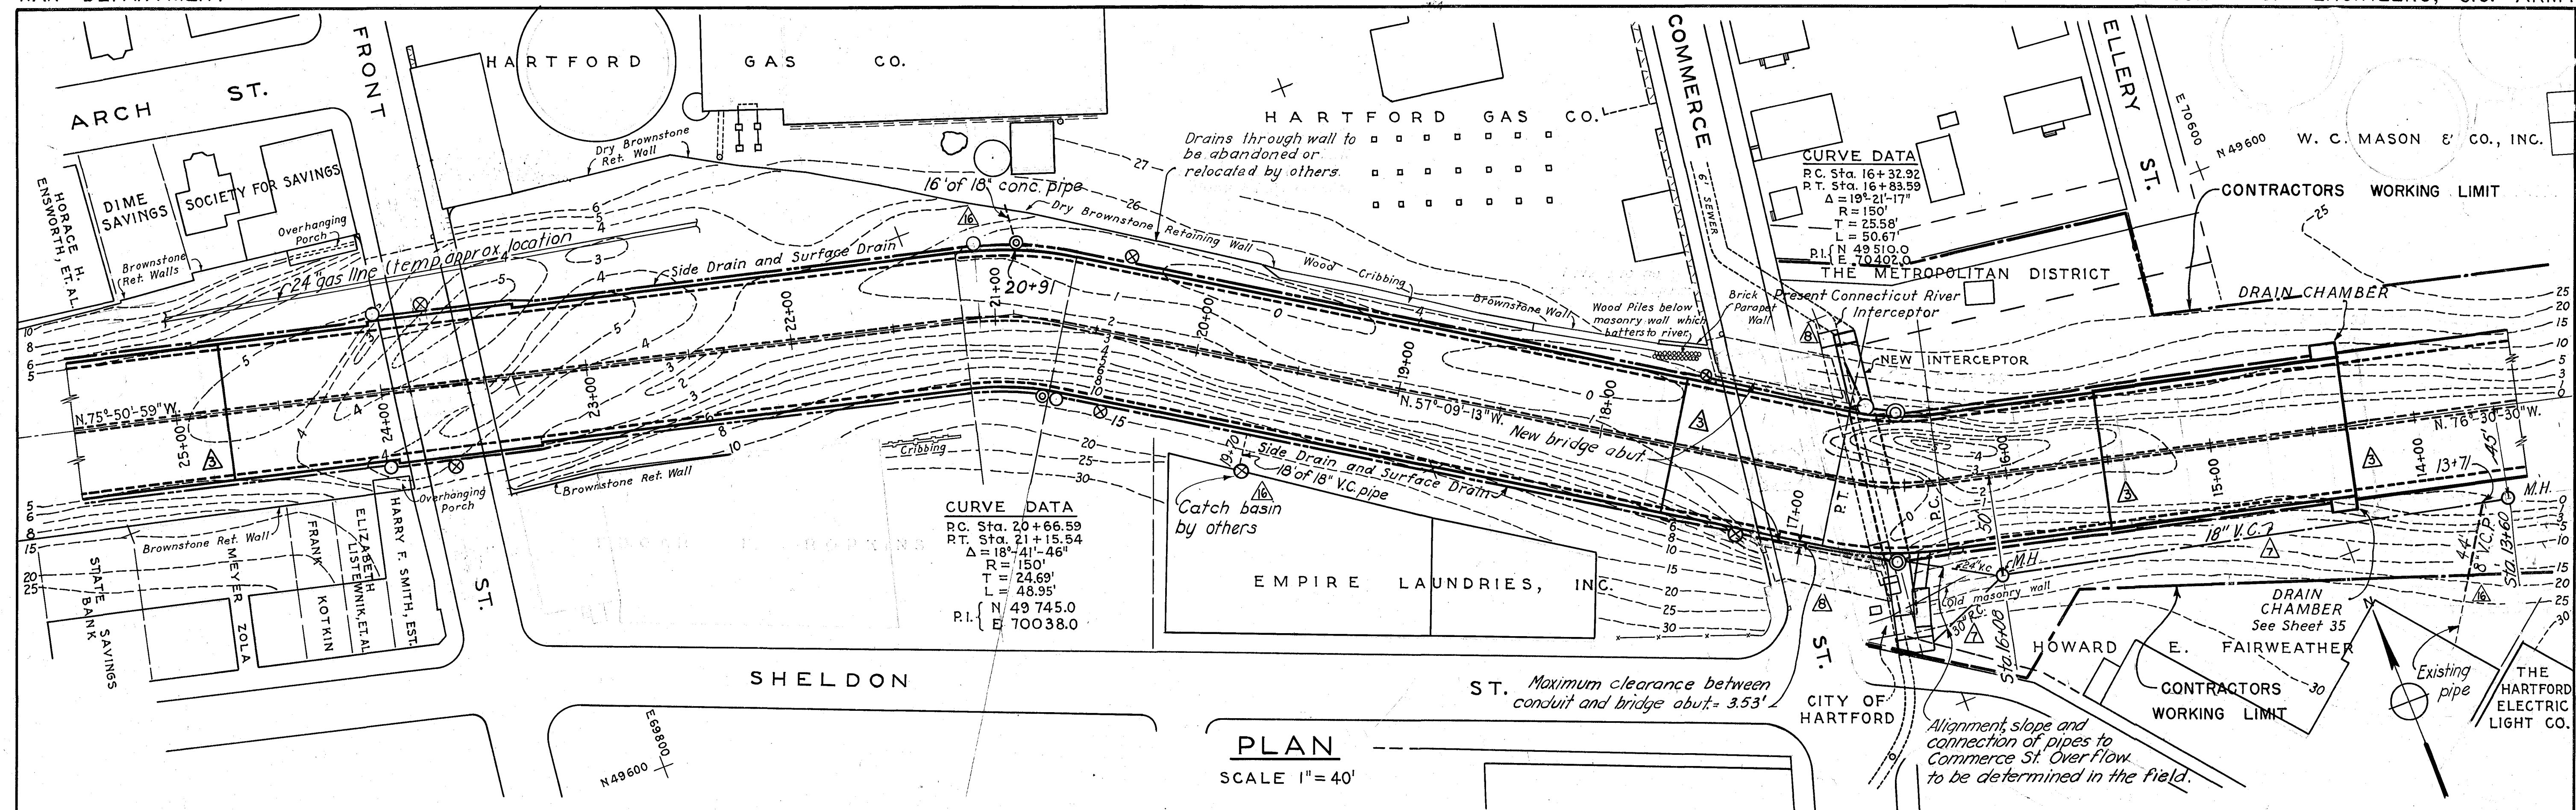

NOTES

For general notes applying to details shown on this sheet, see Sheet No. 10.
See legend on Sheet No. 10.
For Contractor's working limit above Commerce St. see Sheet No. 9.

METCALF & EDDY
ENGINEERS
BOSTON, MASS.

RECORD
DRAWINGS

PROFILE
SCALE HOR. 1"=40'
VERT. 1"=10'

KEY	DATE	REVISION (Indicated by Δ)	REV. BY	CK. BY	AP. BY
Δ	12-31-45	As Built Revisions	B.S.	C.M.R.	J.M.B.
Δ	11-17-43	Sewer connections added.	E.D.E.	J.P.B.	J.M.B.
Δ	4-22-42	Drain pipes at Commerce St. revised	P.C.H.	J.P.B.	J.M.B.
Δ	10-28-41	18" V.C. pipe added	P.C.H.	J.P.B.	J.M.B.
Δ	2-17-41	Transitions changed	J.C.D.	V.P.V.	J.M.B.
Δ	11-22-40	Opening relocated at Sta. 16+41.5	P.C.H.	K.B.N.	J.M.B.

CONNECTICUT RIVER FLOOD CONTROL
PARK RIVER CONDUIT
HARTFORD, CONN.

PLAN AND PROFILE NO. 2

CONNECTICUT RIVER CONNECTICUT

IN 48 SHEETS SCALE 1 IN. = 40 FT. SHEET NO. 11

U.S. ENGINEER OFFICE PROVIDENCE, R.I. MAY 1940

REVIEWED: *W.H. Jones* APPROVAL RECOMMENDED: *W.H. Jones* APPROVED: *W.H. Jones*
ENGINEER PRINCIPAL ENGINEER LT. COL. CORPS OF ENGINEERS
R.C. DESIGN SECTION CHIEF F.C. ENGINEERING DIV. DISTRICT ENGINEER
SUBMITTED: *W.H. Jones* (PARTNER) DRAWN BY: H.C.T. FILE NO. CT-4-2609
METCALF & EDDY TRACED BY: H.C.T.
BOSTON, MASS. CHECKED BY: P.M.T.