
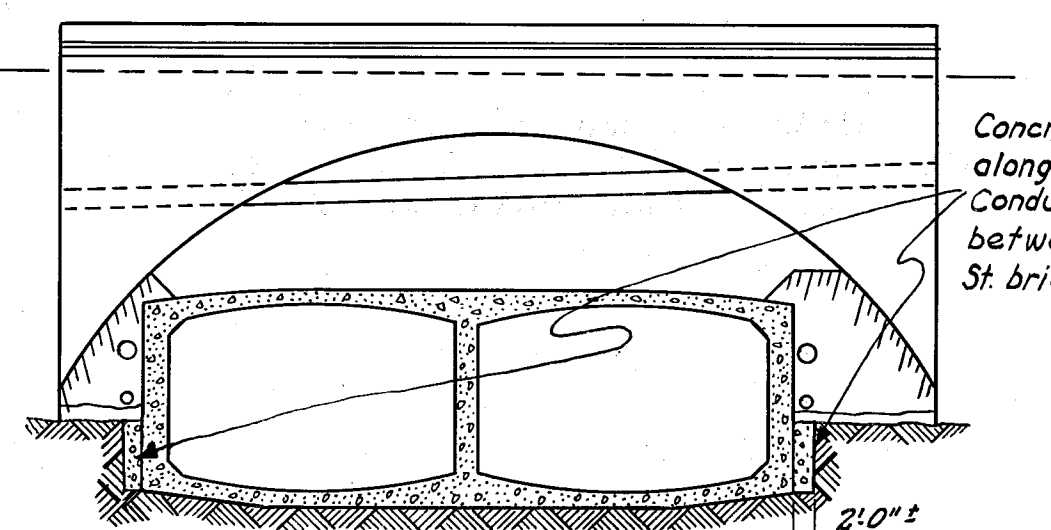
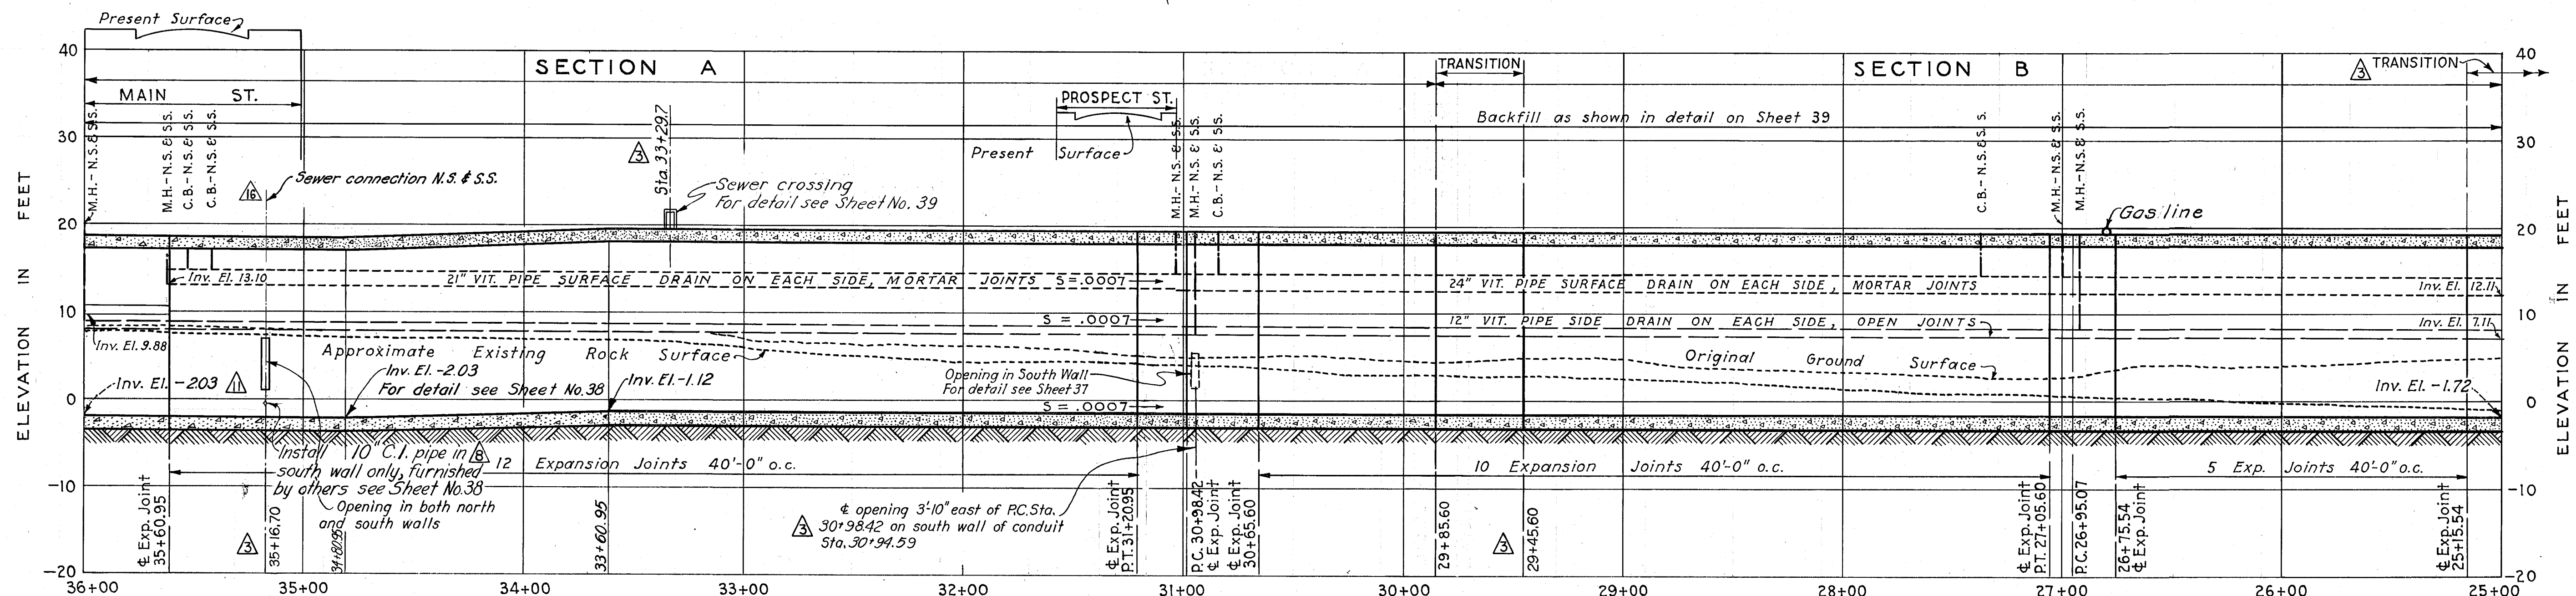
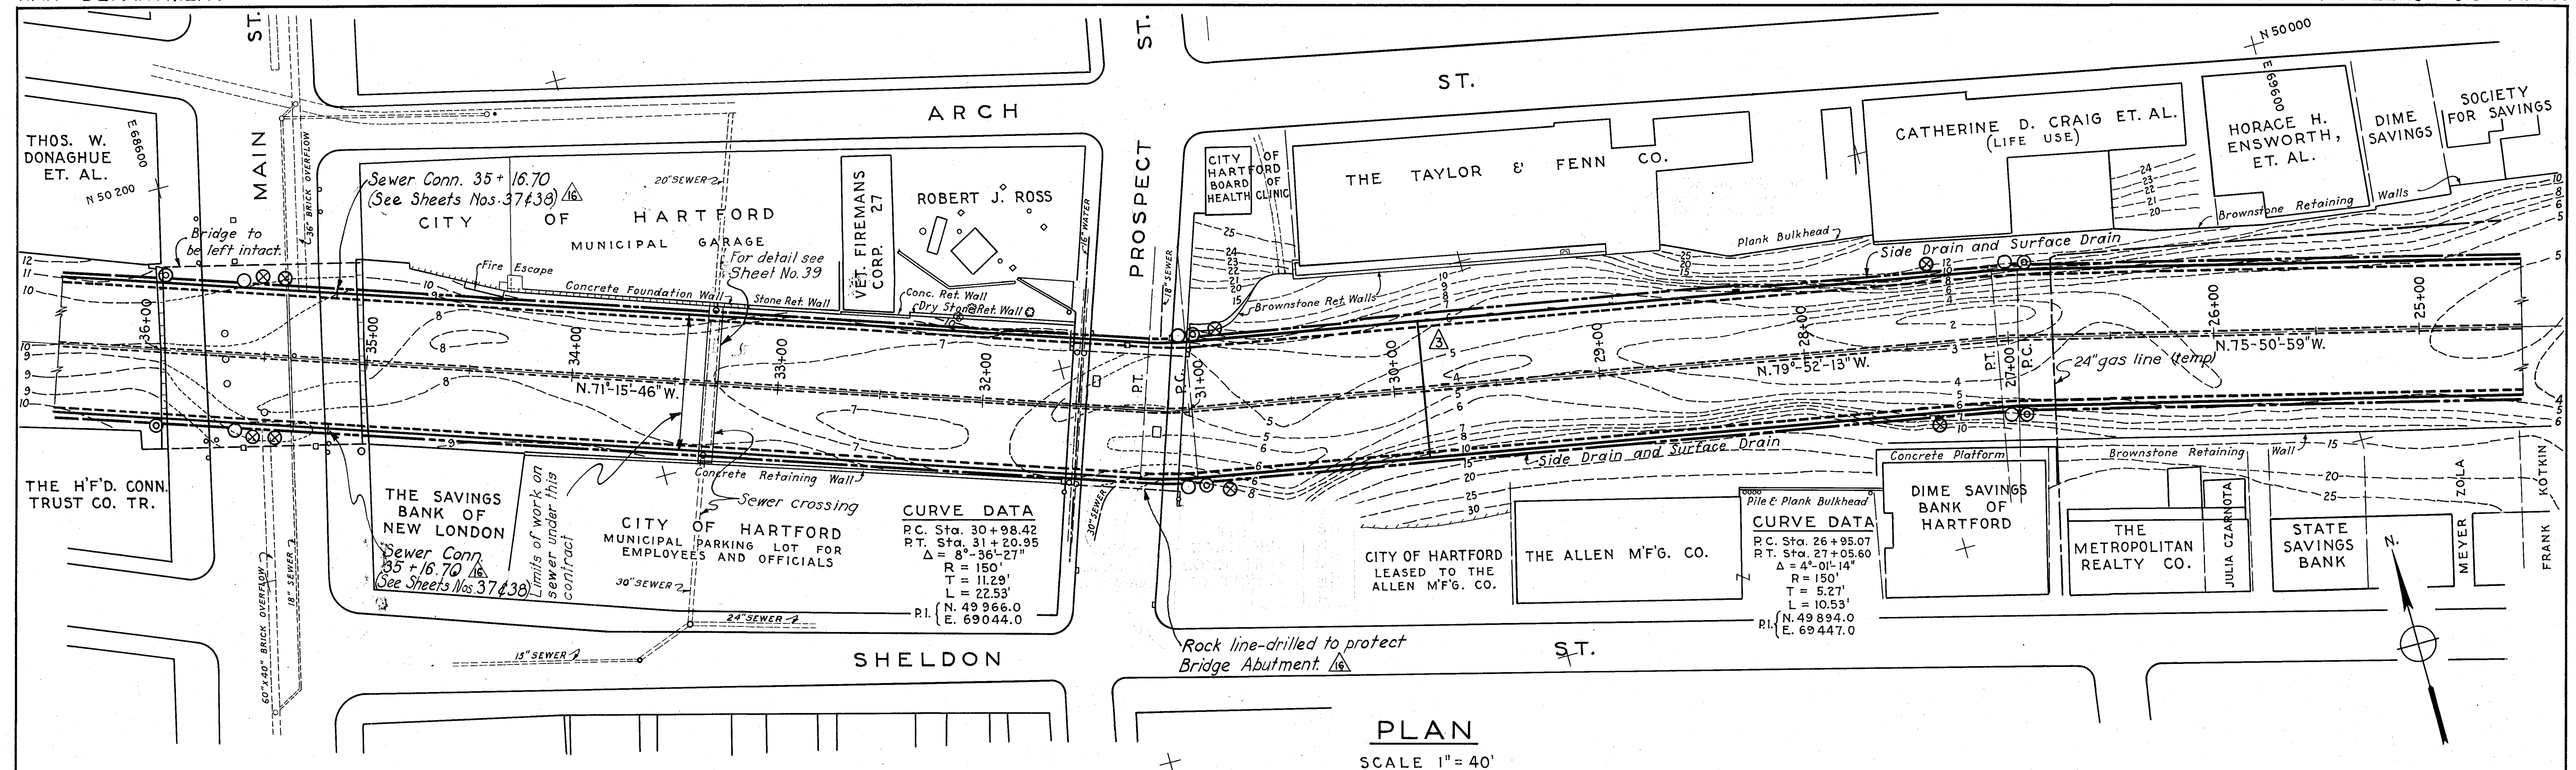


SECTION AT STA. 36+00 LOOKING EAST
METCALF & EDDY
ENGINEERS
BOSTON, MASS.

SCALE 1\"/>

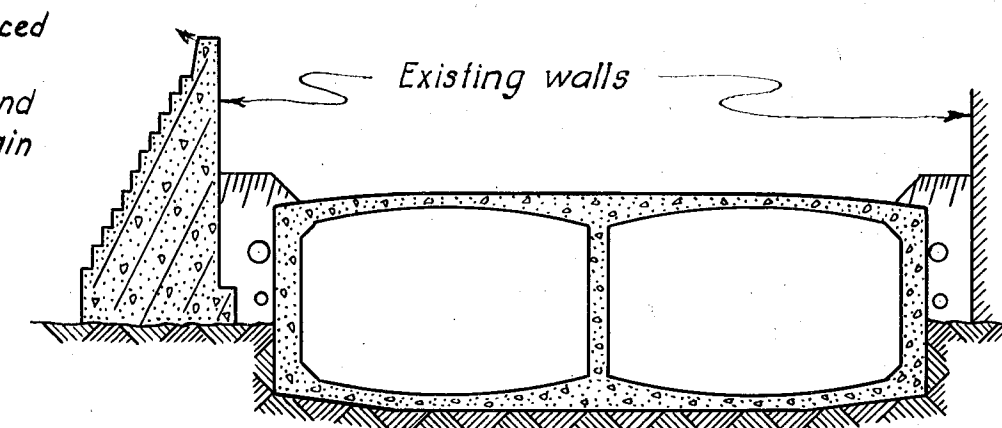

SECTION AT STA. 33+00 LOOKING WEST

SCALE 1\"/>

PROFILE

SCALE HOR. 1\"/>

NOTES

For general notes applying to details shown on this sheet, see Sheet No. 10.
See legend on Sheet No. 10.

RECORD
DRAWINGS

KEY	DATE	REVISION (Indicated by Δ)	REV. BY	CK. BY	AP. BY
Δ	12-31-45	As built revisions			
Δ	11-17-43	Sewer connections & conc. fill at Main St. bridge added; line-drilling at Prospect St. added	B.S.	CMR	WM
Δ	8/26/42	Conduit invert revised Sta. 33+60.95 to Sta. 37+20.95	E.D.C.	JCS	2813
Δ	4/22/42	Pipe added at Main St.	E.D.C.	JCS	2813
Δ	2-17-41	Transitions and openings changed	JCS	JCS	2817

CONNECTICUT RIVER FLOOD CONTROL
PARK RIVER CONDUIT
HARTFORD, CONN.

PLAN AND PROFILE NO. 3

CONNECTICUT RIVER CONNECTICUT
IN 48 SHEETS SCALE 1\"/>

U.S. ENGINEER OFFICE PROVIDENCE, R.I. MAY 1940

REVIEWED: *W. H. Hauer* APPROVAL RECOMMENDED: *W. H. Hauer* APPROVED: *W. H. Hauer*
PRINCIPAL ENGINEER LT. COL. CORPS OF ENGINEERS
F.C. DESIGN SECTION CHIEF F.C. ENGINEERING DIV. DISTRICT ENGINEER
SUBMITTED: *W. H. Hauer* (PARTNER) DRAWN BY: H.C.T. TRACED BY: H.C.T. CHECKED BY: H.C.T.
METCALF & EDDY BOSTON, MASS. FILE NO. CT-4-2610