
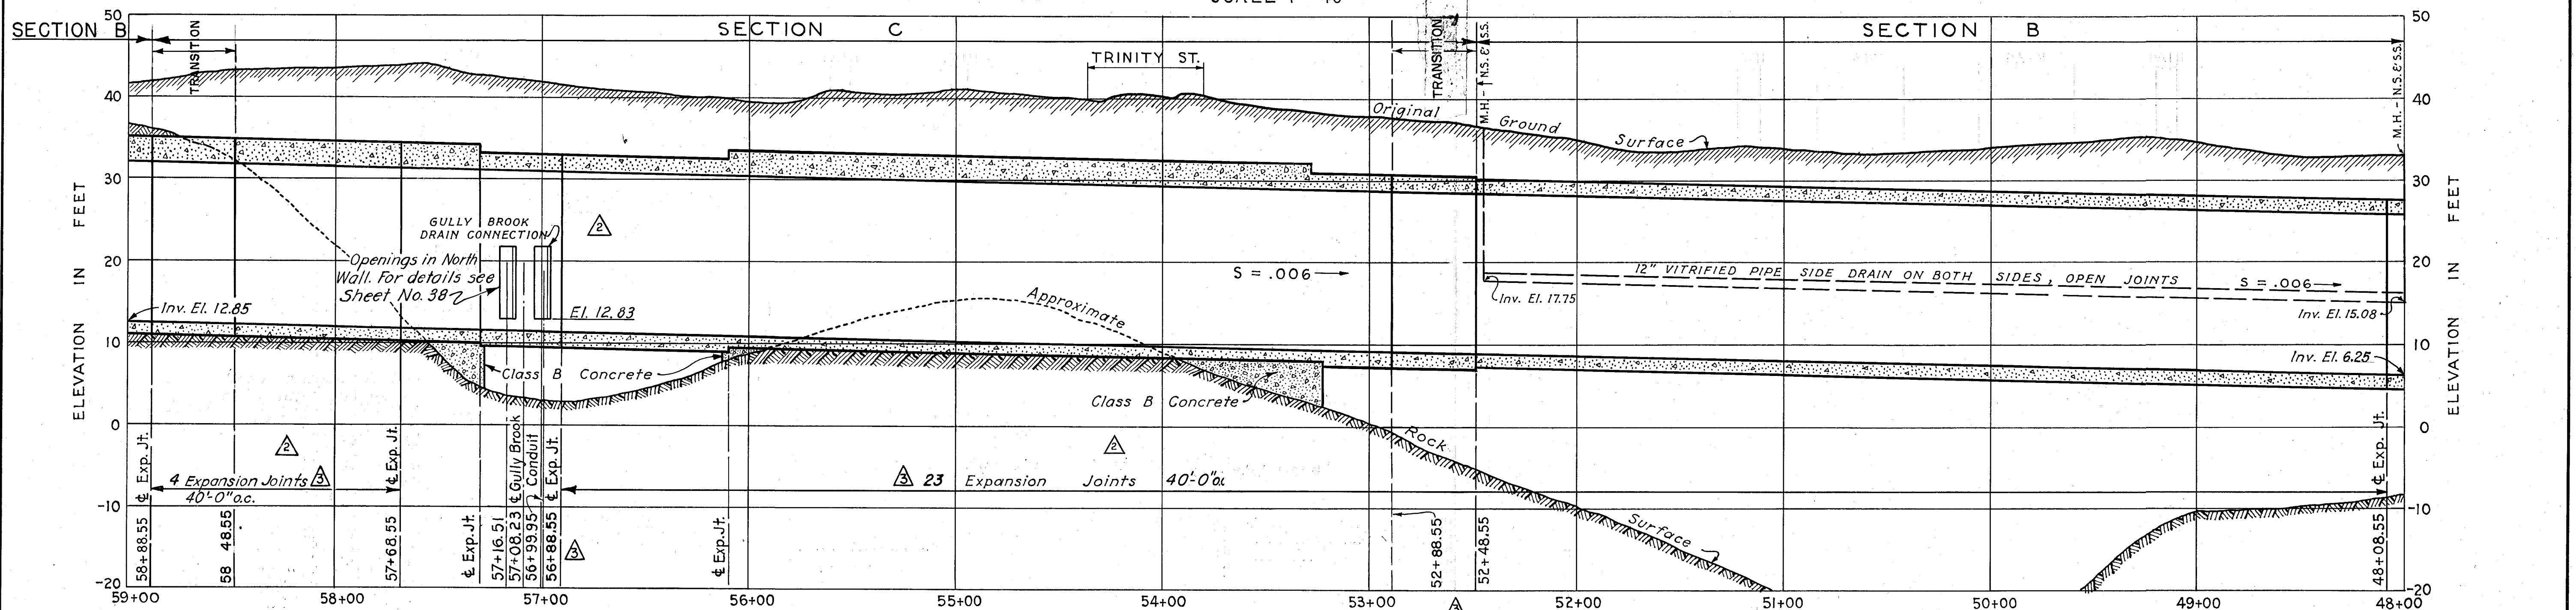


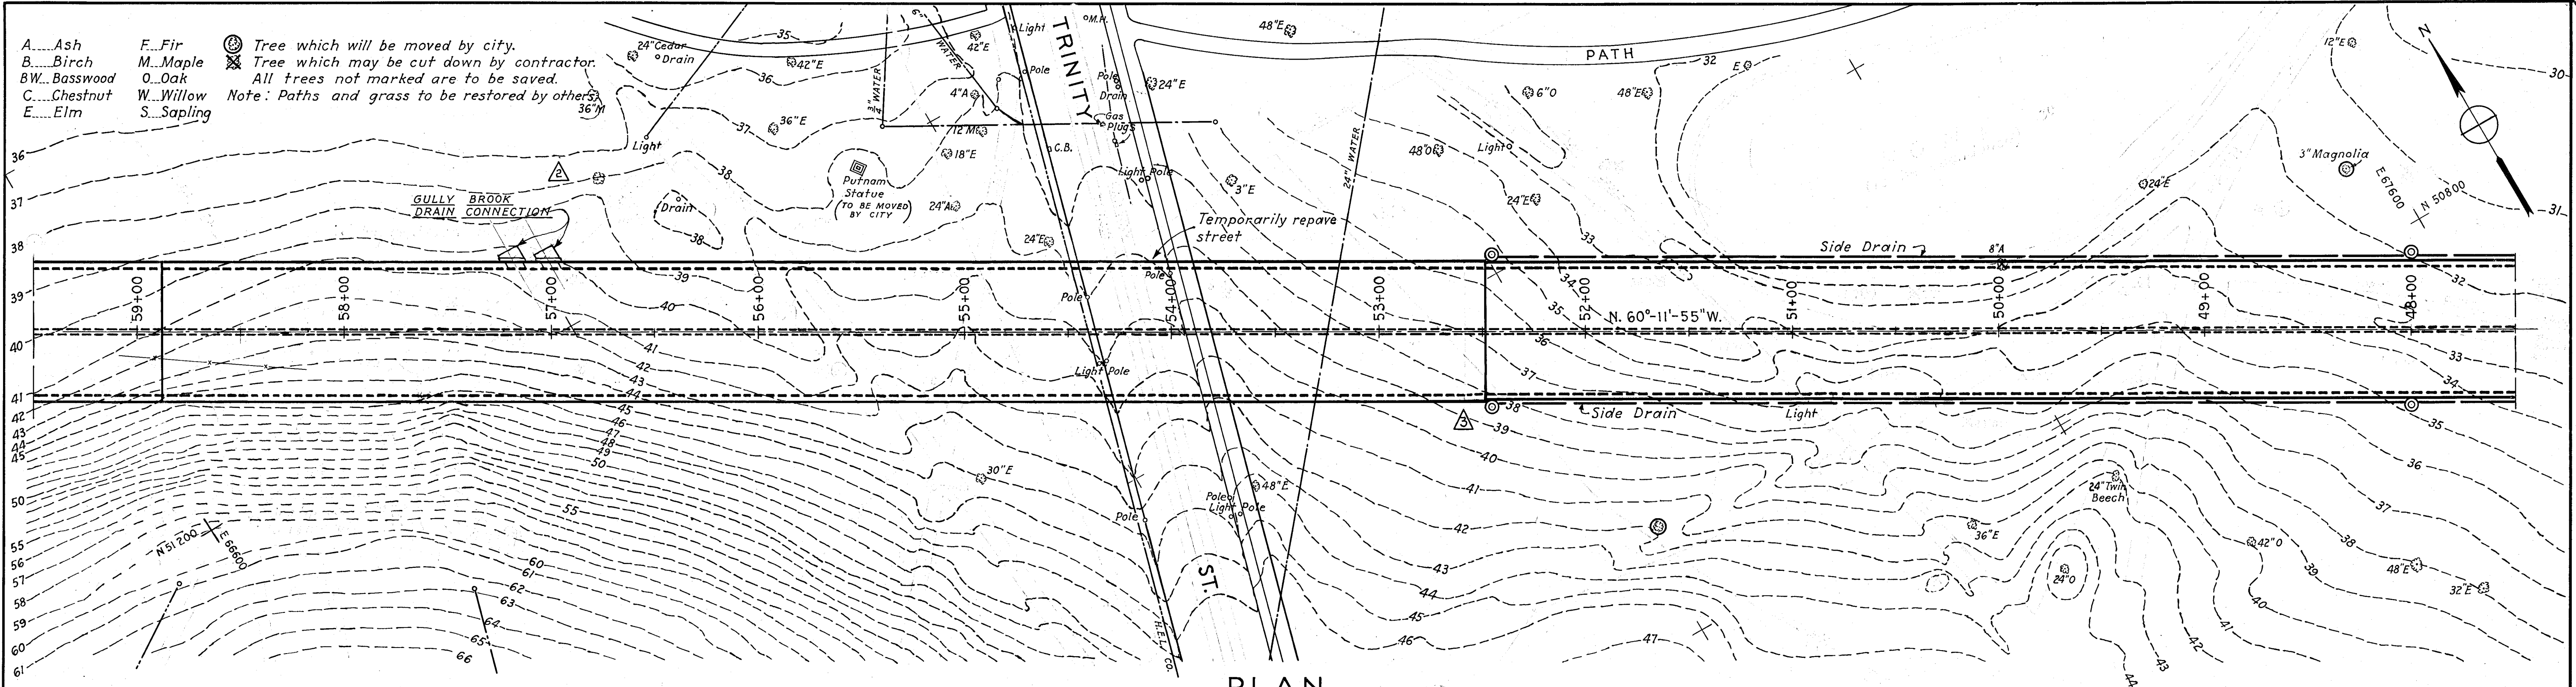

NOTES
For general notes applying to details shown on this sheet, see Sheet No. 10.
See legend on Sheet No. 10.
For detail of treatment at earth-rock junction see Sheet No. 36.

PROFILE
SCALE HOR. 1" = 40'
VERT. 1" = 10'

CONNECTICUT RIVER FLOOD CONTROL
PARK RIVER CONDUIT
HARTFORD, CONN.

PLAN AND PROFILE NO. 5

CONNECTICUT RIVER CONNECTICUT
IN 48 SHEETS SCALE 1" = 40 FT. SHEET NO. 14
50' 0' 50'

U.S. ENGINEER OFFICE PROVIDENCE, R.I. MAY 1940

REVIEWED: *W. H. Hannon* APPROVAL RECOMMENDED: *W. H. Hannon* APPROVED: *W. H. Hannon*
ENGINEER PRINCIPAL ENGINEER LT. COL. CORPS OF ENGINEERS
F.C. DESIGN SECTION CHIEF F.C. ENGINEERING DIV. DISTRICT ENGINEER
SUBMITTED: *W. H. Hannon* (PARTNER) DRAWN BY: H.C.T. FILE NO. CT-4-2612
METCALF & EDDY TRACED BY: H.C.T.
BOSTON, MASS. CHECKED BY: R.W.

METCALF & EDDY
ENGINEERS
BOSTON, MASS.

KEY	DATE	REVISION (indicated by Δ)	REV. BY	CK. BY	AP. BY
Δ	12-31-45	As built revisions			
Δ	2-17-41	Transitions and opening changed	SC	MM	JHB
Δ	11-22-40	Openings and Exp. Joints	P.C.H.	K.B.N.	JHB