
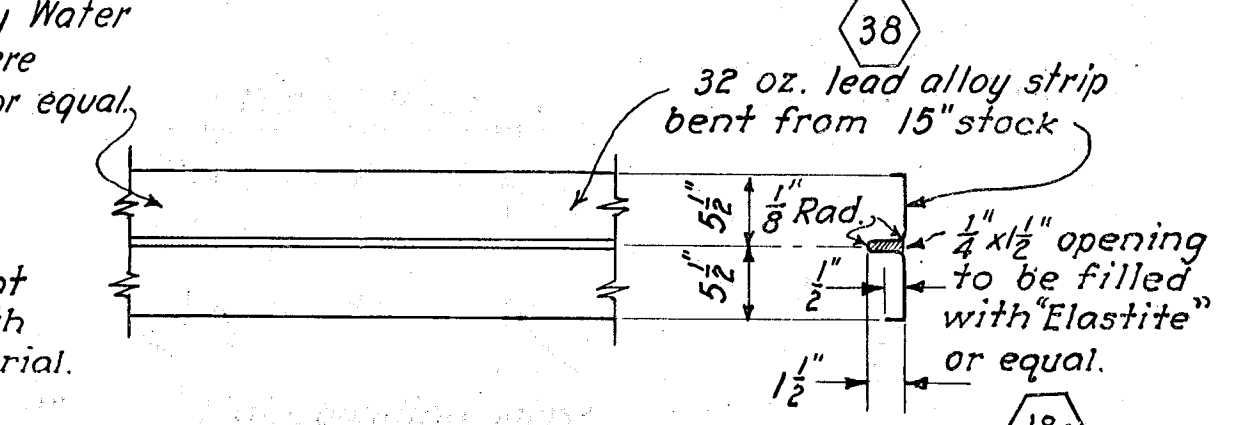
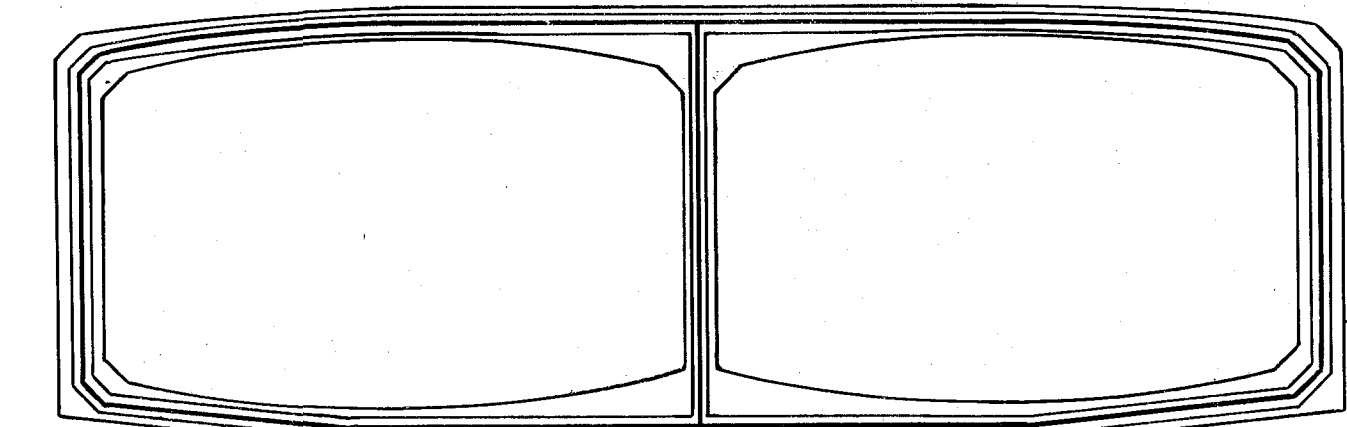
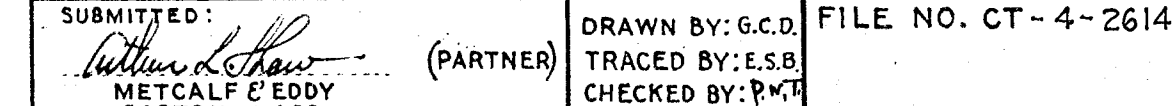
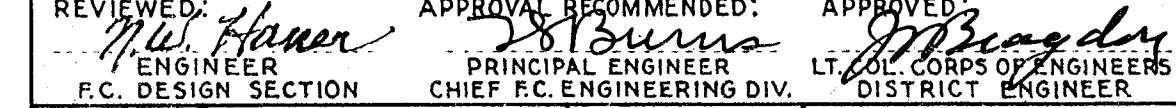
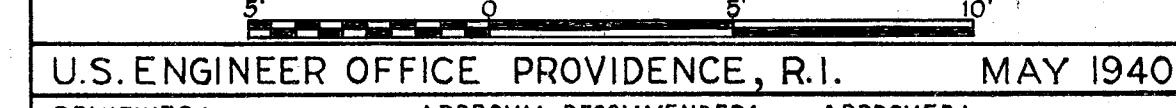
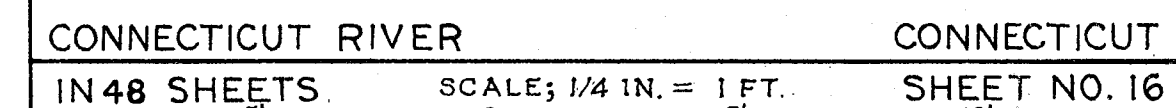


RECORD
DRAWINGS

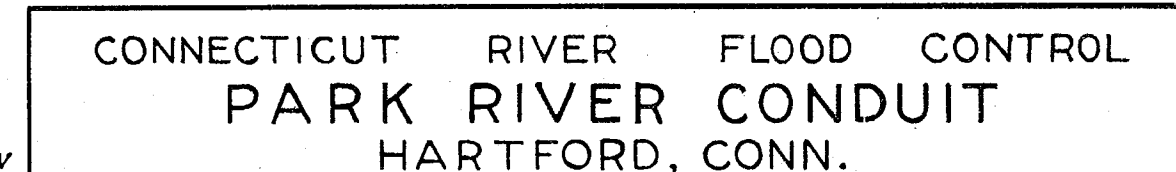

	12-31-45	As built revisions	783		
3	2-17-41	Top center wall fillet added.	100	121	28B
9	7-14-42	Water stop revised.	500	100	28B
12	11-22-40	Class "B" concrete Sect A and Notes	100	KB-N	8B
KEY	DATE	REVISION (Indicated by Δ)	REV.	CK. BY	AP. BY

Furnishing, bending and placing of steel reinforcement will be paid for under Item No. 19.

All concrete in contact with the structural concrete of the conduit such as 6" pile capping, concrete filling below grade, siphons or sewers under the conduit, shall be poured and allowed to harden before construction of the conduit itself.

For detail of anchor bars for curbs see Sheet No. 39.

For detail of construction joint see Sheet No. 39.

Concrete except as noted to be Class "A" paid for under Item No. 18a.

BOSTON, MASS.