


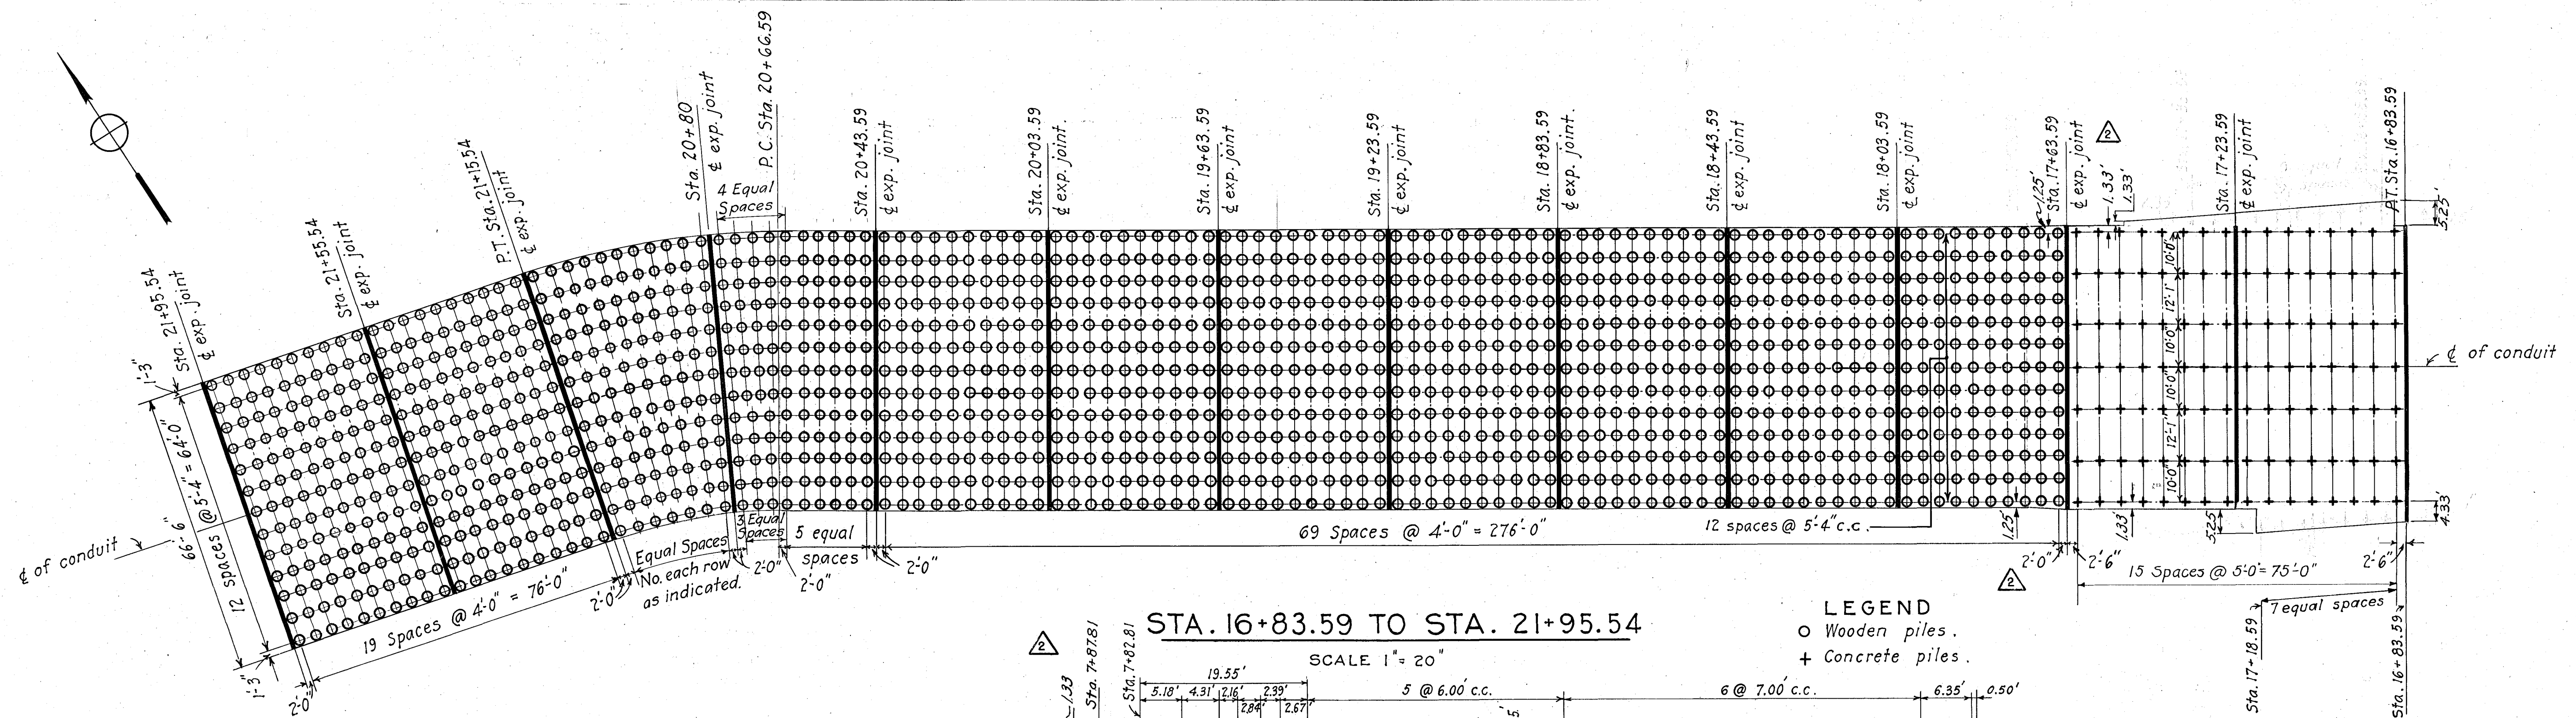


STA. 16+83.59 TO STA. 21+95.54

SCALE 1" = 20'

LEGEND


- Wooden piles.
+ Concrete piles.

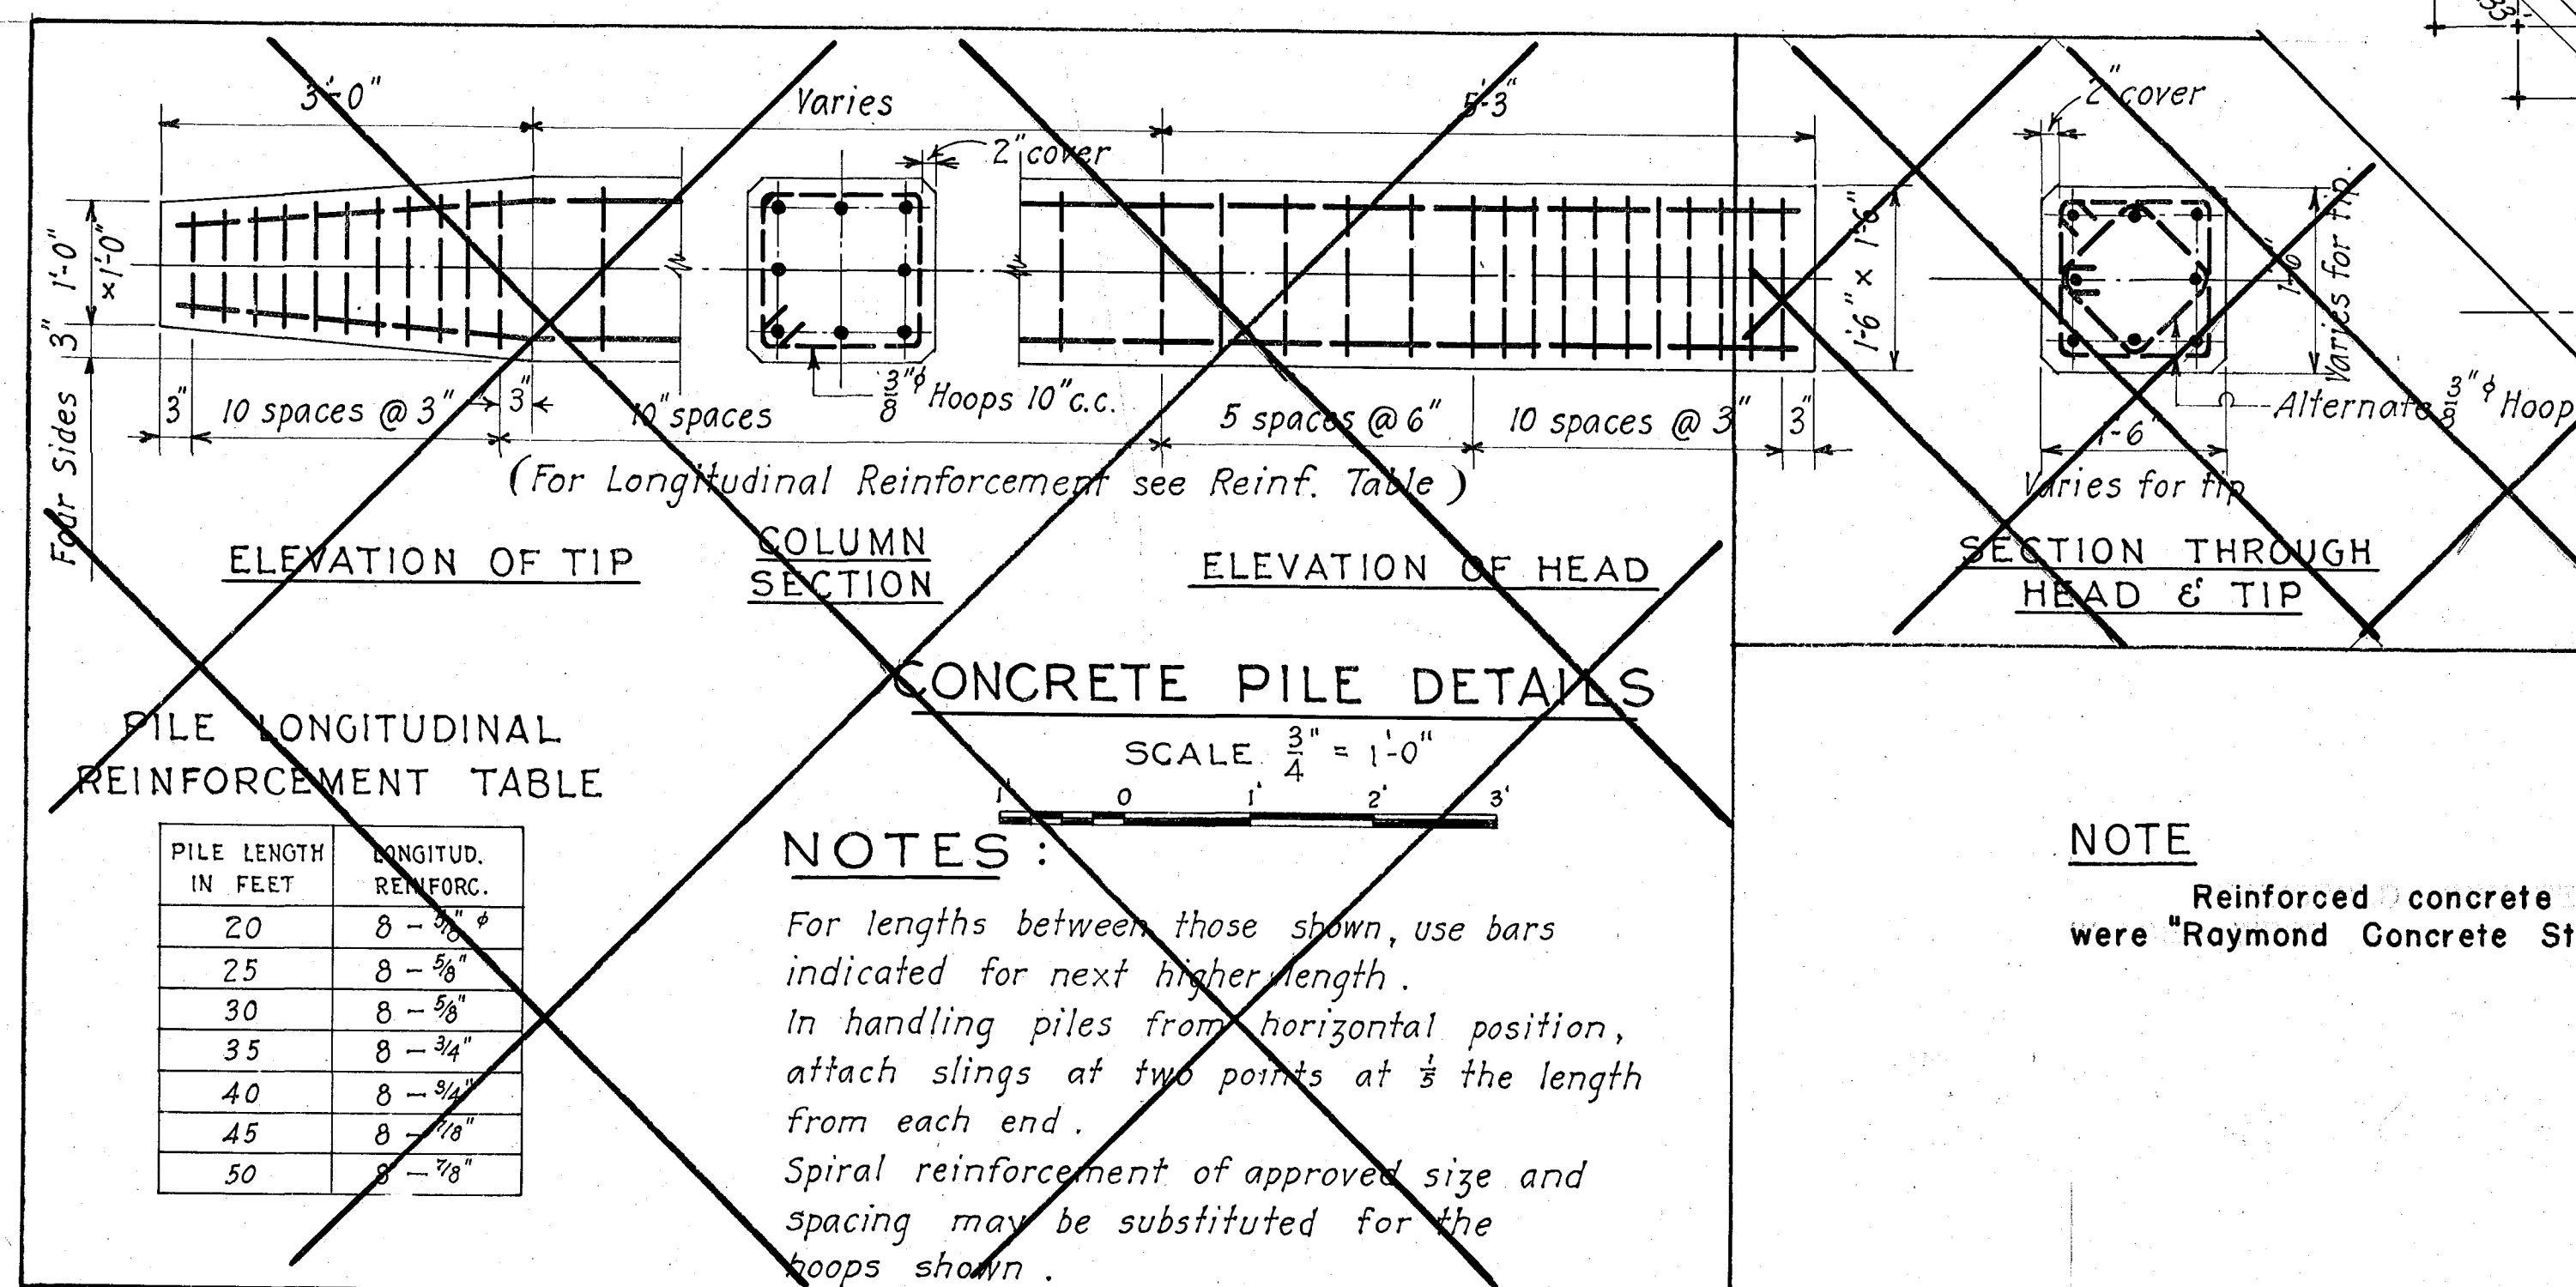

NOTE

Reinforced concrete piles placed were "Raymond Concrete Step Taper Piles."

PILE LOCATION AT OUTLET

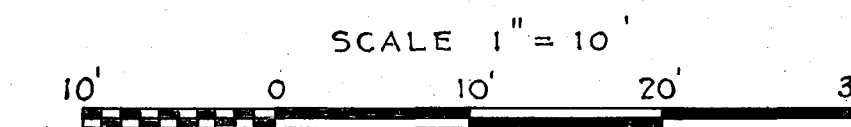

METCALF & EDDY
ENGINEERS
BOSTON, MASS.

RECORD
DRAWINGS

12-31-45	As built revisions				
11-22-40	Dimensions changed	P.C.H.	K.B.N.	P.B.	
KEY	DATE	REVISION (Indicated by Δ)	REV. BY	CK. BY	AR. BY

CONNECTICUT RIVER FLOOD CONTROL
PARK RIVER CONDUIT
HARTFORD, CONN.

PIILING NO. 2

CONNECTICUT RIVER CONNECTICUT
IN 48 SHEETS, SCALE 1 IN. = 20 FT. SHEET NO. 19

U.S. ENGINEER OFFICE PROVIDENCE, R.I. MAY 1940

REVIEWED: P.W. Hower ENGINEER F.C. DESIGN SECTION	APPROVAL RECOMMENDED: P.W. Hower PRINCIPAL ENGINEER CHIEF F.C. ENGINEERING DIV.	APPROVED: M. J. Magdon LT. COL. CORPS OF ENGINEERS DISTRICT ENGINEER
SUBMITTED: M. J. Magdon METCALF & EDDY BOSTON, MASS.	(PARTNER)	DRAWN BY: F.F. TRACED BY: C.W.R. CHECKED BY: P.M.T.