

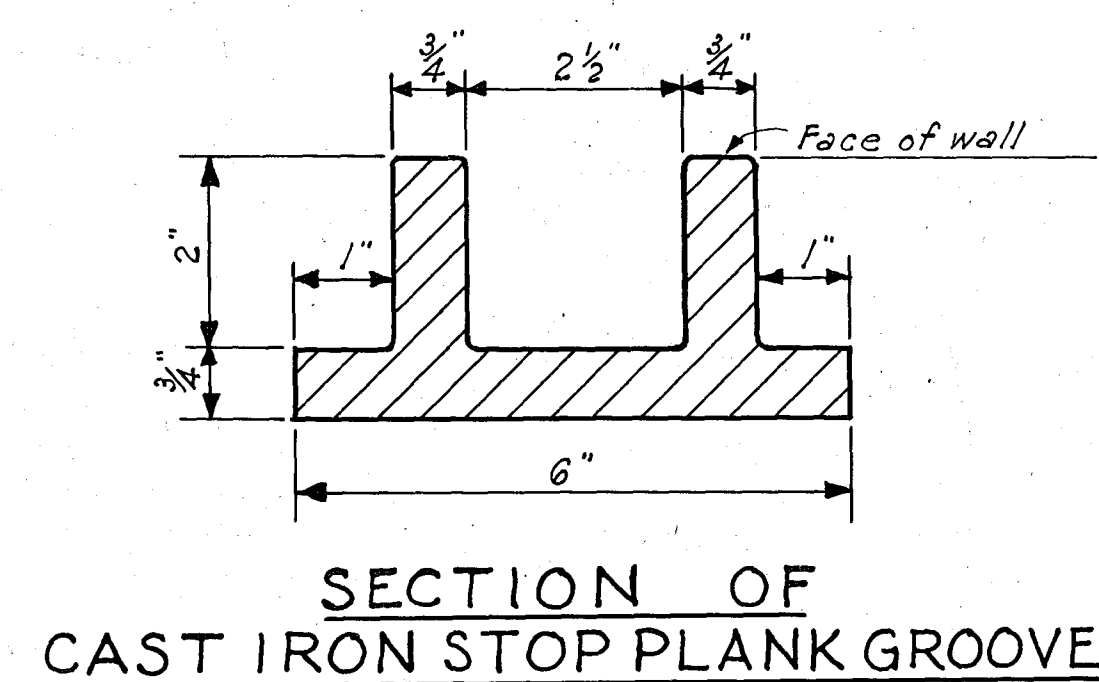
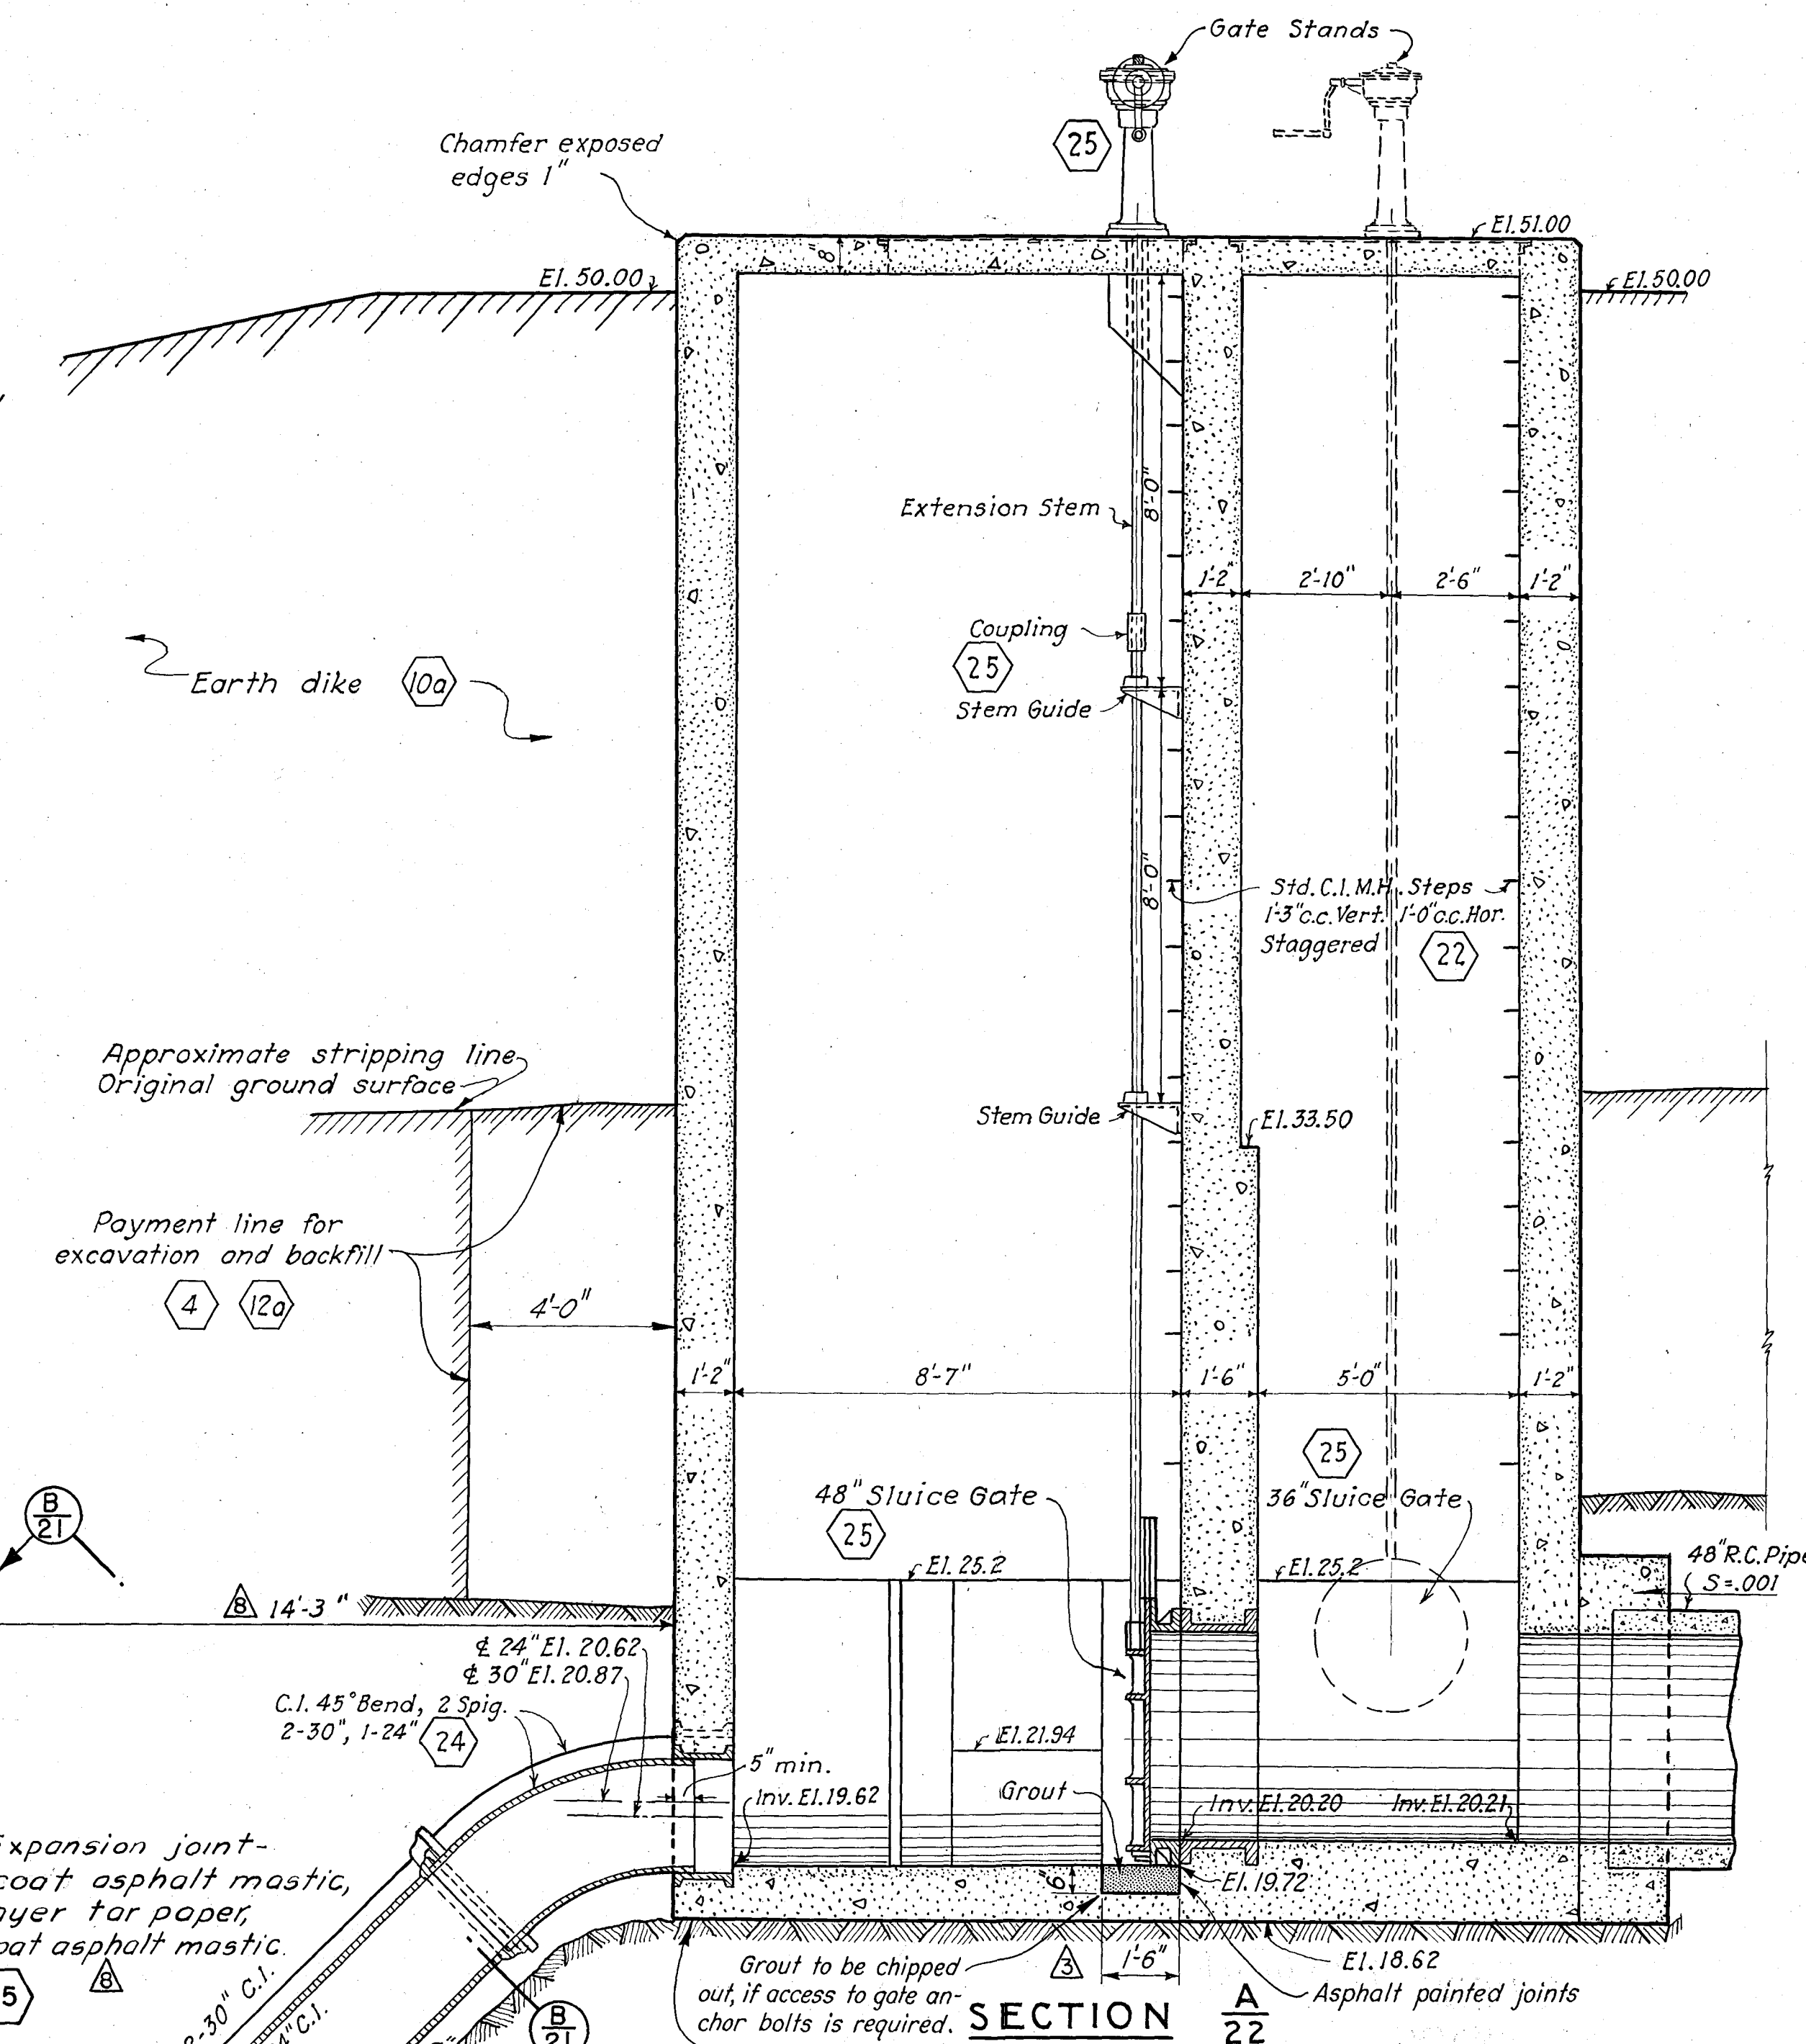
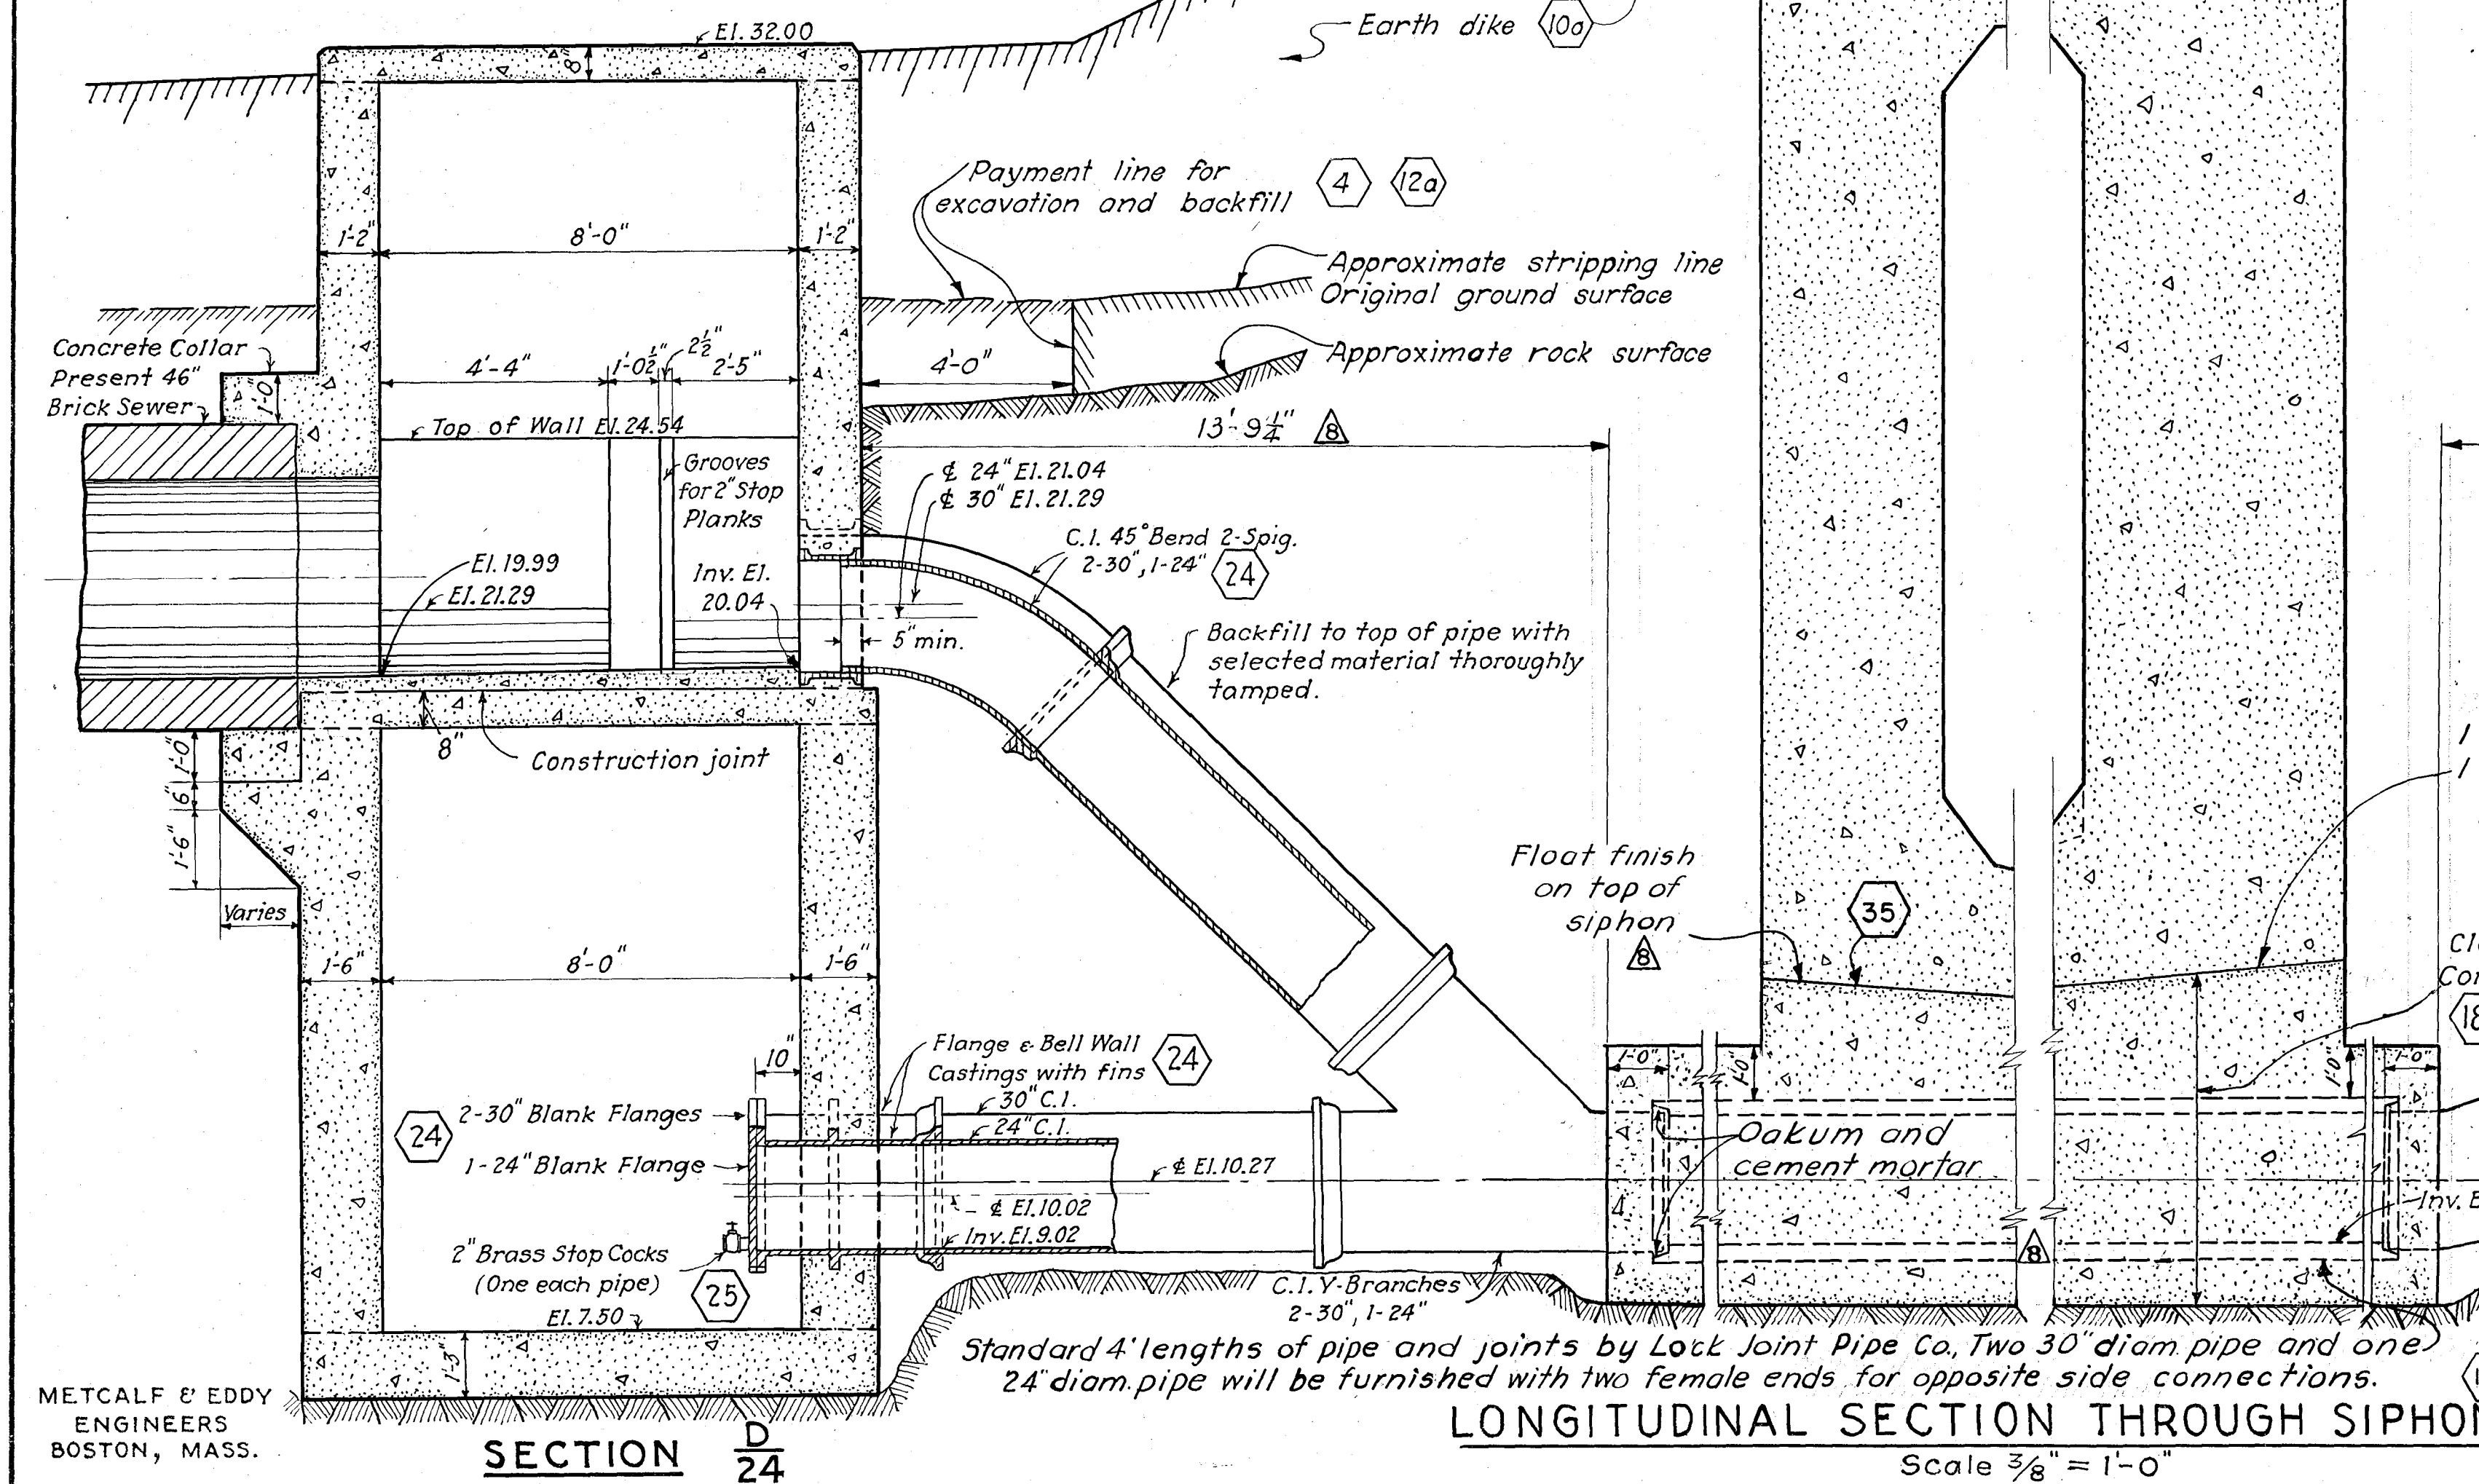


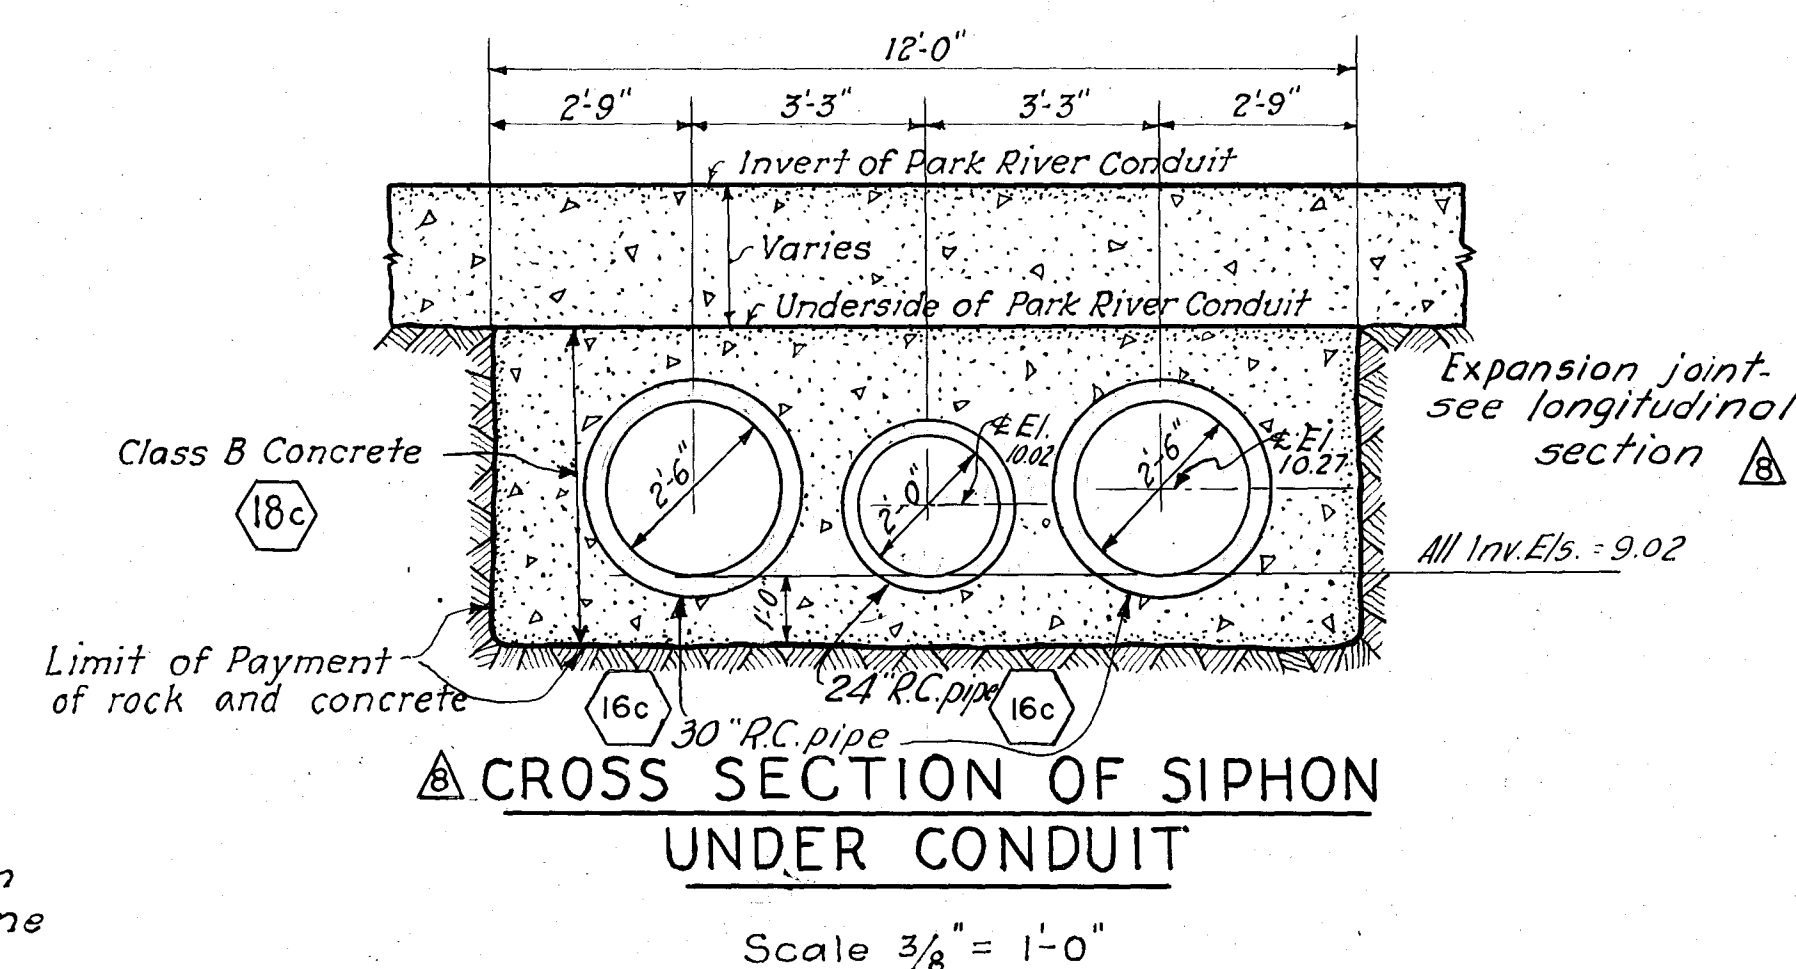

1" 0 1" 2" 3"

6 Required 5'-7" 1'g
6 do. 4'-6" 1'g

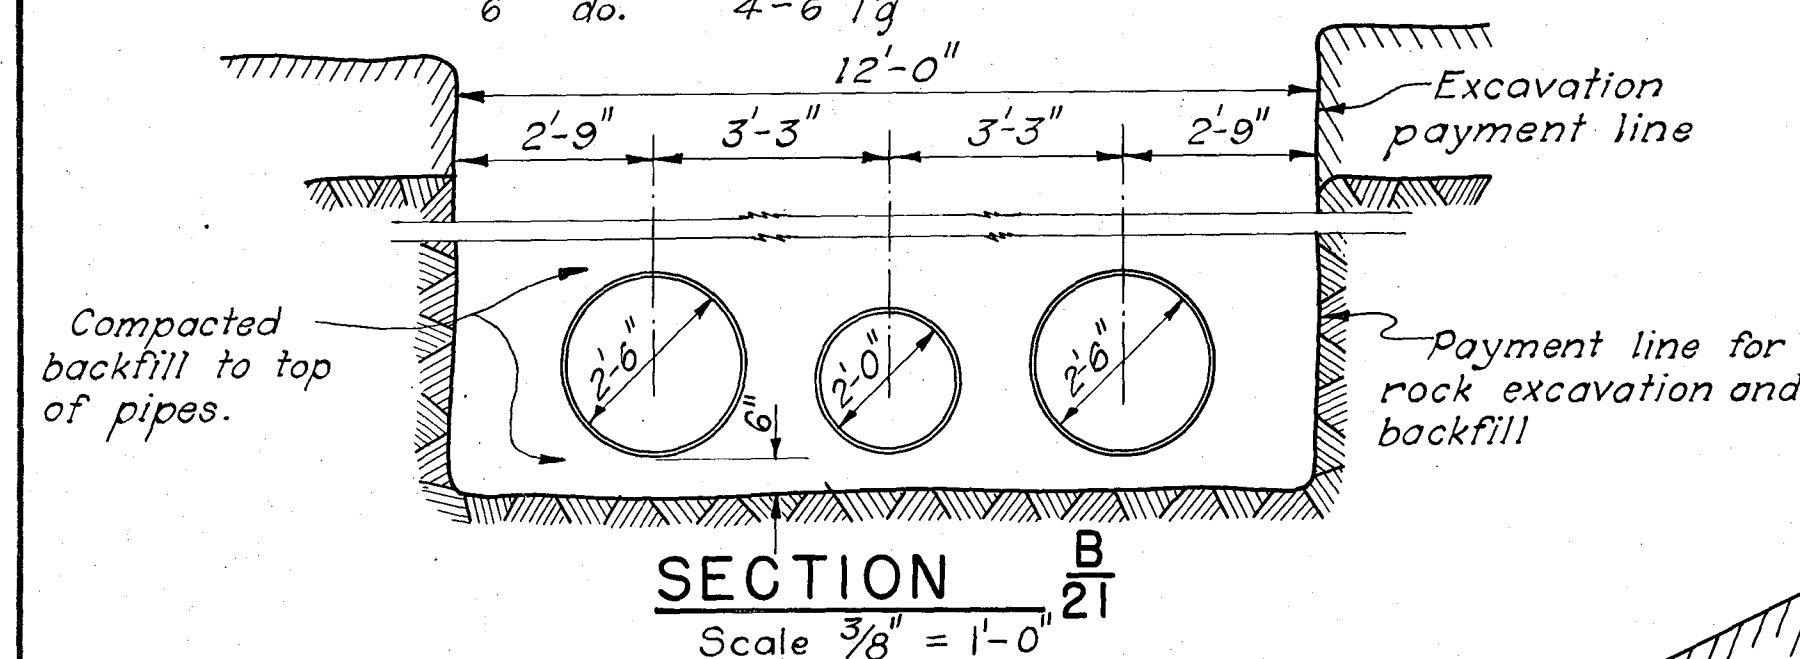

RECORD
DRAWINGS

CONNECTICUT RIVER FLOOD CONTROL PARK RIVER CONDUIT HARTFORD, CONN. PARK RIVER INTERCEPTOR SIPHON DETAILS NO. 2			
CONNECTICUT RIVER		CONNECTICUT	
IN 40 SHEETS	SCALE: 3/8 IN. = 1 FT.	SHEET NO. 2	
			
U.S. ENGINEER OFFICE PROVIDENCE, R.I.			MAY 1940
REVIEWED <i>W. C. Hance</i> ENGINEER F.C. DESIGN SECTION	APPROVAL RECOMMENDED: <i>W. C. Hance</i> PRINCIPAL ENGINEER CHIEF F.C. ENGINEERING DIV.	APPROVED <i>W. C. Hance</i> LTCOL. CORPS OF ENGINEERS DISTRICT ENGINEER	
SUBMITTED: <i>Arthur C. Eddy</i> METCALF & EDDY BOSTON, MASS.	(PARTNER)	DRAWN BY: E.F.M. TRACED BY: E.S.B. CHECKED BY: J.W.T.	FILE NO. CT-4-2619

METCALF & EDDY
ENGINEERS
BOSTON, MASS.

SECTION D
24

LONGITUDINAL SECTION THROUGH SIPHON

Scale $\frac{3}{8}'' = 1'-0''$

KEY	DATE	REVISION (Indicated by Δ)	REV. BY	CK. BY	AP. BY
Δ	12-31-45	As built			
Δ	4-22-42	Expansion joint added, pipe changed	E.P.A.		
Δ	2-17-41	Grout recess added	J.C.		