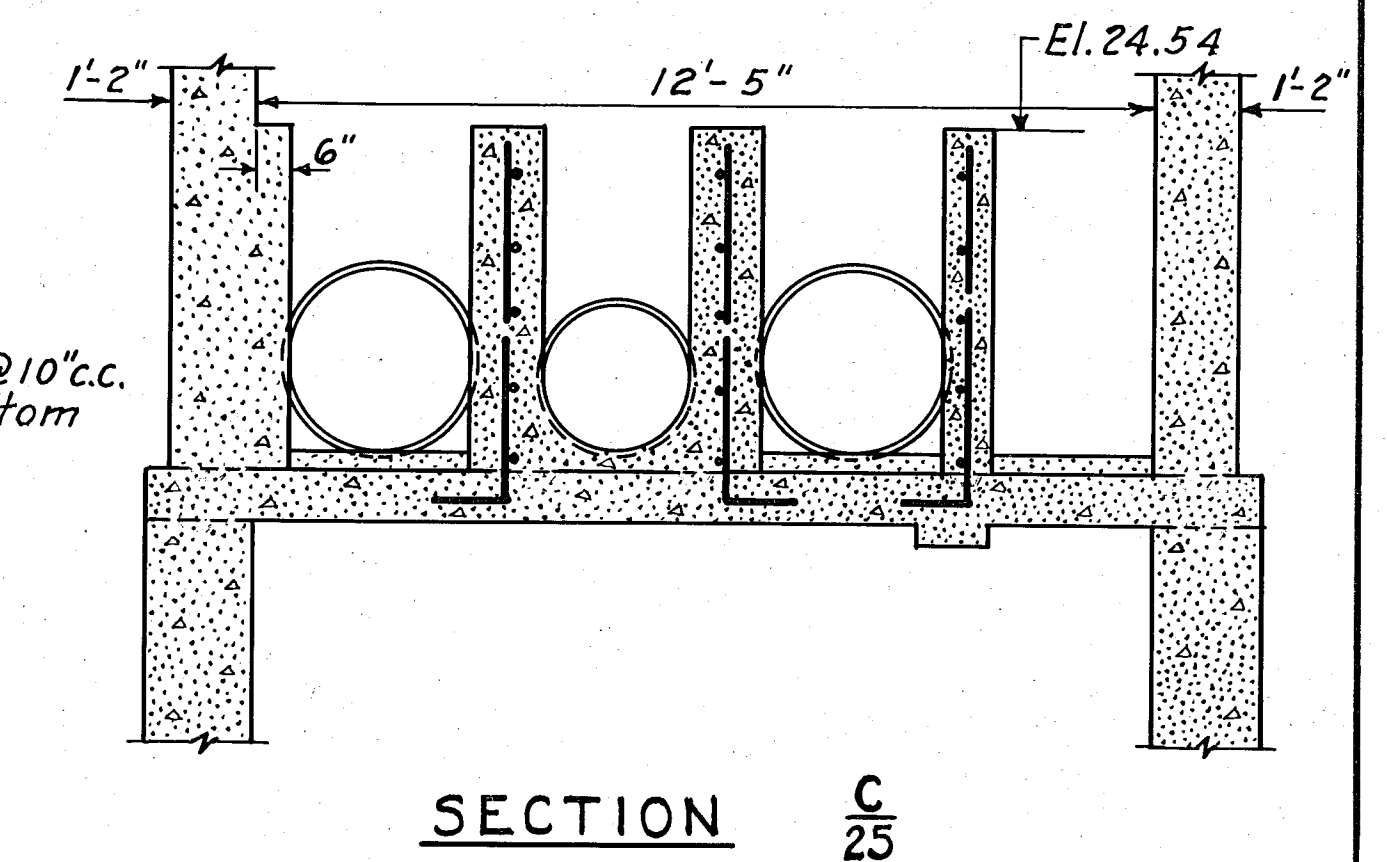


RECORD
DRAWINGS

	12-31-45	As built				
KEY	DATE	REVISION (Indicated by Δ)	REV. BY	CK. BY	AP. BY	

CONNECTICUT RIVER FLOOD CONTROL PARK RIVER CONDUIT HARTFORD, CONN.	
SIPHON OUTLET CHAMBER STEEL REINFORCEMENT	
CONNECTICUT RIVER	CONNECTICUT
IN 48 SHEETS	SCALE: $\frac{3}{8}$ IN = 1 FT. 
U.S. ENGINEER OFFICE PROVIDENCE, R.I.	
REVIEWED BY: <i>W.H. Fawcett</i> ENGINEER	APPROVAL RECOMMENDED: <i>W.H. Fawcett</i> CHIEF F.C. ENGINEERING DIV.
SUBMITTED: <i>W.H. Fawcett</i> METCALF & EDDY BOSTON, MASS.	APPROVED: <i>W.H. Fawcett</i> LT. COL. CORPS OF ENGINEERS DISTRICT ENGINEER
(PARTNER)	DRAWN BY: F.F. TRACED BY: W.H.F. CHECKED BY: J.W.T.
FILE NO. CT-4-26-23	

11-14-2