
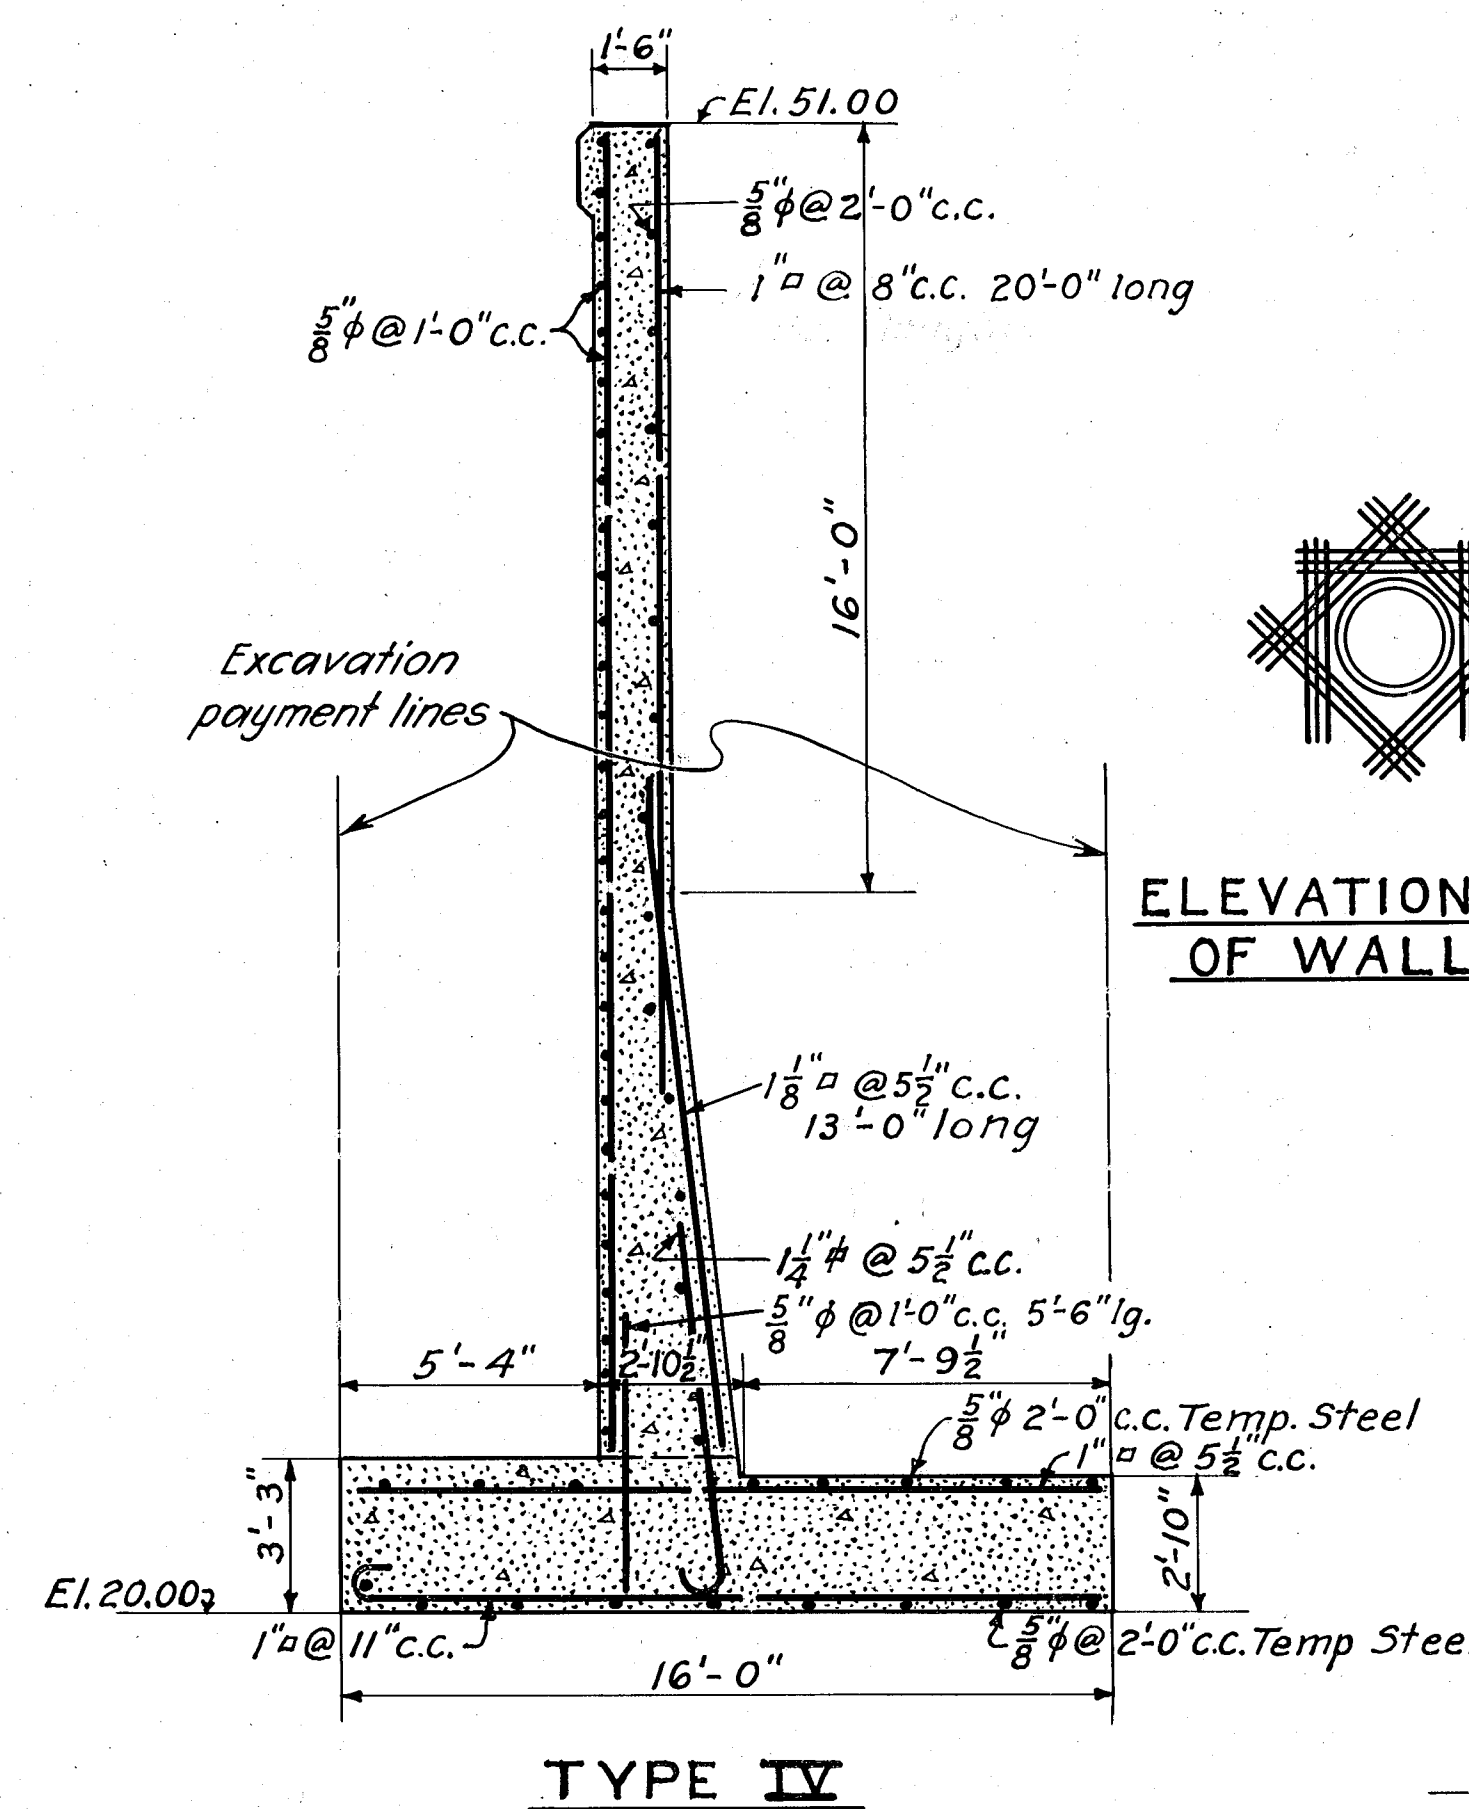
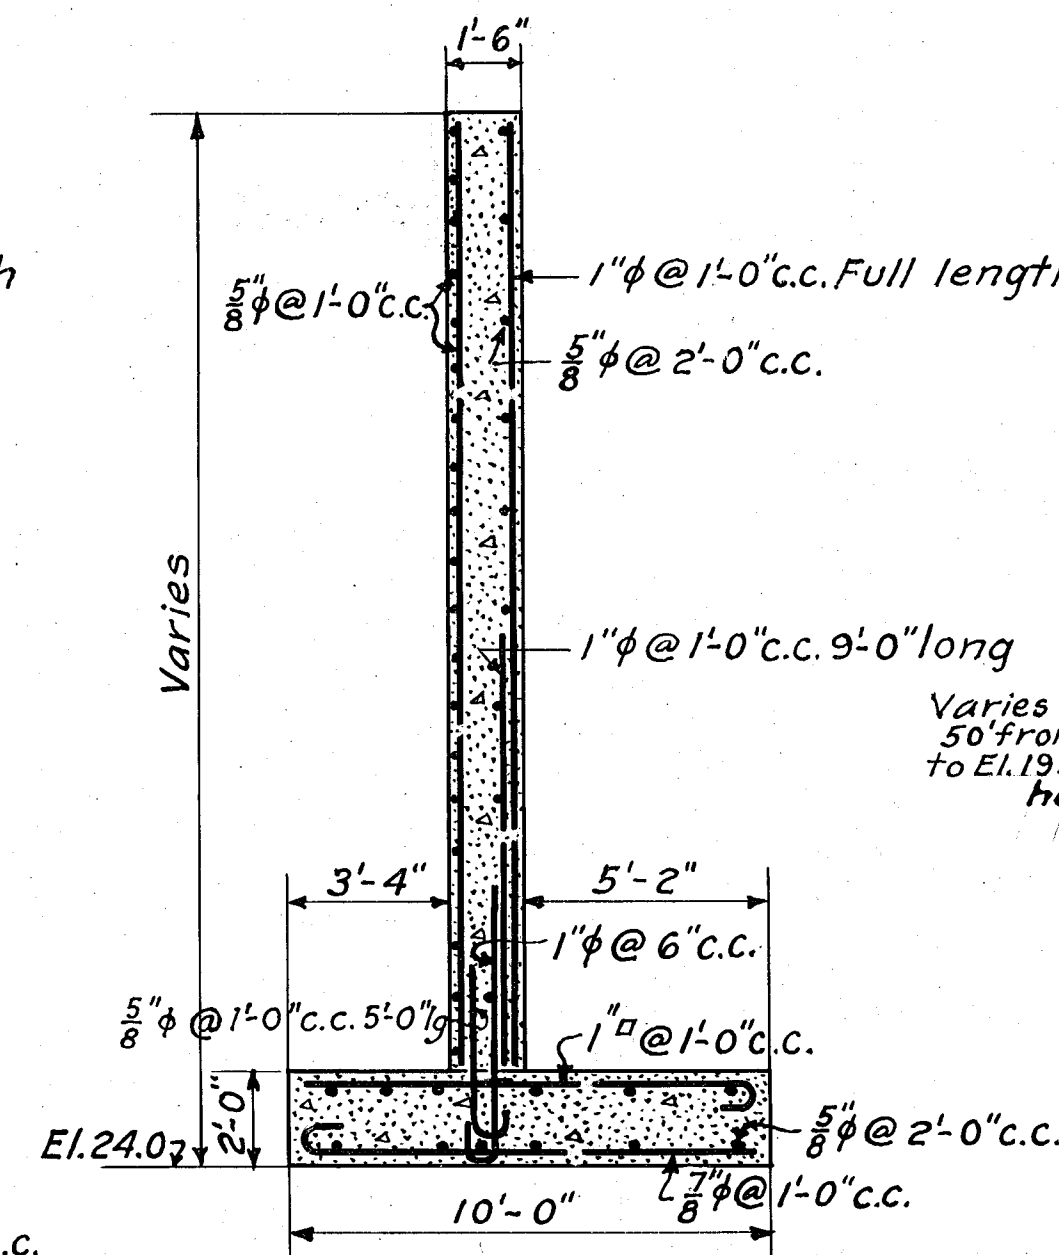
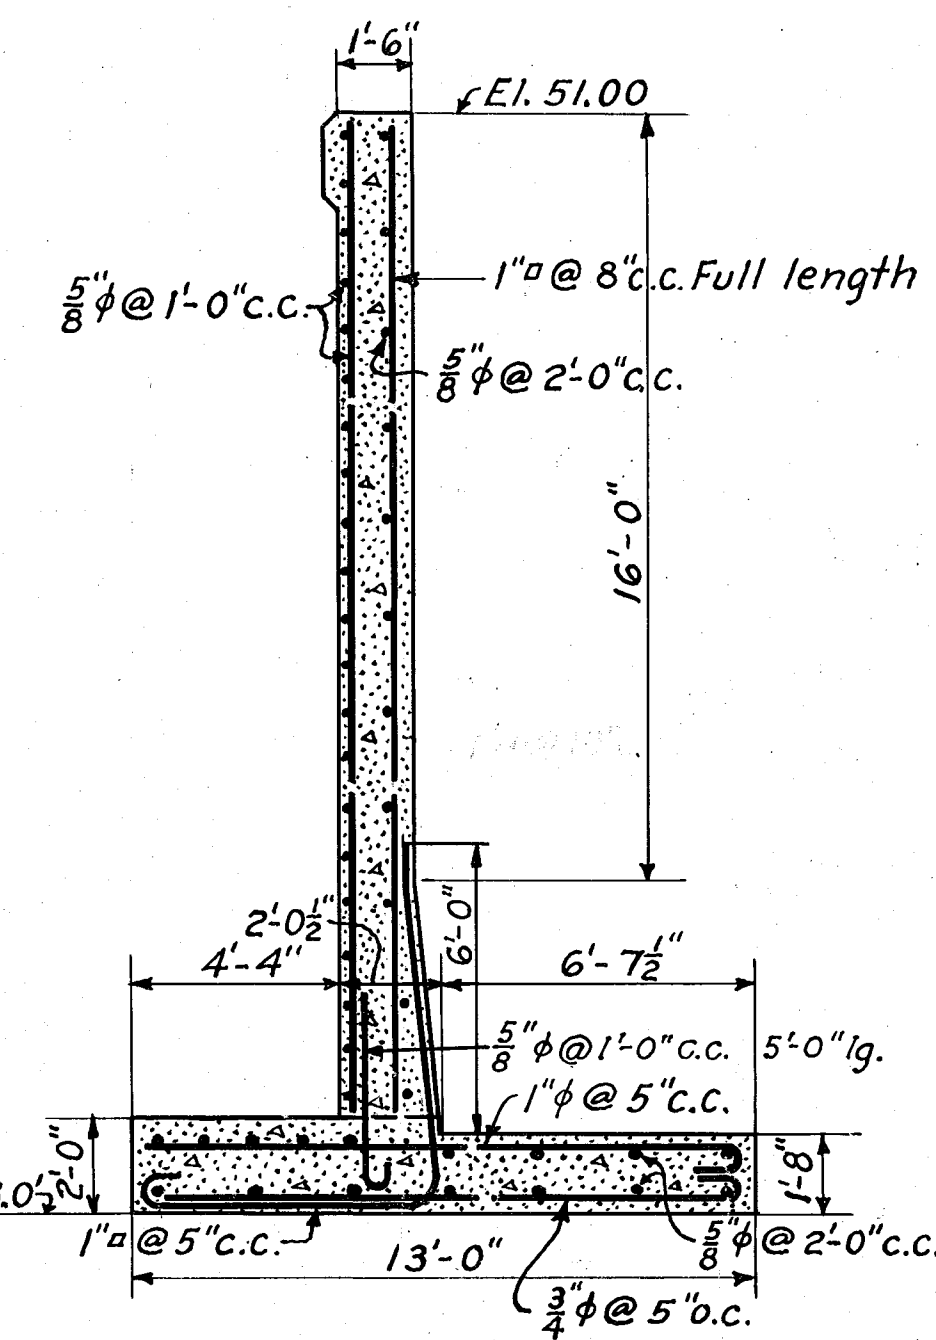
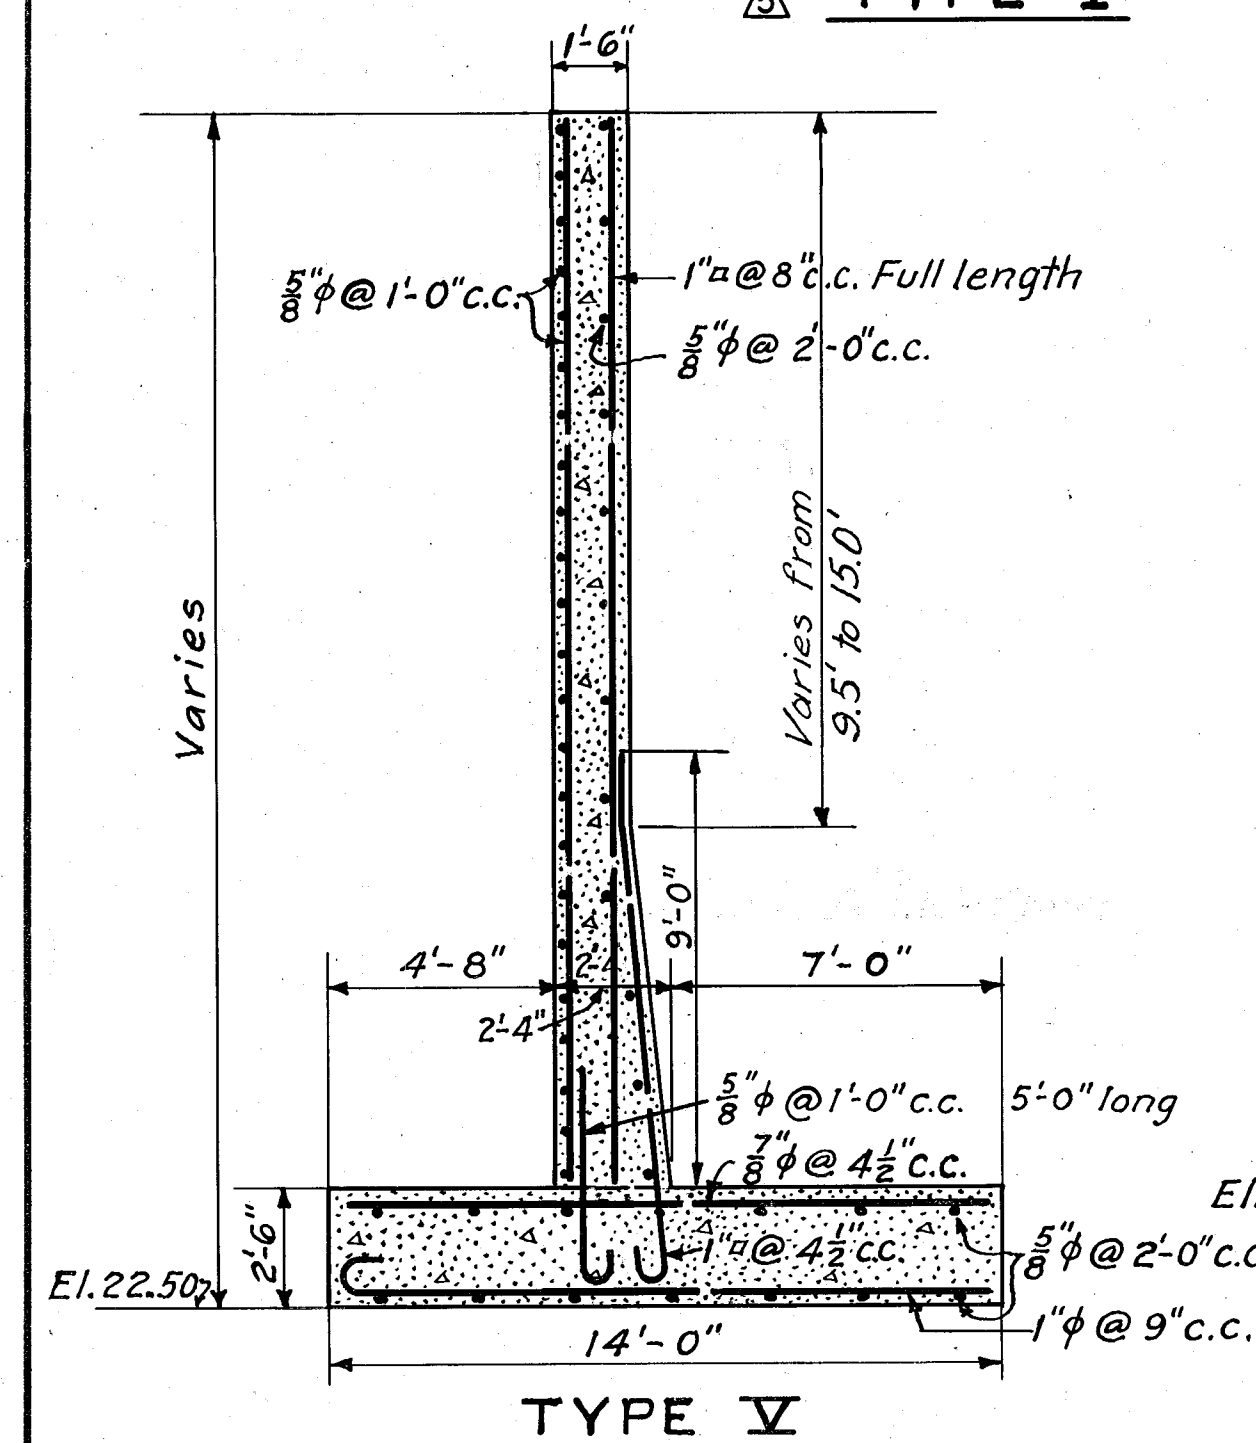
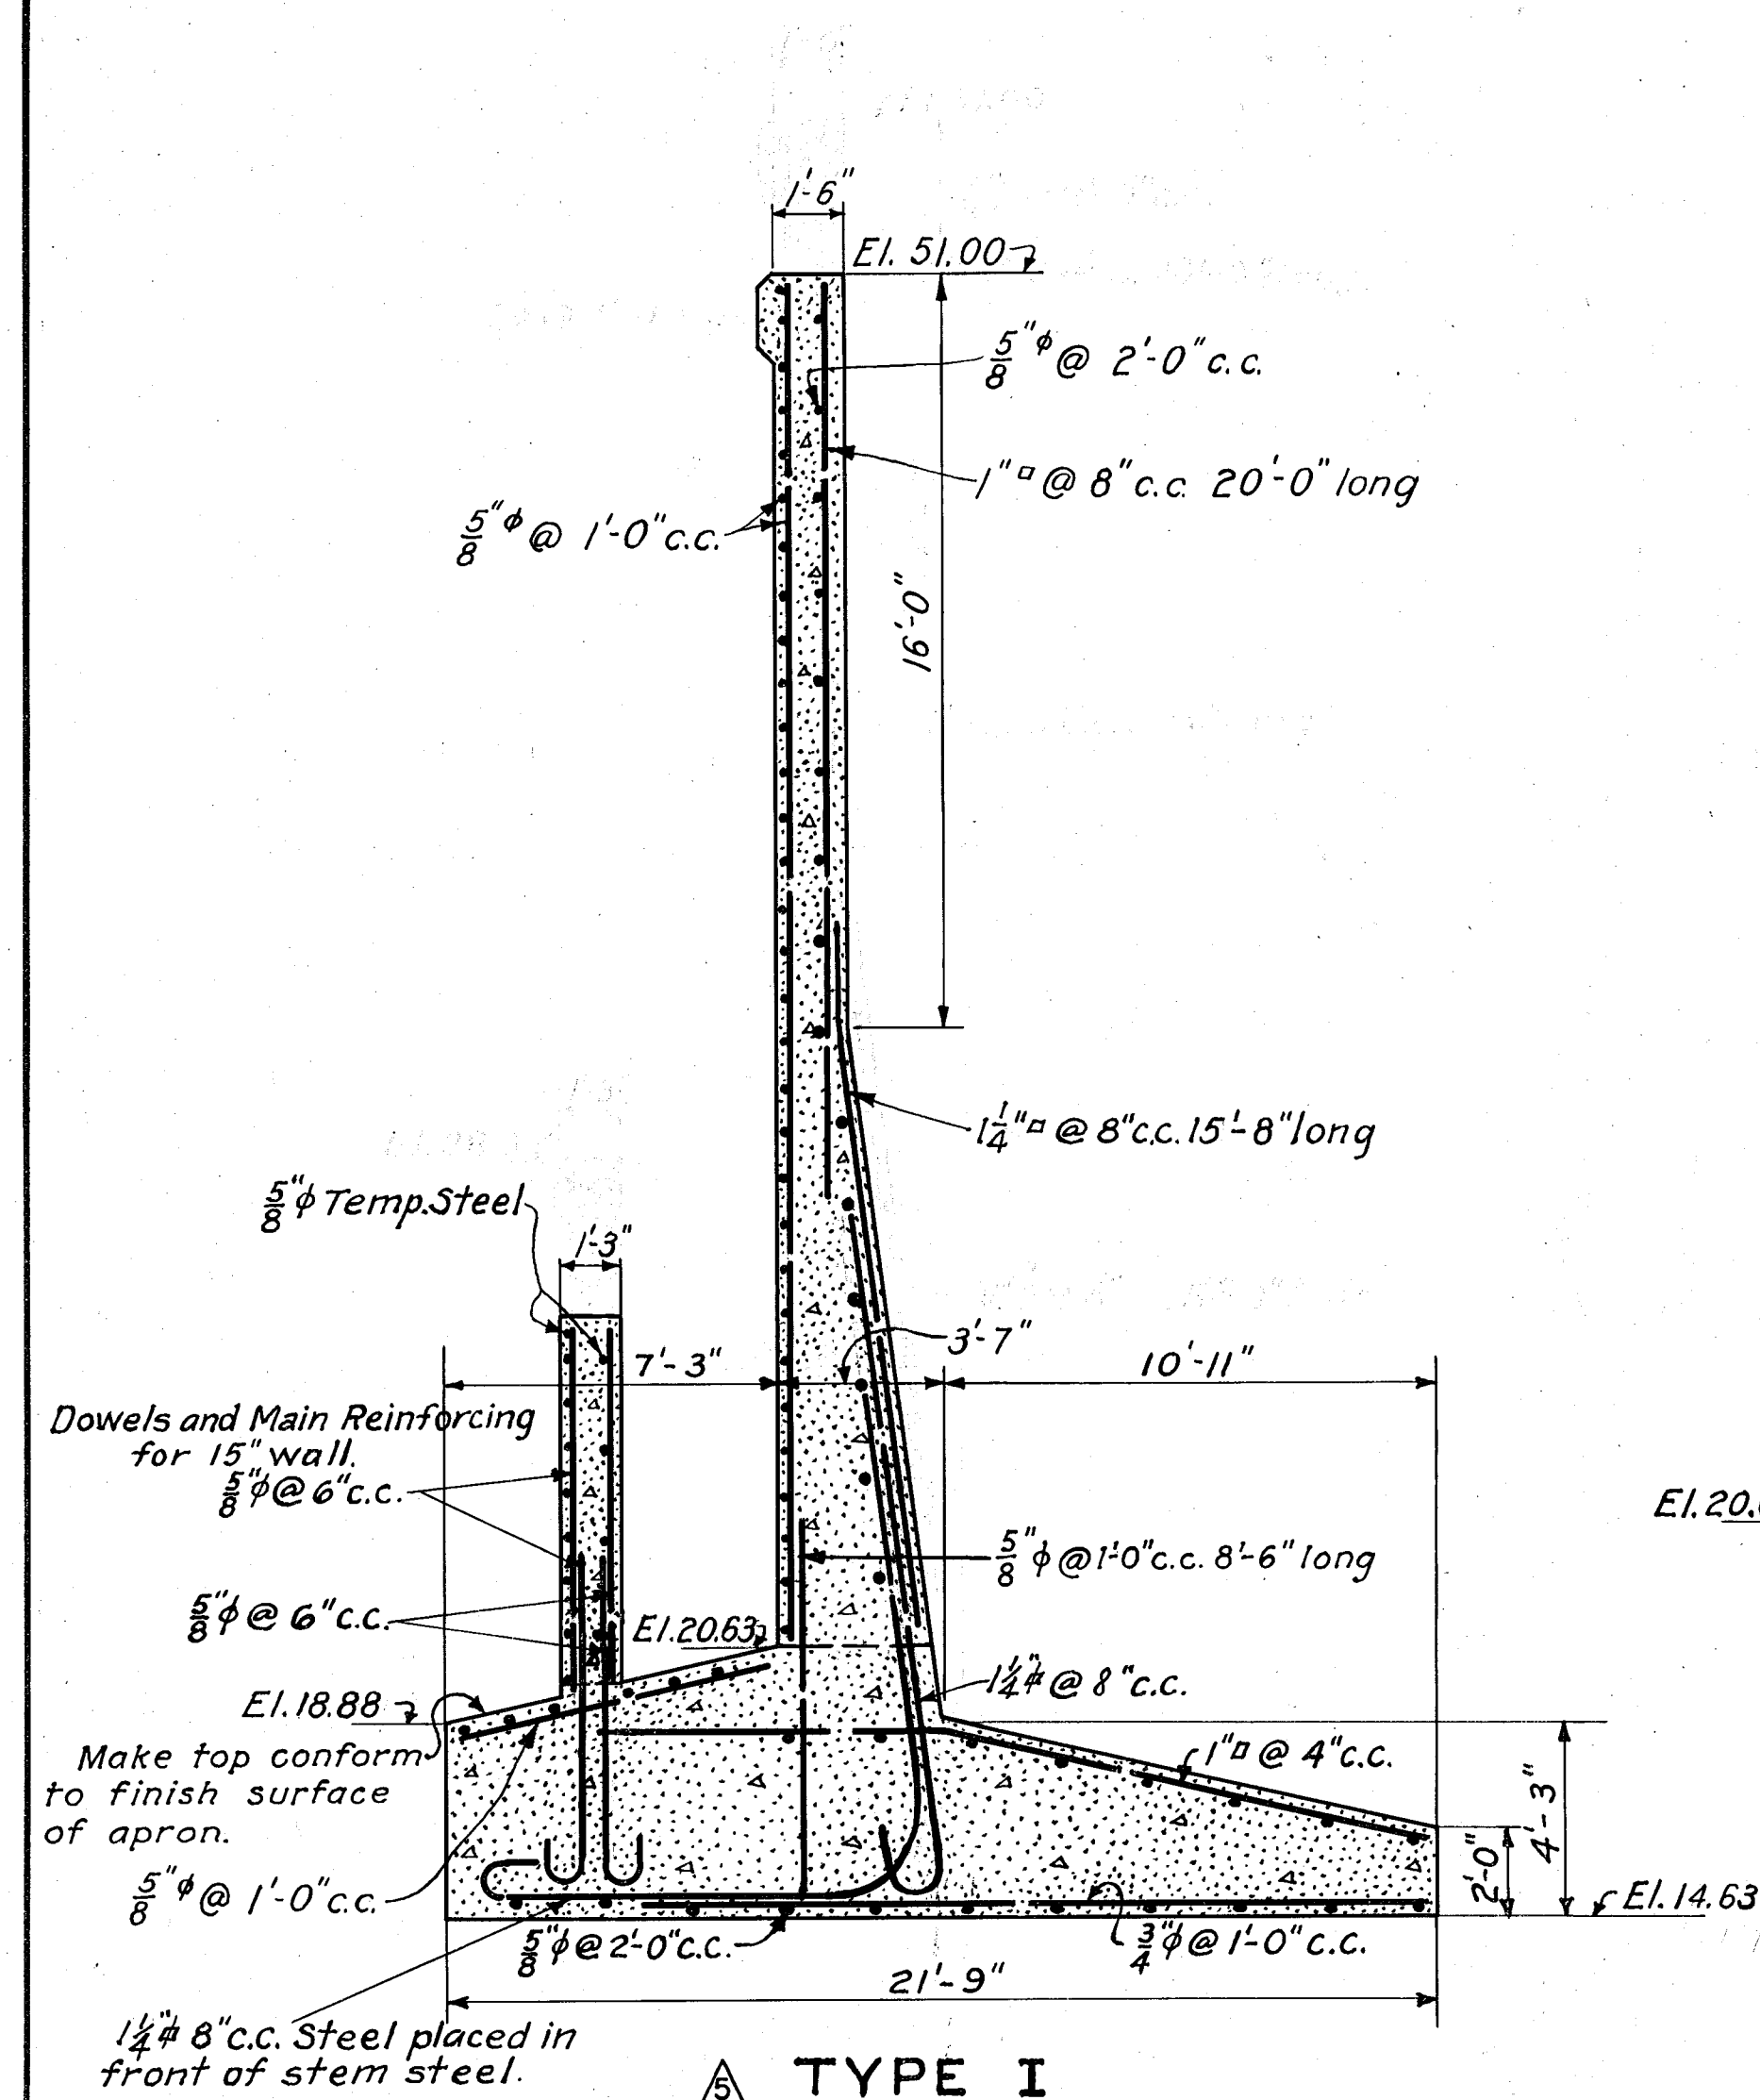
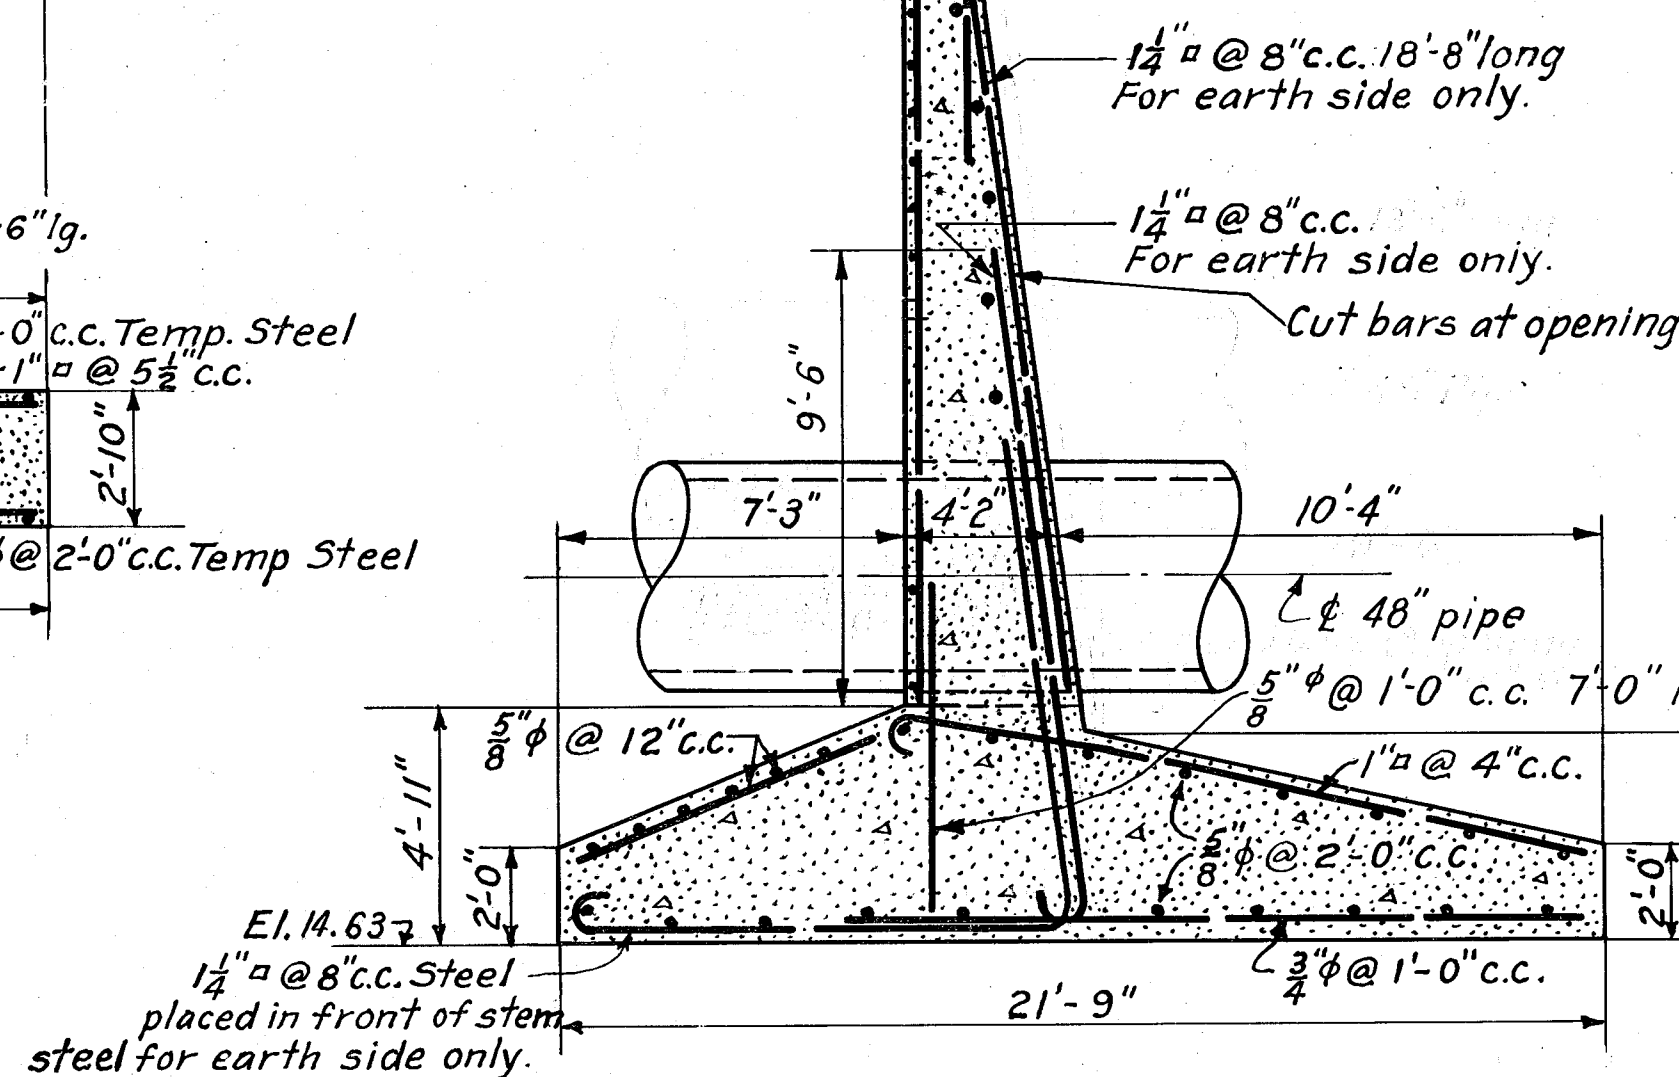
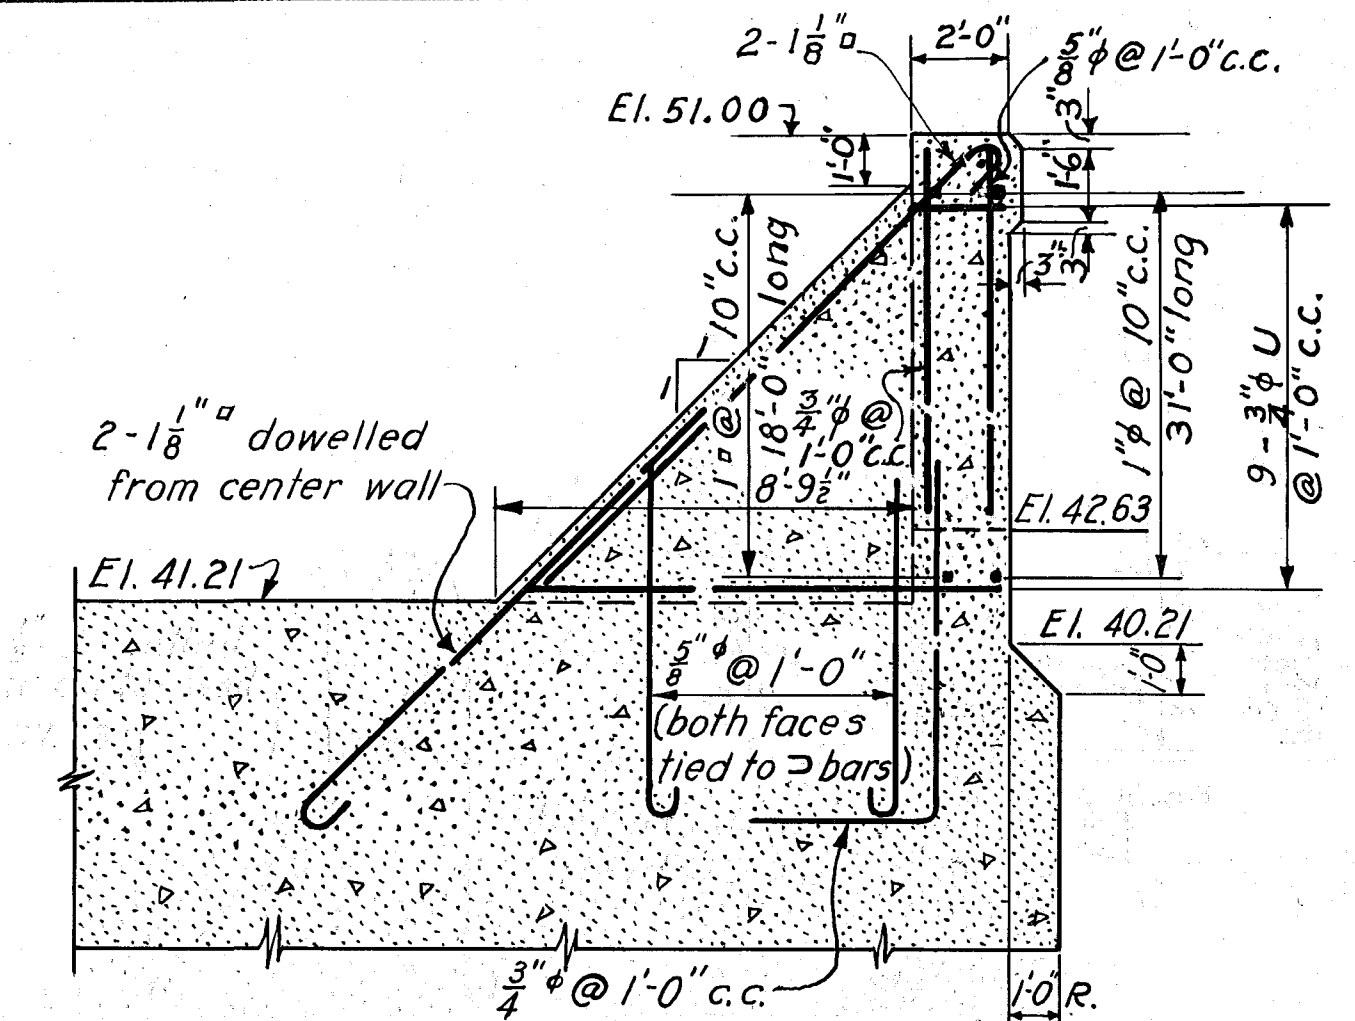
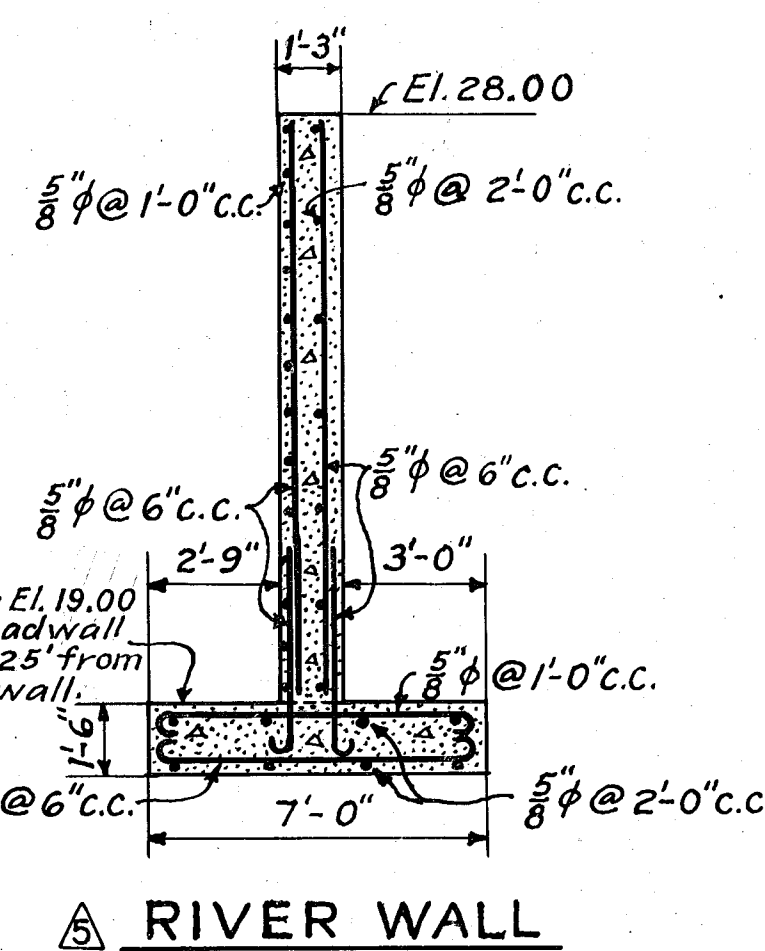


ELEVATION - EARTH SIDE
OF WALL AT PIPE

Diagonal bars
1" @ 4' c.c. 9'-6" lg.
Hor. & Vert. bars
1" @ 4' c.c. 8'-0" lg.

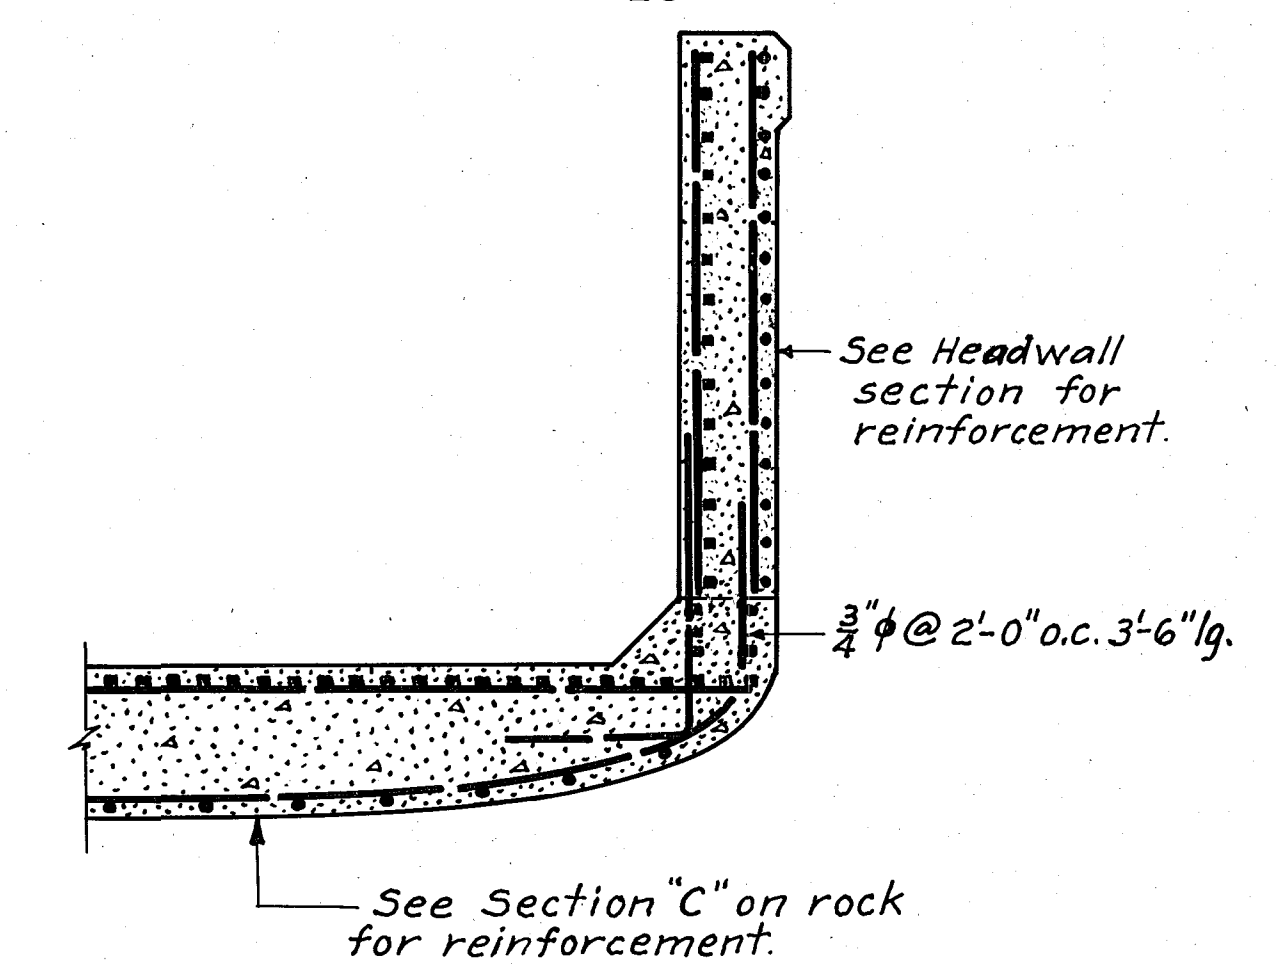

TYPE II

HEADWALL
SECTION A

SECTION THROUGH INLET ARCH

SECTION B

NOTES

For location of types see Sheet No. 20.

RECORD
DRAWINGS

CONNECTICUT RIVER FLOOD CONTROL

PARK RIVER CONDUIT

HARTFORD, CONN.

INLET STRUCTURE

WALL REINFORCEMENT NO. 1

CONNECTICUT RIVER

CONNECTICUT

IN 48 SHEETS

SCALE: 1/4 IN. = 1 FT.

SHEET NO. 27

U.S. ENGINEER OFFICE PROVIDENCE, R.I.

MAY 1940

REVIEWED: *W. H. Eddy*

APPROVAL: *W. H. Eddy*

APPROVED: *W. H. Eddy*

ENGINEER

PRINCIPAL ENGINEER

DIST. CORPS OF ENGINEERS

F.C. DESIGN SECTION

CHIEF F.C. ENGINEERING DIV.

DISTRICT ENGINEER

SUBMITTED: *W. H. Eddy*

(PARTNER)

DRAWN BY: F.M.E.

FILE NO. CT-4-2625

TRACED BY: W.H.E.

METCALF & EDDY

BOSTON, MASS.

CHECKED BY: W.H.E.

KEY	DATE	REVISION (Indicated by Δ)	REV. BY	CK. BY	AP. BY
Δ	12-31-45	As built revisions			
Δ	7-10-41	Wall base changed.			

METCALF & EDDY
ENGINEERS
BOSTON, MASS.