

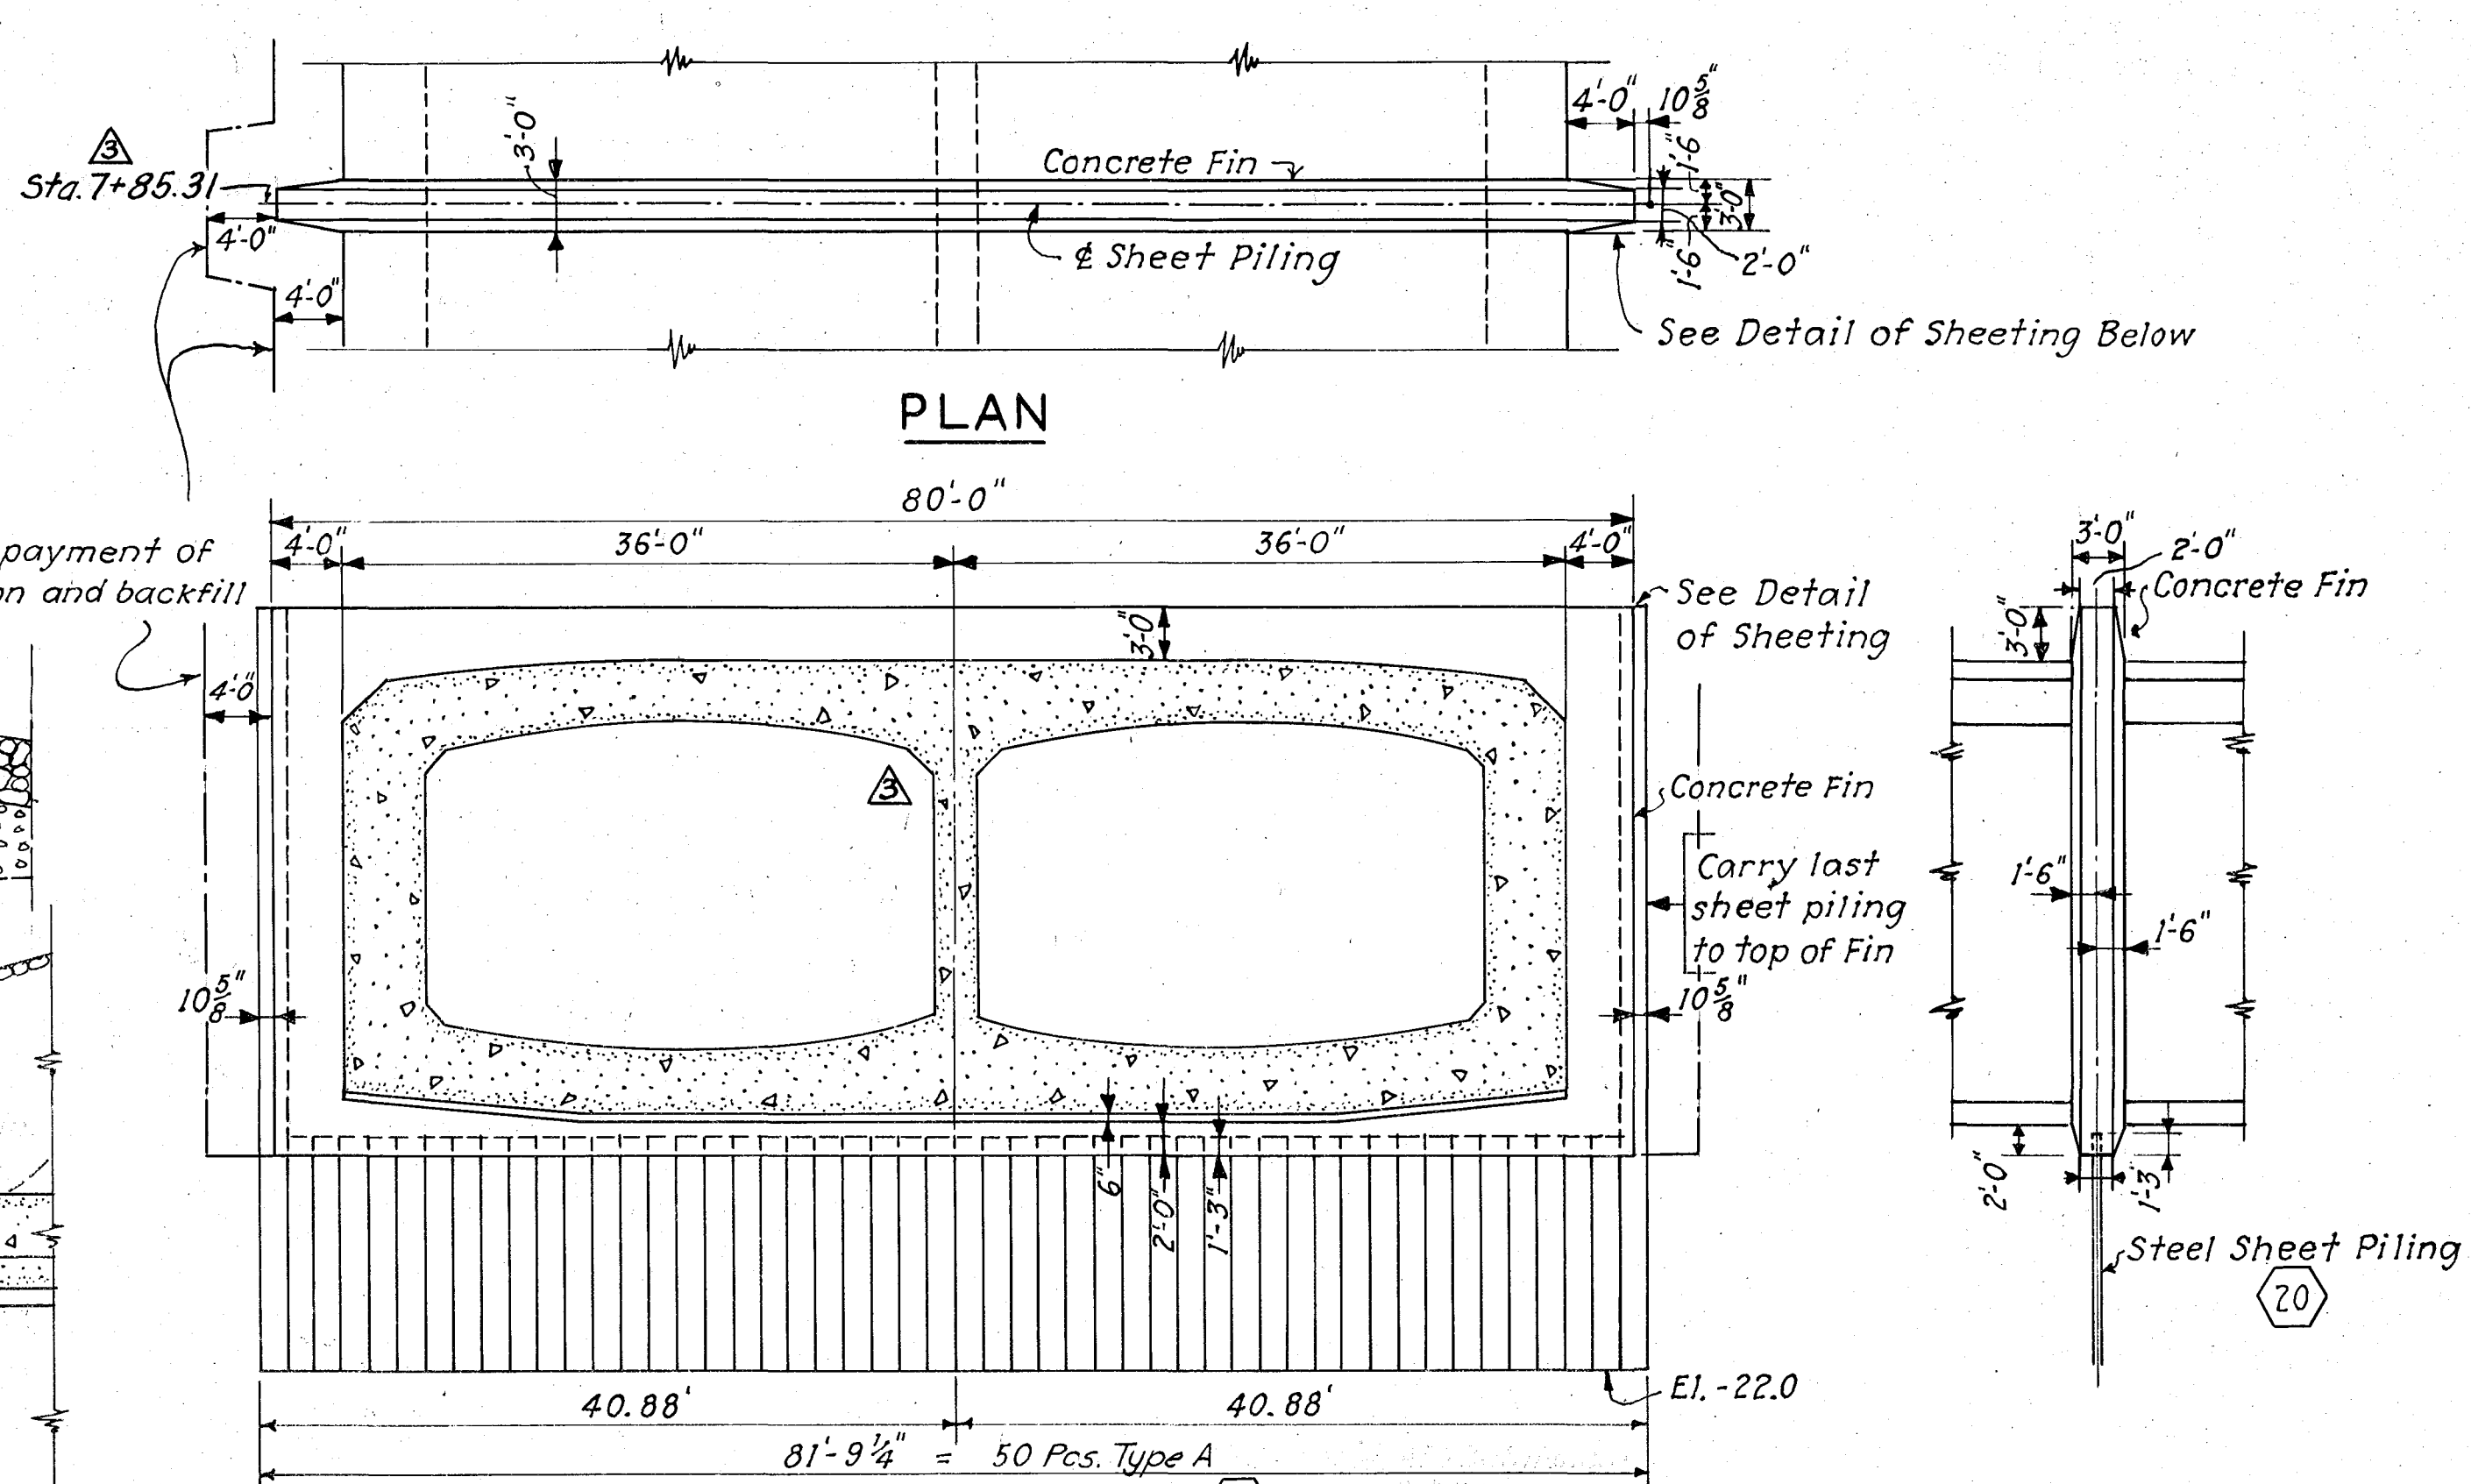
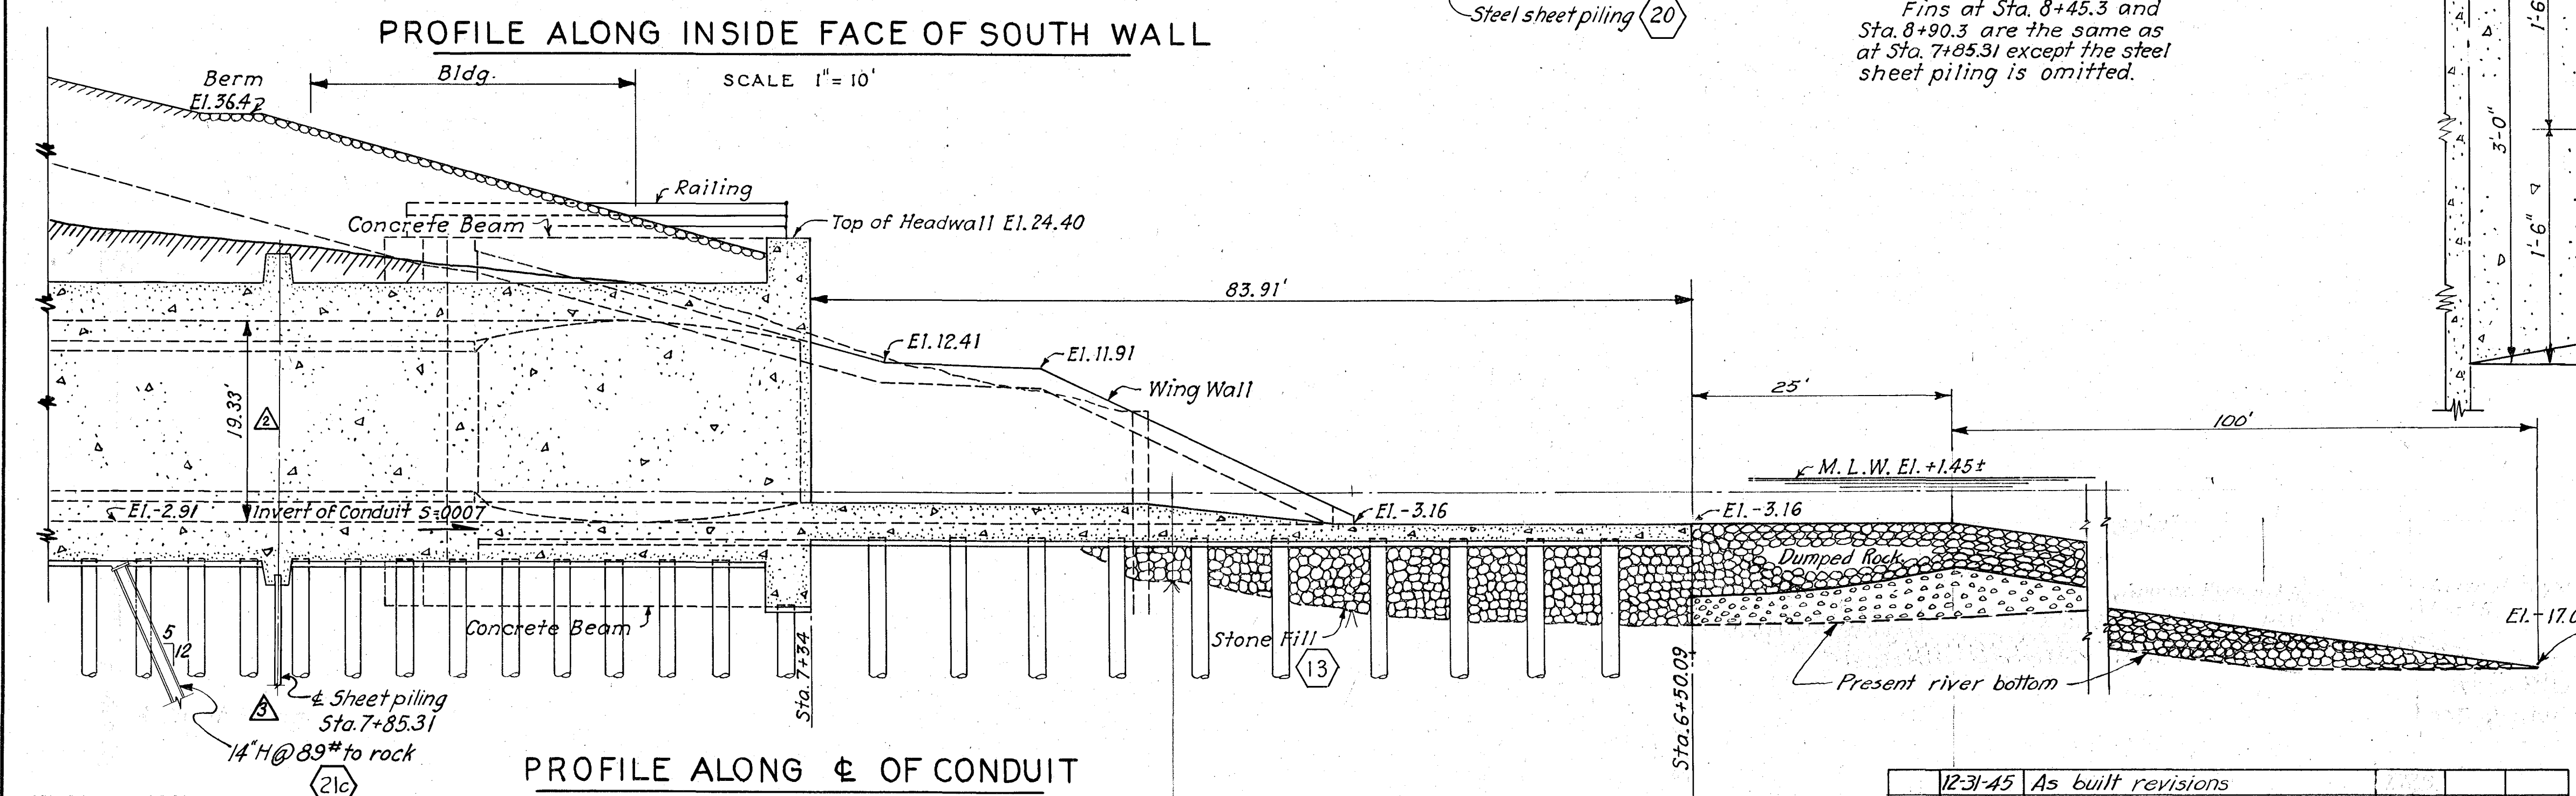


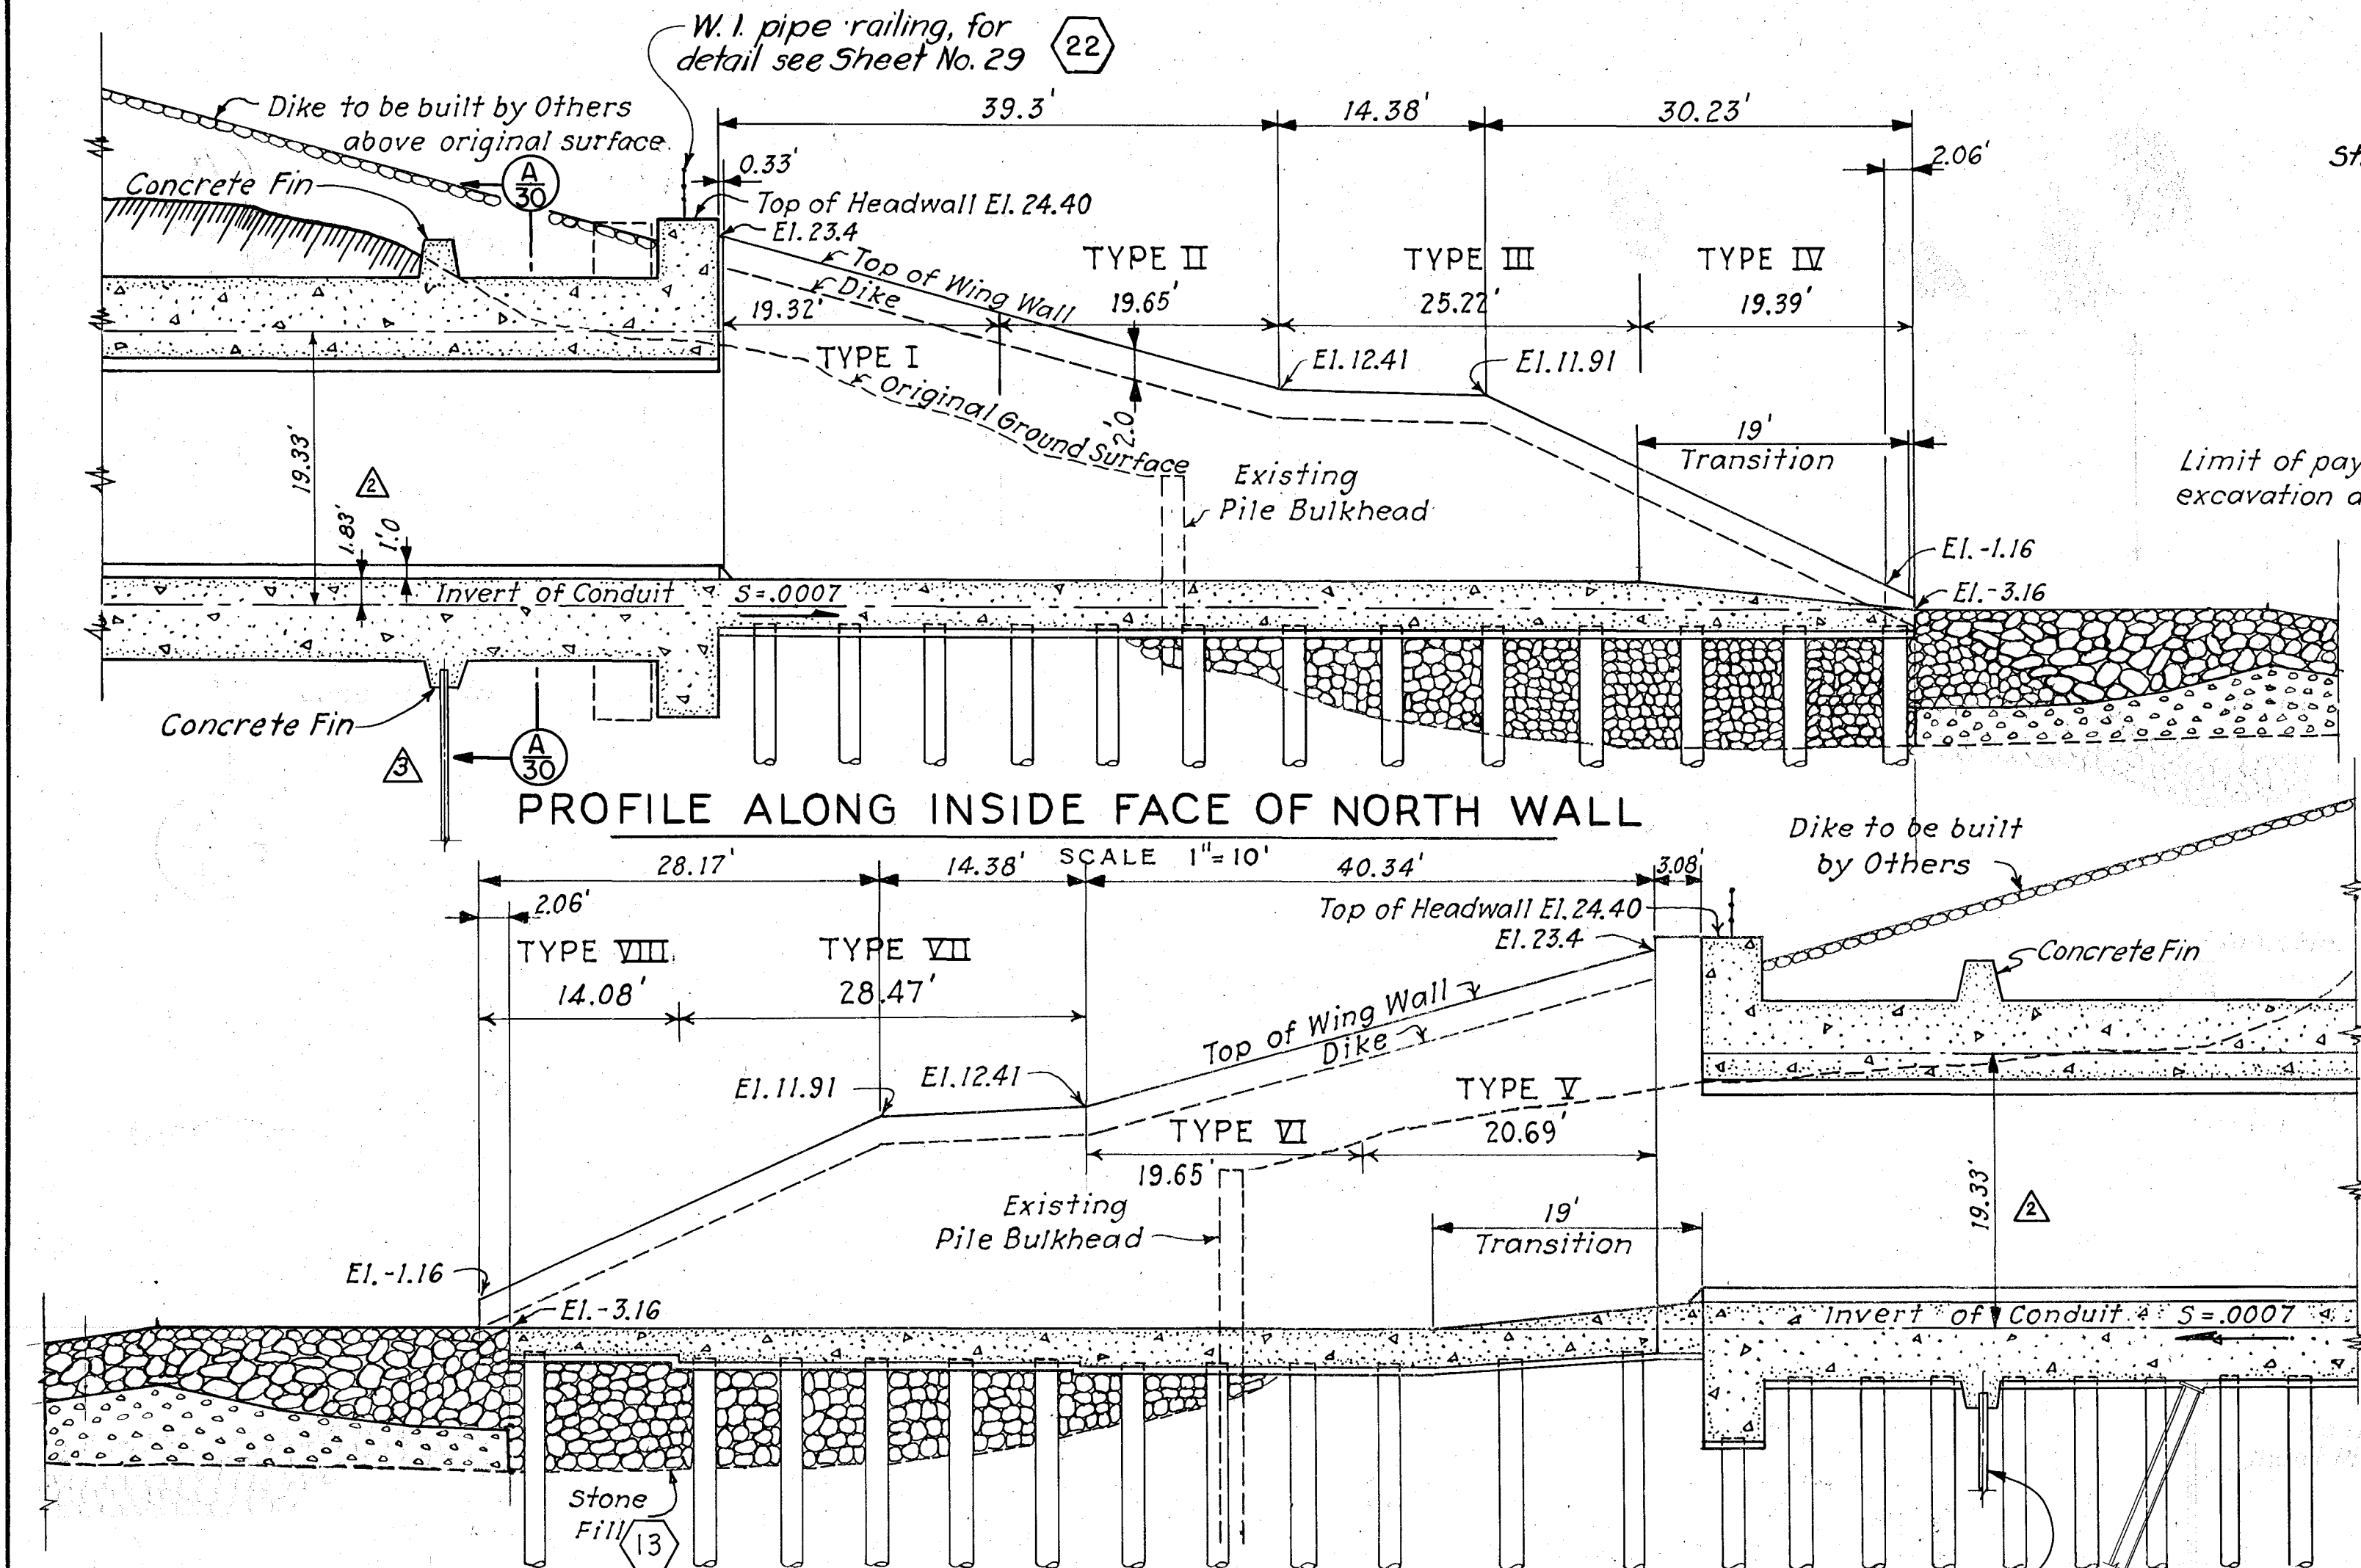

NOTE:
Fins at Sta. 8+45.3 and Sta. 8+90.3 are the same as at Sta. 7+85.31 except the steel sheet piling is omitted.

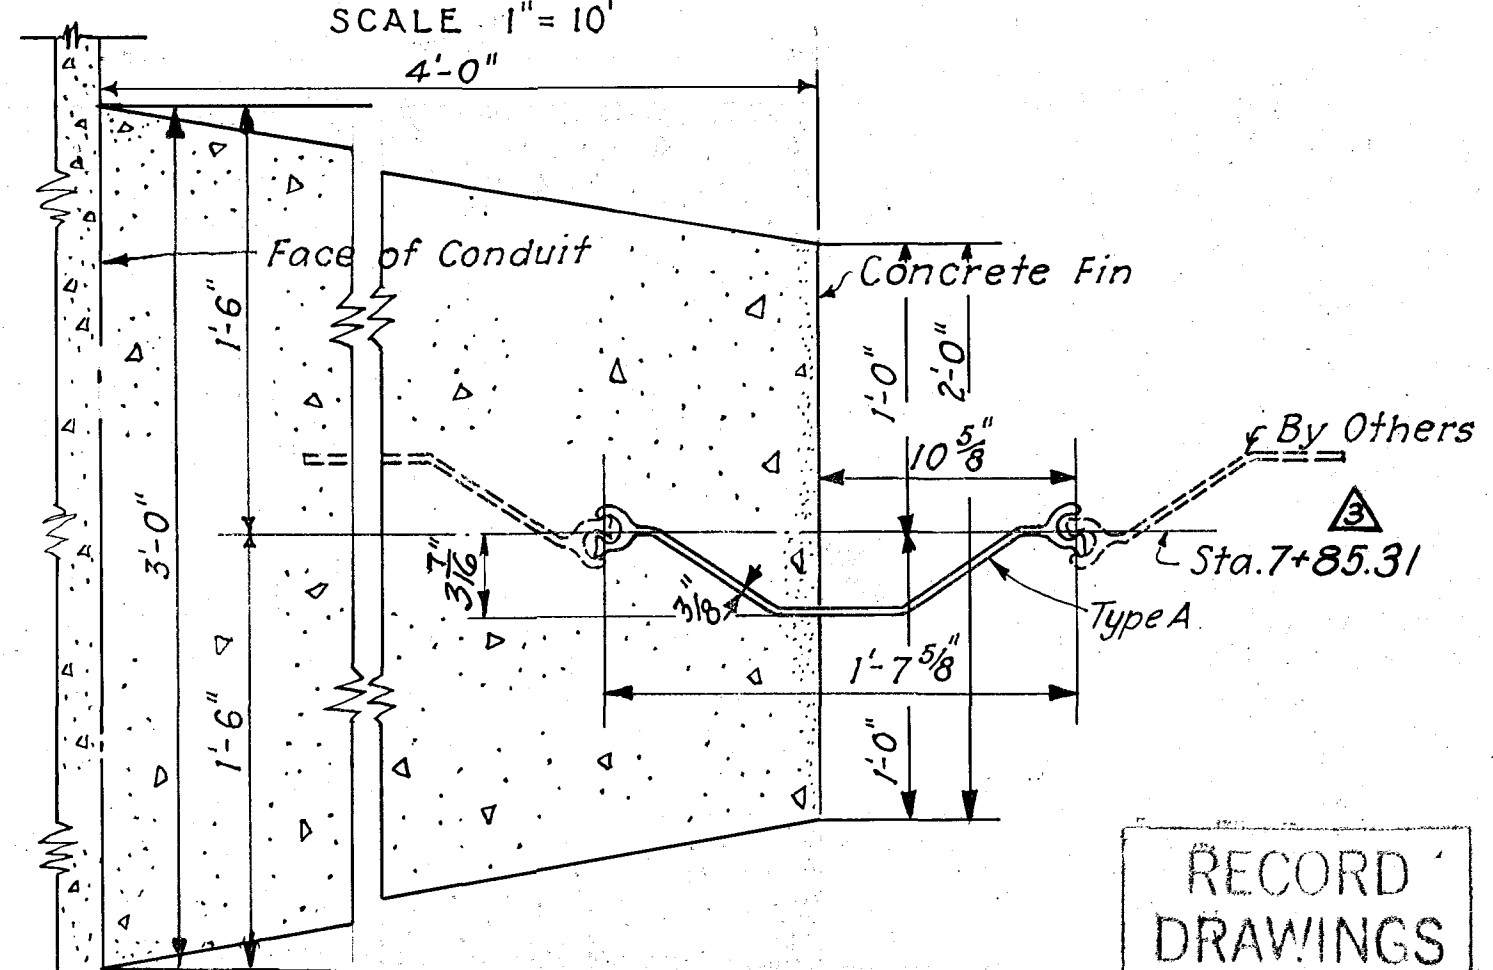

DETAIL OF SHEETING

SCALE: 1 1/2 IN. = 1 FT.
12" 9" 6" 3" 0" 6" 12"

CONNECTICUT RIVER FLOOD CONTROL
PARK RIVER CONDUIT
HARTFORD, CONN.
OUTLET STRUCTURE
DETAILS NO. 1

CONNECTICUT RIVER IN 48 SHEETS. SCALE: 1 IN. = 10 FT. SHEET NO. 30

U.S. ENGINEER OFFICE PROVIDENCE, R.I. MAY 1940

REVIEWED: *[Signature]* APPROVAL RECOMMENDED: *[Signature]* APPROVED: *[Signature]*
ENGINEER F.C. DESIGN SECTION PRINCIPAL ENGINEER CHIEF F.C. ENGINEERING DIV. LT. COL. CORPS OF ENGINEERS DISTRICT ENGINEER

SUBMITTED: *[Signature]* (PARTNER) DRAWN BY: E.F.M. FILE NO. CT-4-2628
METCALF & EDDY BOSTON, MASS. CHECKED BY: *[Signature]*

METCALF & EDDY
ENGINEERS
BOSTON, MASS.

KEY	DATE	REVISION (Indicated by Δ)	REV. BY	CK. BY	AP. BY
Δ	12-31-45	As built revisions			
Δ	2-17-41	Batter piles added	K.C.H.	161	282
Δ	11-22-40	Dimensions changed	K.C.H.	K.S.N.	282