
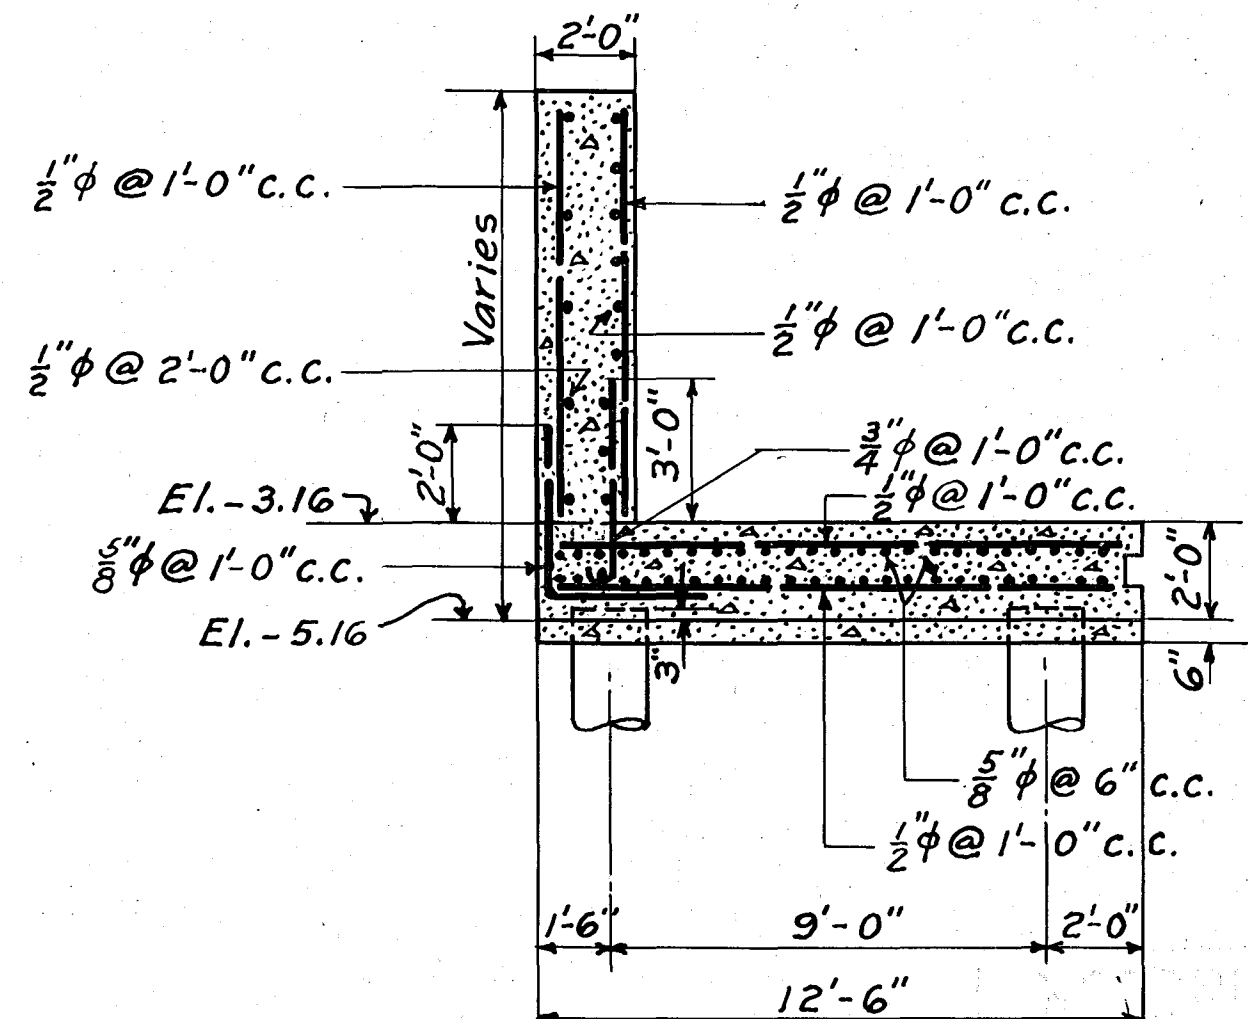
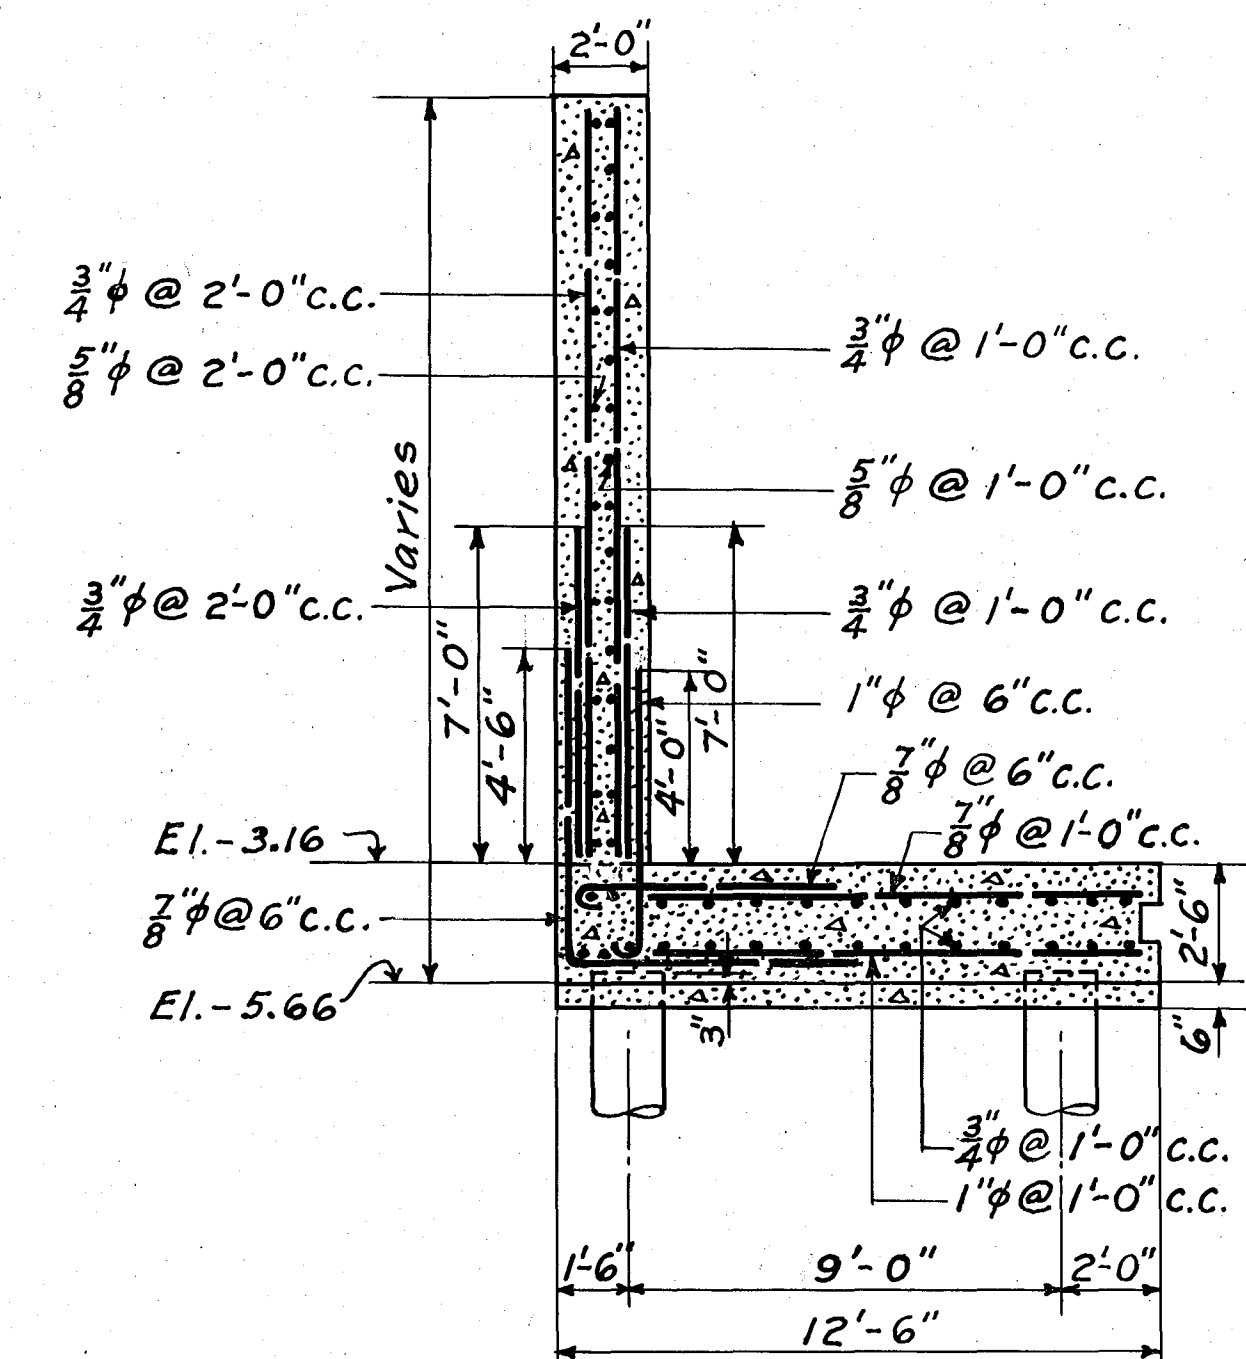
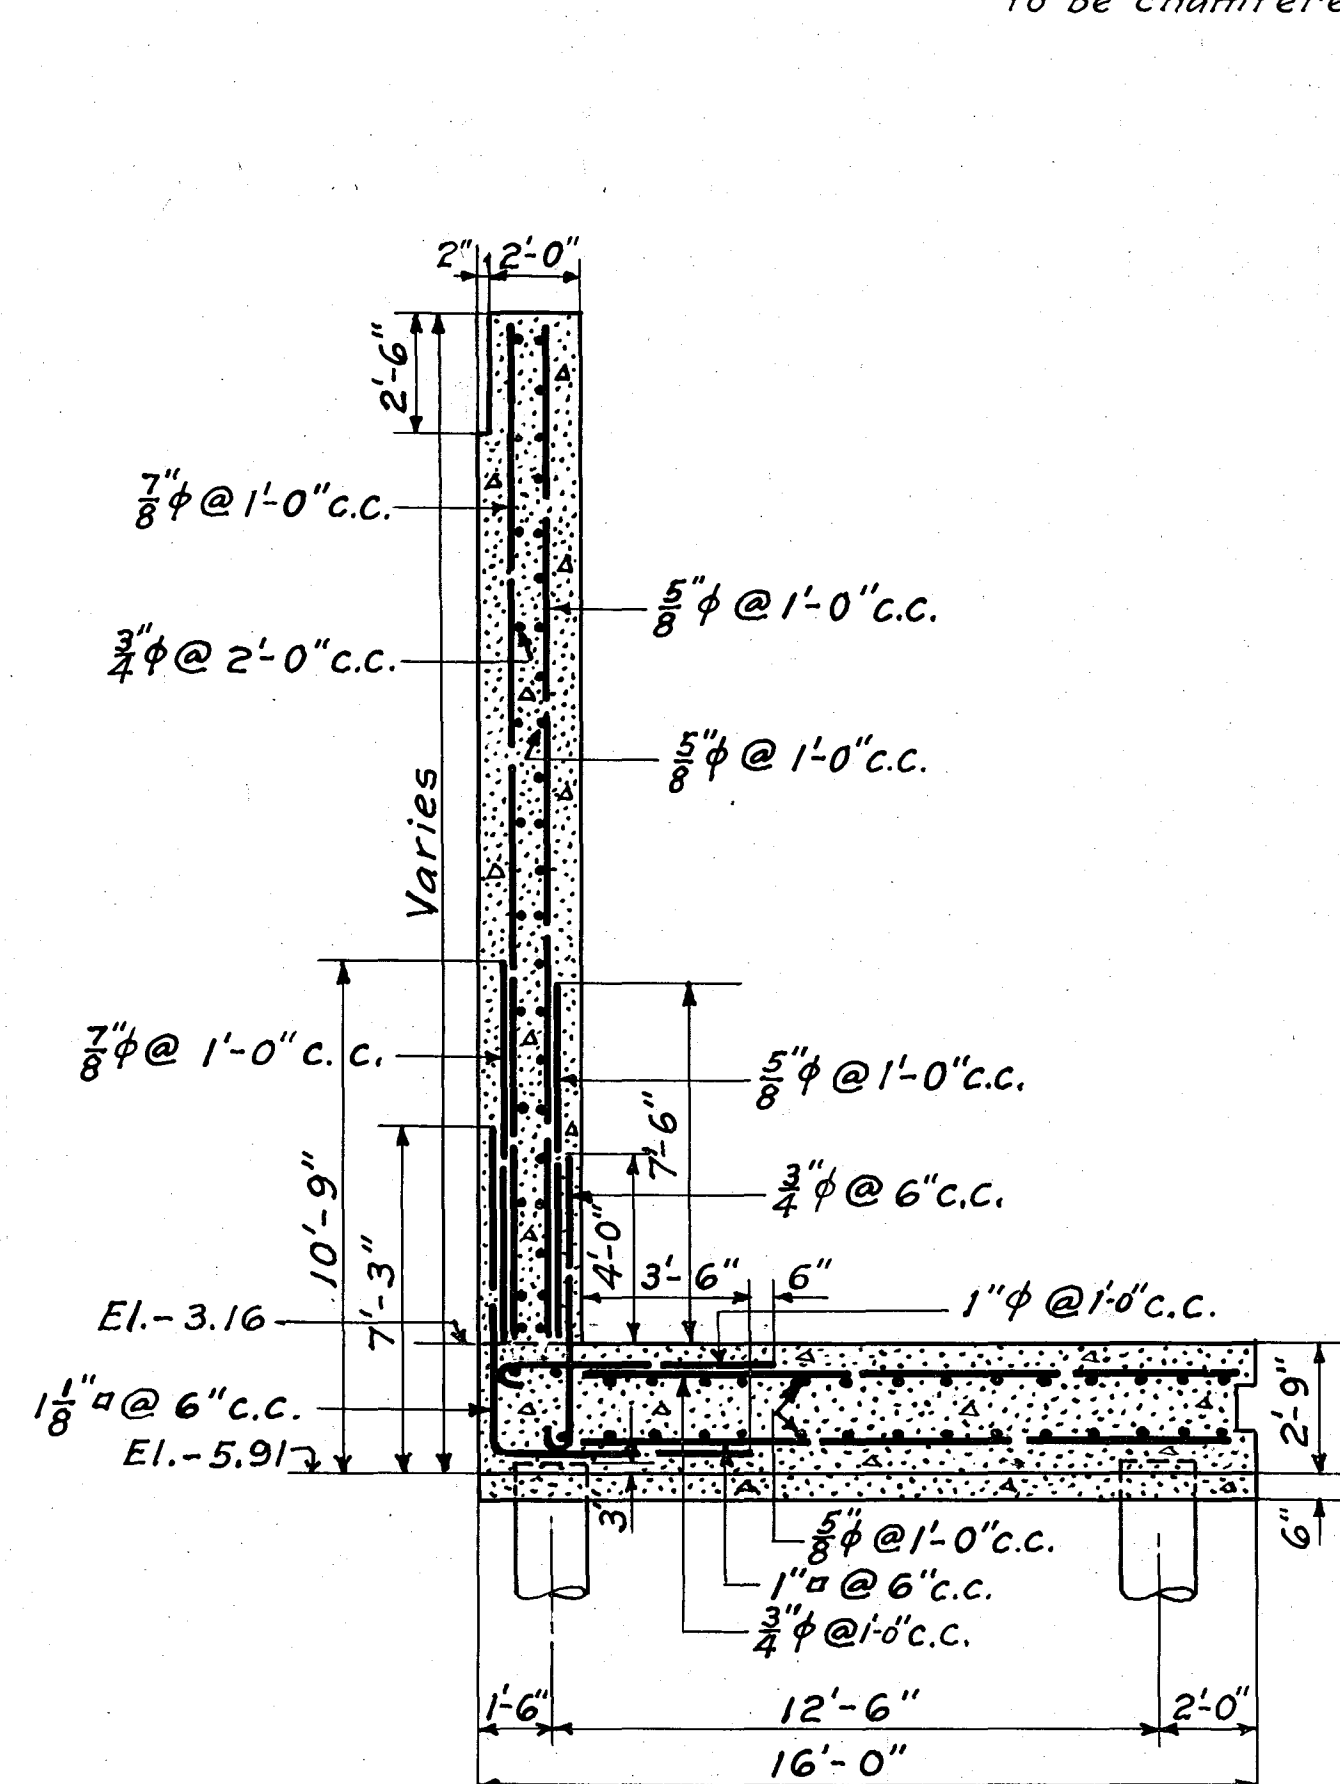
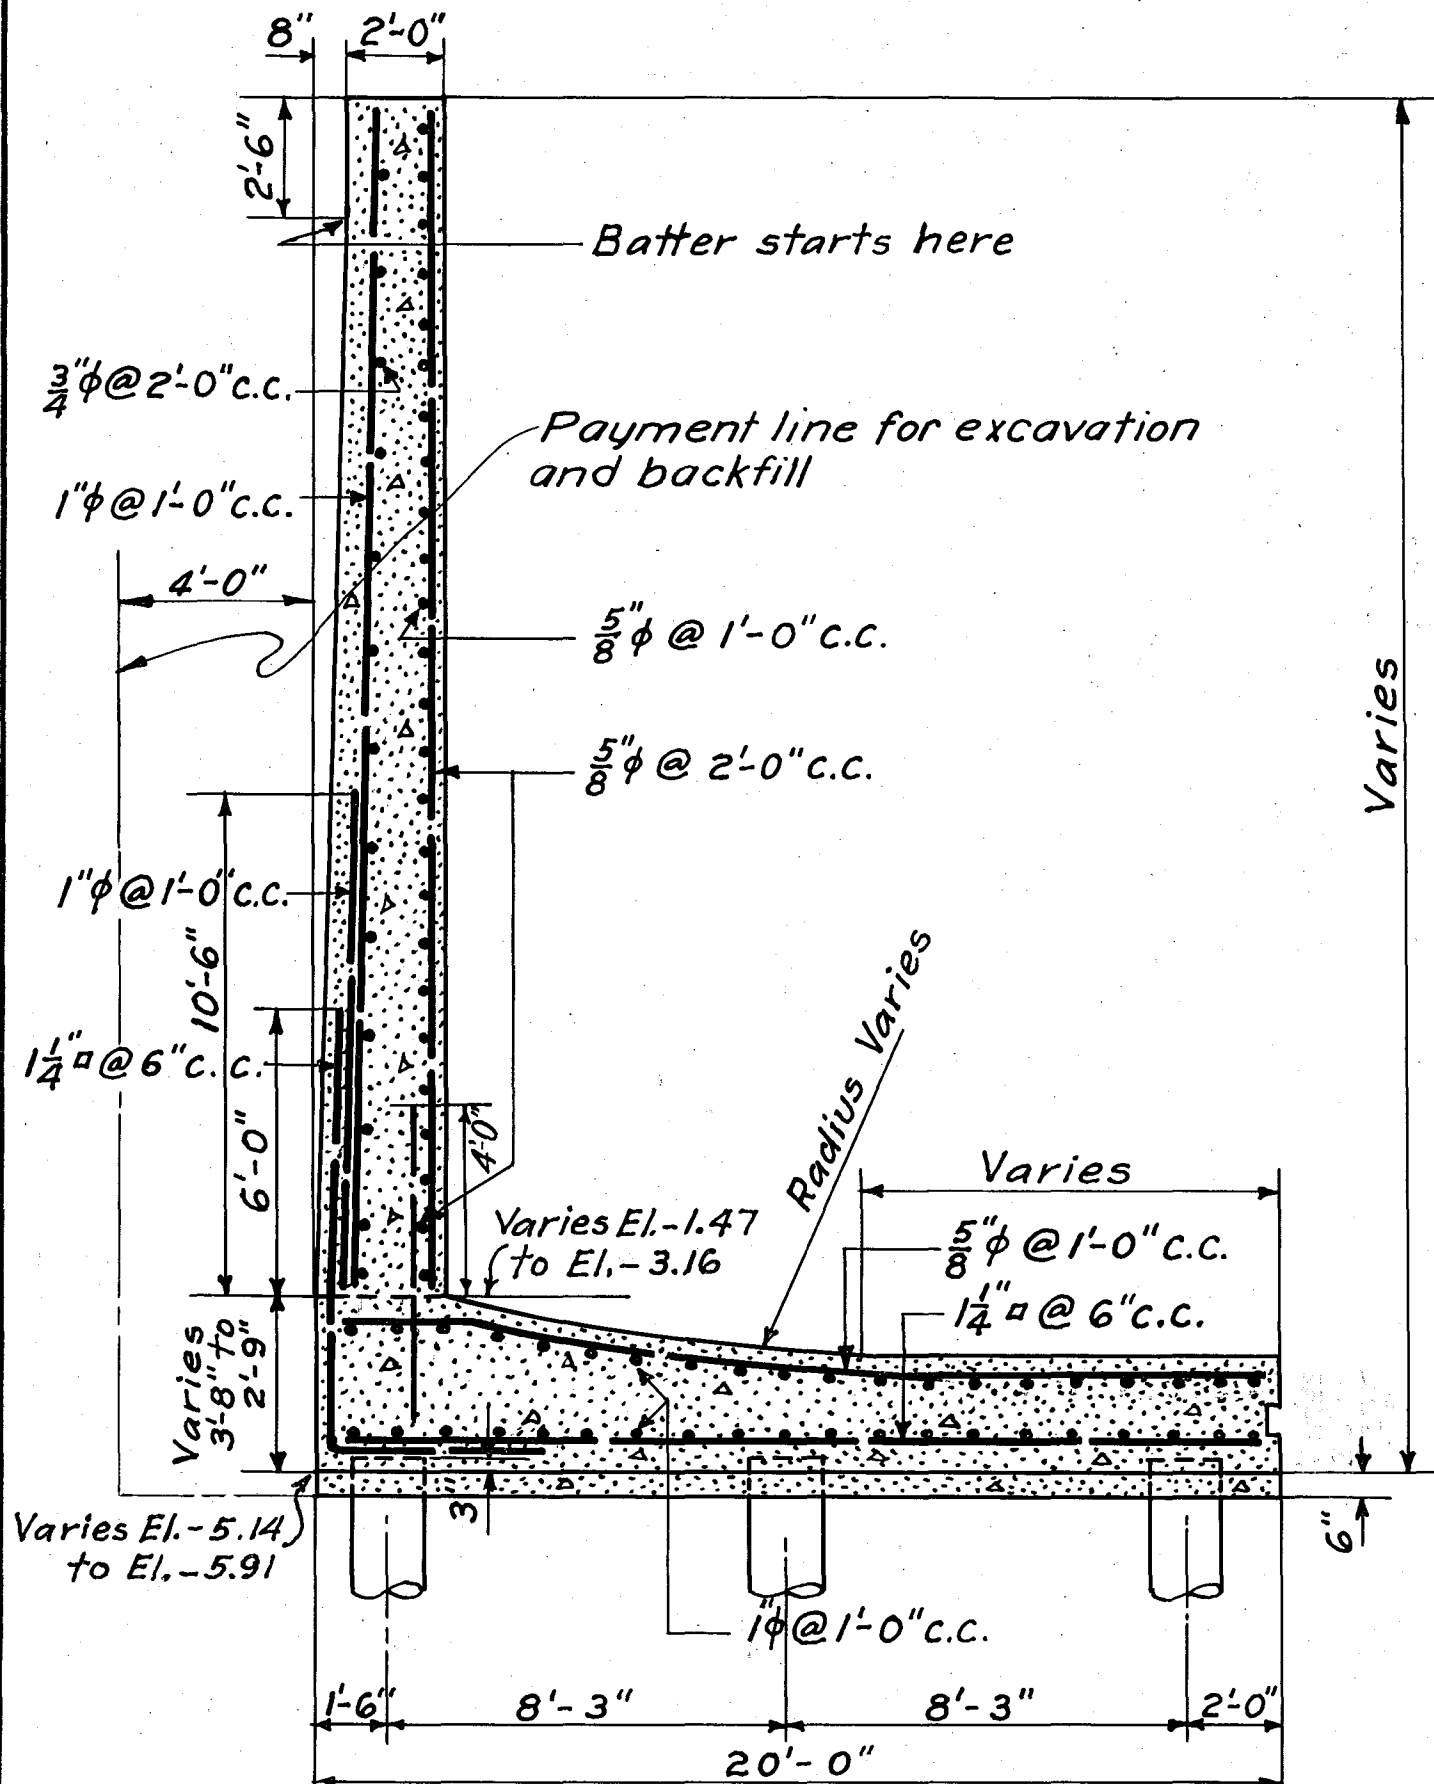
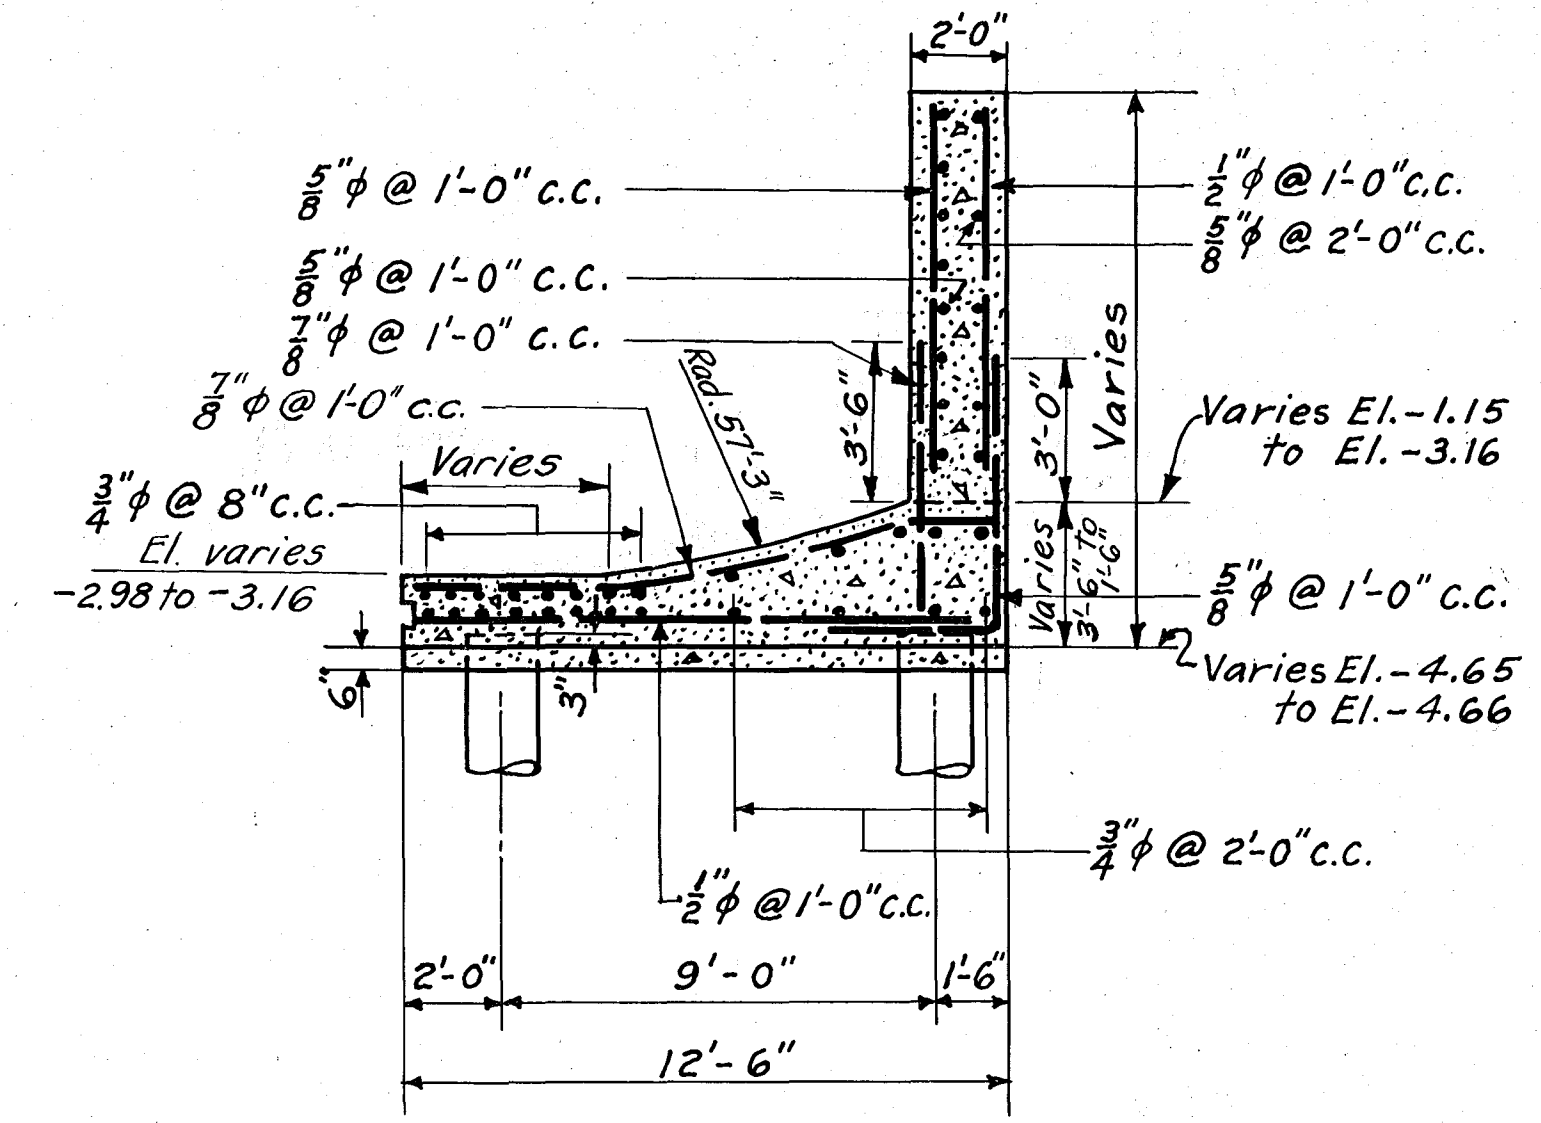
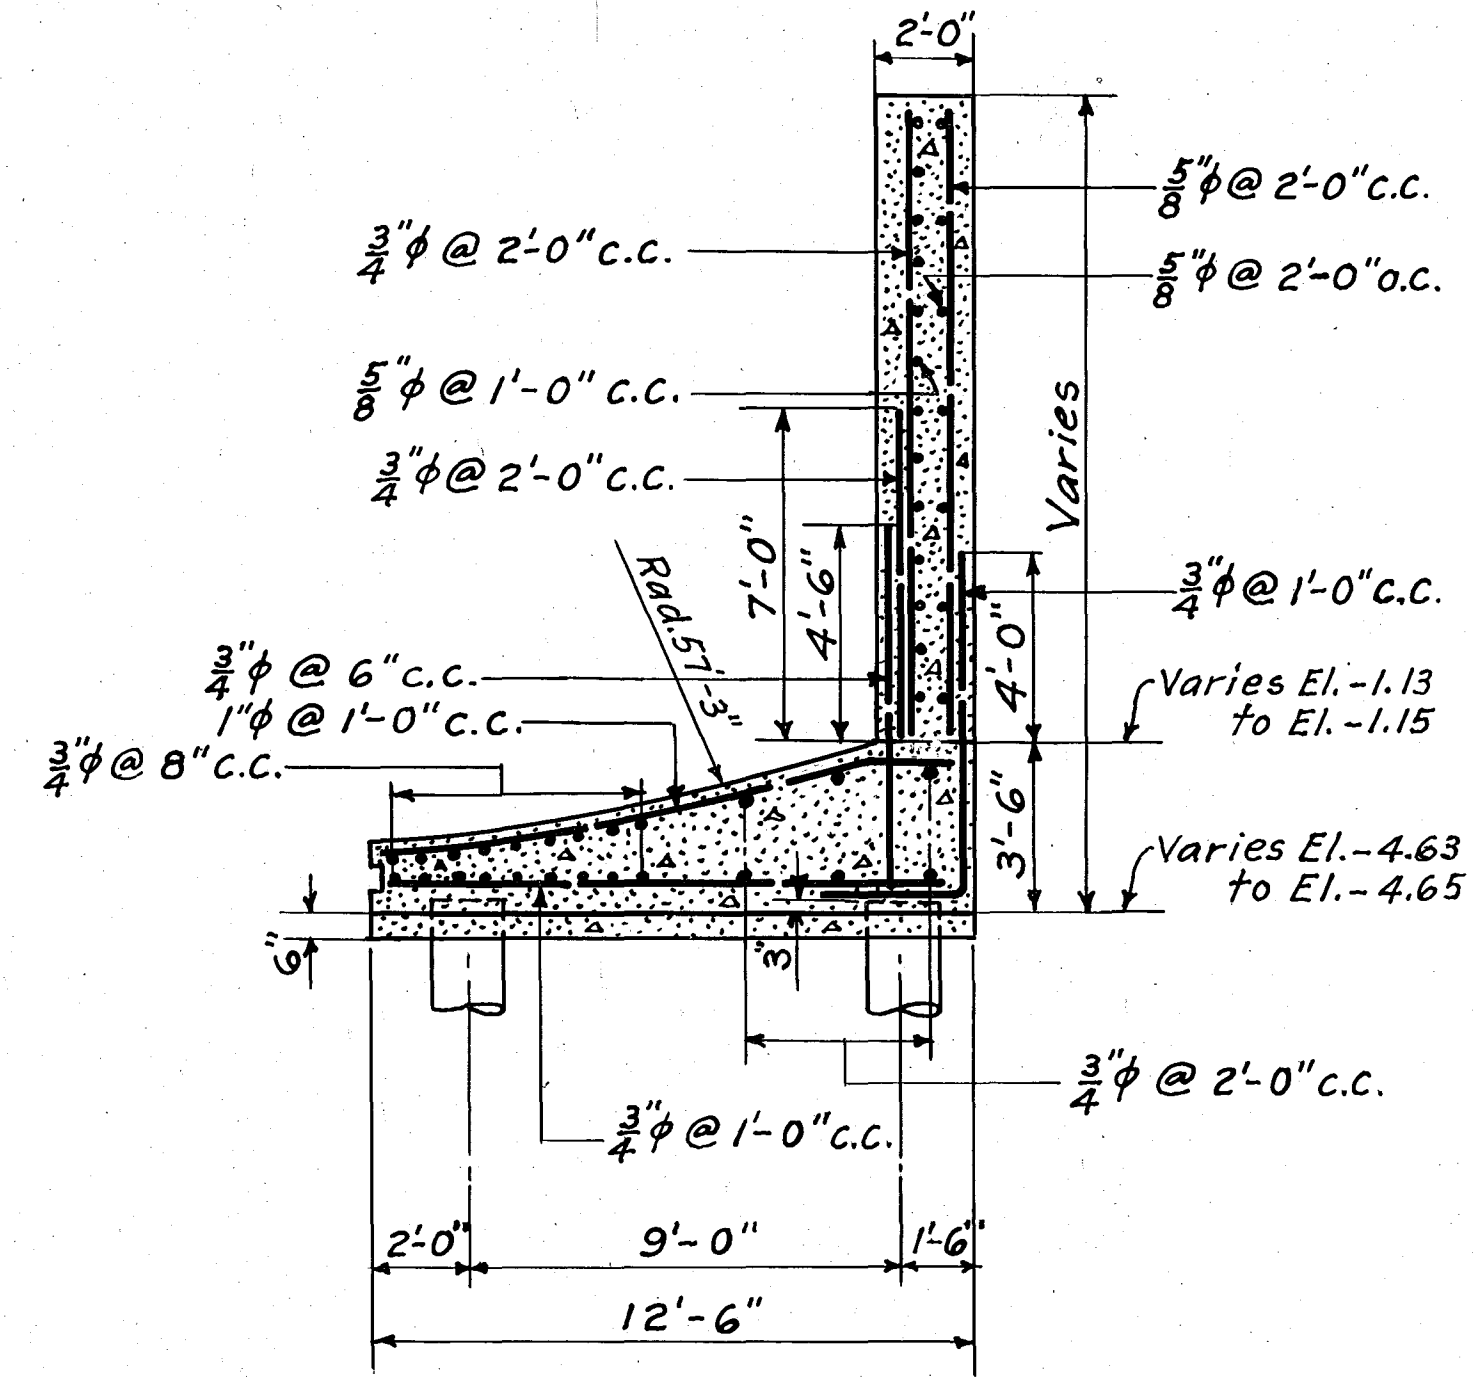
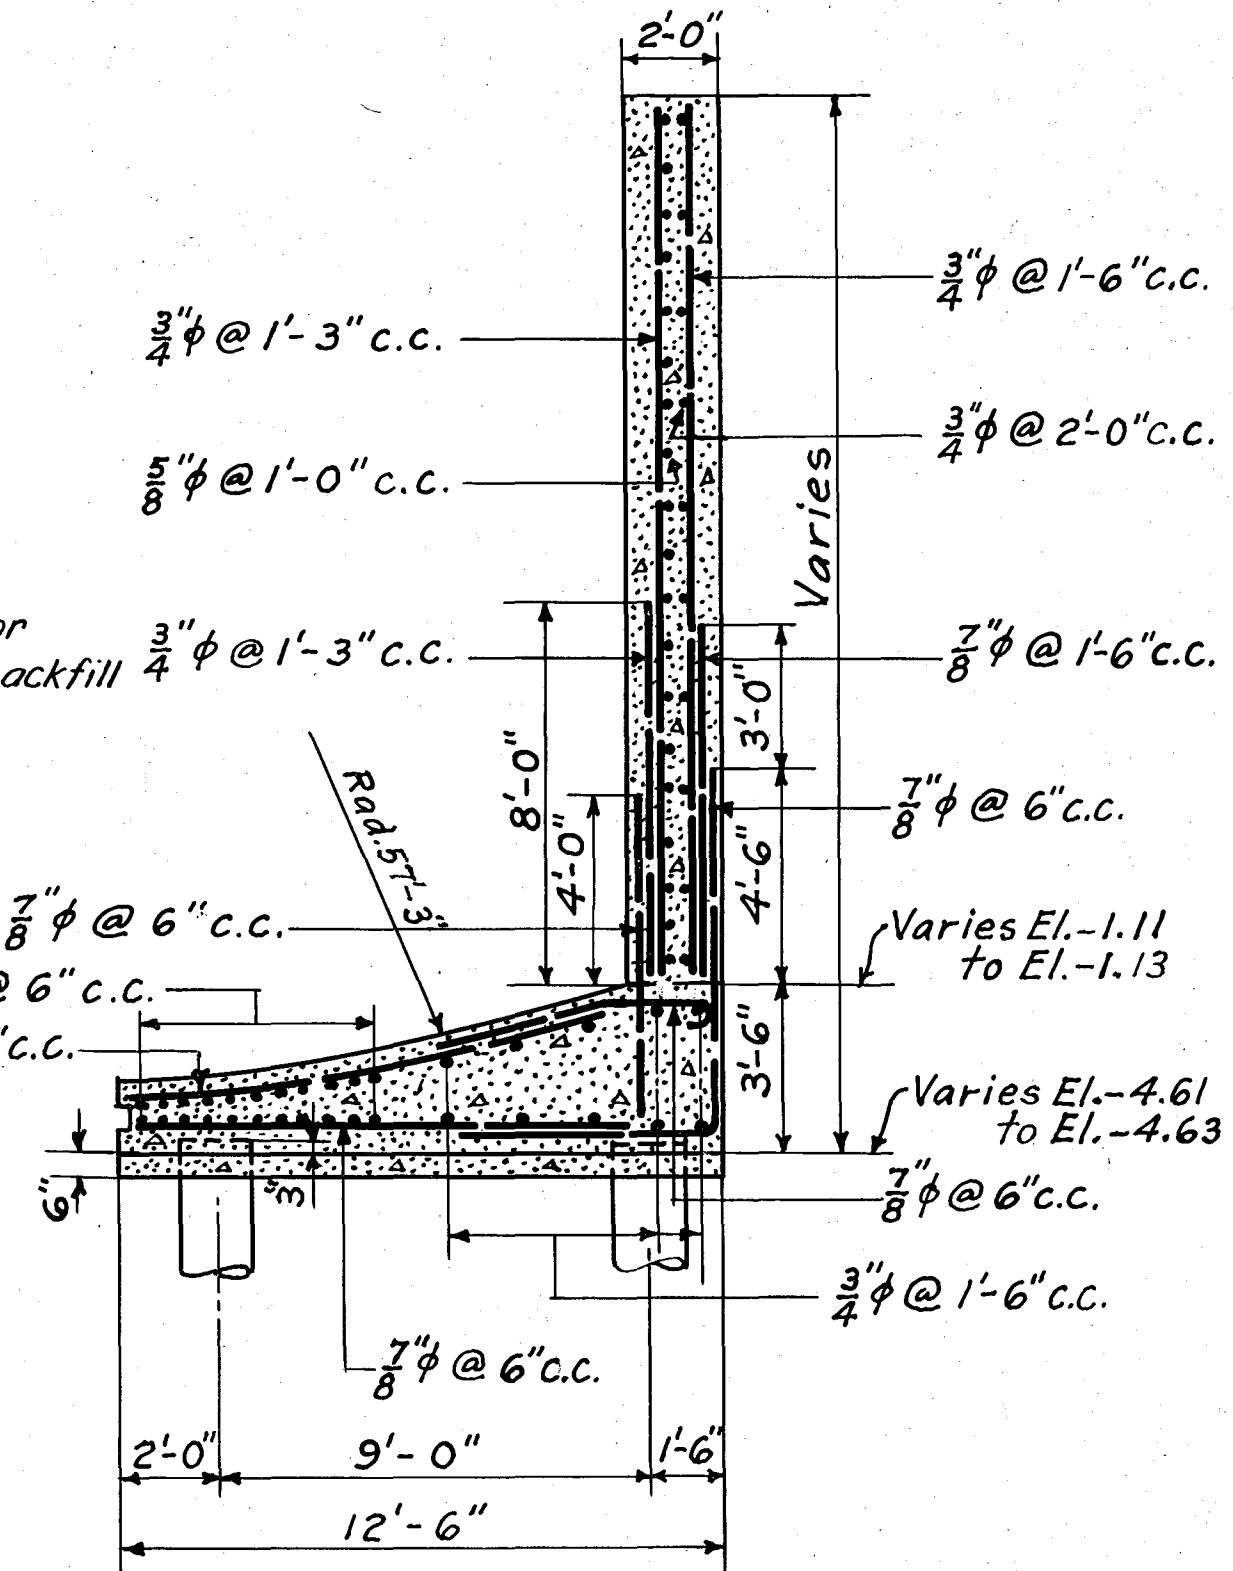


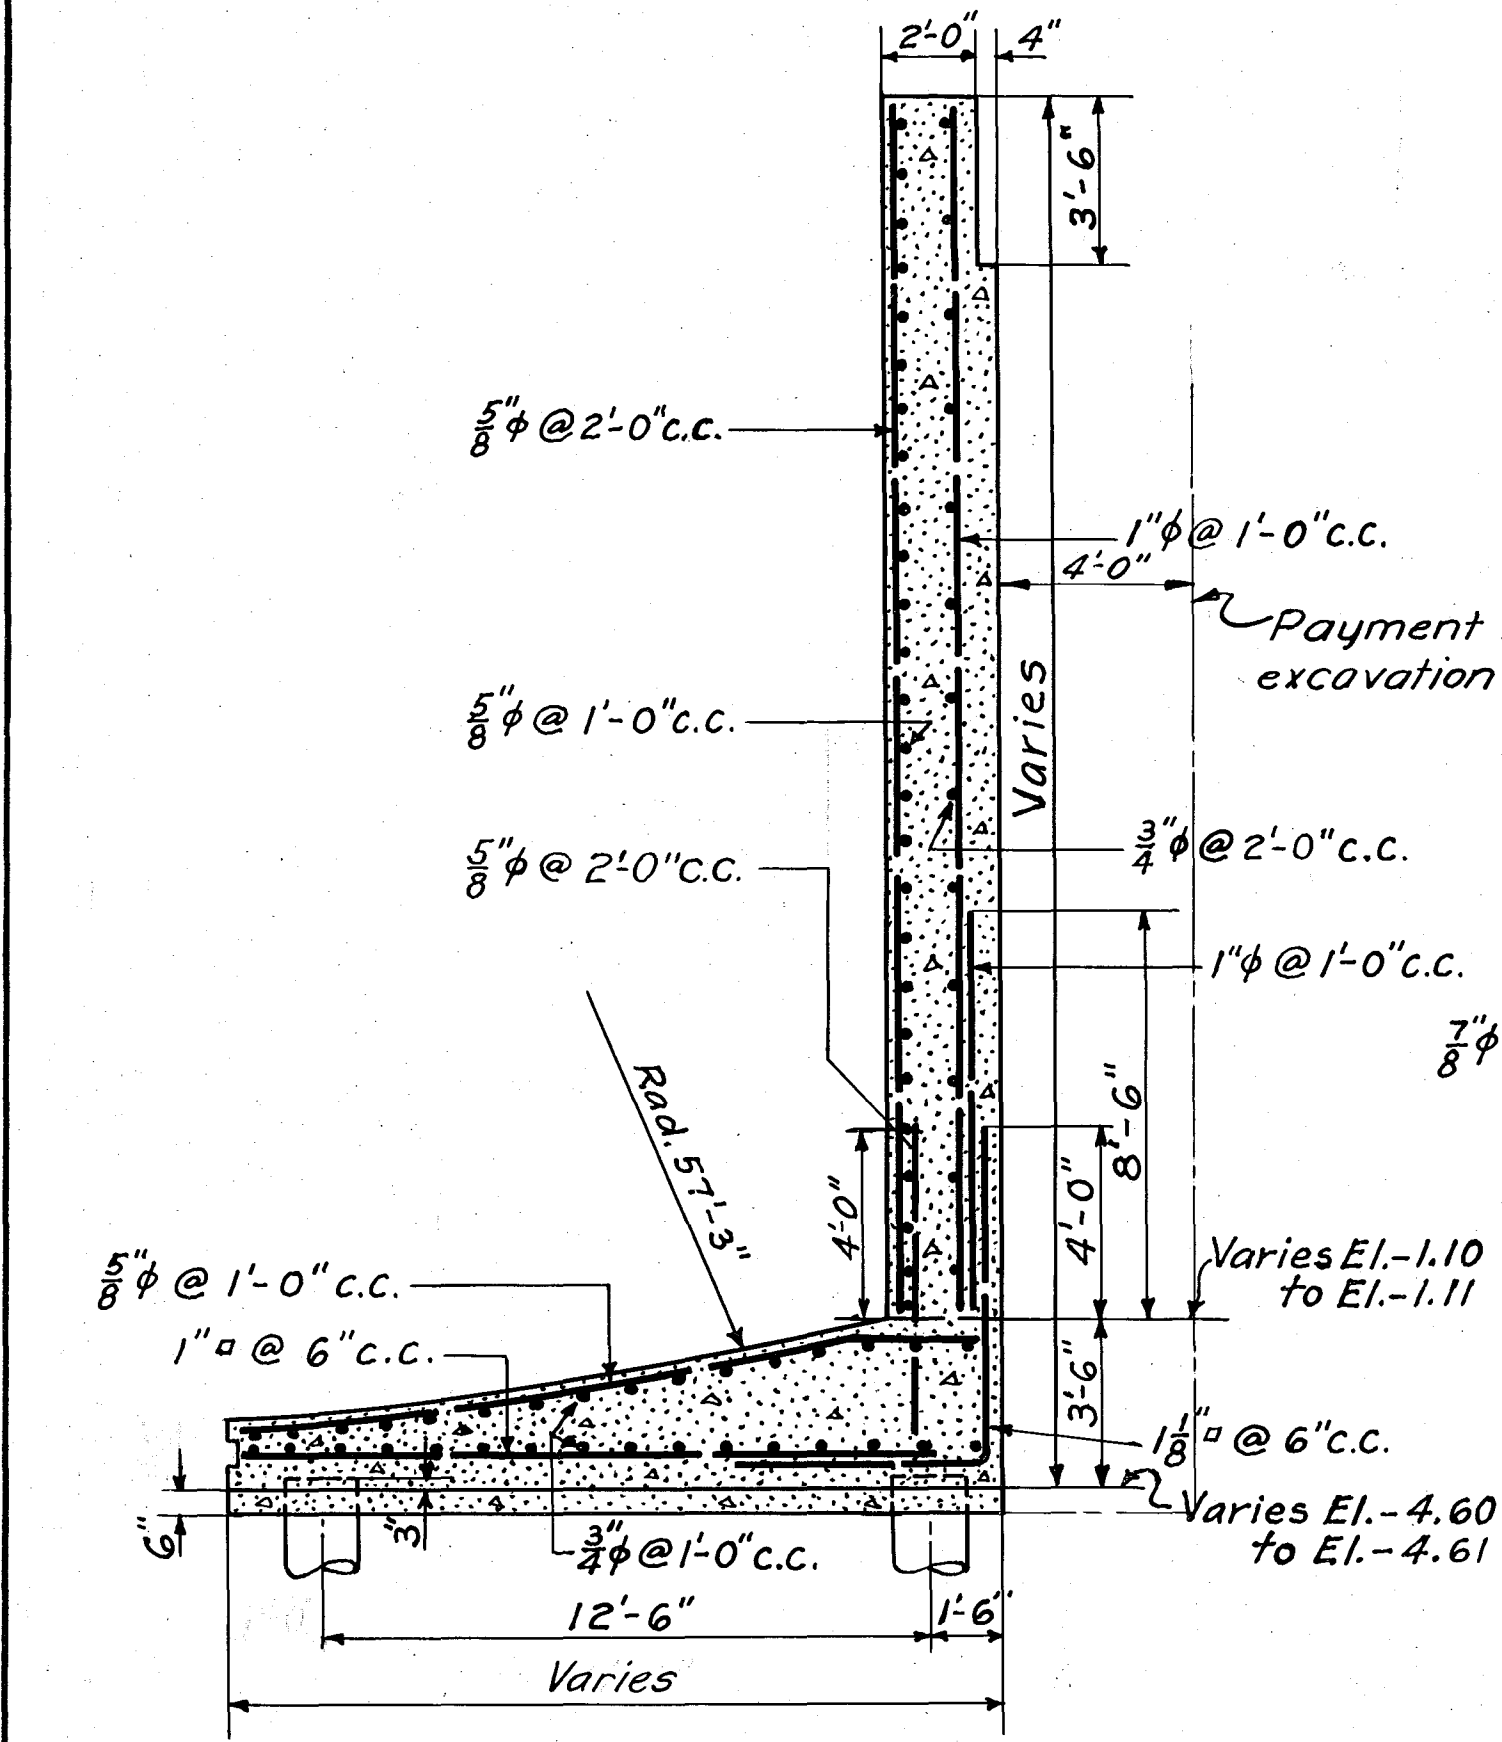

NOTE: All exposed edges of concrete to be chamfered 1".

METCALF & EDDY
ENGINEERS
BOSTON, MASS.

RECORD
DRAWINGS

KEY	DATE	REVISION (Indicated by Δ)	REV. BY	CK. BY	AR. BY
Δ	12-31-45	As built			
Δ	11-22-40	Section and dimensions changed	JCD	K3/H	78/3

CONNECTICUT RIVER FLOOD CONTROL
PARK RIVER CONDUIT
HARTFORD, CONN.
OUTLET STRUCTURE
STEEL REINFORCEMENT NO. 2
CONNECTICUT RIVER CONNECTICUT
IN 48 SHEETS SCALE: 1/4" IN. = 1 FT. SHEET NO. 33
U.S. ENGINEER OFFICE PROVIDENCE, R.I. MAY 1940
REVIEWED: [Signature] APPROVAL RECOMMENDED: [Signature] APPROVED: [Signature]
ENGINEER: [Signature] PRINCIPAL ENGINEER: [Signature] LT. COL. CORPS OF ENGINEERS
F.C. DESIGN SECTION CHIEF F.C. ENGINEERING DIV. DISTRICT ENGINEER
SUBMITTED: [Signature] (PARTNER) DRAWN BY: FAN TRACED BY: WHF
METCALF & EDDY CHECKED BY: PWT
BOSTON, MASS. FILE NO. CT-4-2631