




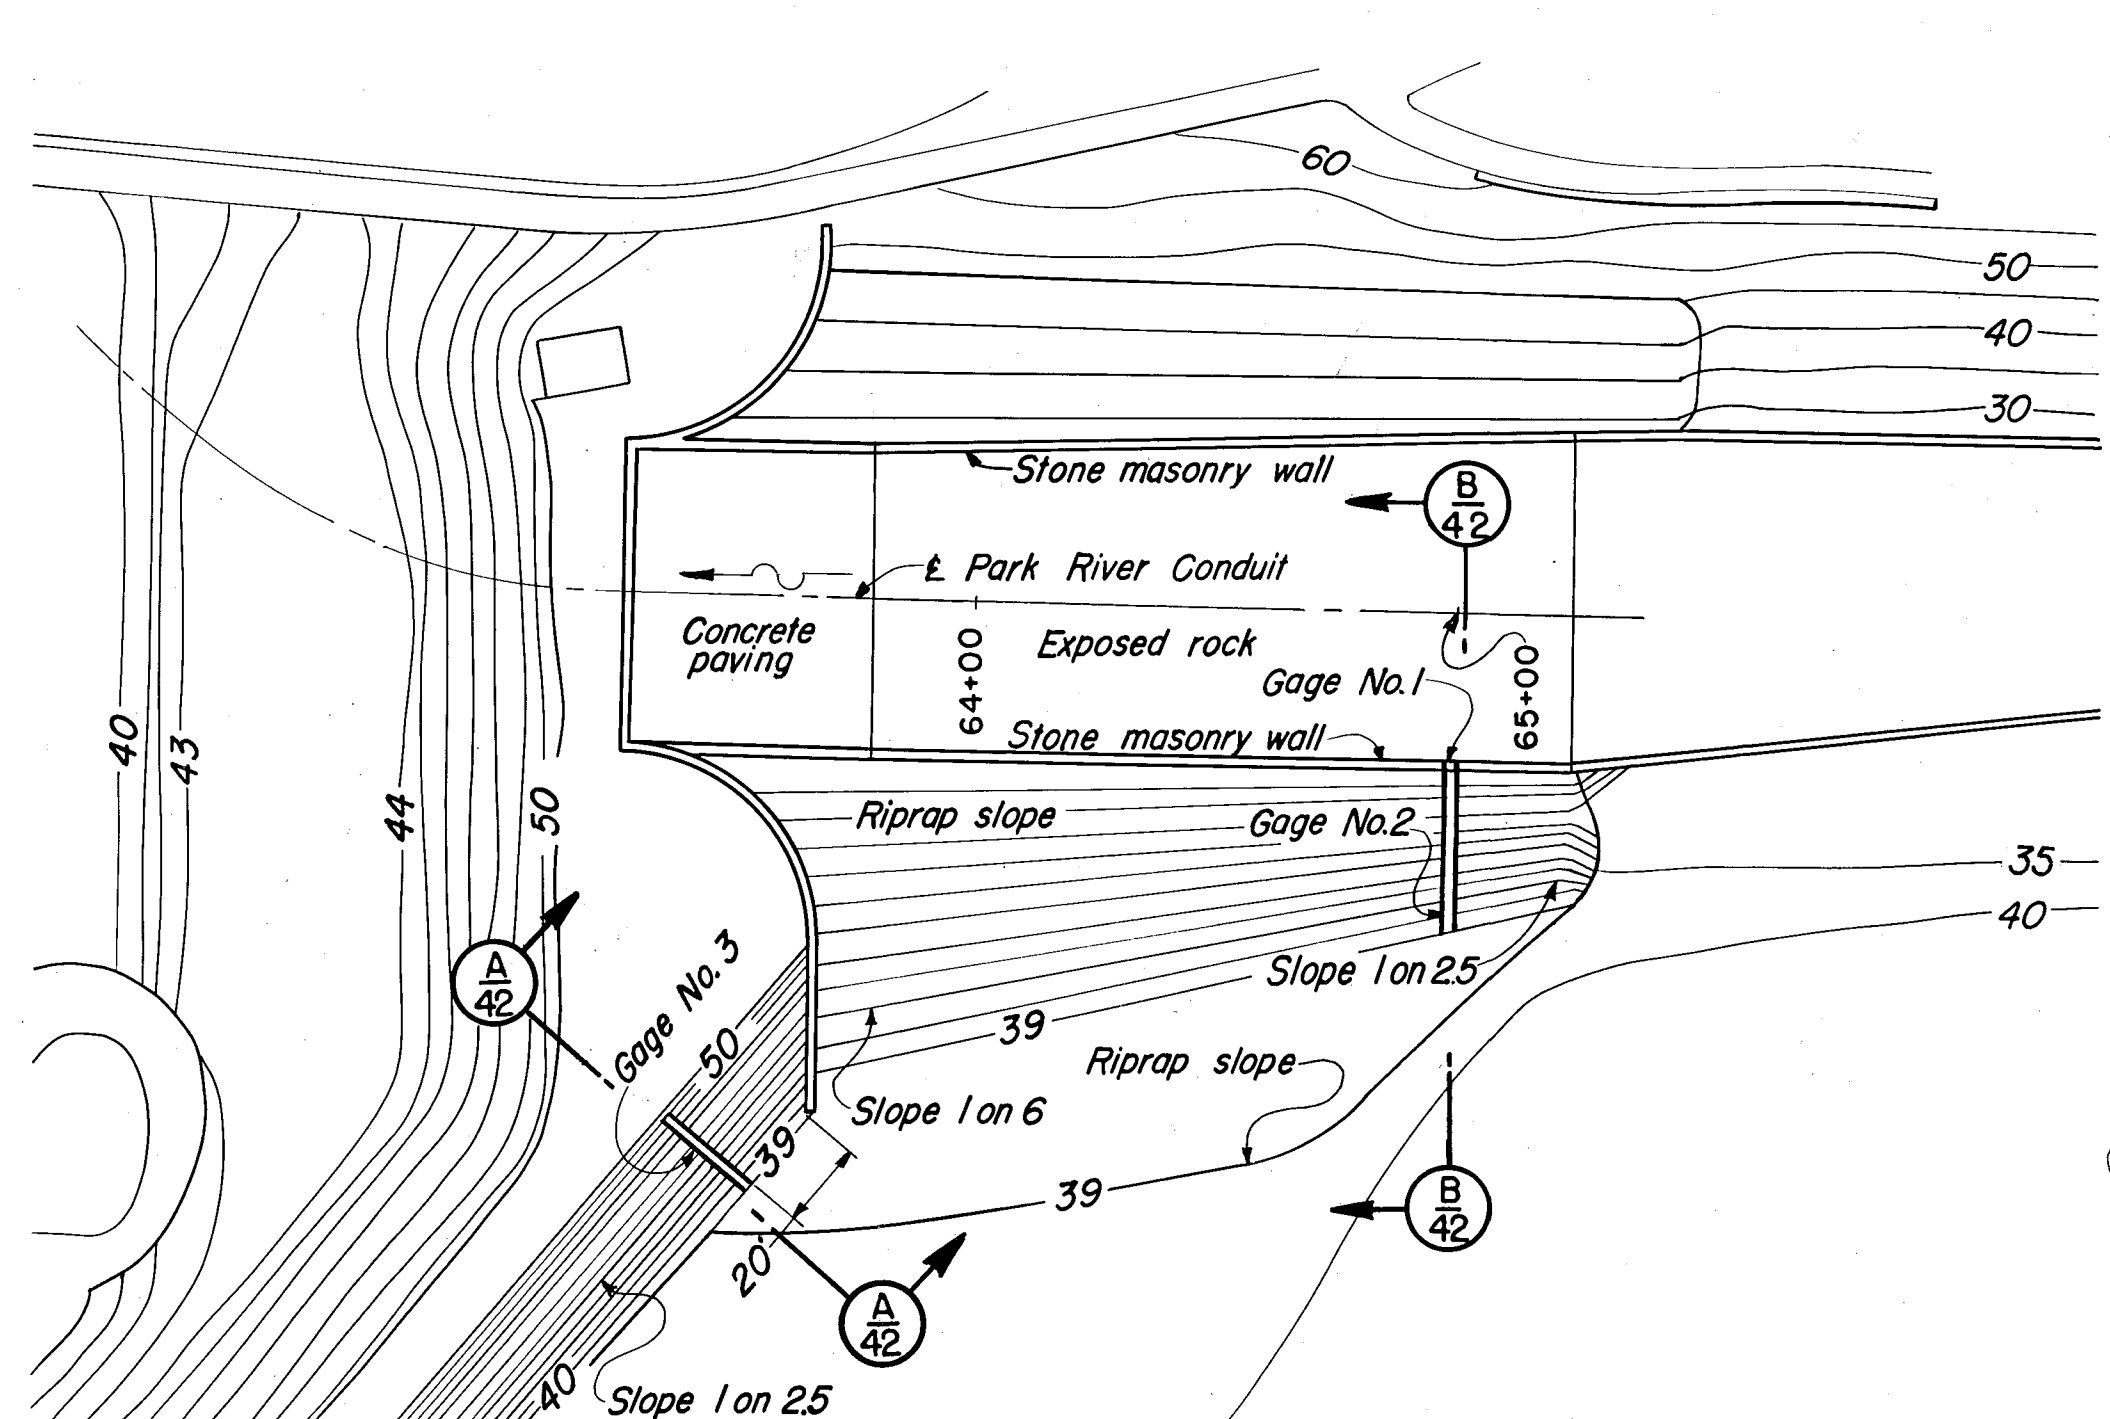

INLET PLAN
SCALE: 1" = 40'

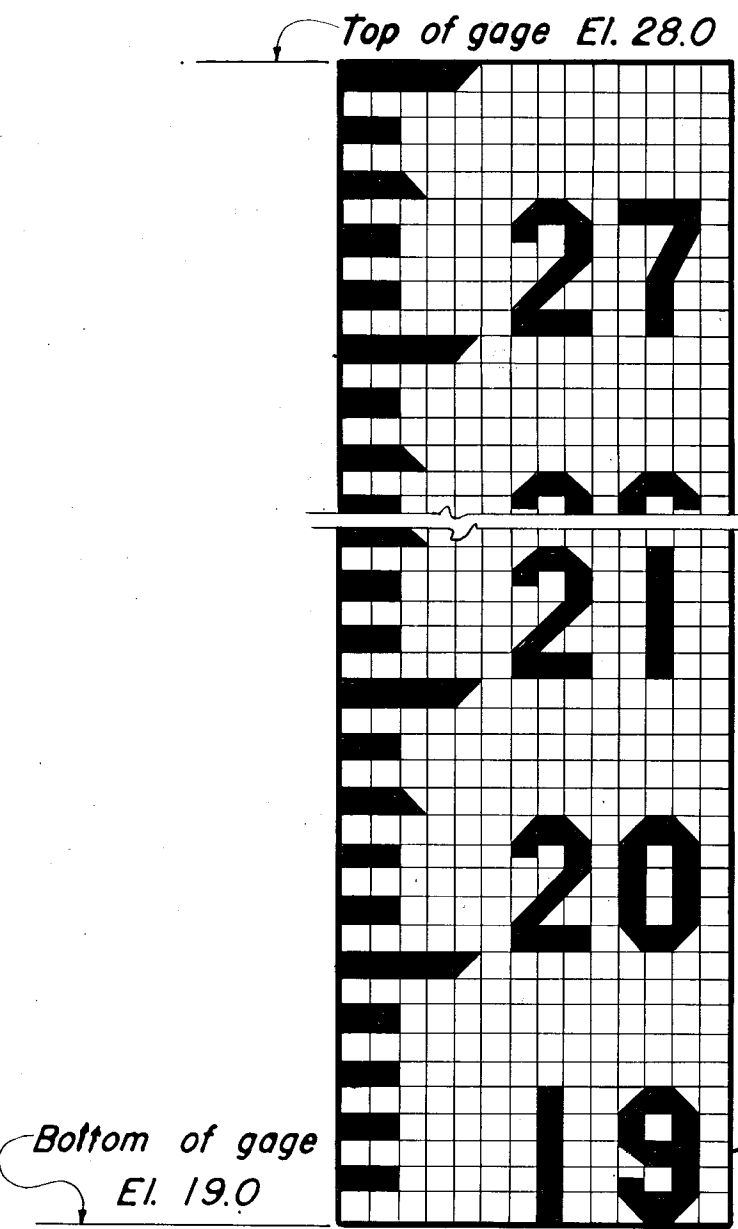


VERTICAL GAGE NO. 1
NOT TO SCALE

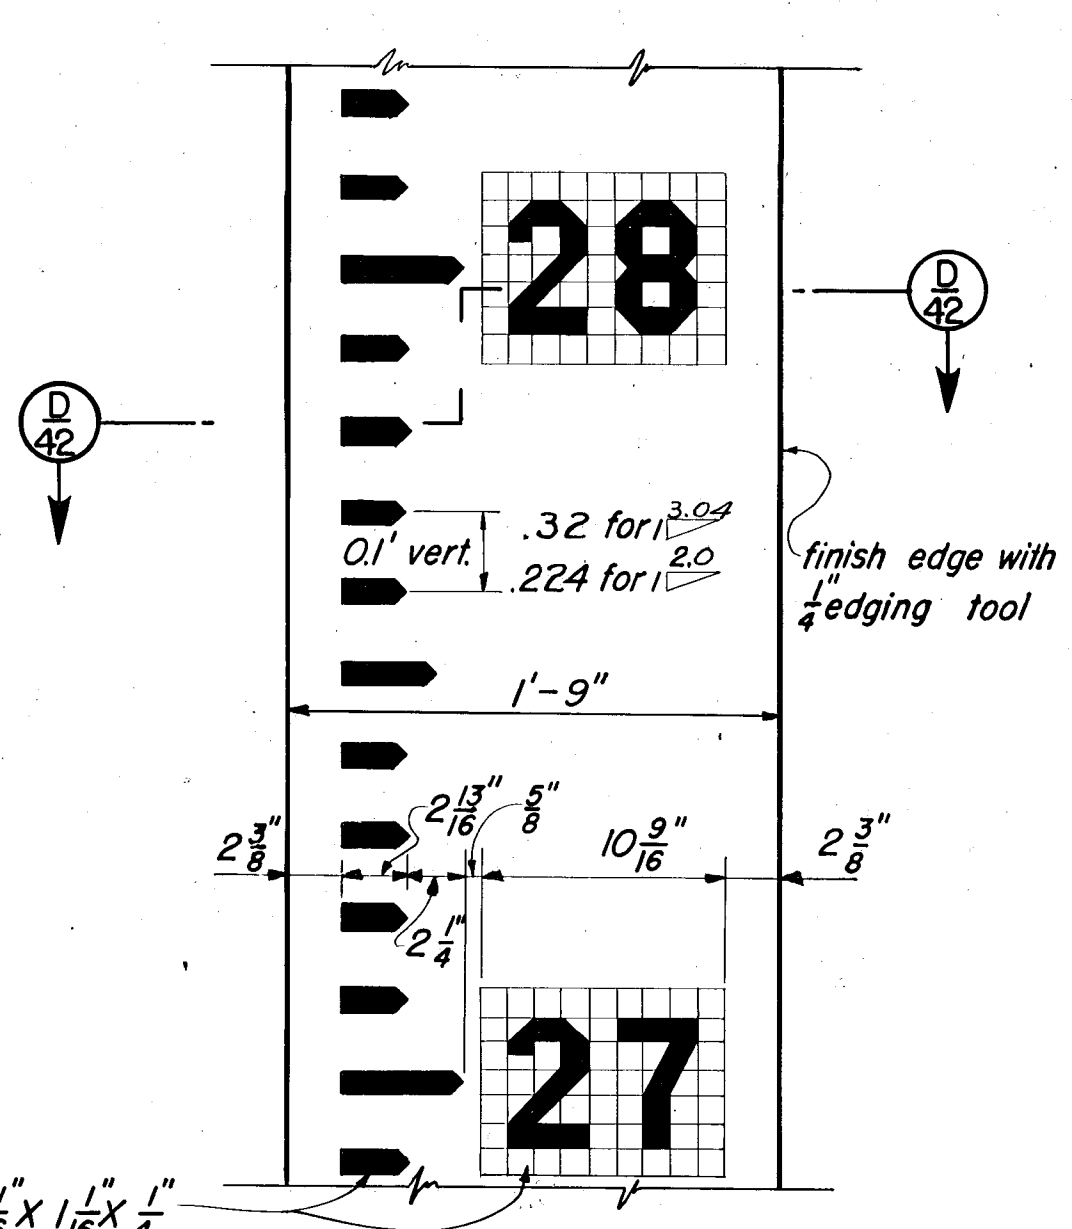


SLOPED GAGE NOS. 2 & 3
NOT TO SCALE


LEGEND
□ White — Background
■ Black — Figures and graduations

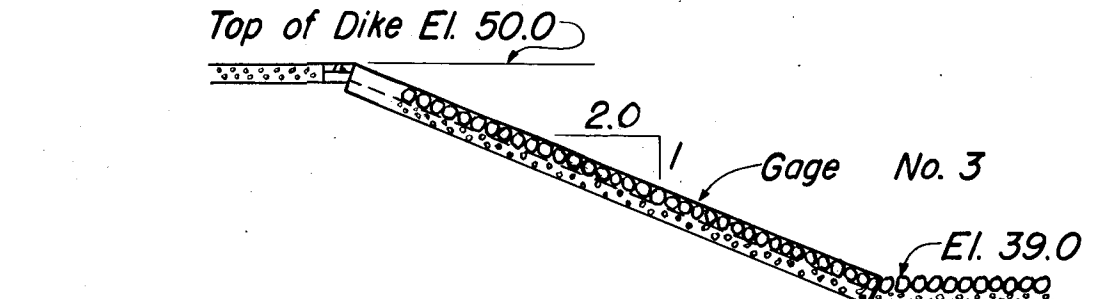


SECTION A
SCALE: 1" = 10'

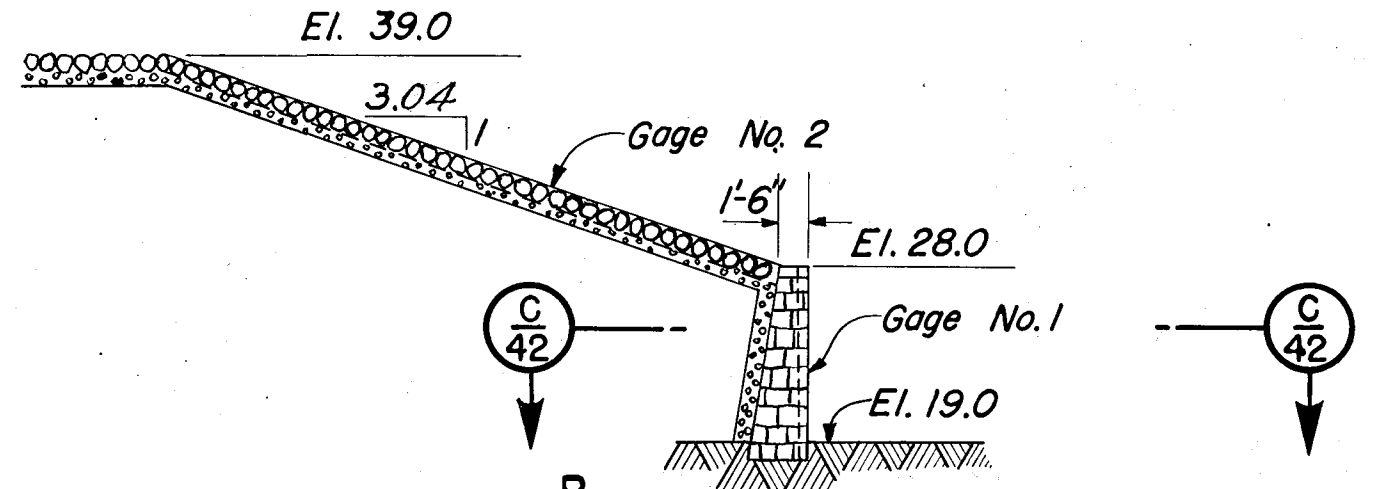

SECTION B
SCALE: 1" = 10'

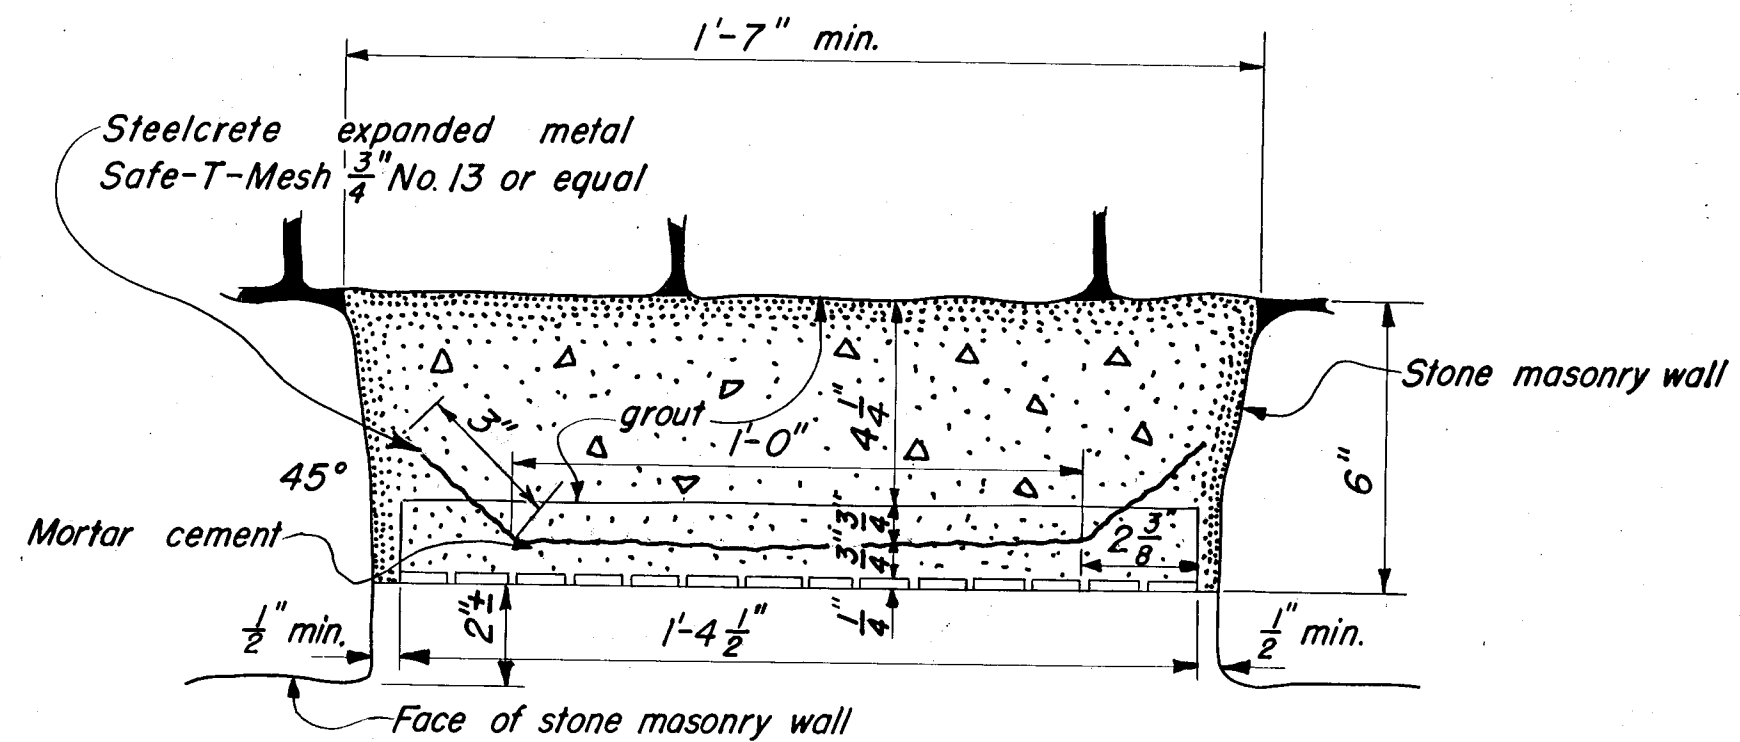

SECTION C
TYPICAL FOR GAGE NO. 1
SCALE: 3" = 1'-0"

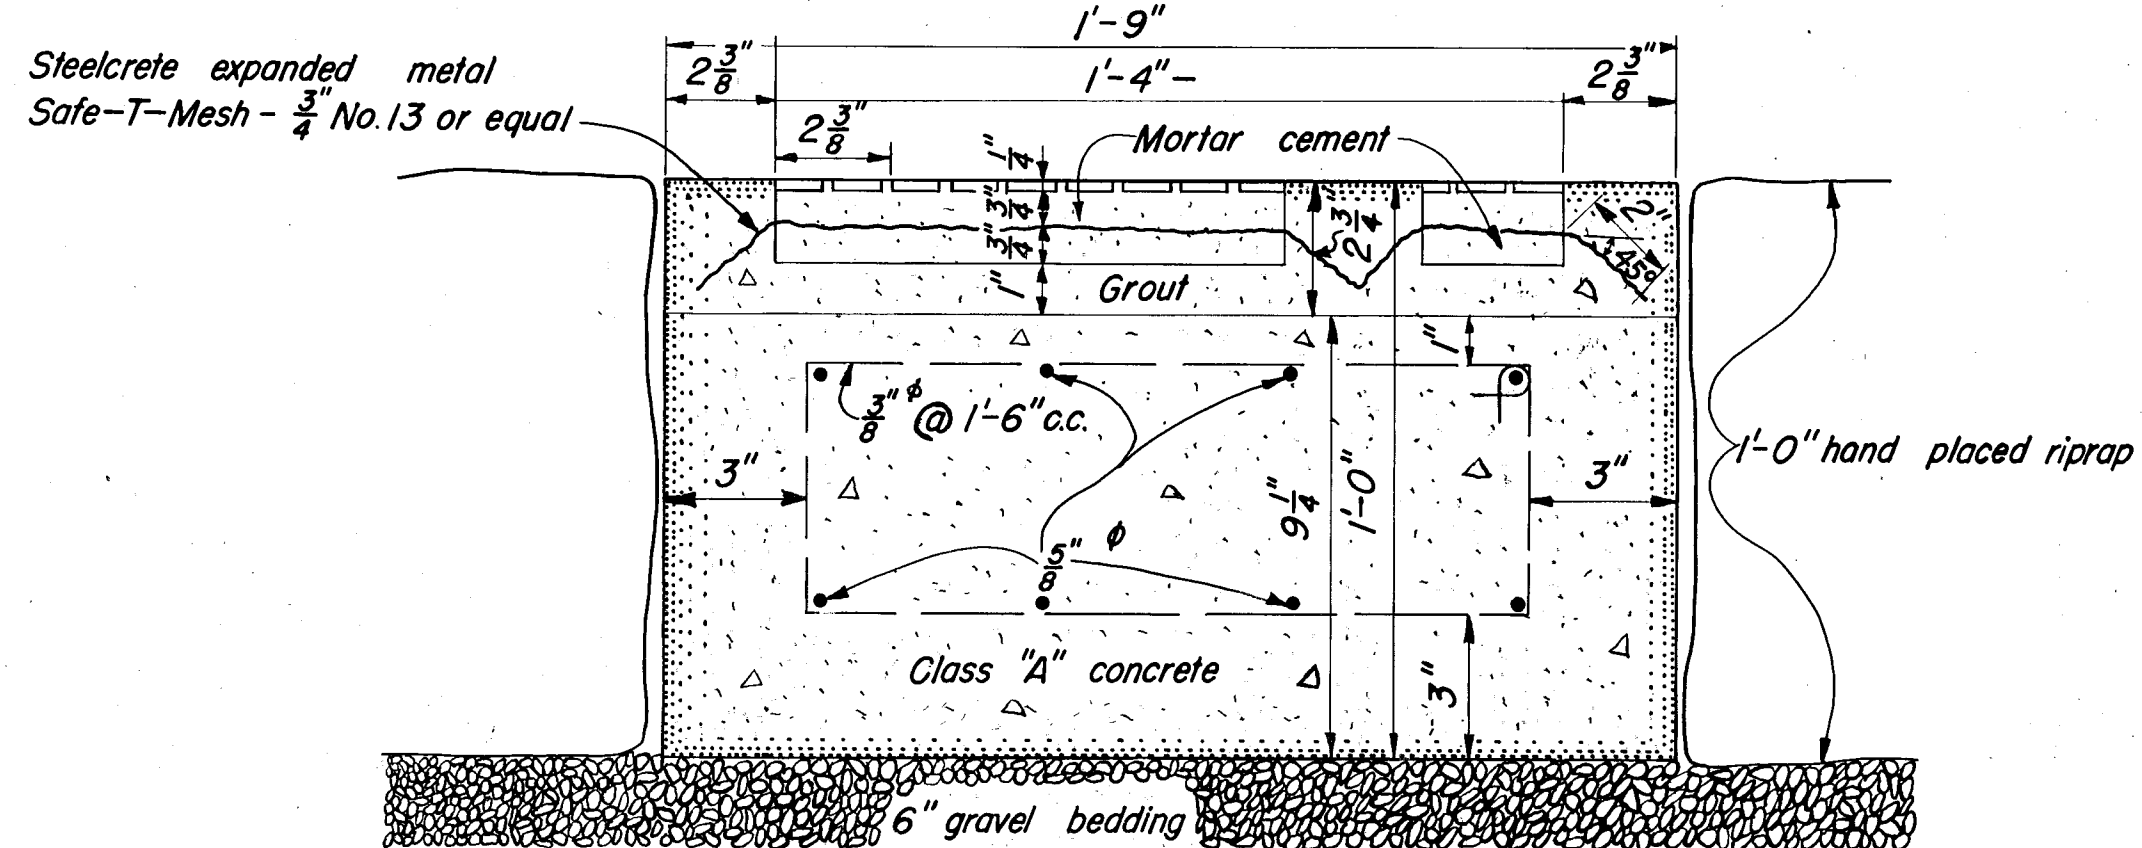

SECTION D
TYPICAL FOR GAGE NO. 2 & 3
SCALE: 3" = 1'-0"

TABLE				
GAGE	TOPEL.	BOT. EL.	SLOPE	NUMBERS
NO. 1	28.0	19.0	VERT.	19 to 27
NO. 2	39.0	28.0	1 on 3	29 to 38
NO. 3	50.0	39.0	1 on 2.5	40 to 49

NOTES:
All elevations refer to Mean Sea Level Datum
Payment for all work connected with the installation of gages shall be made under item No. 34

RECORD
DRAWINGS

THIS SHEET ADDED AS OF CHANGE ORDER NO. 10

CONNECTICUT RIVER FLOOD CONTROL	
PARK RIVER CONDUIT	
HARTFORD, CONN.	
TILE STAFF GAGES	
CONNECTICUT RIVER	CONNECTICUT
IN 46 SHEETS	SHEET NO. 42
SCALE: 1 IN. = 40 FT.	
U.S. ENGINEER OFFICE, PROVIDENCE, R.I., APRIL 1942	
SUBMITTED BY: J. C. Russell	APPROVED: J. C. Russell
DESIGNED BY: C. D. Chase	TRACED BY: R. D. A.
ASSOC. ENGINEER	CHECKED: F. D. C.
FILE NO. CT-4-3122	

KEY	DATE	REVISION (Indicated by Δ)	REV. BY	CK. BY	AP. BY
	12-31-45	As built revisions			