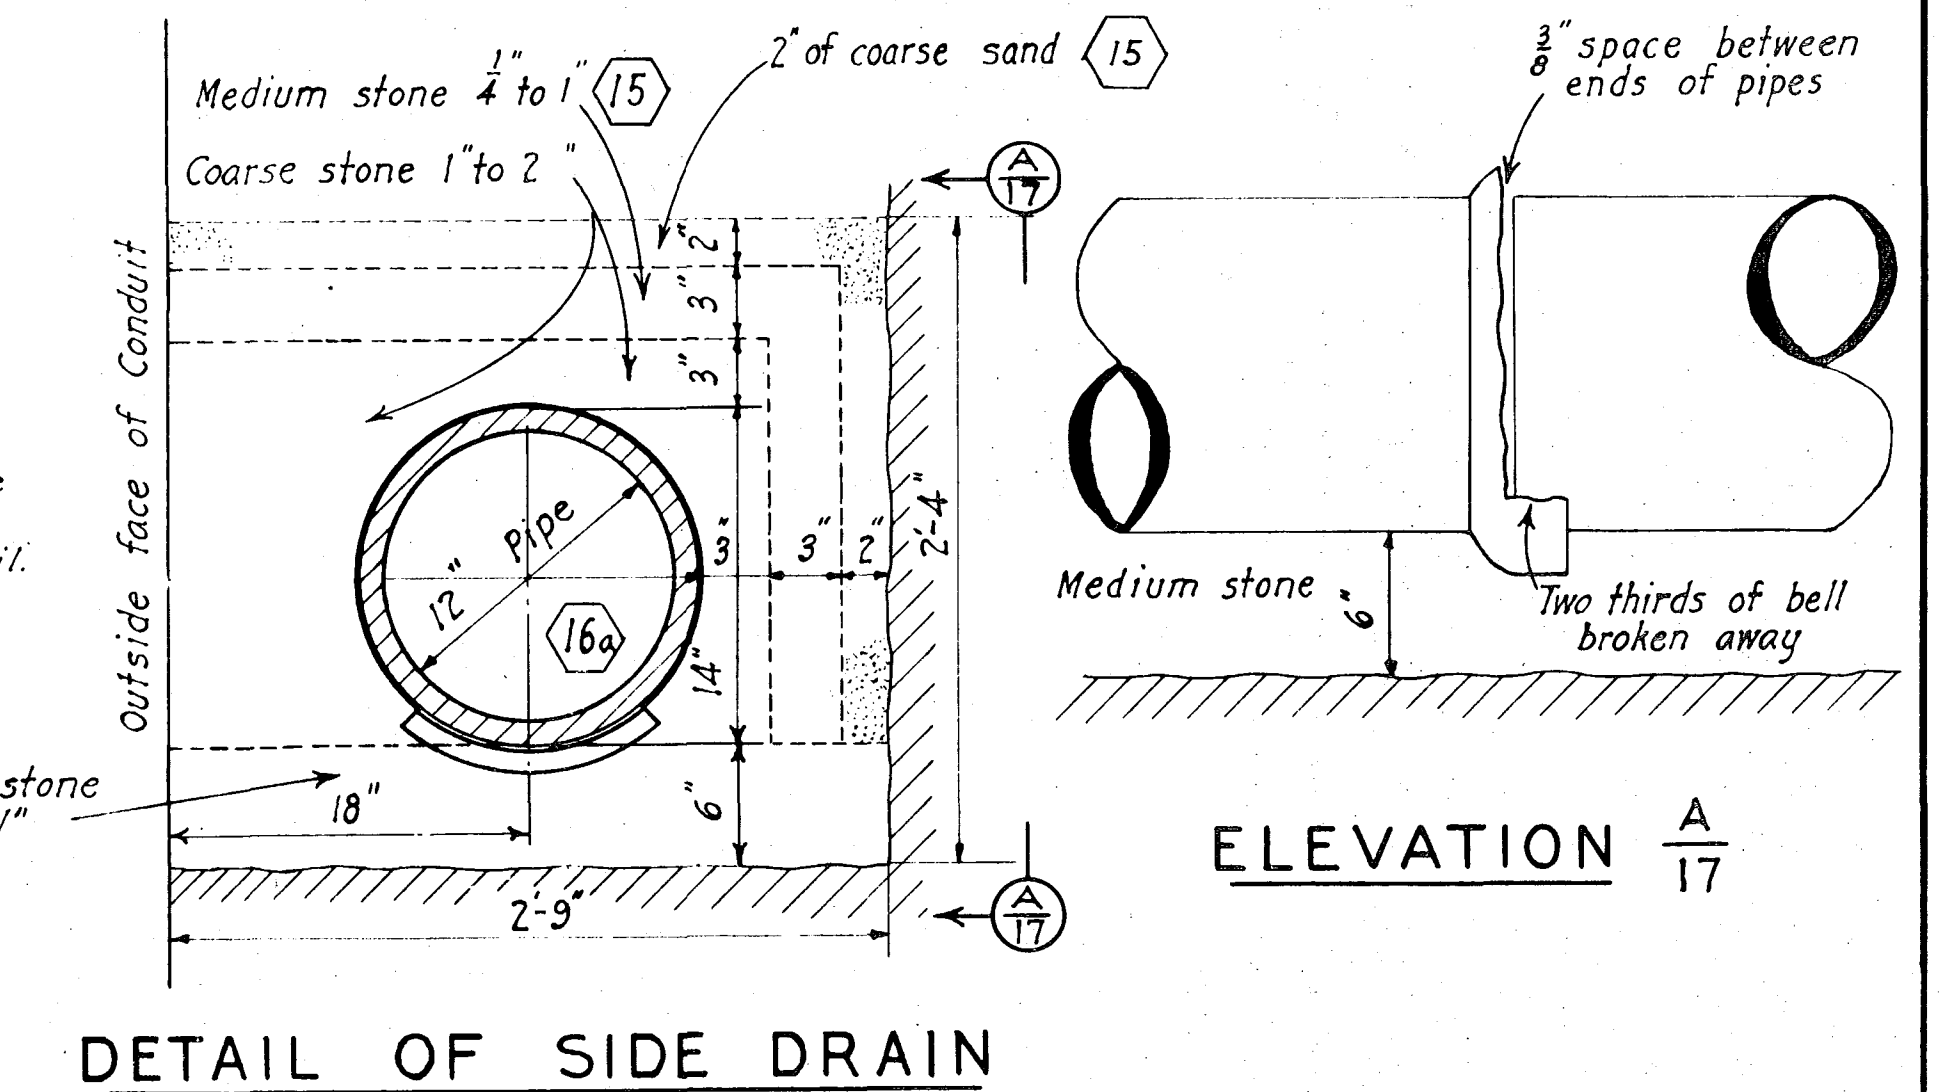
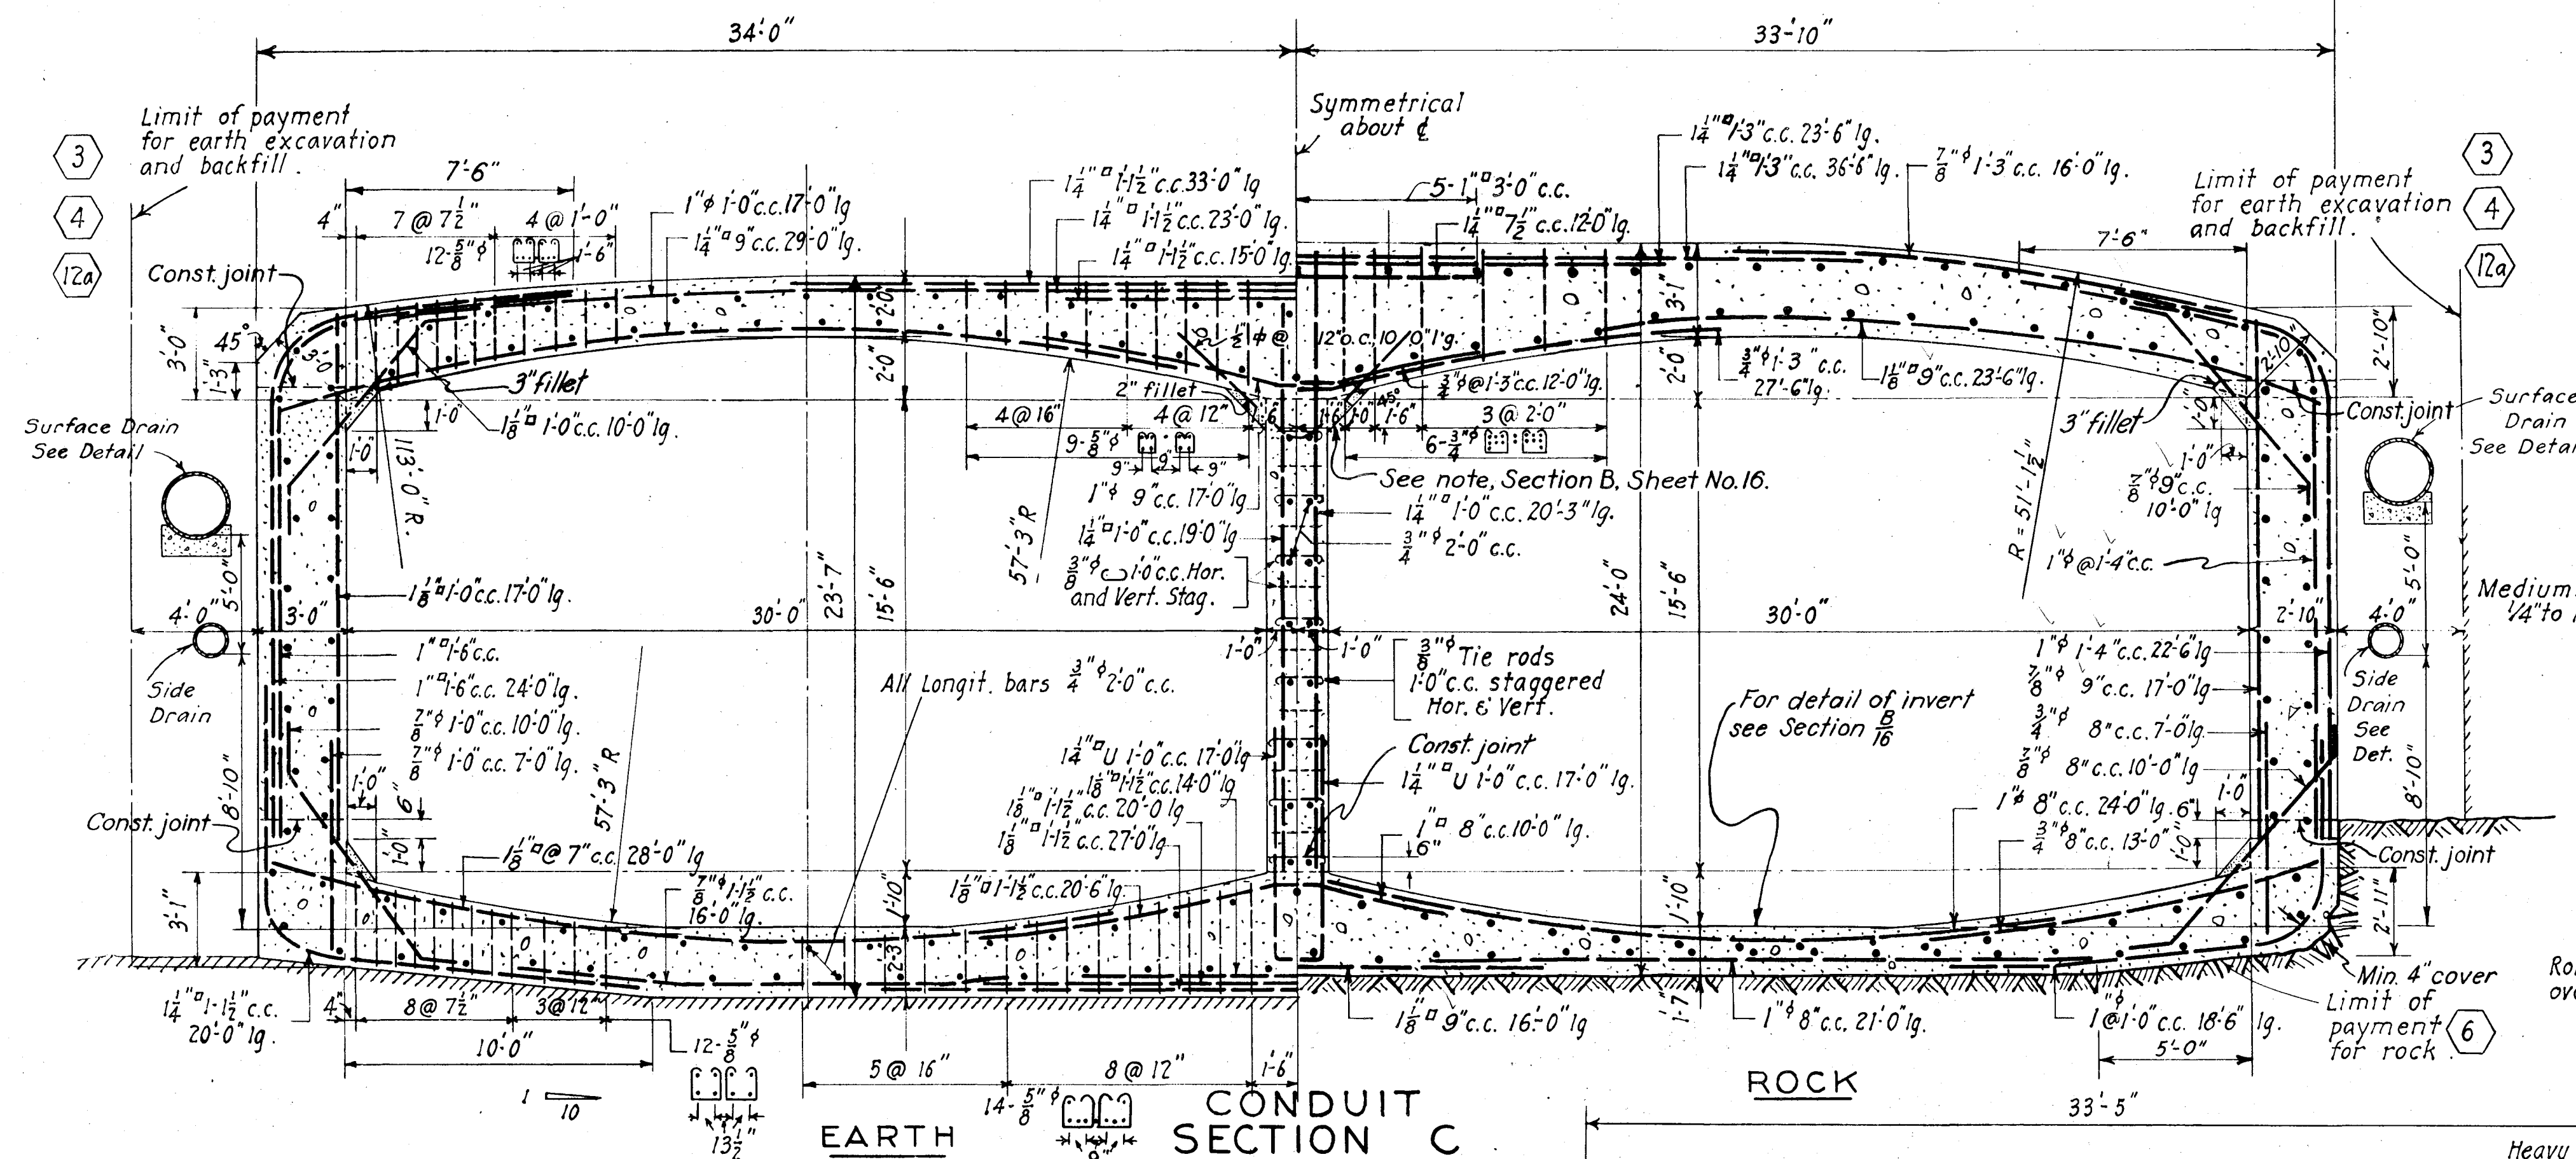
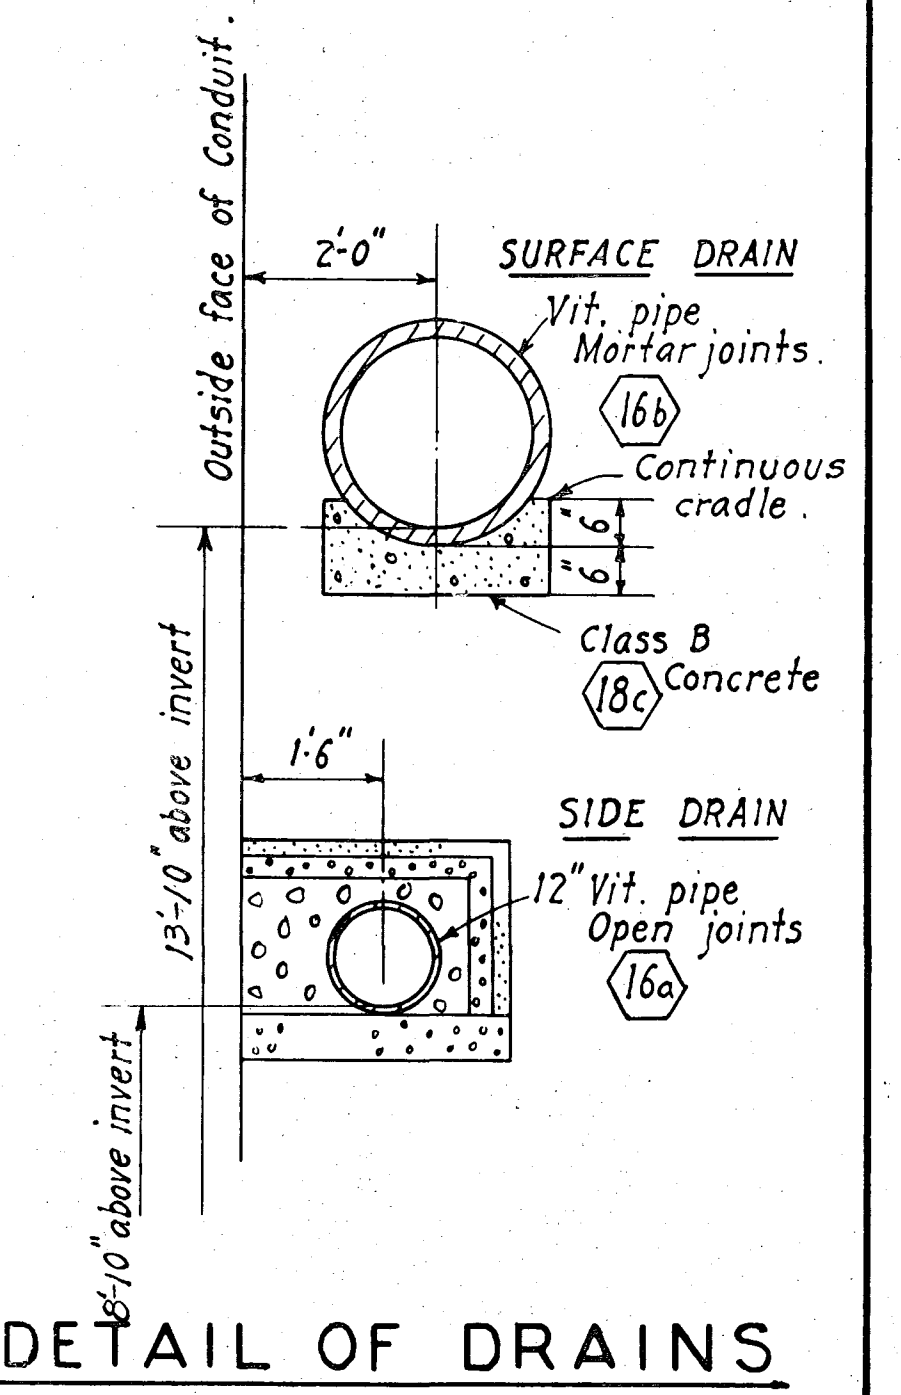
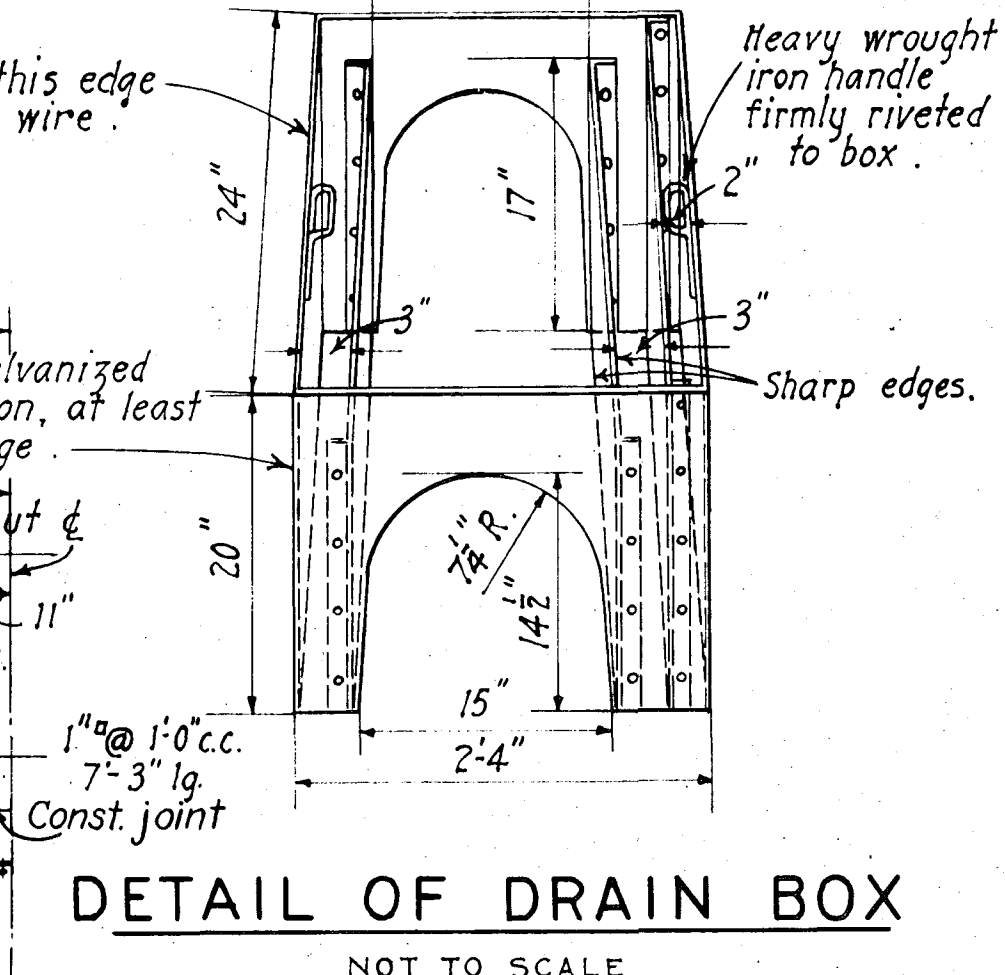
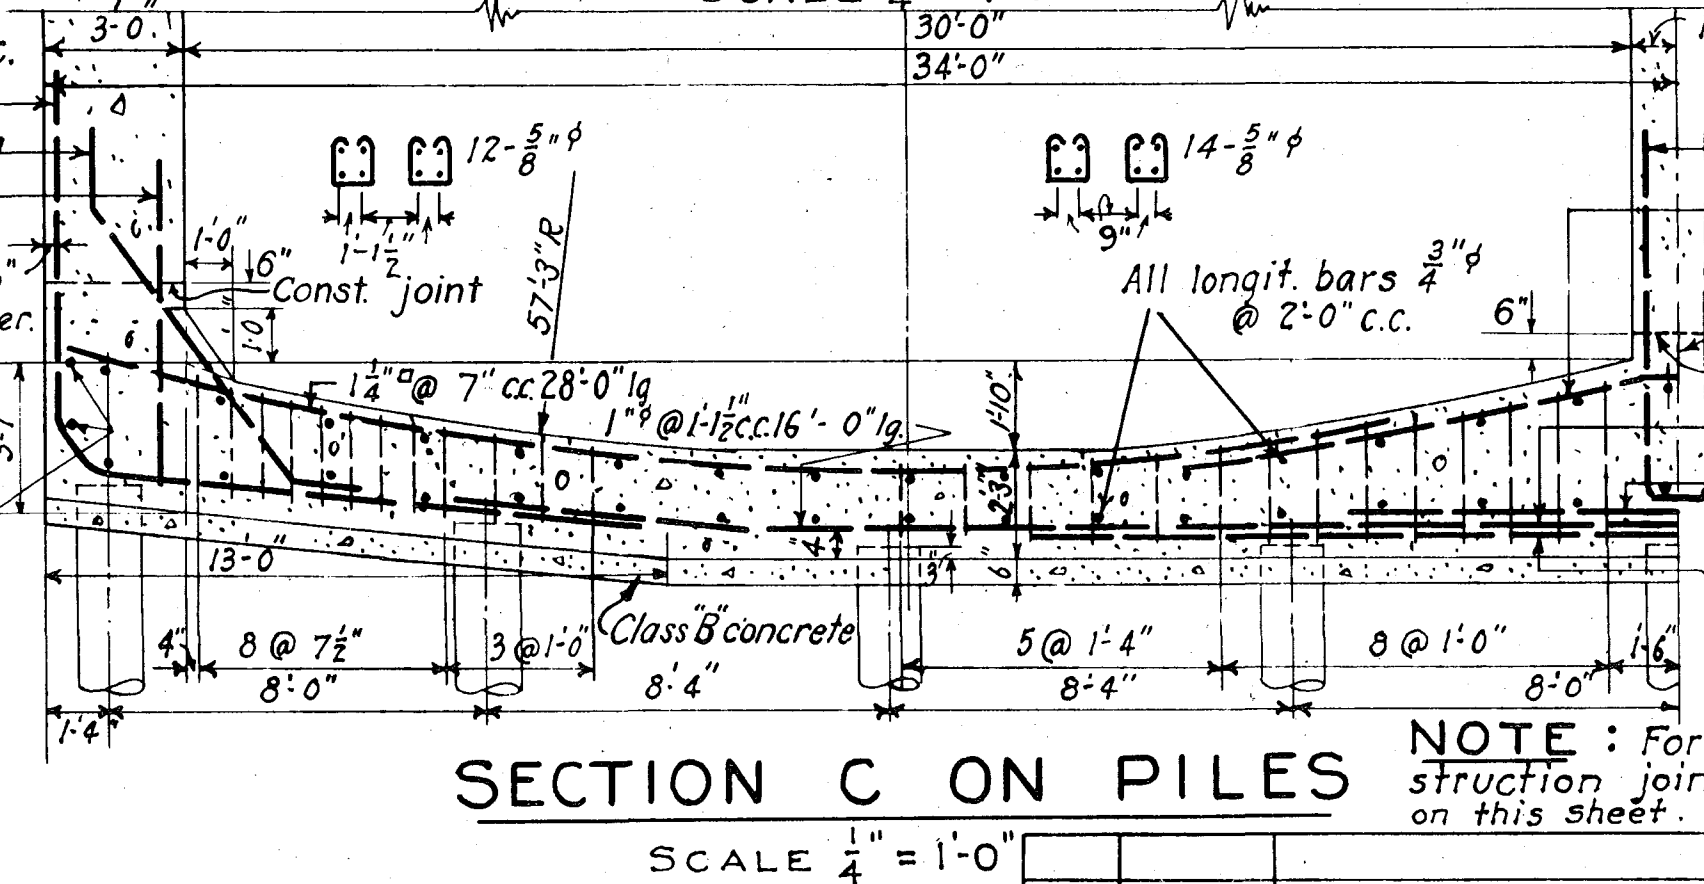
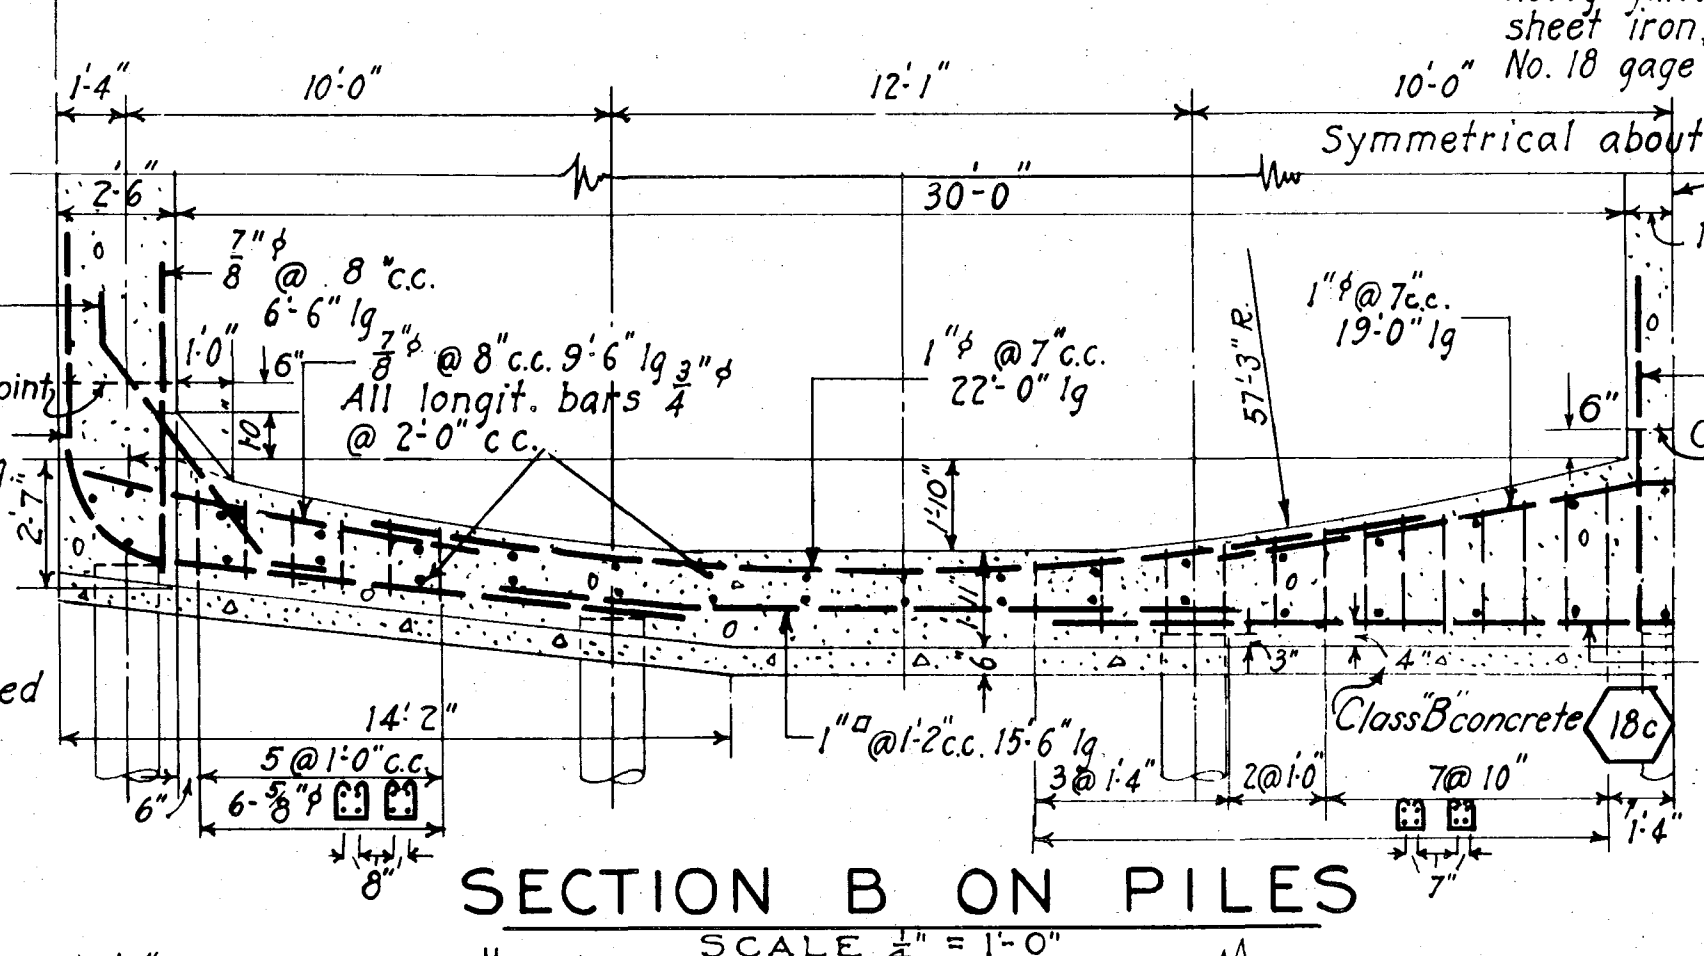
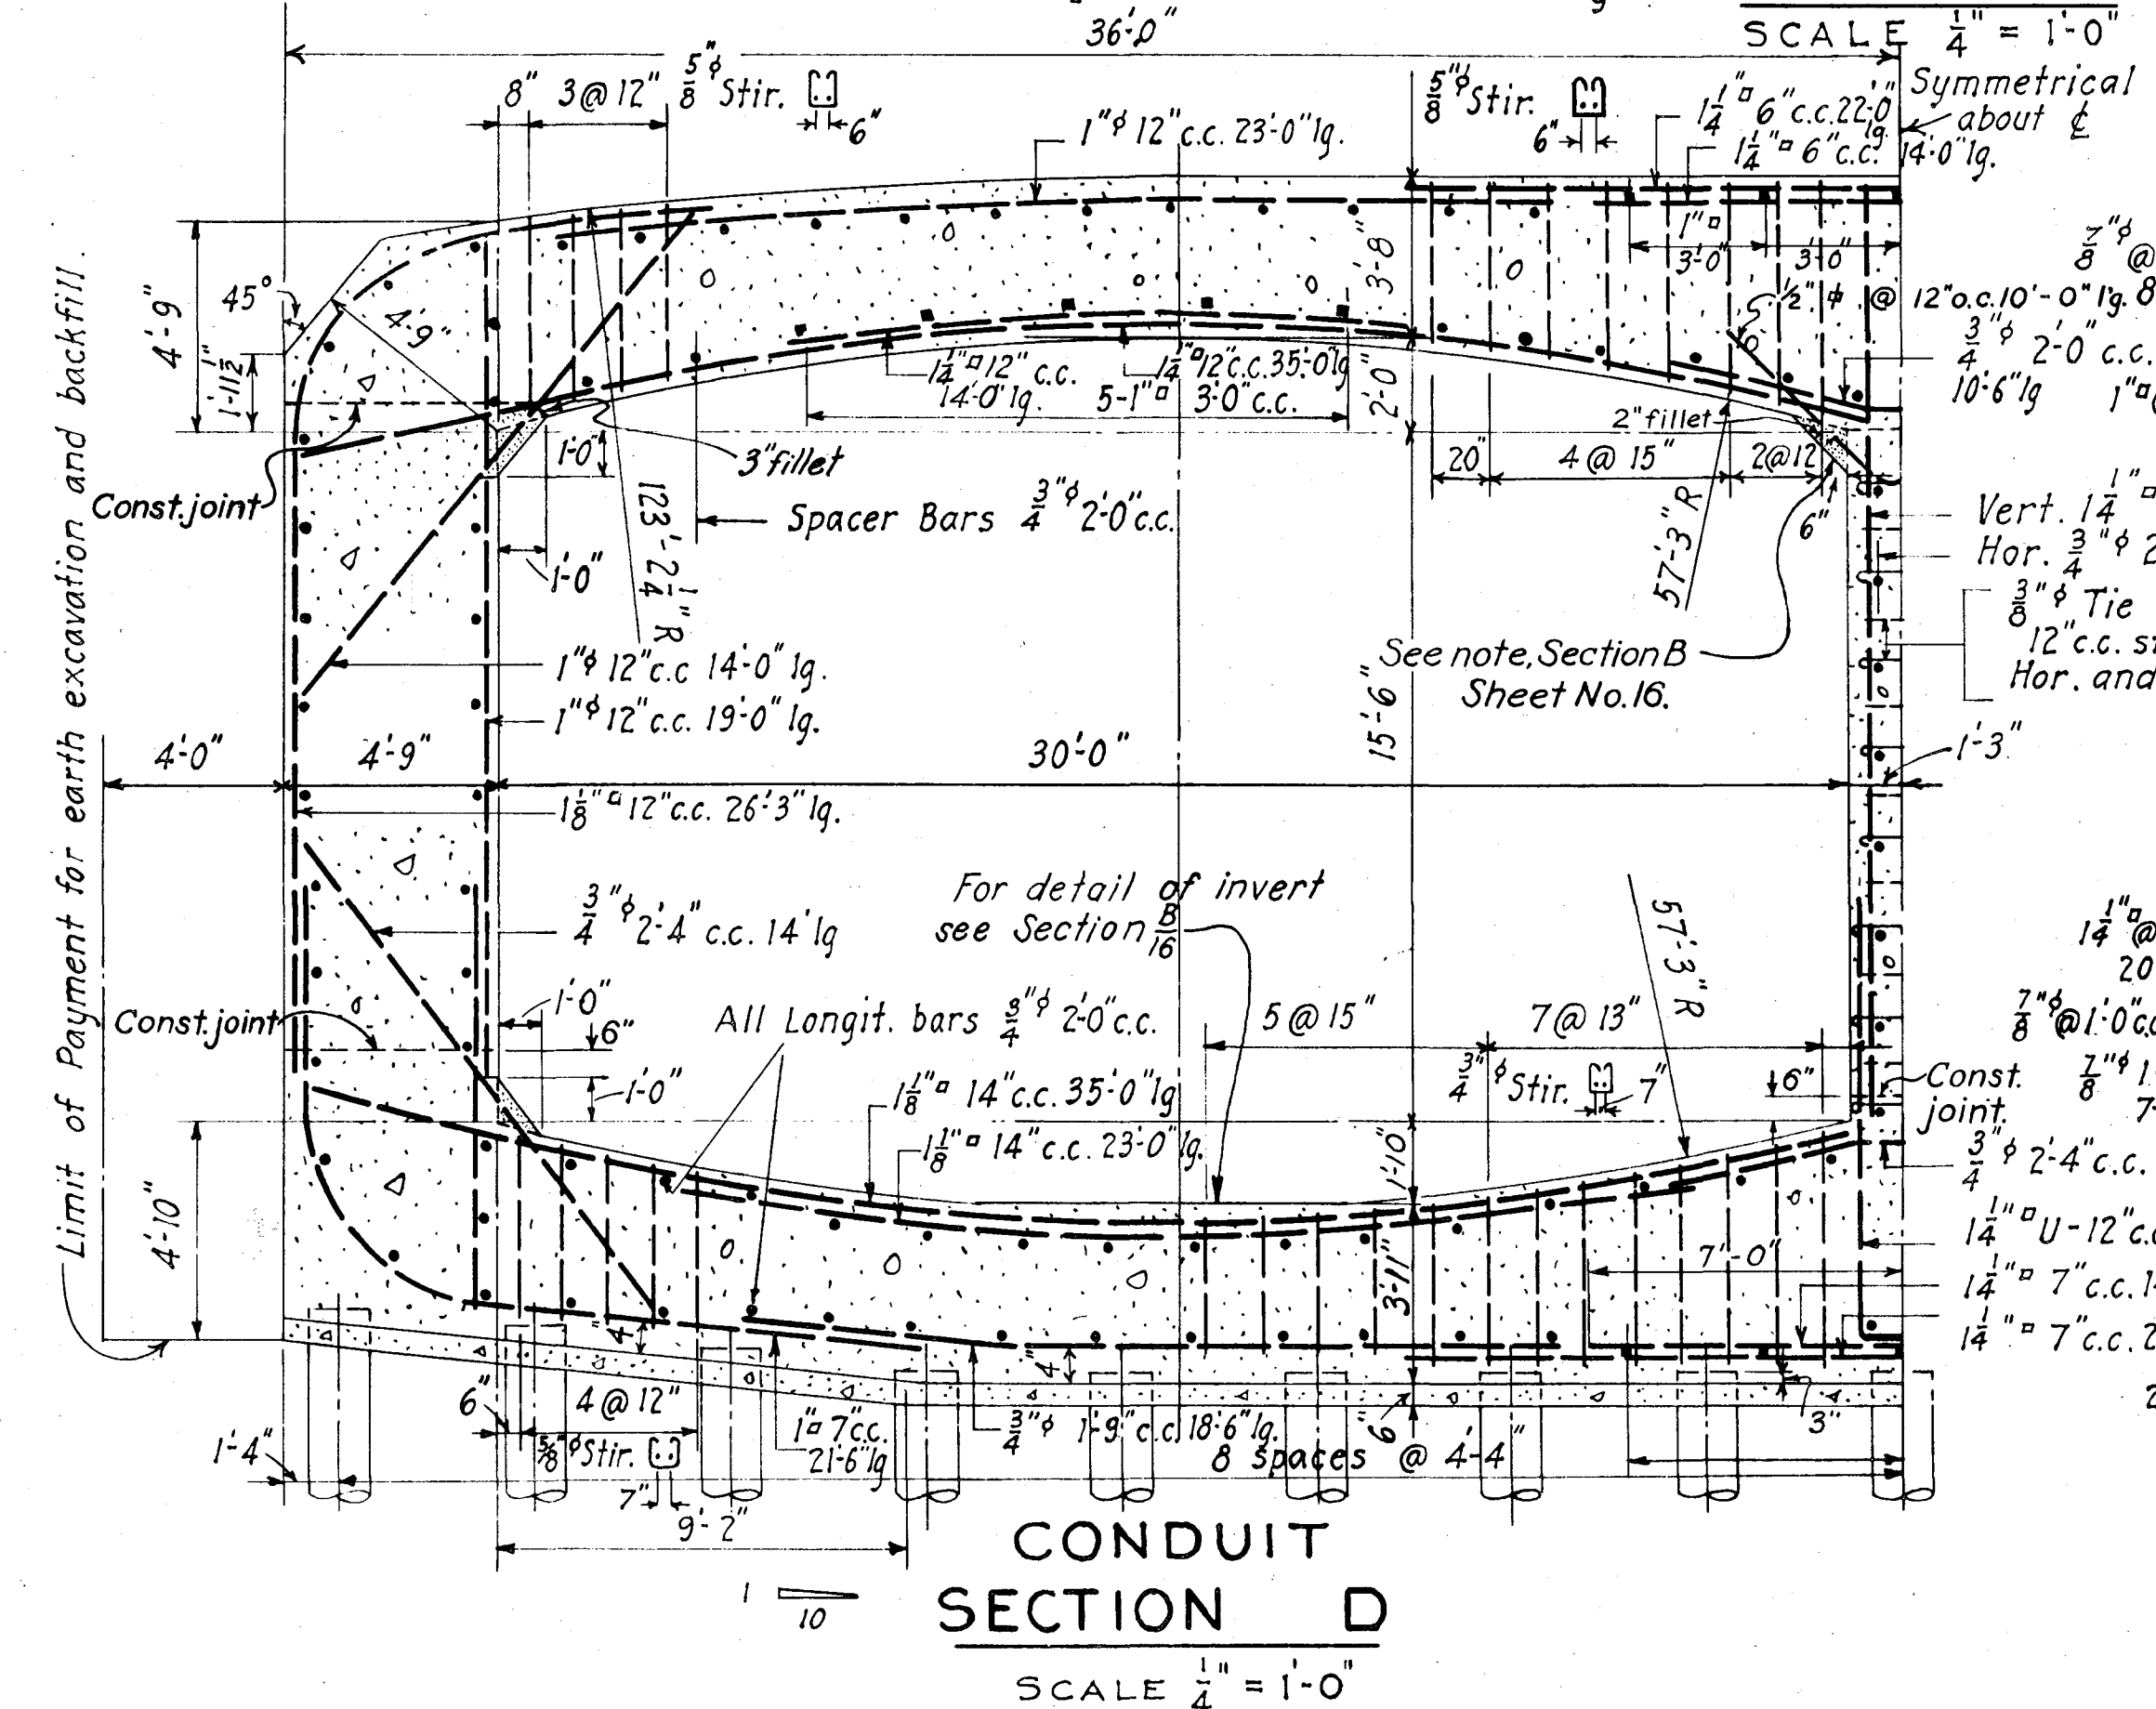


ELEVATION A
17

NOTE: For Reinforcement above construction joints, see Section "B" on Earth, Sheet No. 16.

NOTES

For general notes applying to details shown on this sheet, see Sheet No. 16.

THIS SHEET ADDED TO SET.

CONNECTICUT RIVER FLOOD CONTROL
PARK RIVER CONDUIT
HARTFORD, CONN.

CONDUIT SECTIONS NO. 2A

CONNECTICUT RIVER CONNECTICUT
IN 48 SHEETS SCALE: 1/4 IN. = 1 FT. SHEET NO. 44

U.S. ENGINEER OFFICE PROVIDENCE, R.I. SEPT. 1942

SUBMITTED BY: H. C. Eddy METCALF & EDDY BOSTON, MASS.	APPROVAL RECOMMENDED: J. C. Burns SENIOR ENGINEER CHIEF, ENGINEERING DIV.	APPROVED: W. L. Brown COL. CORPS OF ENGINEERS DISTRICT ENGINEER
DRAWN BY: G. C. D. TRACED BY: C. M. R. CHECKED BY: J. J. J.		FILE NO. CT-4-3139

METCALF & EDDY
ENGINEERS
BOSTON, MASS.

KEY	DATE	REVISION (Indicated by Δ)	CK. BY	AP. BY
12-31-45		As built revisions		