
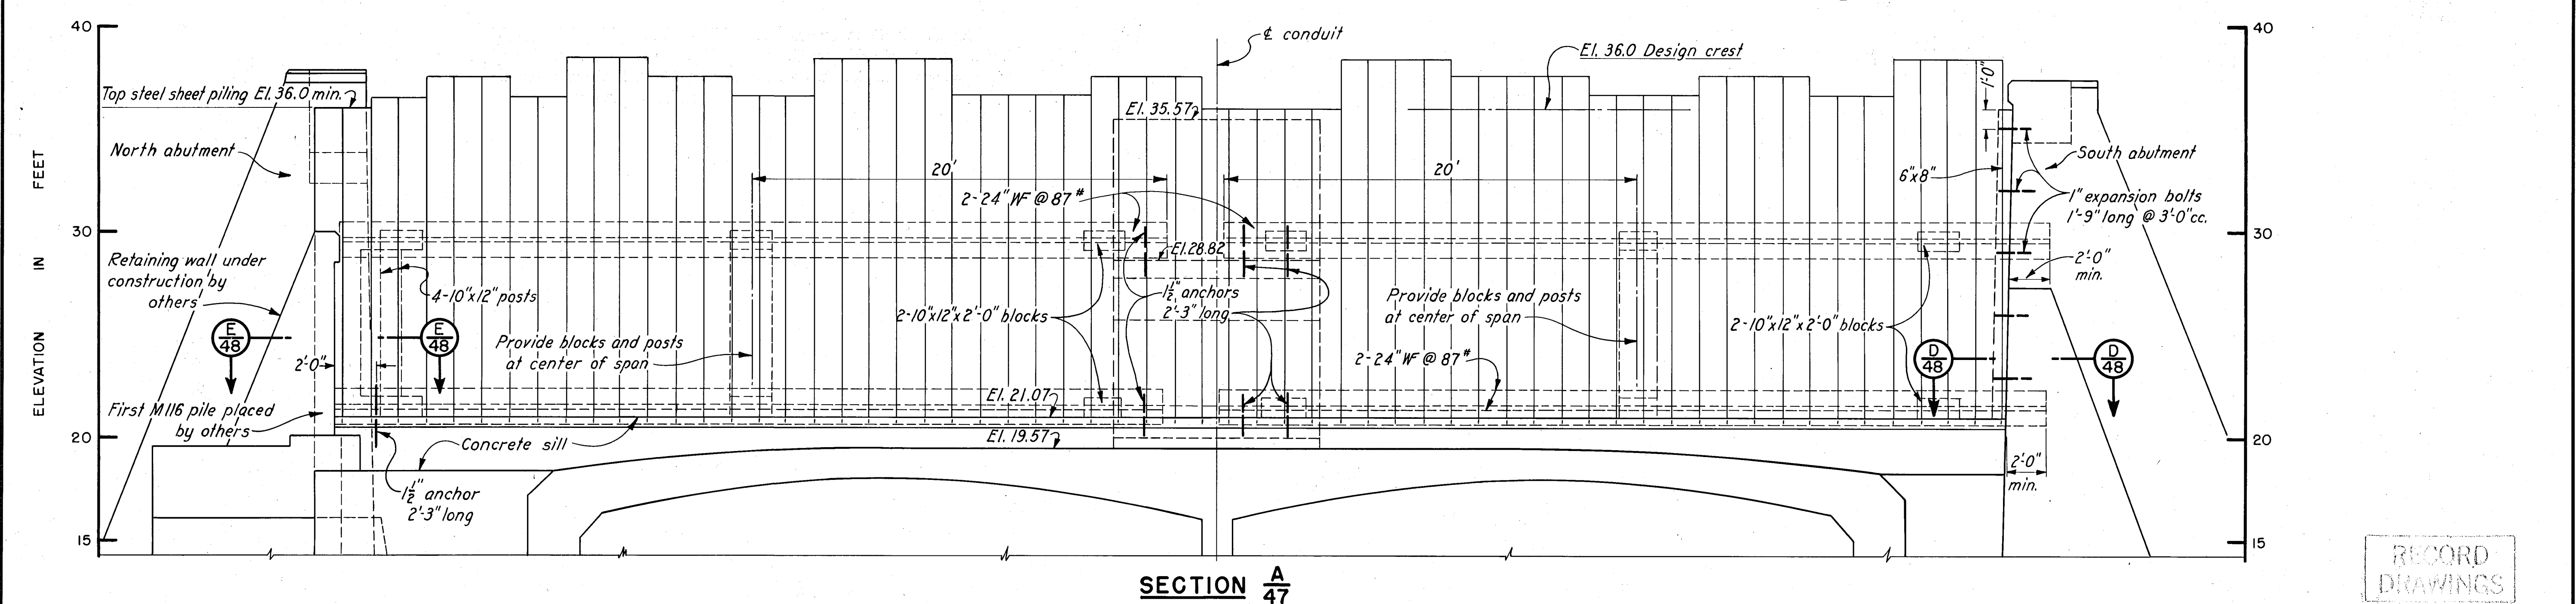


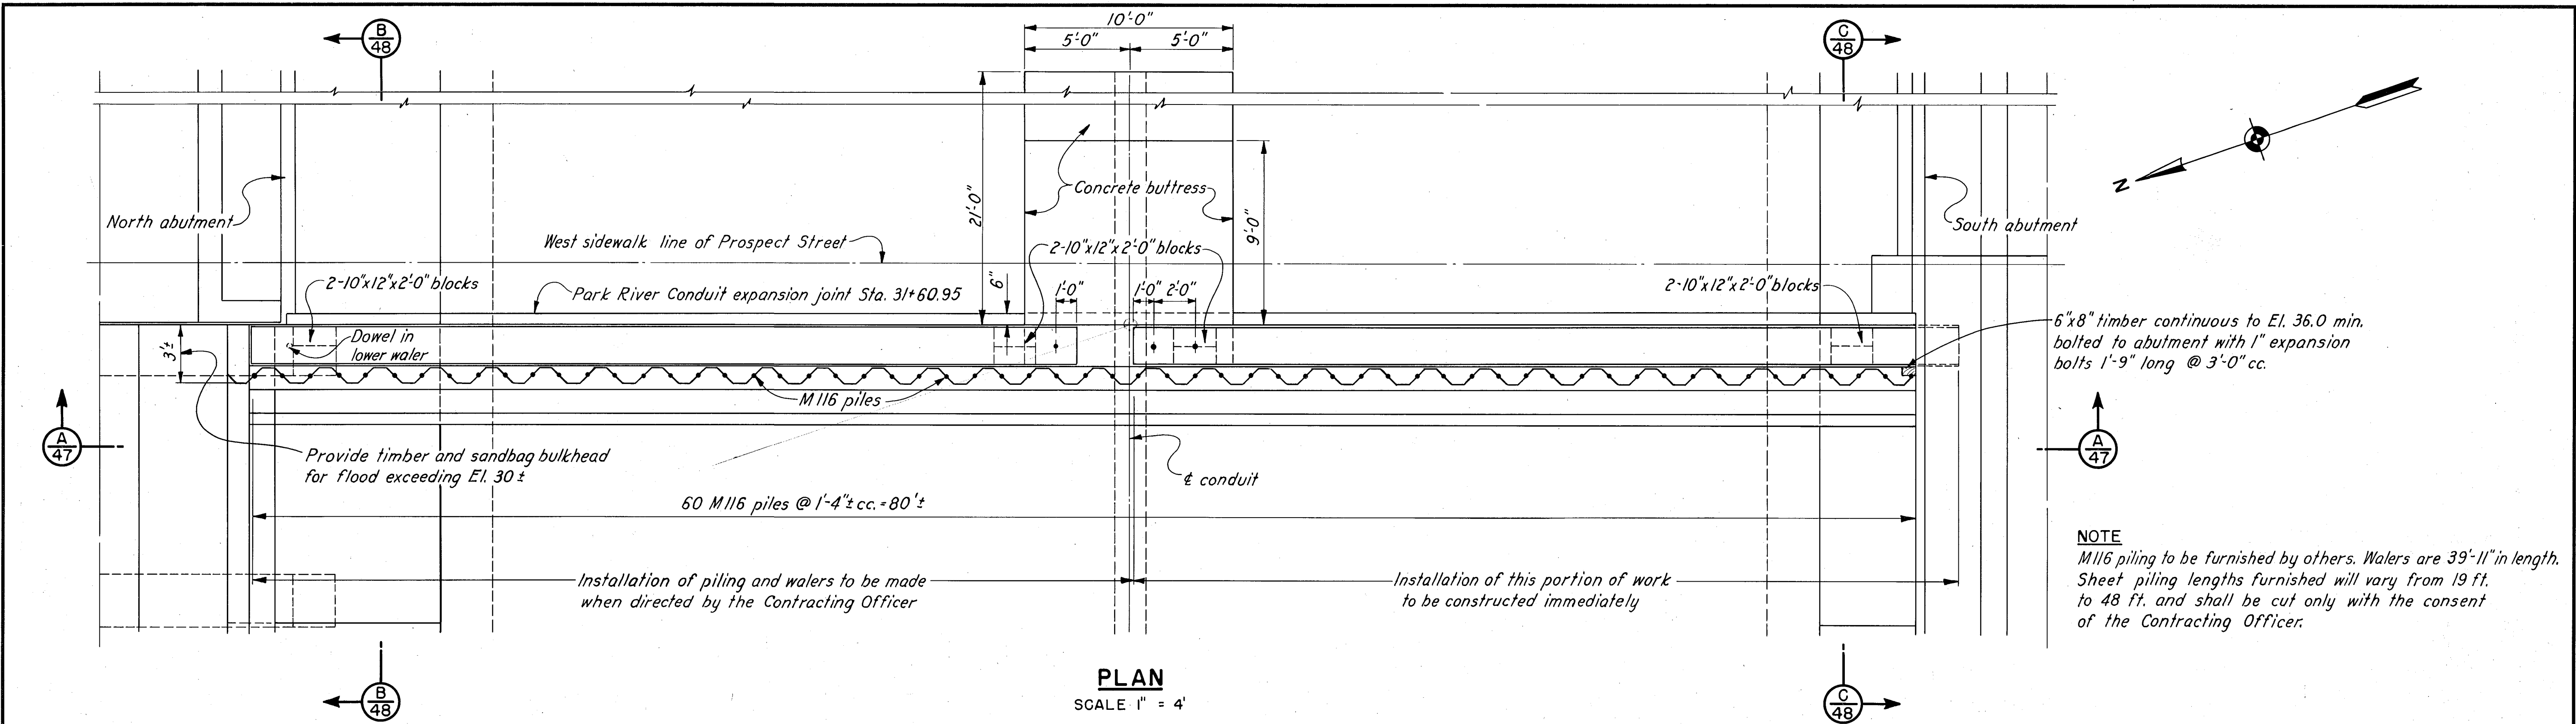

NOTES
Elevations refer to Mean Sea Level datum.
M116 piles to be furnished by others.
Bolt every other pile to top waler. Bolt every fourth pile to bottom waler.
All concrete shown will be class "A"

THIS SHEET ADDED TO SET.

CONNECTICUT RIVER FLOOD CONTROL
PARK RIVER CONDUIT
HARTFORD, CONN.

TEMPORARY SHEET PILE BULKHEAD AT PROSPECT STREET - PLAN AND SECTION

CONNECTICUT RIVER SCALE 1 IN. = 4 FT. CONNECTICUT
IN 48 SHEETS SHEET NO. 47

U. S. ENGINEER OFFICE, PROVIDENCE, R. I., MARCH 1943

APPROVAL RECOMMENDED: APPROVED:
J. C. Dignall J. Burns
SENIOR ENGINEER PRINCIPAL ENGINEER
HEAD, DESIGN SECTION CHIEF, ENGINEERING DIVISION COL., CORPS OF ENGINEERS
DESIGN SECTION: D. D. Clark TRACED: H. R. F. FILE NO. CT-4-3143
ASSOC. ENGINEER CHECKED: E. P. C.

KEY	DATE	REVISION (Indicated by Δ)	REV. BY	CK. BY	AP. BY
	12-31-45	As built			