
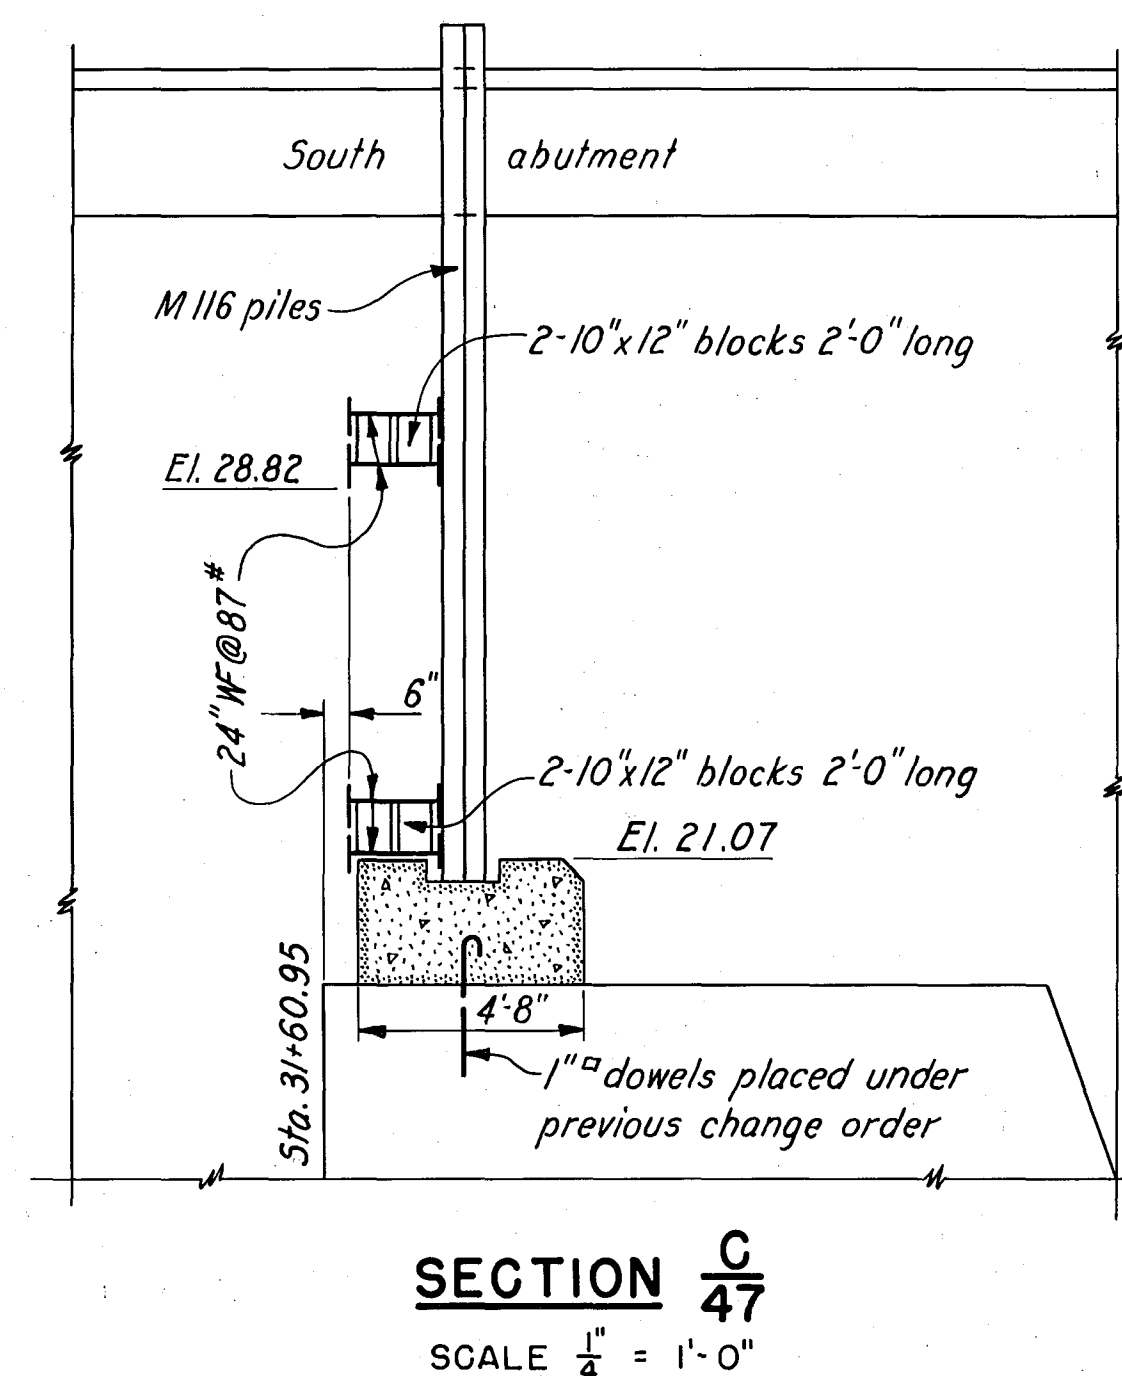
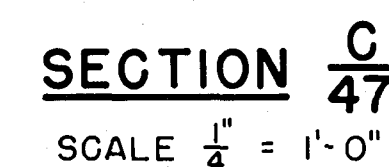
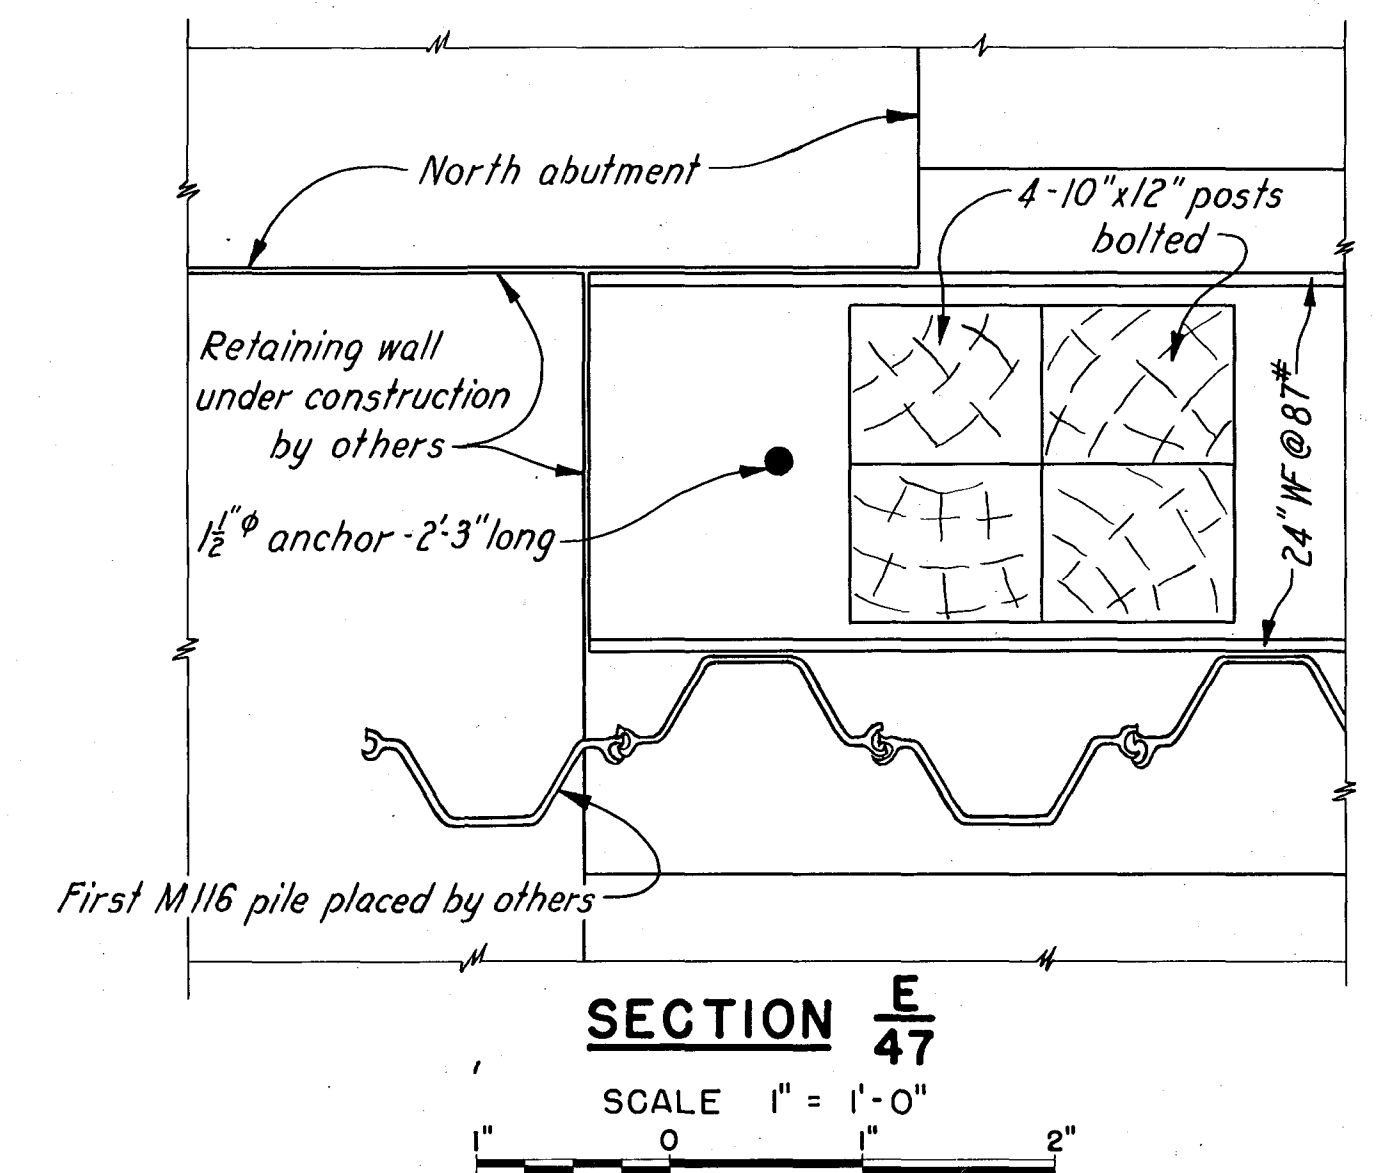
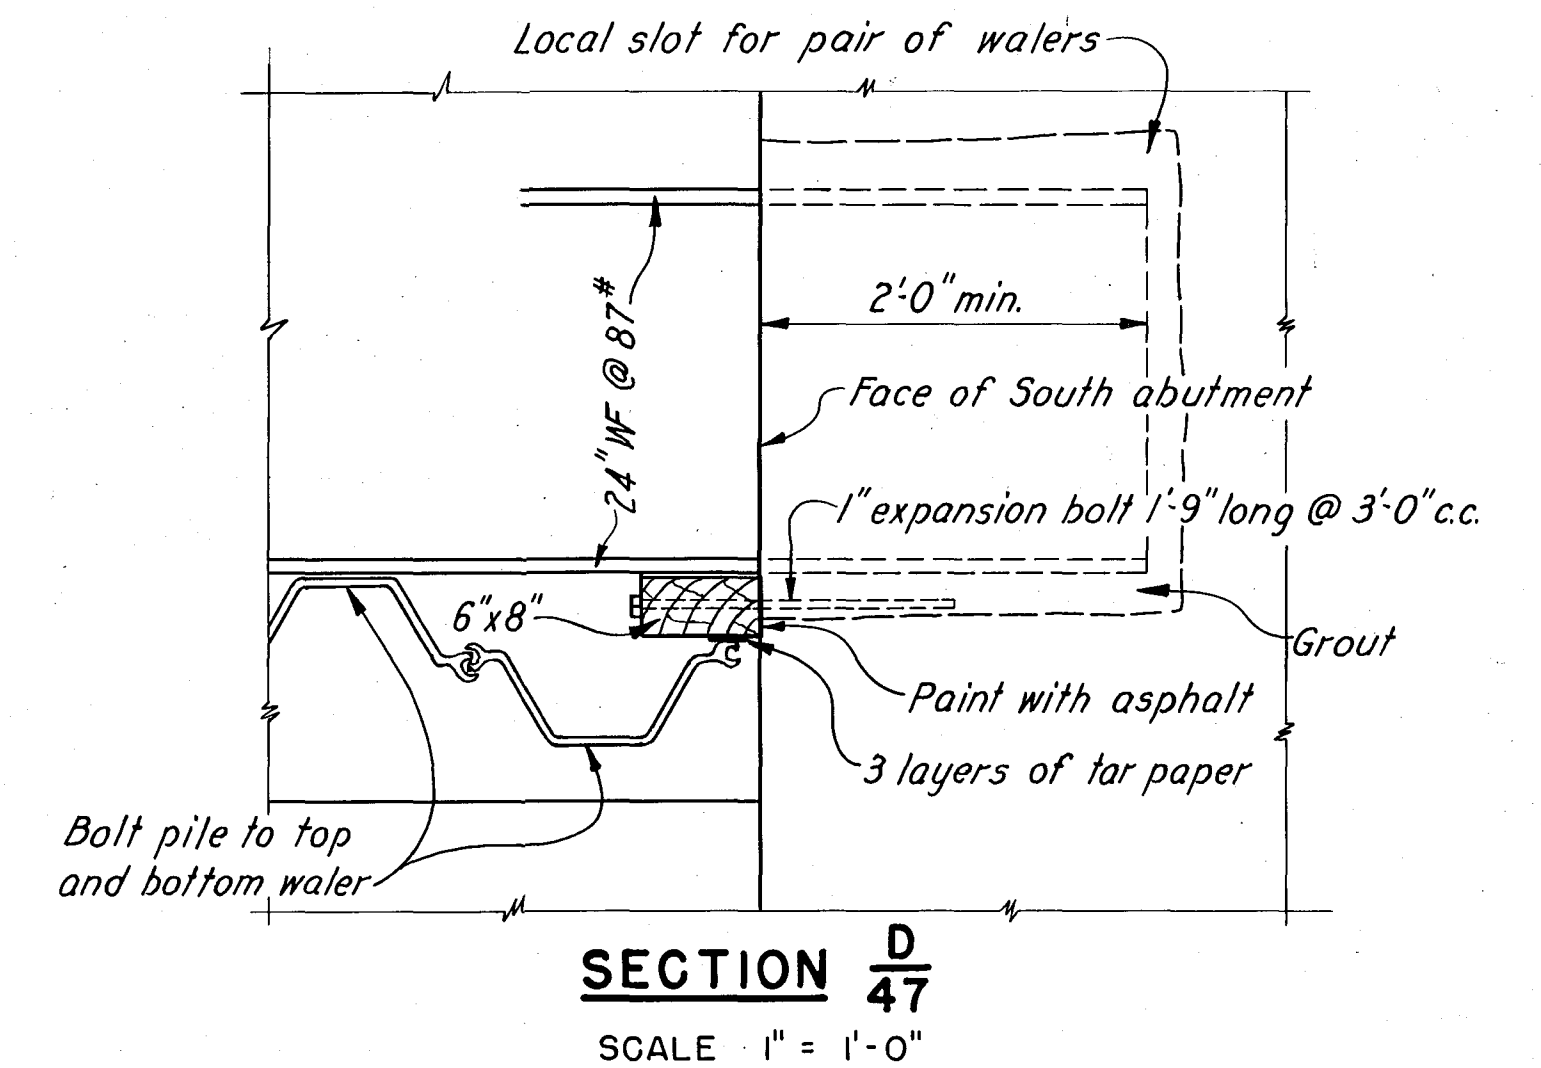


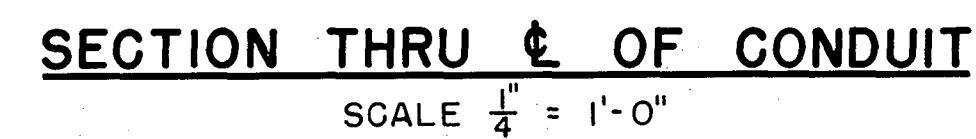

RECORD
DRAWINGS

	12-31-45	As built			
KEY	DATE	REVISION (Indicated by Δ)	REV. BY	CK. BY	AP. BY

THIS SHEET ADDED TO SET.		
CONNECTICUT RIVER FLOOD CONTROL PARK RIVER CONDUIT HARTFORD, CONN.		
TEMPORARY SHEET PILE BULKHEAD AT PROSPECT STREET - DETAILS		
CONNECTICUT RIVER		CONNECTICUT
IN 48 SHEETS	SCALE 1/4 IN. = 1 FT.	SHEET NO. 48
0' 10'	0' 5' 10'	10'
U. S. ENGINEER OFFICE, PROVIDENCE, R.I., MARCH 1943		
SUBMITTALS: 	APPROVAL RECOMMENDED: 	APPROVED:
SENIOR ENGINEER HEAD, DESIGN SECTION	PRINCIPAL ENGINEER CHIEF, ENGINEERING DIVISION	COL., CORPS OF ENGINEERS DISTRICT ENGINEER
DESIGN SECTION: ASOC. ENGINEER	DRAWN: D. W. G. CHECKED: H. R. F. CHECKED: S. D. C.	FILE NO. CT-4-3144