

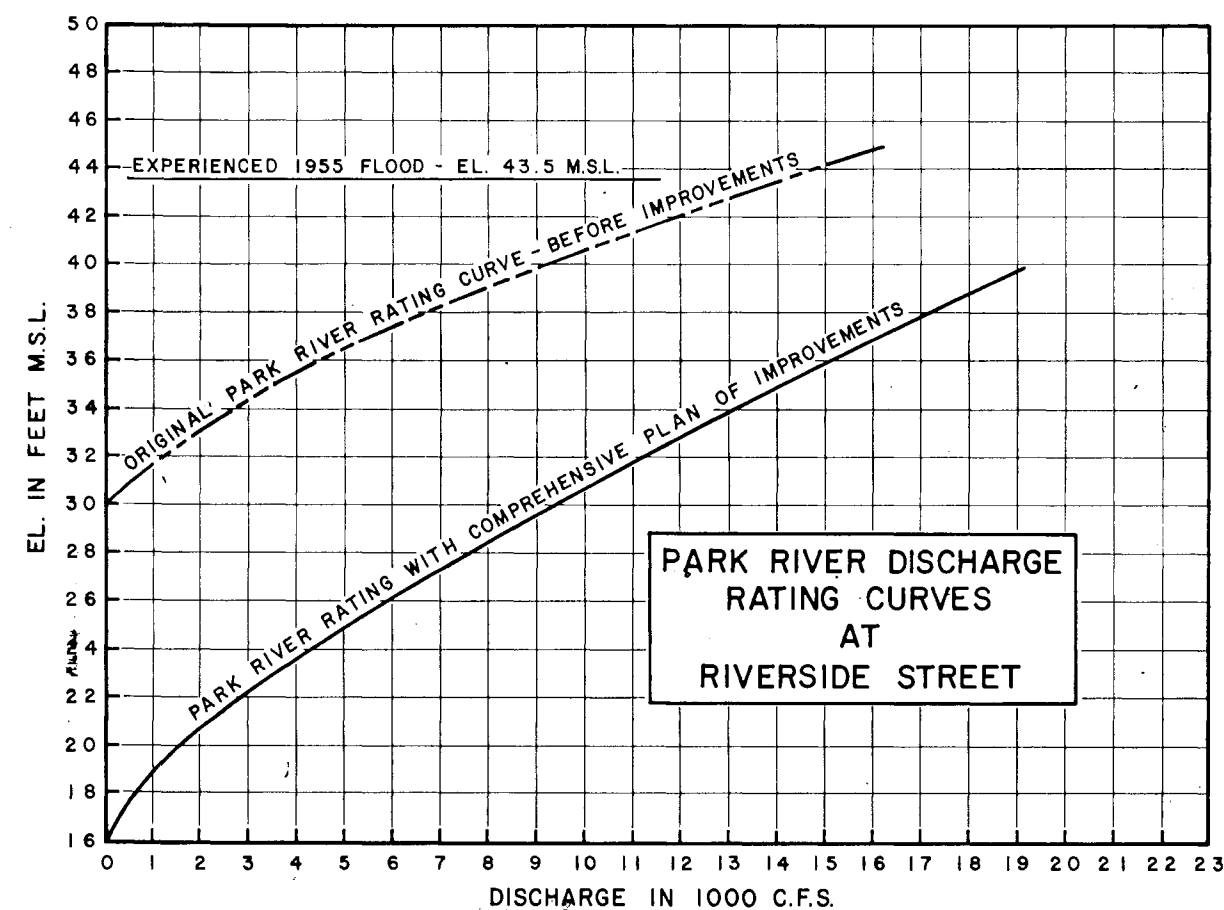


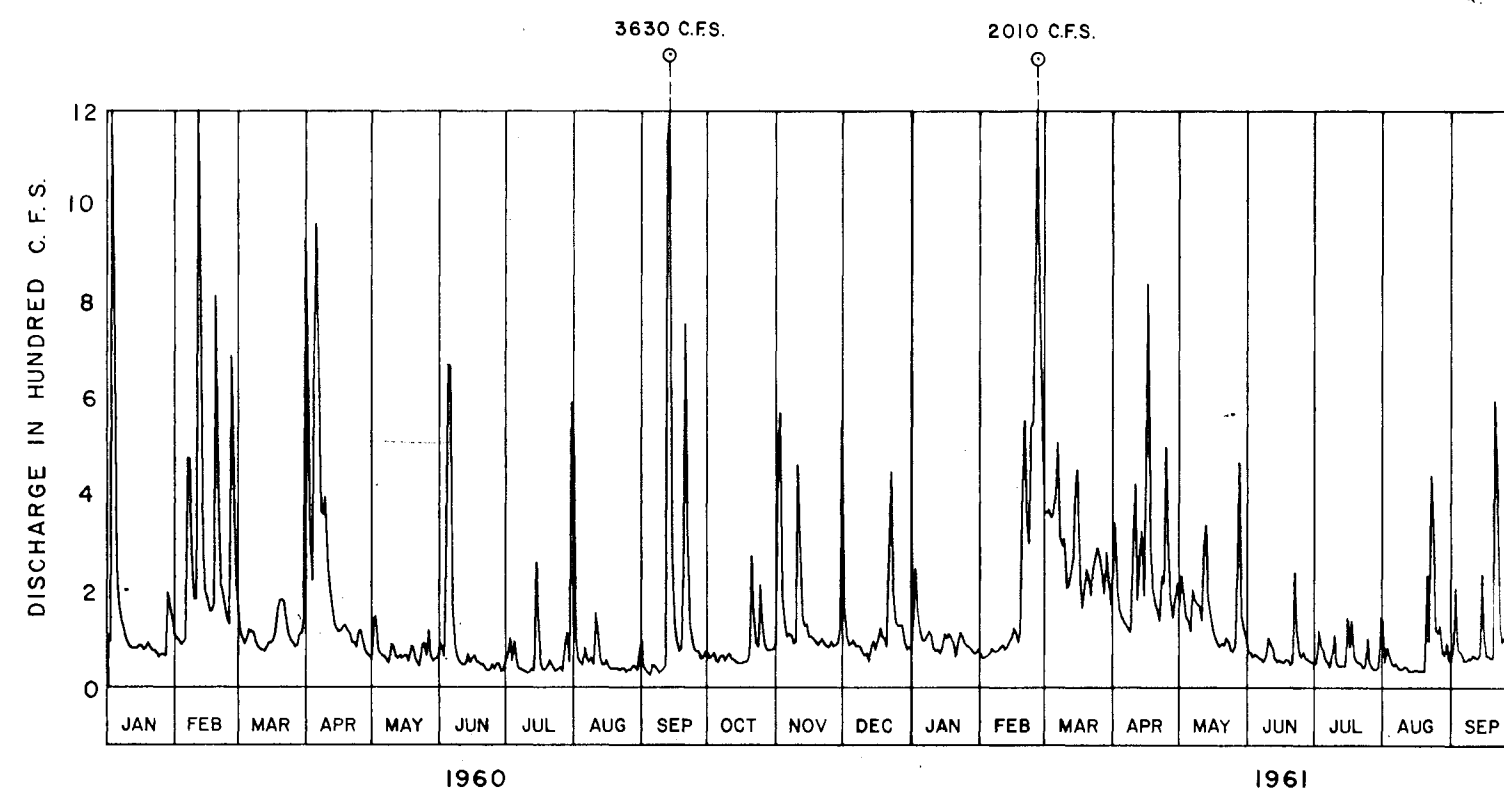

NOTE:

1. SEE HYDROGRAPHS NO. 1 FOR NOTES.

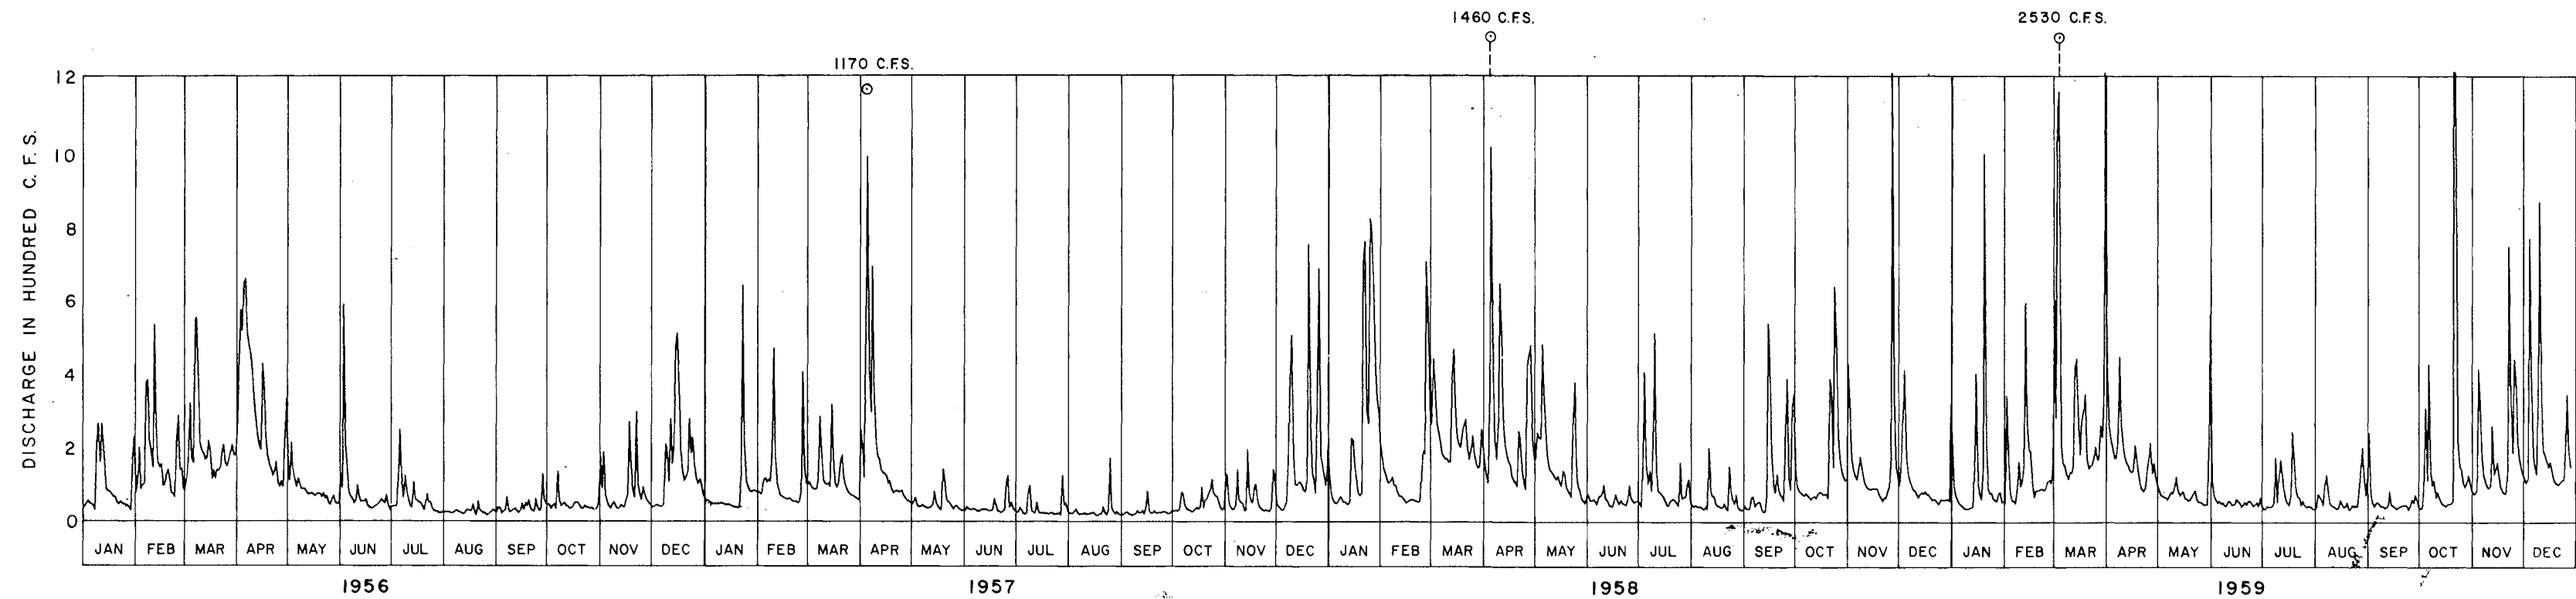

GRAPHIC SCALES

As Built Drawing

Contract No. DACW 33-76-0098



REVISION	DATE	DESCRIPTION	BY

DEPARTMENT OF THE ARMY
NEW ENGLAND DIVISION
CORPS OF ENGINEERS
WALTHAM, MASS.

DESIGNED BY: W.B. DRAWN BY: J.M. CHECKED BY: W.B.
SUBMITTED: [Signature] APPROVED: [Signature]
CHIEF, WATER CONSTRUCTION BRANCH
CHIEF, PROJECT BRANCH
CHIEF, ENGINEERING DIVISION

WATER RESOURCES DEVELOPMENT PROJECT
PARK RIVER LOCAL PROTECTION
DAILY FLOW HYDROGRAPHS NO. 3
PARK RIVER AT HARTFORD

HARTFORD CONNECTICUT
DATE: MARCH 1976
SCALE: [Blank] SPEC. NO. DACW33-76-0040
DRAWING NUMBER: PAR-1
SHEET 6