


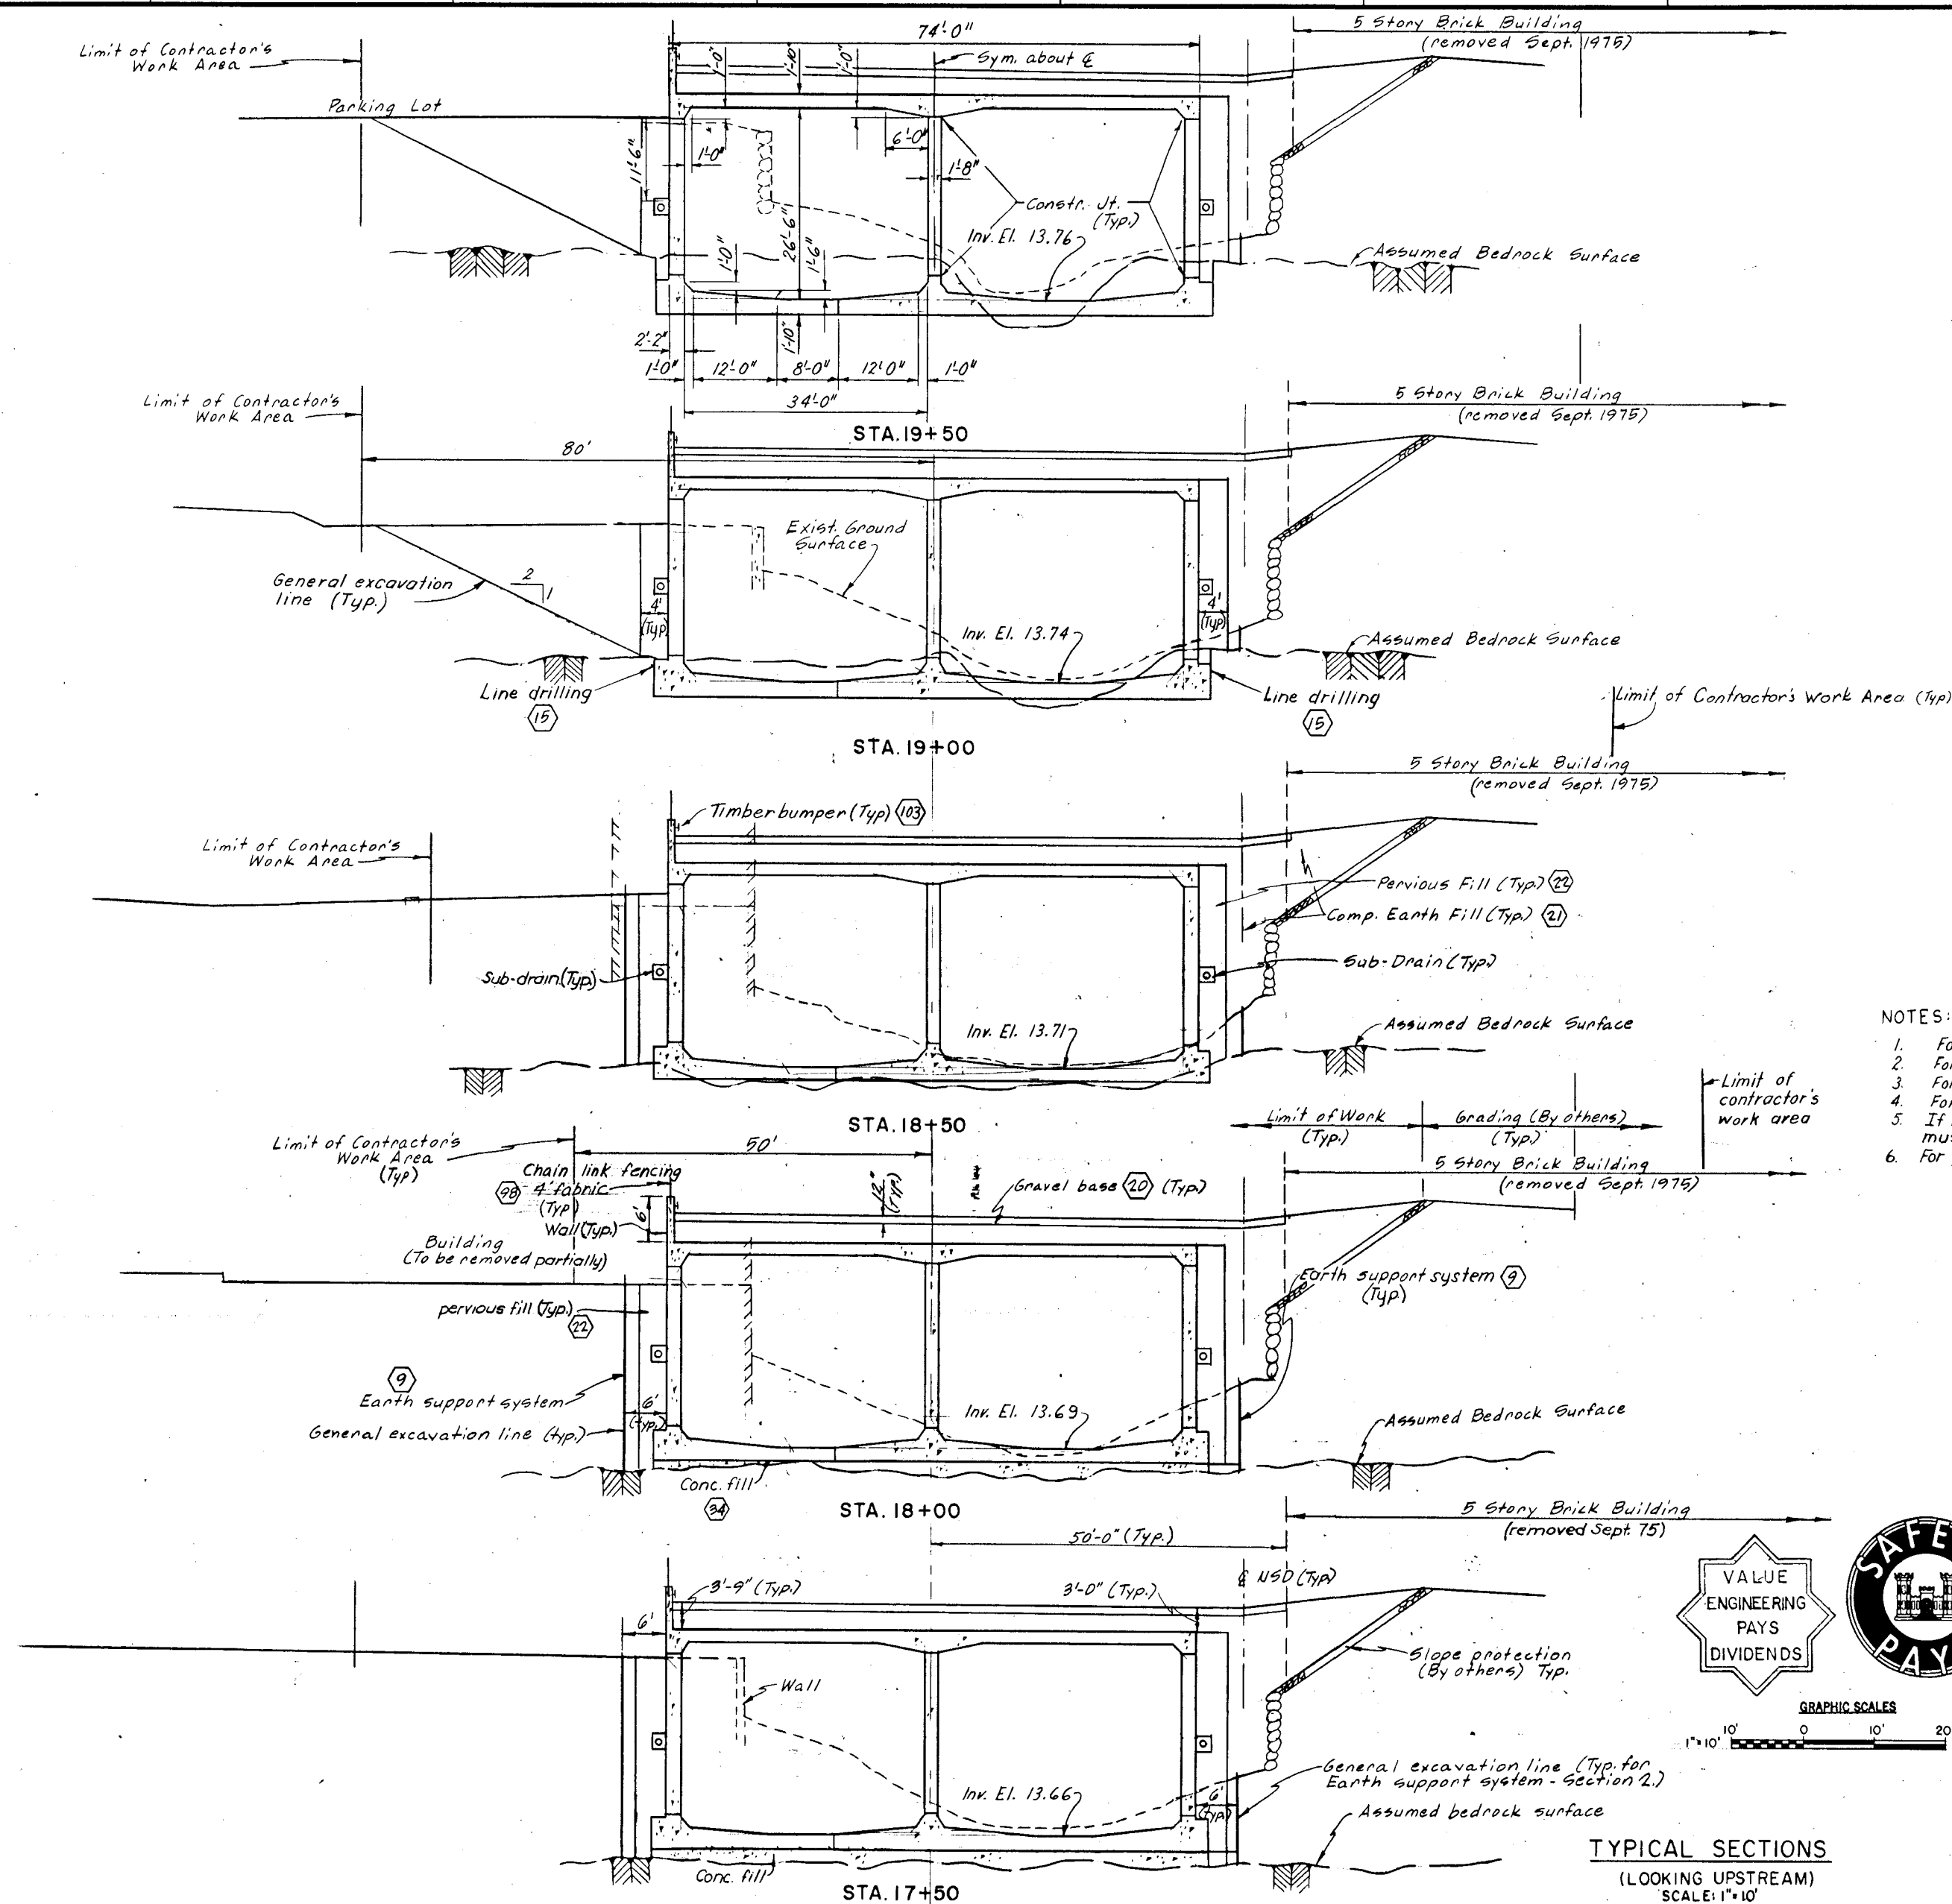


NOTES:

1. For general notes see sheet 2
2. For plan & profile of section 2 see sheets 7 and 8
3. For section 2 grading plan see sheets 18 and 19
4. For sub-drain detail see sheet 9
5. If rock excavation is over 8' safety mesh must be used.
6. For payment line in rock see sheet 9

As Built Drawing

Contract No. DACW 33-76-C-0098

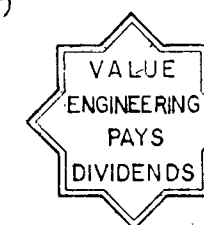

GRAPHIC SCALES

1" = 10' 0 10' 20'

TYPICAL SECTIONS
(LOOKING UPSTREAM)
SCALE: 1" = 10'

4-4-83 Final Field Corrections		DATE	DESCRIPTION	BY
DEPARTMENT OF THE ARMY NEW ENGLAND DIVISION CORPS OF ENGINEERS WALTHAM, MASS.				
WATER RESOURCES DEVELOPMENT PROJECT PARK RIVER LOCAL PROTECTION BOX CONDUIT AT SECTION 2 TYPICAL SECTIONS NO. 4				
DES. BY M.B.		CHK. BY W.F.	DATE MARCH 1976	
SUBMITTED J. B. B.		APPROVED J. B. B.		
CHIEF, LAYOUT SECTION		CHIEF, ENGINEERING DIVISION		
APPROVAL RECOMMENDATION J. B. B.		APPROVED J. B. B.		
REVIEWED J. B. B.		SPEC. NO. DACW33-76-B-0040		
CHIEF, PROJECT BRANCH		DRAWING NUMBER PAR - 1		
		SHEET 12		