

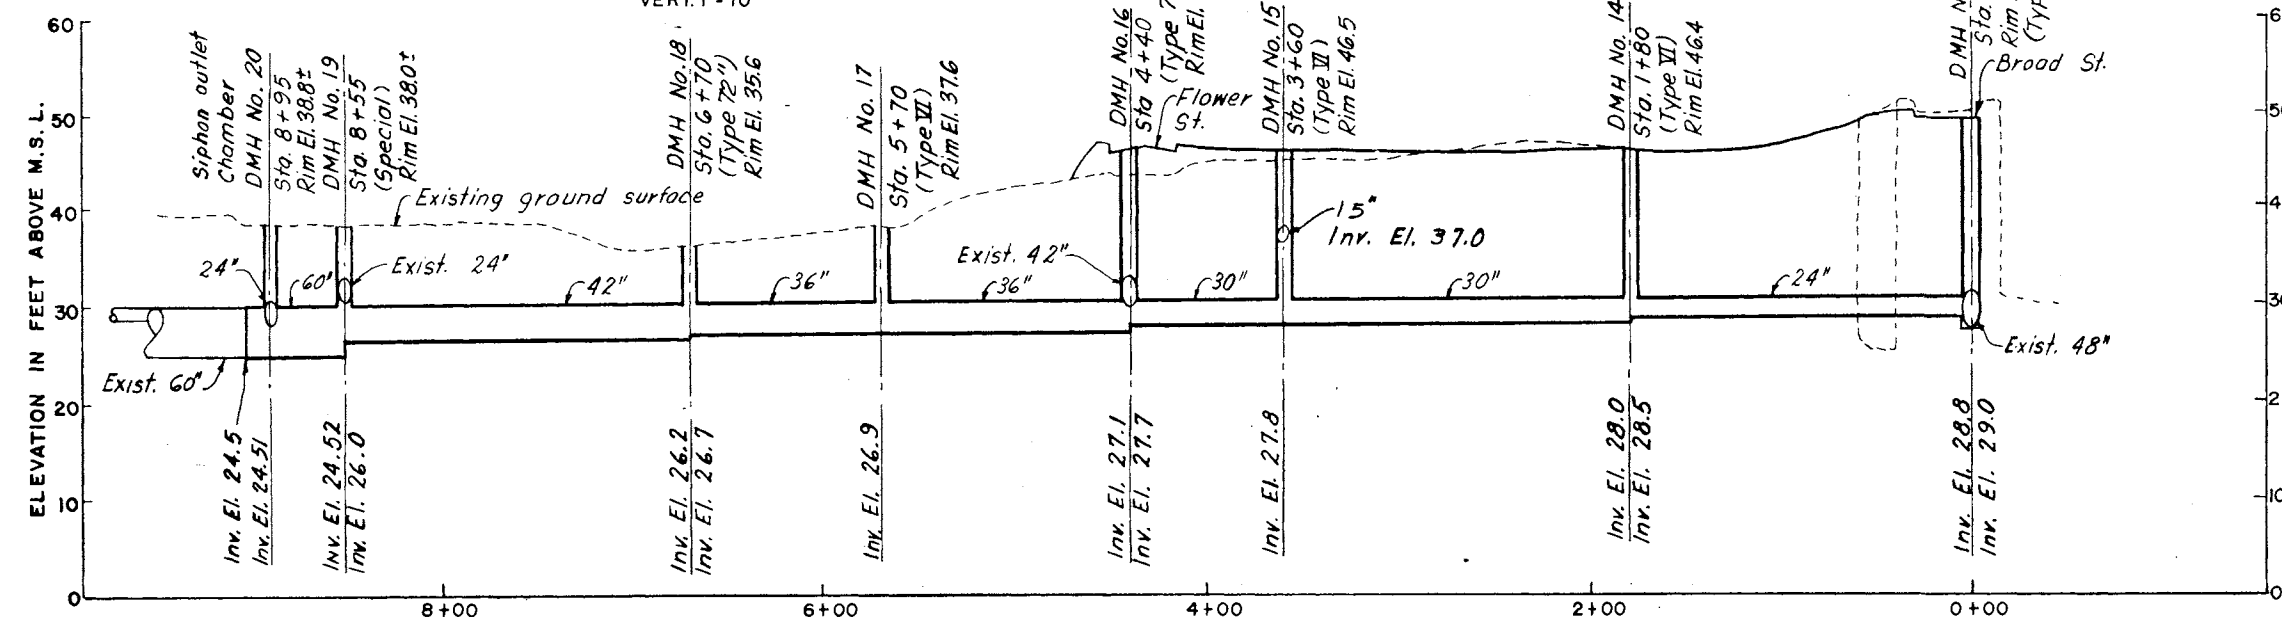
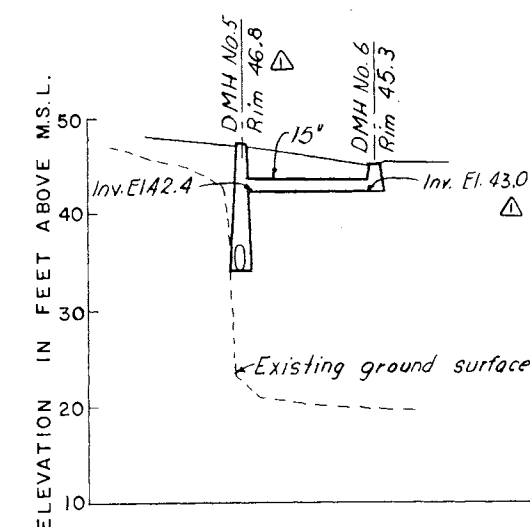
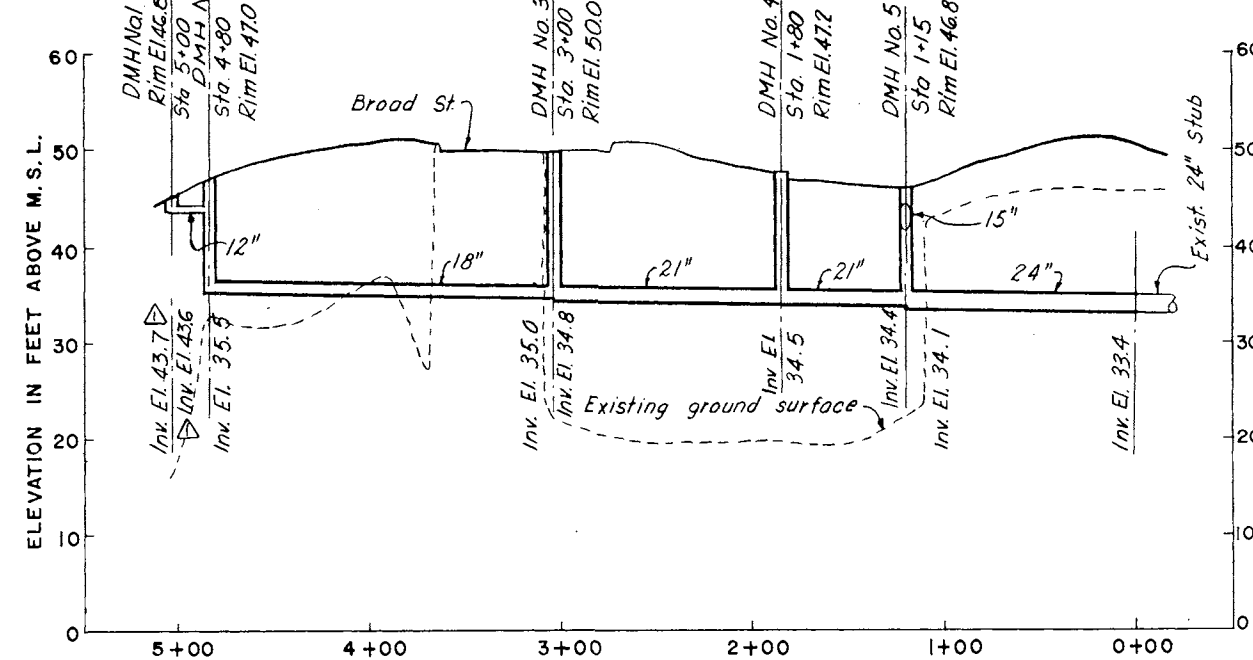


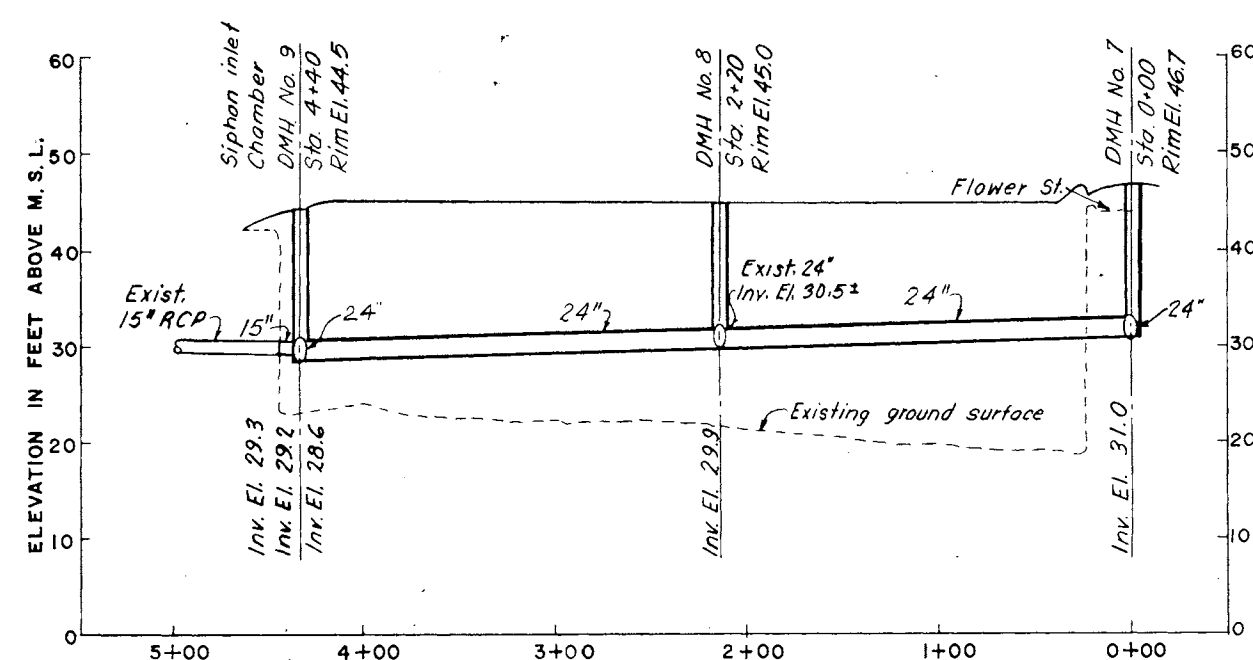

- NOTE:**
1. For location of low level drains see sheets 18 and 19.
 2. All manholes shall be Type II unless otherwise noted.
 3. DMH Nos. 13, 16 & 18 changed from Type II to Type I.
Top slabs, with 48" risers, installed on DMH bases Nos. 13 & 18.

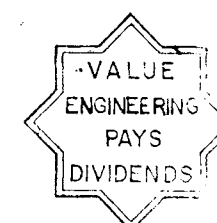

As Built Drawing

Contract No. DACW 33-76-C-0098

4-4-83 Final field corrections		DATE	DESCRIPTION	BY
1 June 76 DMH Rim & Inv. El. revised (Am. #4)				sha
DEPARTMENT OF THE ARMY NEW ENGLAND DIVISION CORPS OF ENGINEERS WALTHAM, MASS.				
DES. BY W. F.		WATER RESOURCES DEVELOPMENT PROJECT PARK RIVER LOCAL PROTECTION BOX CONDUIT AT SECTION 2 LOW LEVEL DRAINAGE PROFILES		
SUBMITTED BY H. S.		HARTFORD CONNECTICUT		
CHIEF UTILITIES SECTION		DATE MARCH 1976		
REVIEWED BY C. P.		SCALE AS SHOWN SPEC. NO. DACW 33-76-B-0040		
PROJECT ENGINEER		DRAWING NUMBER		
APPROVED BY J. P.		PAR - 1		
CHIEF PROJECT BRANCH		SHEET 20		