


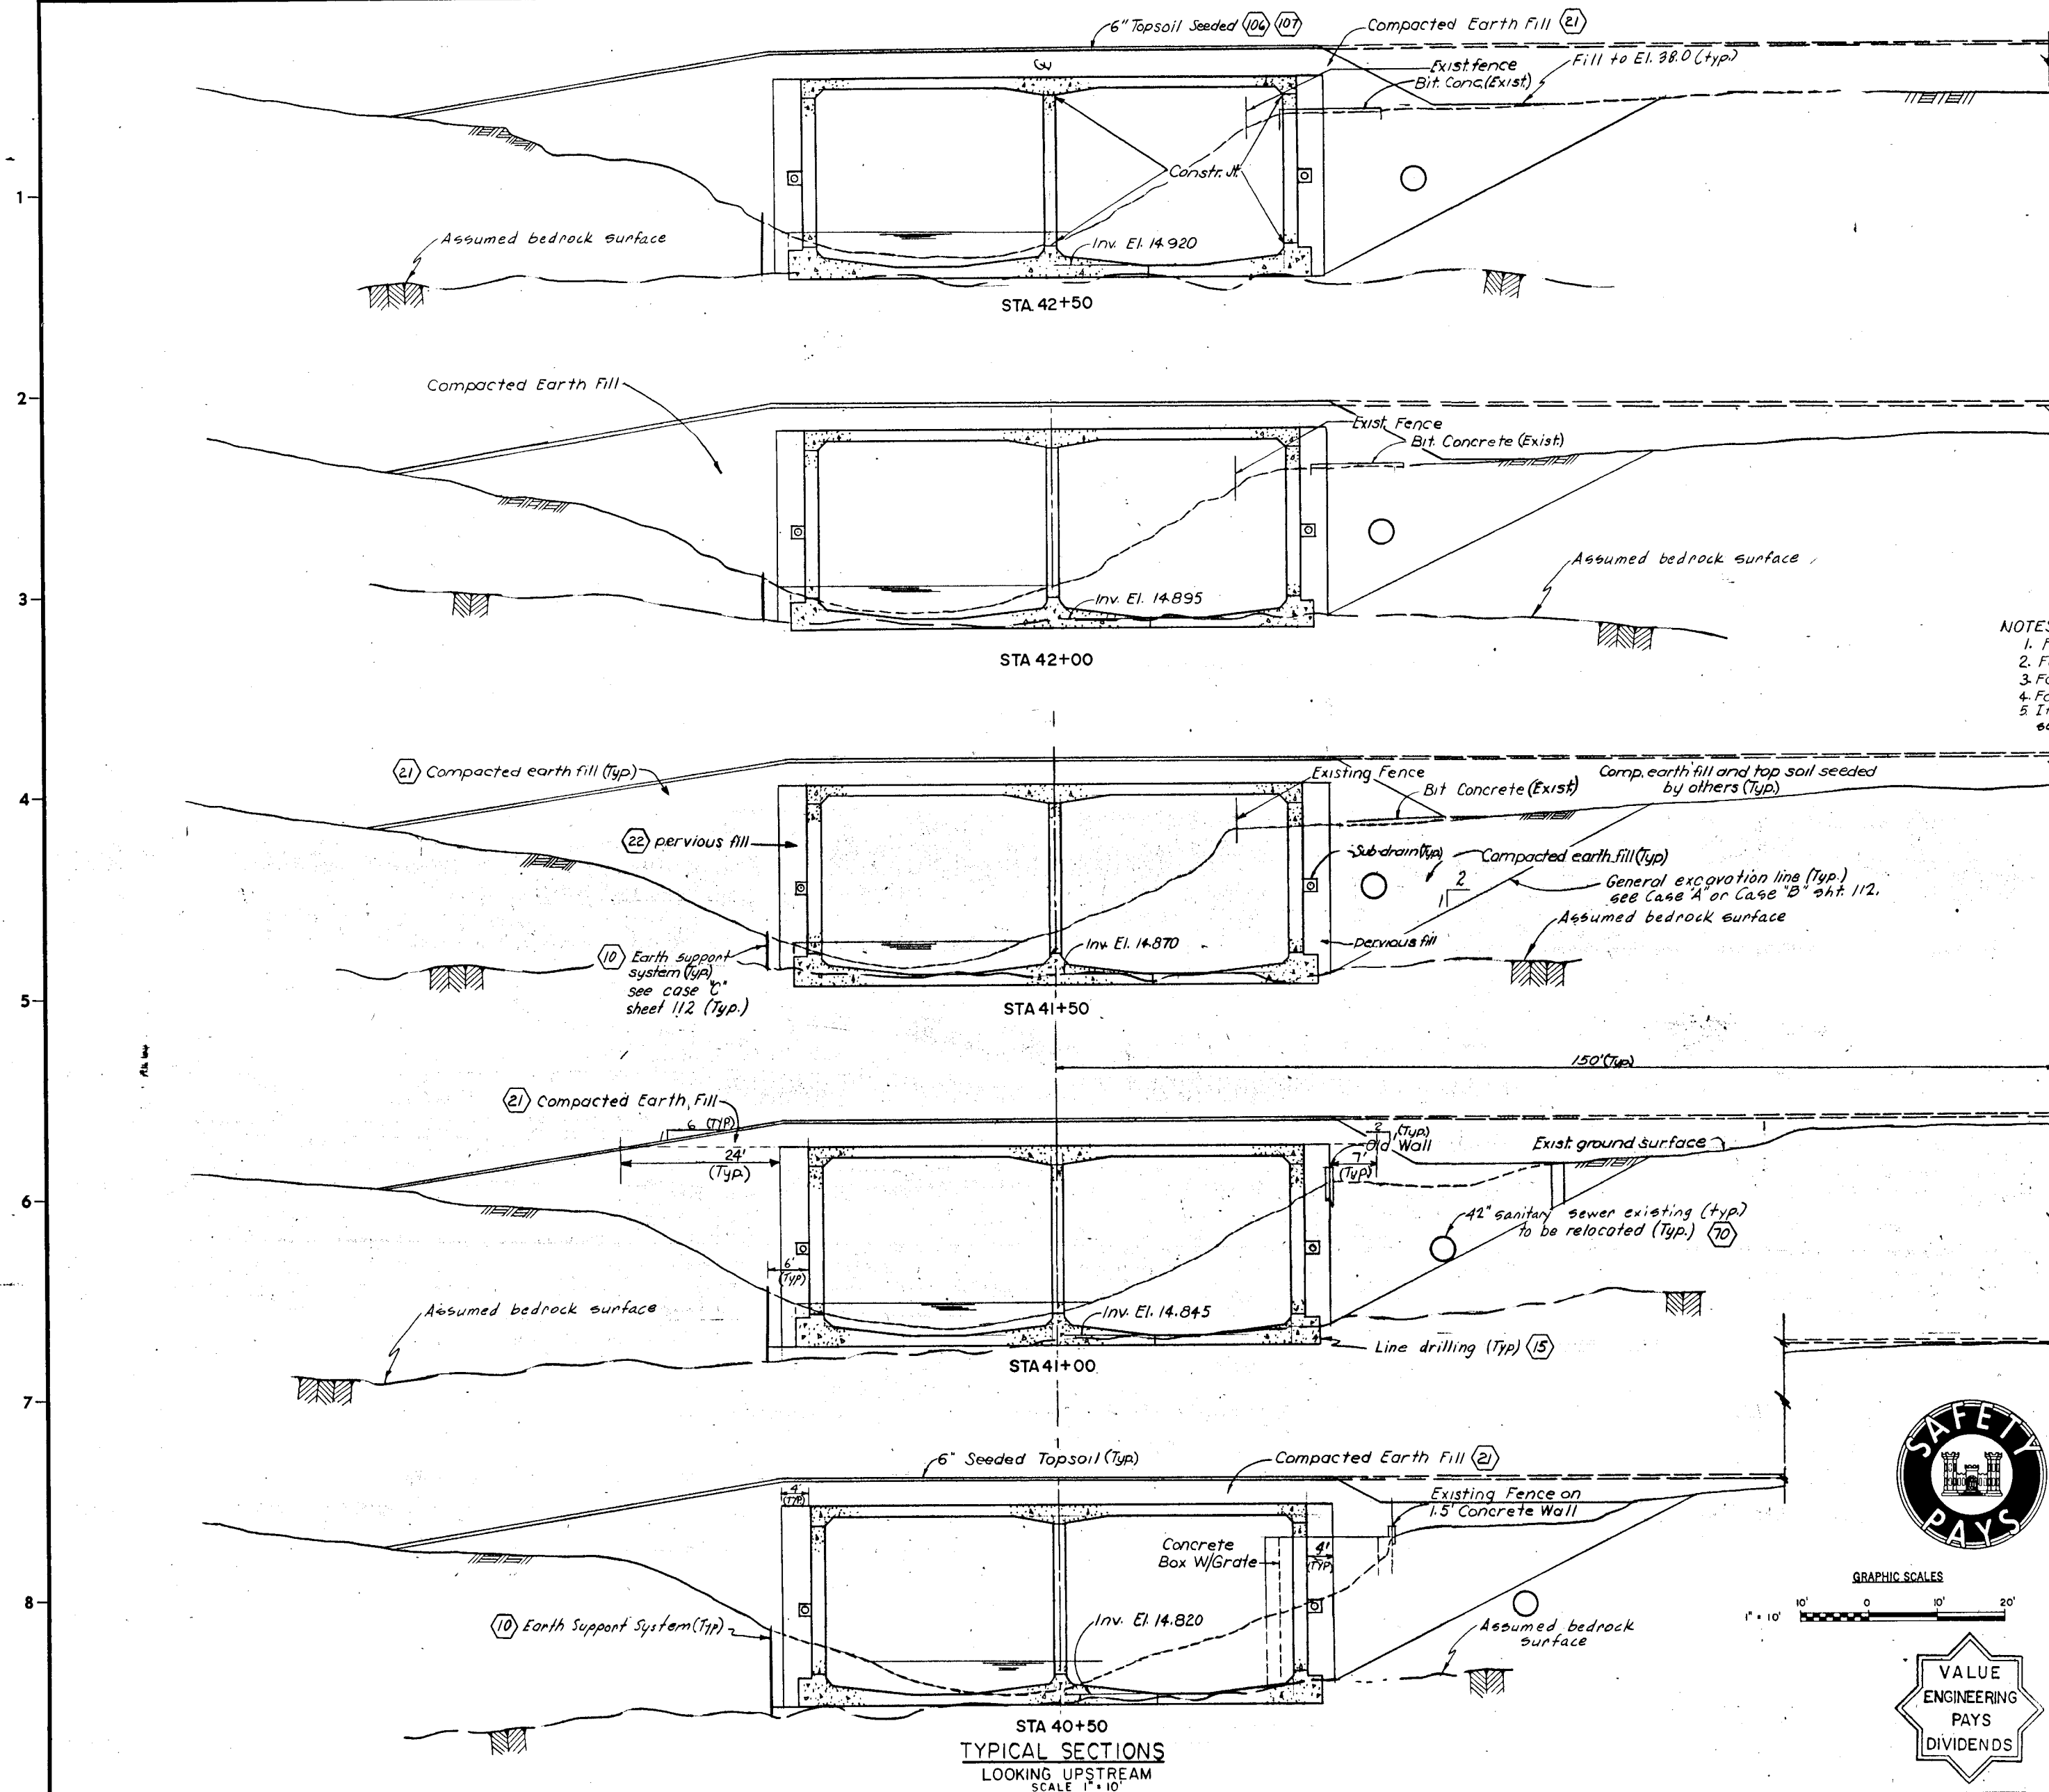

NOTES:

1. For general notes see sheet 2
2. For plan and profile of Section 4 see sheets 24 and 25
3. For grading plan see sheets 34 and 35
4. For sub-drain detail see sheet 26
5. If rock excavation is encountered within this reach, see Sheet 26.
6. Topsoil & seed west slope, Sta. 38+10 to 48+00, top to 5' west of toe.



For continuation of
sections see Sh. 1/3

As Built Drawing

Contract No. DACW 33-76-C-0098



GRAPHIC SCALES

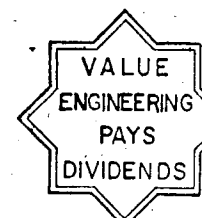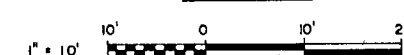

REVISION	DATE	DESCRIPTION	BY
4-4-83		Final Field Corrections	

DES. BY: R. C. J. B. M. R. J. C.			
SUBMITTED: [Signature]			
CHIEF, LAYOUT SECTION: [Signature]			
APPROVAL RECOMMENDED: [Signature]			
REVIEWED: [Signature]			
PROJECT ENGINEER: [Signature]			
APPROVED: [Signature]			
CHIEF, PROJECT BRANCH: [Signature]			

DEPARTMENT OF THE ARMY NEW ENGLAND DIVISION CORPS OF ENGINEERS WALTHAM, MASS.	
WATER RESOURCES DEVELOPMENT PROJECT PARK RIVER LOCAL PROTECTION BOX CONDUIT AT SECTION 4 TYPICAL SECTIONS NO. 2	
HARTFORD	CONNECTICUT
DATE: MARCH 1976	
SCALE 1"=10'	SPEC. NO. DACW33-76-B-0040
DRAWING NUMBER PAR - 1	SHEET 27