


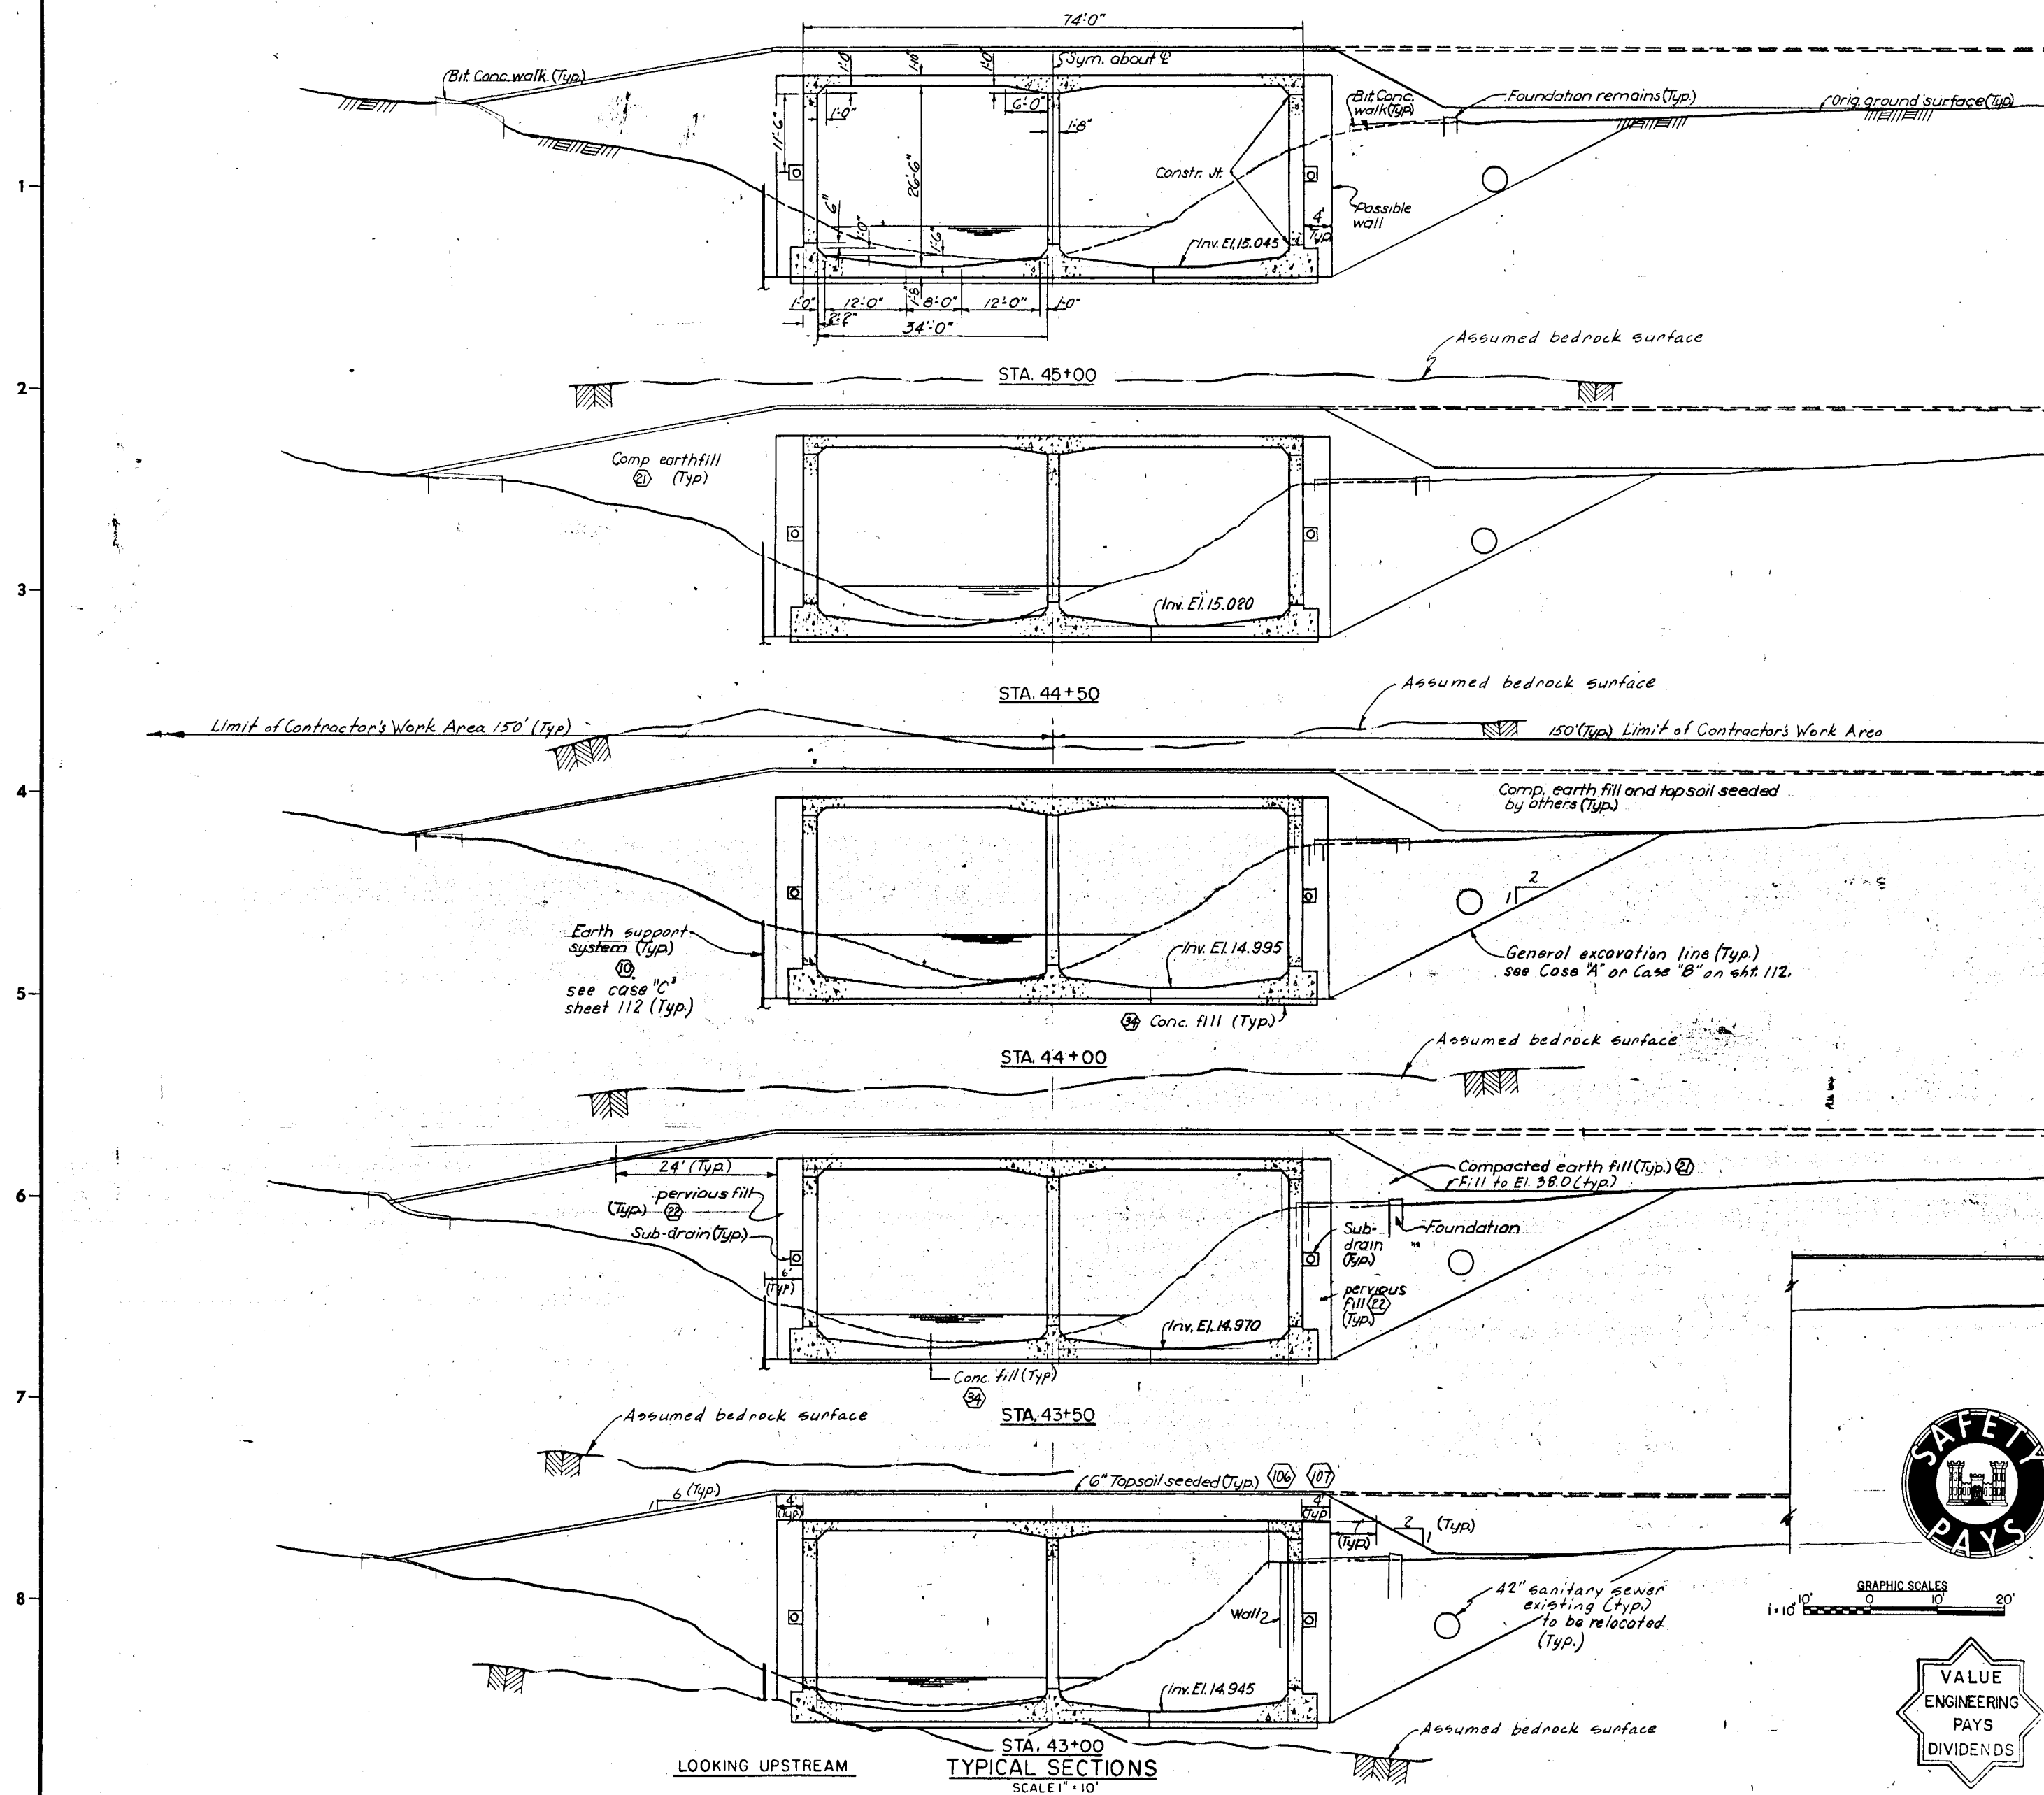

For continuation of sections
see Sh. 113

NOTES


1. For general notes see Sh. 2
2. For plan and profile of Sect. 4 see Sheets 24 and 25.
3. For grading plan see Sh. 34 and 35
4. For sub-drain detail see Sh. 26
5. If rock excavation is encountered within this reach, see Sheet 26.
6. Topsoil & seed west slope, Sta. 38+10 to 48+00, top to 5' wet toe.

As Built Drawing

Contract No. DACW 33-76C-0098



GRAPHIC SCALES
1" = 10'

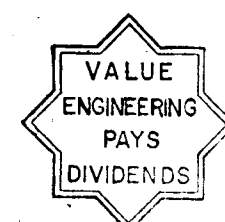

REVISION	DATE	DESCRIPTION	BY
4-4-83		Final Field Corrections	

DEPARTMENT OF THE ARMY NEW ENGLAND DIVISION CORPS OF ENGINEERS WALTHAM, MASS.			
WATER RESOURCES DEVELOPMENT PROJECT PARK RIVER LOCAL PROTECTION BOX CONDUIT AT SECTION 4 TYPICAL SECTIONS NO. 3			
DES. BY R.C. JBM	DR. BY JBM	CK. BY RTC	DATE MARCH 1976
SUBMITTED 8-1-76			
APPROVAL RECOMMENDED CHIEF, LAYOUT SECTION CHIEF, FIELD THIS BRANCH			
REVIEWER PROJECT ENGINEER			
APPROVED CHIEF, ENGINEERING DIVISION			
SCALE 1" = 10'			
SPEC. NO. DACW 33-76-B-0040			
DRAWING NUMBER PAR - 1			
SHEET 28			