
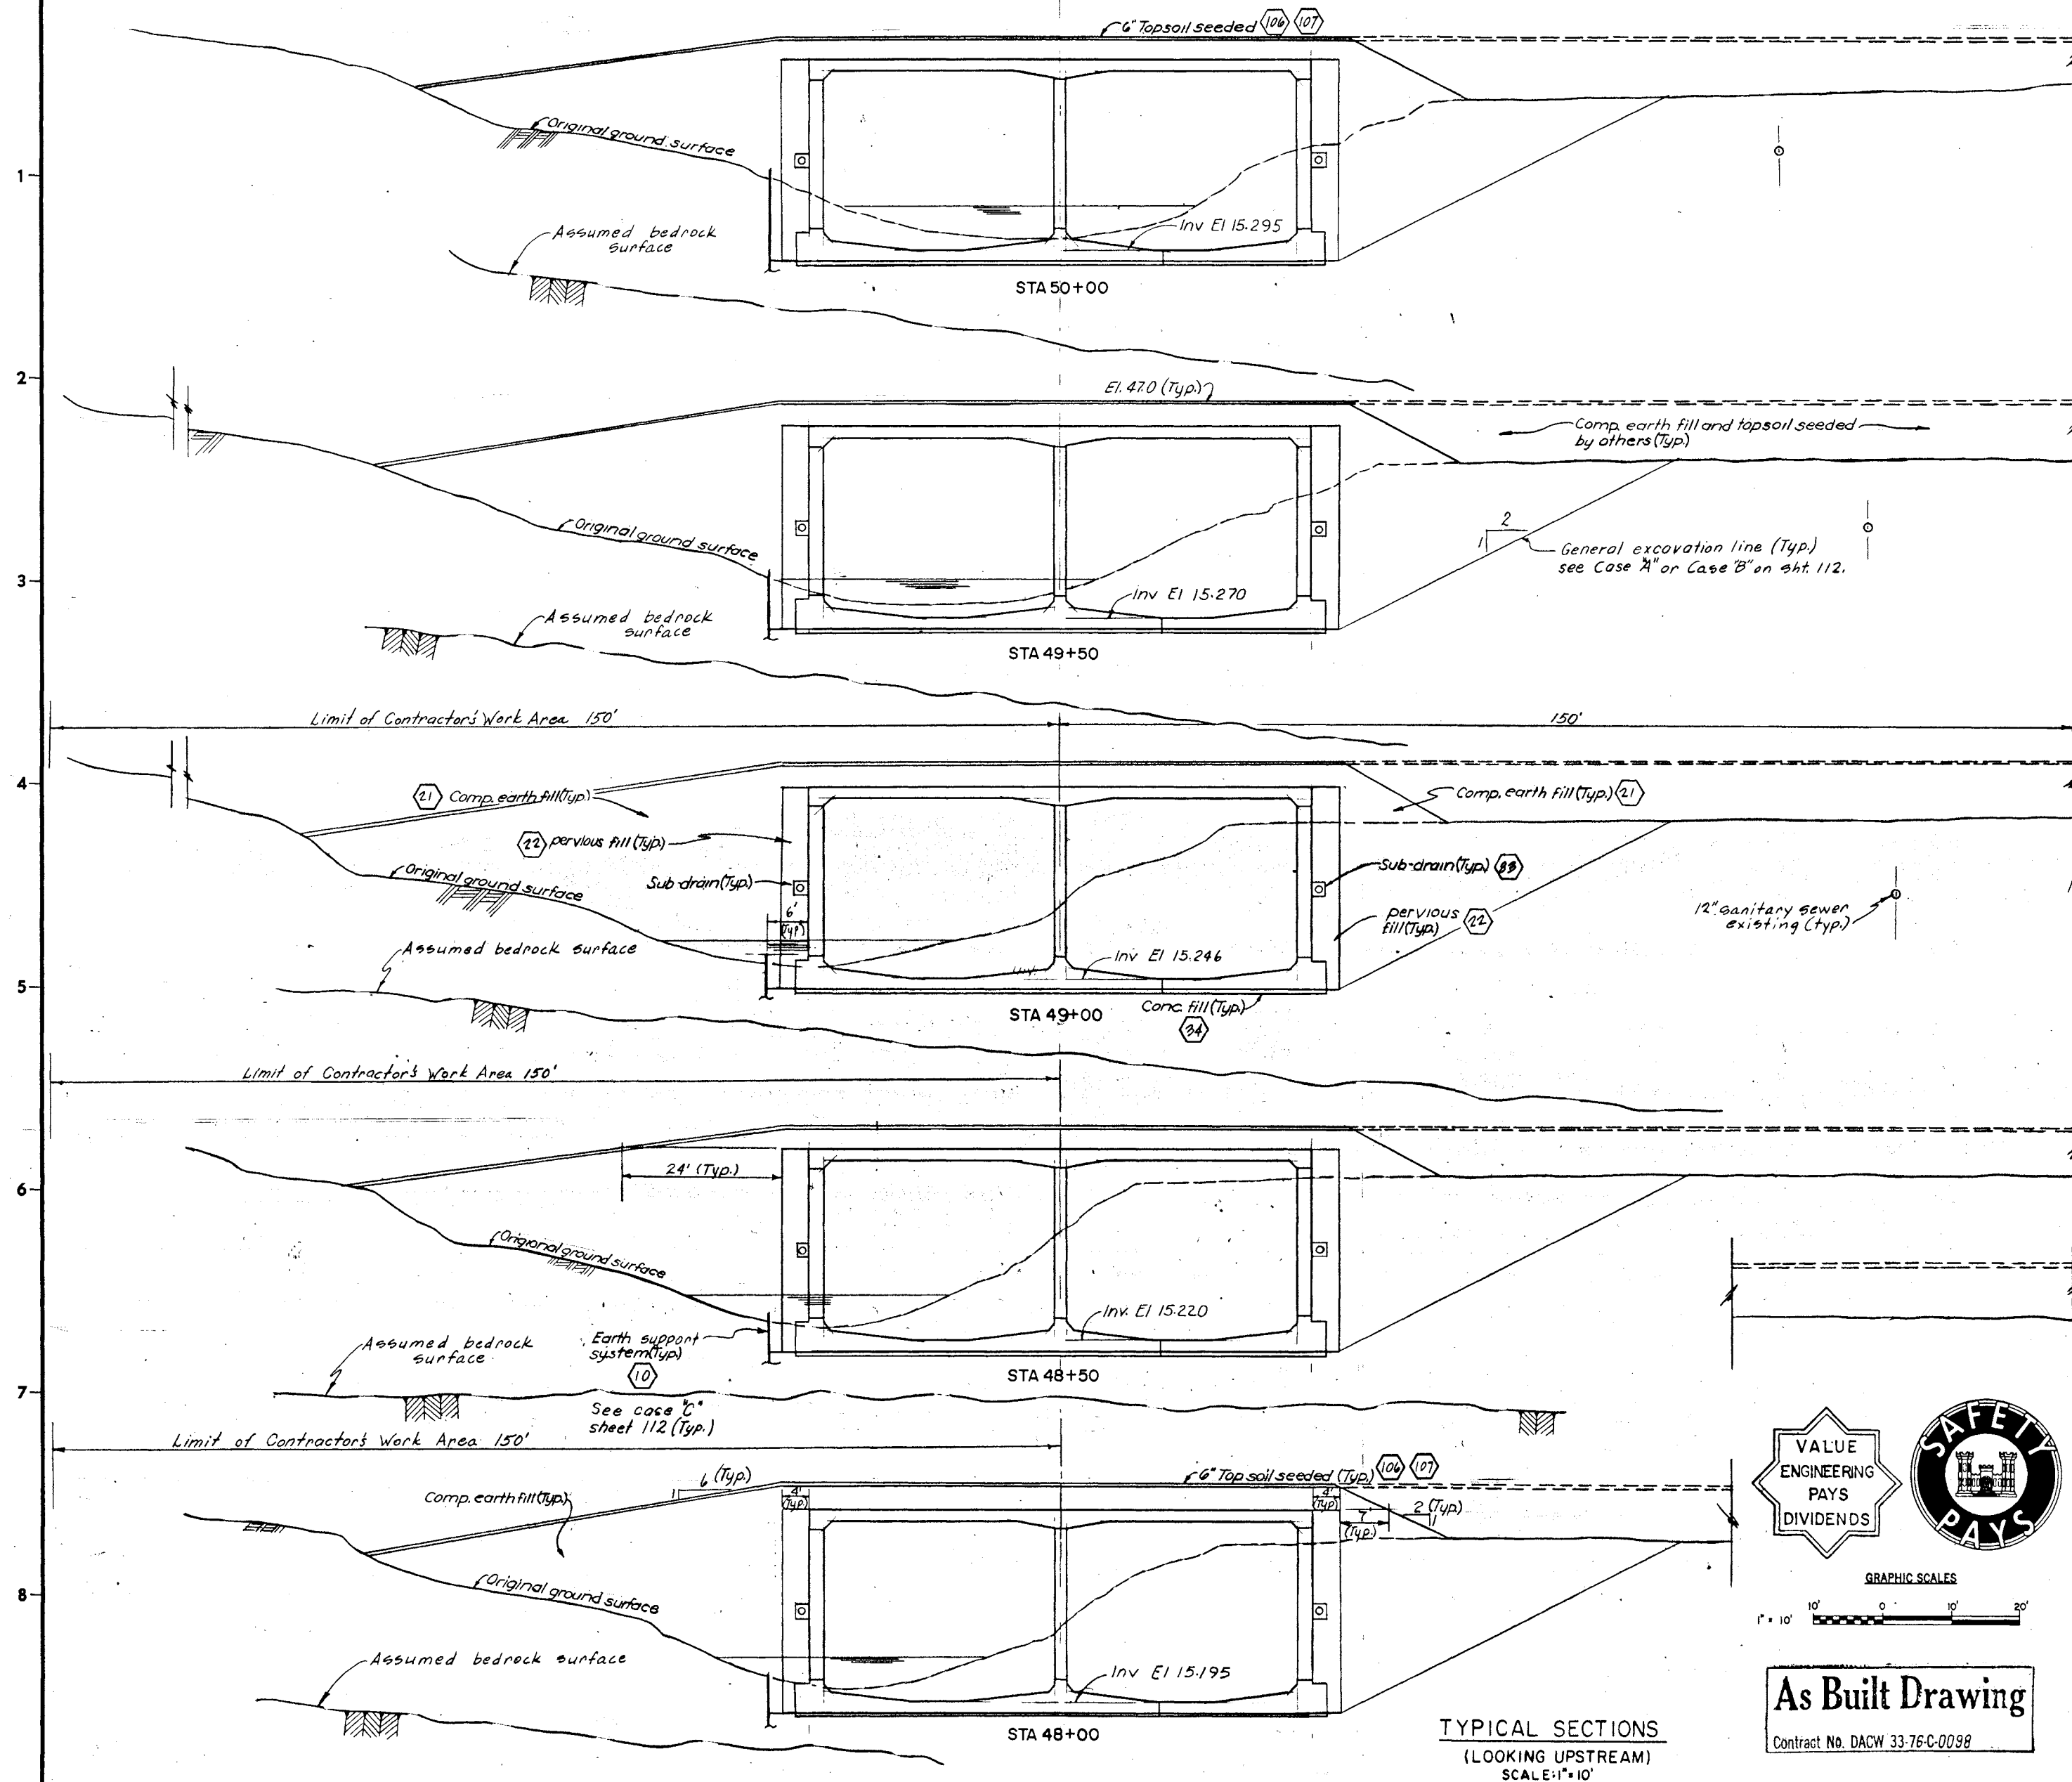


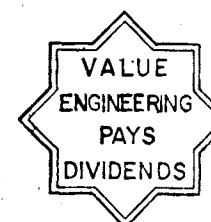

NOTES:

1. For general notes see sheet 2.
2. For plan and profile of section 4 see sheets 24 and 25.
3. For grading plan see sheets 34 and 35.
4. For sub-drain details see sheet 26.
5. If rock excavation is encountered within this reach, see sheet 26.
6. For Limit of Contractor's Work Area see sheet 113.
7. Topsoil & seed west slope, Sta. 38+10 to 48+00, top to 5' west of toe.

GRAPHIC SCALES
1" = 10'

As Built Drawing

Contract No. DACW 33-76-C-0098

TYPICAL SECTIONS
(LOOKING UPSTREAM)
SCALE: 1" = 10'

REVISION	DATE	DESCRIPTION	BY
4-4-83		Final Field Corrections	

DEPARTMENT OF THE ARMY
NEW ENGLAND DIVISION
CORPS OF ENGINEERS
WALTHAM, MASS.

DES. BY: J.B.M. R.T.C.
SUBMITTED: [Signature]
CHIEF, LAYOUT SECTION
APPROVAL RECOMMENDED: [Signature]
CHIEF, FIELD ENG. BRANCH
REVIEWED: [Signature]
PROJECT ENGINEER

WATER RESOURCES DEVELOPMENT PROJECT
PARK RIVER LOCAL PROTECTION
BOX CONDUIT AT SECTION 4
TYPICAL SECTIONS NO. 5

HARTFORD CONNECTICUT
APPROVED: [Signature]
CHIEF, ENGINEERING DIVISION
DATE: MARCH 1976

SCALE: 1" = 10' SPEC. NO. DACW 33-76-B-0040
DRAWING NUMBER
PAR - I
SHEET 30