


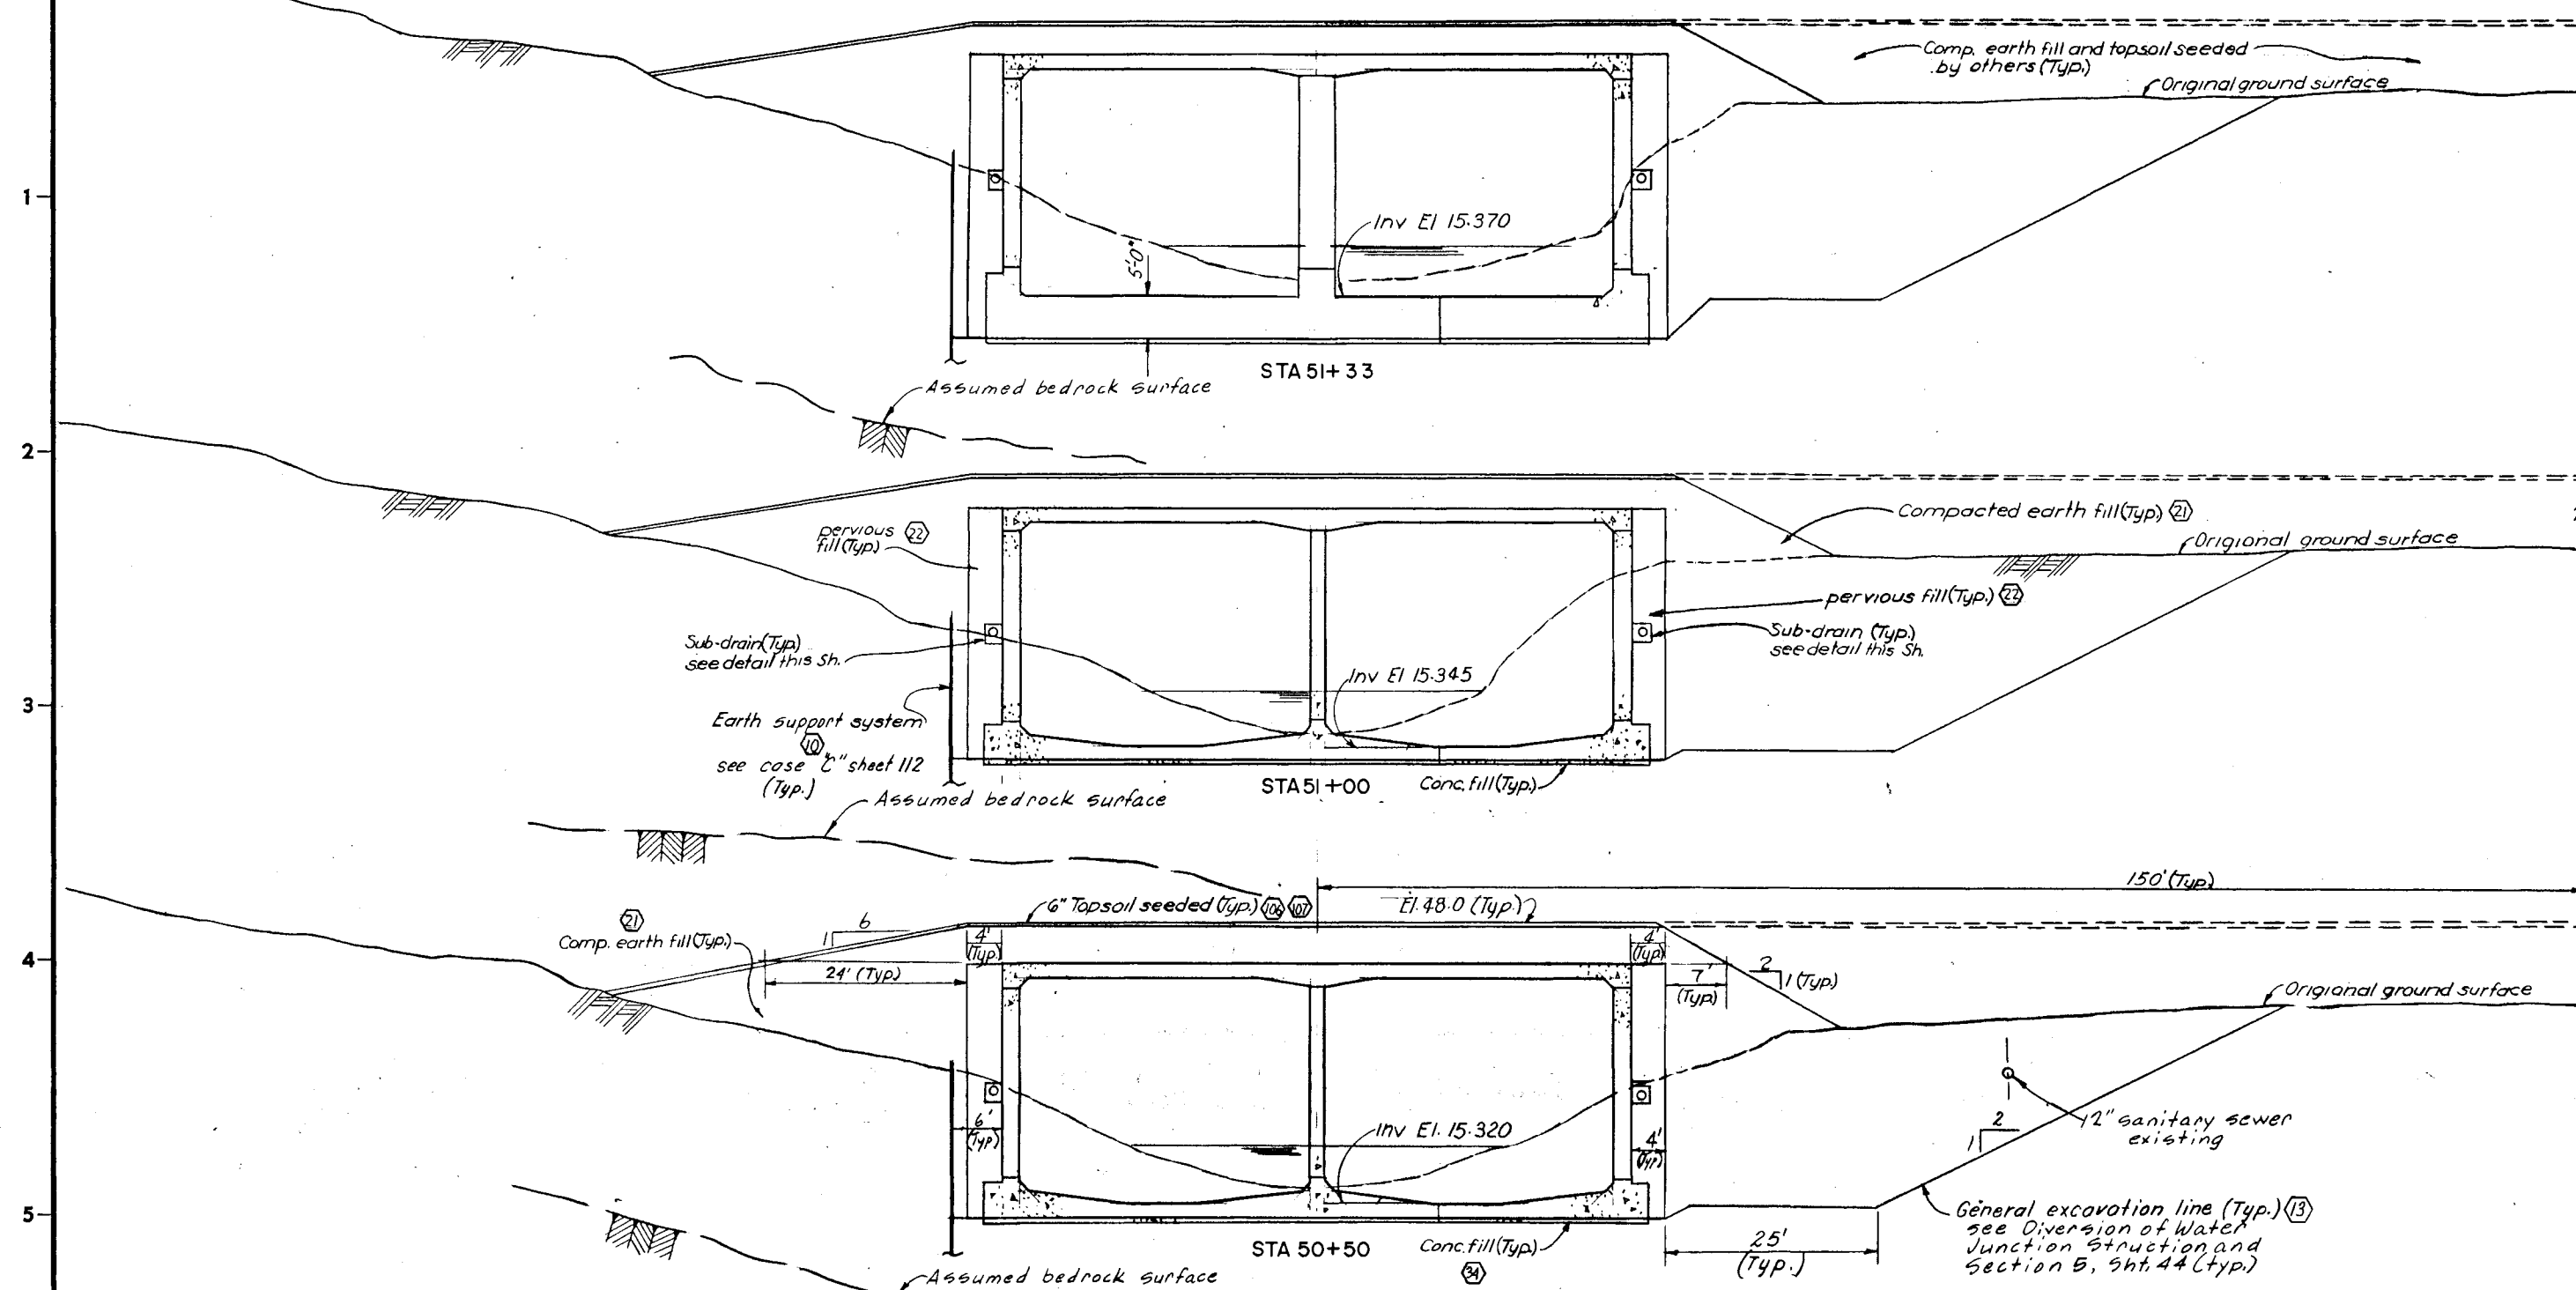

For continuation of sections see Sh. 113


NOTES:

1. For general notes see sheet 2
2. For plan and profile of Section 4 see sheets 24 and 25
3. For grading plan see sheets 34 and 35
4. For sub-drain details see sheet 26
5. If rock excavation is encountered within this reach, see sheet 26.
6. For limit of contractor's work area see Sh. 113.



TYPICAL SECTIONS

(LOOKING UPSTREAM)

SCALE 1"=10'

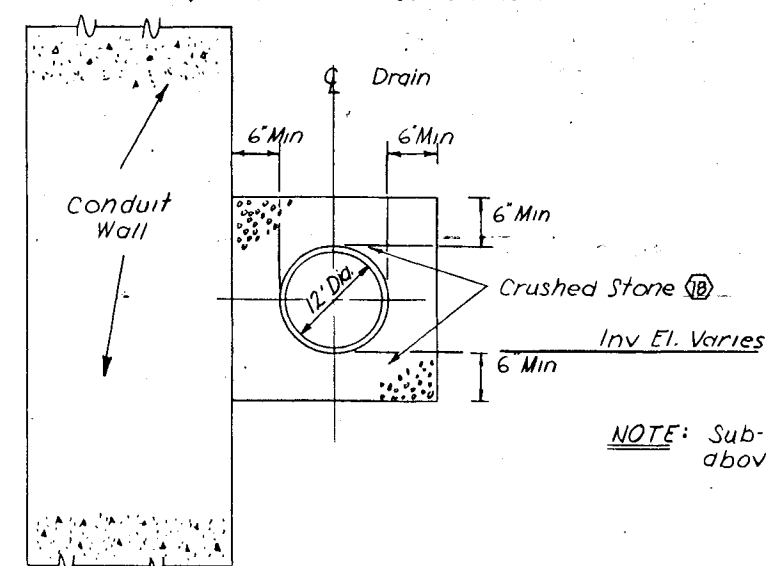SUB-DRAIN DETAIL
SCALE 1"=1'

NOTE: Sub-drain Invert 12.86' above Conduit Invert.

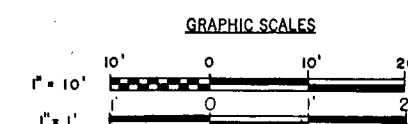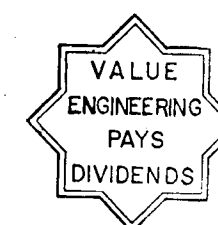

As Built Drawing

Contract No. DACW 33-76-C-0098

REVISION	DATE	DESCRIPTION	BY
4-4-83		Final Field Corrections	
DEPARTMENT OF THE ARMY NEW ENGLAND DIVISION CORPS OF ENGINEERS WALTHAM, MASS.			
WATER RESOURCES DEVELOPMENT PROJECT PARK RIVER LOCAL PROTECTION BOX CONDUIT AT SECTION 4 TYPICAL SECTIONS NO. 6			
DES. BY R. G. L. R. E. C.		APPROVED DATE MARCH 1976	
SUBMITTED CHIEF, LAYOUT SECTION		APPROVED DATE MARCH 1976	
APPROVED CHIEF, TECH. ENG. BRANCH		APPROVED DATE MARCH 1976	
APPROVED CHIEF, PROJECT BRANCH		APPROVED DATE MARCH 1976	
SCALE AS SHOWN SPEC. NO. DACW33-76-B-0040 DRAWING NUMBER PAR - 1 SHEET 31			